

County HENRY S.R. 110

Date 4-26-82

Township DAMASCUS

Weather \_\_\_\_\_

Section 7


Temp. +76°

T5N, R8E

Personnel HOFFMAN

LOEHRKE


HOUSEHOLDER

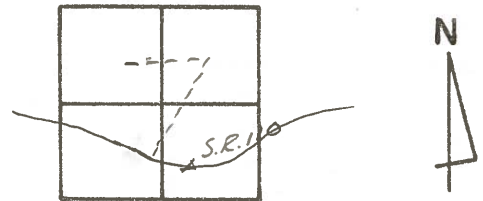

CURVE DATA:  
 P.I. STA. 423+72.22  
 P.C. = 422+92.68  
 P.T. 424+51.65  
 Δ = 5°-10' LT.  
 R. = 1762.95  
 T. = 79.54  
 D = 3°-15'  
 L = 158.97

PROJ. STA. = 425+01

OLD ALIGNMENT

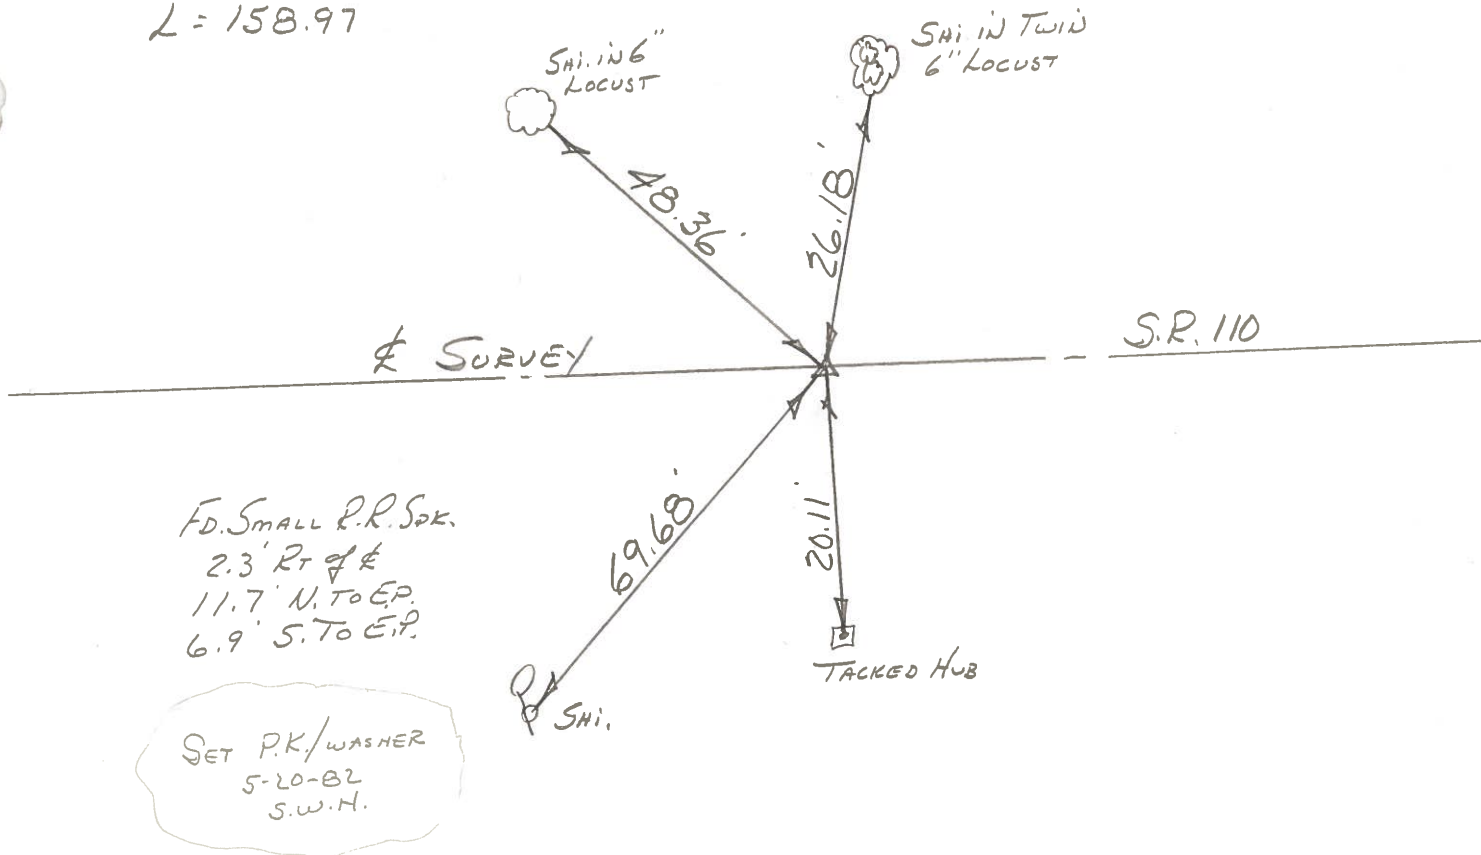


FD. SMALL P.R. Spk.  
 2.3' Rt of E  
 11.7' N. TO EP.  
 6.9' S. TO EP.

SET P.K./WASHER  
 5-20-82  
 S.W.H.

PERSONNEL TITLE PERSONNEL TITLE  
BURNSIDE \_\_\_\_\_  
SMITH \_\_\_\_\_  
BOWERS \_\_\_\_\_  
MEAD \_\_\_\_\_

COUNTY HENRY DATE 4-2-73  
 S. R. 110 WEATHER CLOUDY  
 SEC. \_\_\_\_\_ TEMP. +45°

DESCRIPTION ± SURVEY CONTROL TIES JOB NO. \_\_\_\_\_

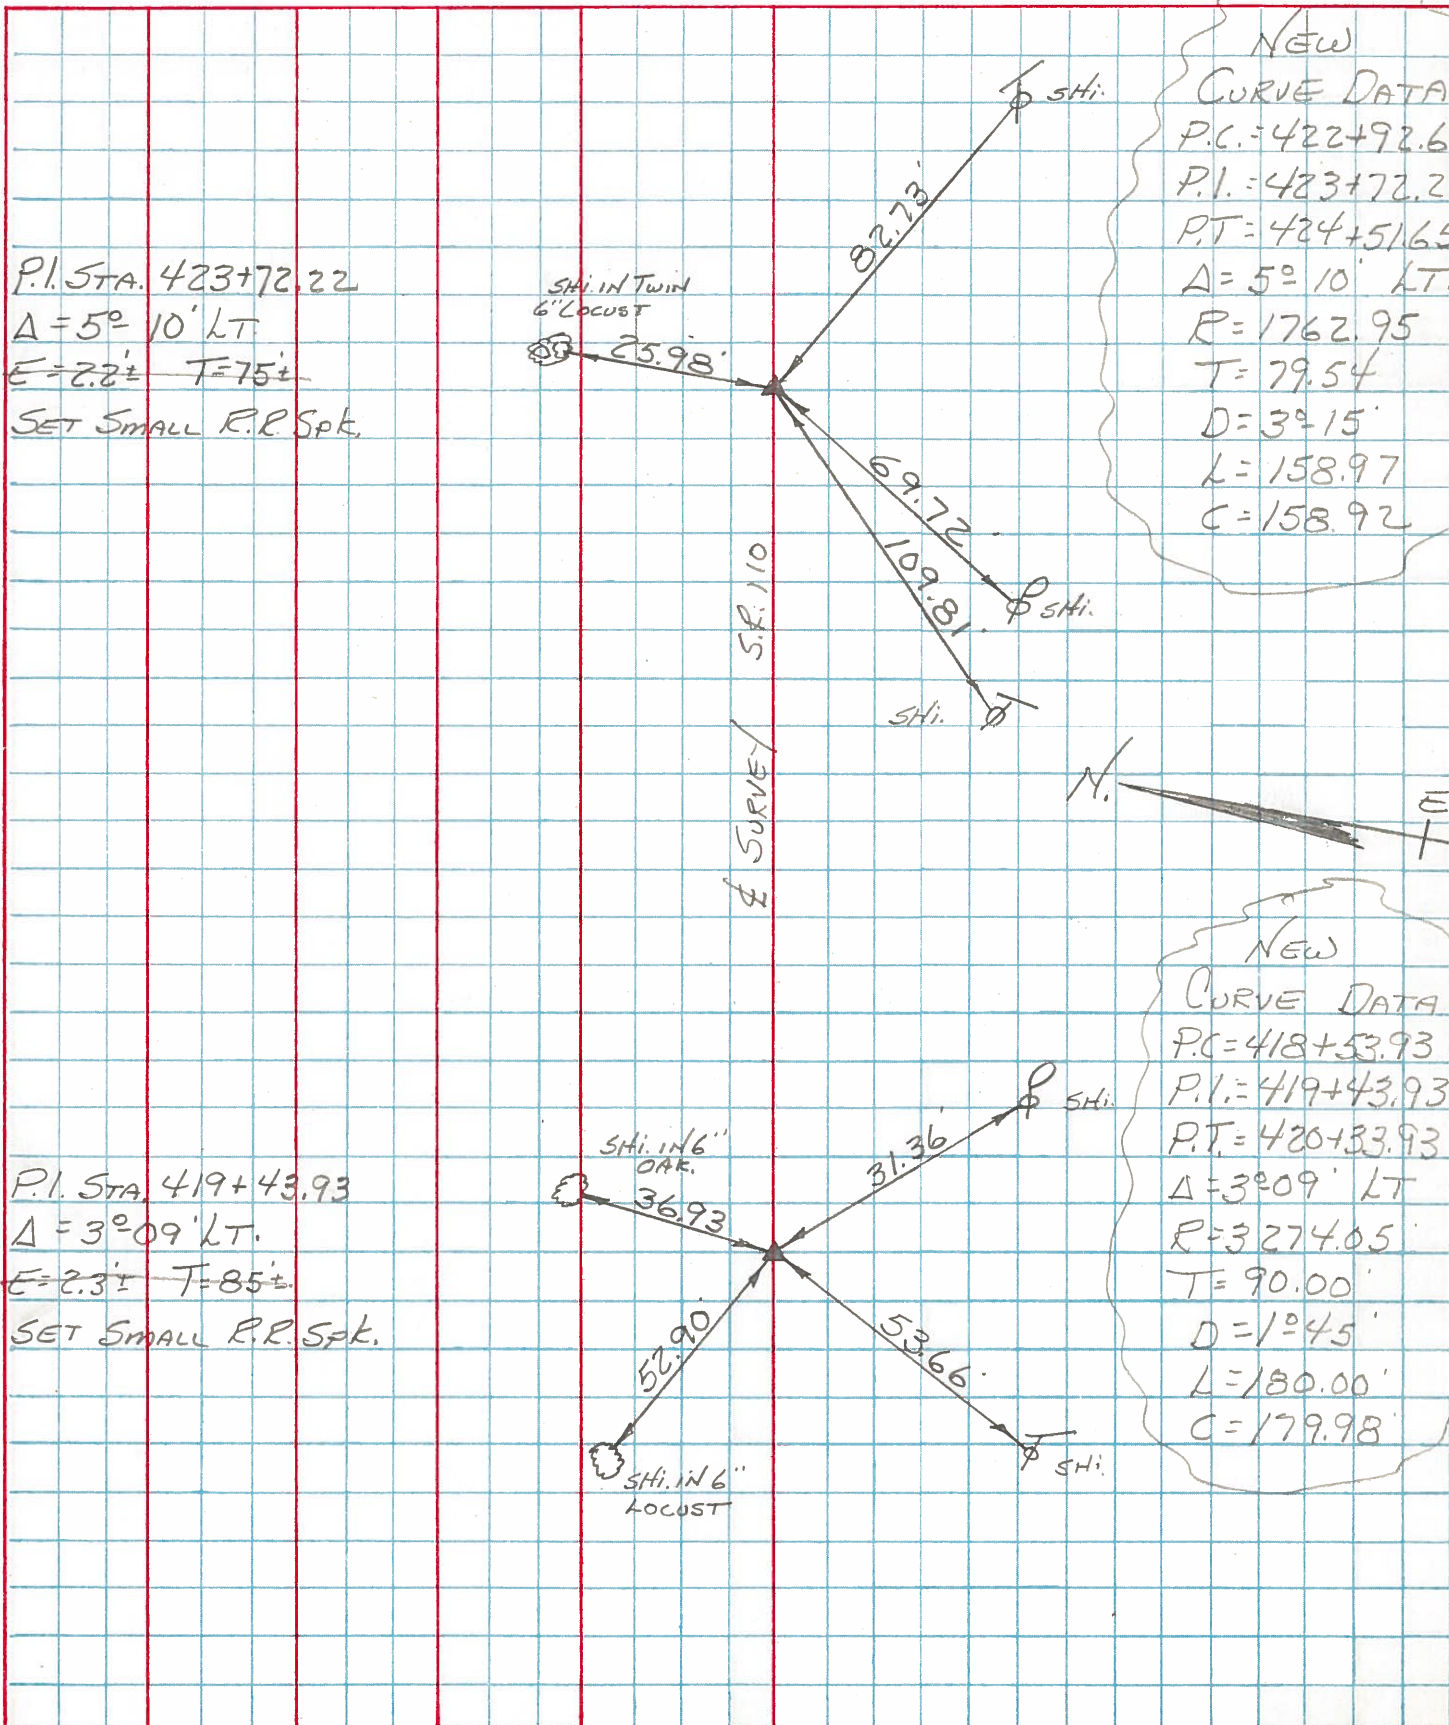

NEW  
 CURVE DATA  
 P.C. = 422+92.6  
 P.I. = 423+72.2  
 P.T. = 424+51.6  
 Δ = 5° 10' LT  
 R = 1762.95  
 T = 79.54  
 D = 3° 15'  
 L = 158.97  
 C = 158.92

NEW  
 CURVE DATA  
 P.C. = 418+53.93  
 P.I. = 419+43.93  
 P.T. = 420+33.93  
 Δ = 3° 09' LT  
 R = 3274.05  
 T = 90.00  
 D = 1° 45'  
 L = 180.00  
 C = 179.98

