

County HENRY S.R. 110

Township DAMASCUS

Section 7

T5N, R8E

Personnel HOFFMAN


LOEHRKE

HOUSEHOLDER

Date 4-26-82

Weather \_\_\_\_\_

Temp. +76°

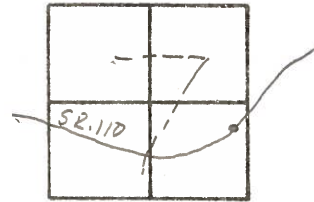


P.O.T. 437+85.11  
 F.D.R. SPK. ON  $\phi$   
 (ORIGIN UNKNOWN)


0.7' Pt. of  $\phi$   
 9.5' N. of E.P.  
 8.3' S. to E.P.

OLD ALIGNMENT

SET P.K.  
 5-19-82  
 S.W.H.

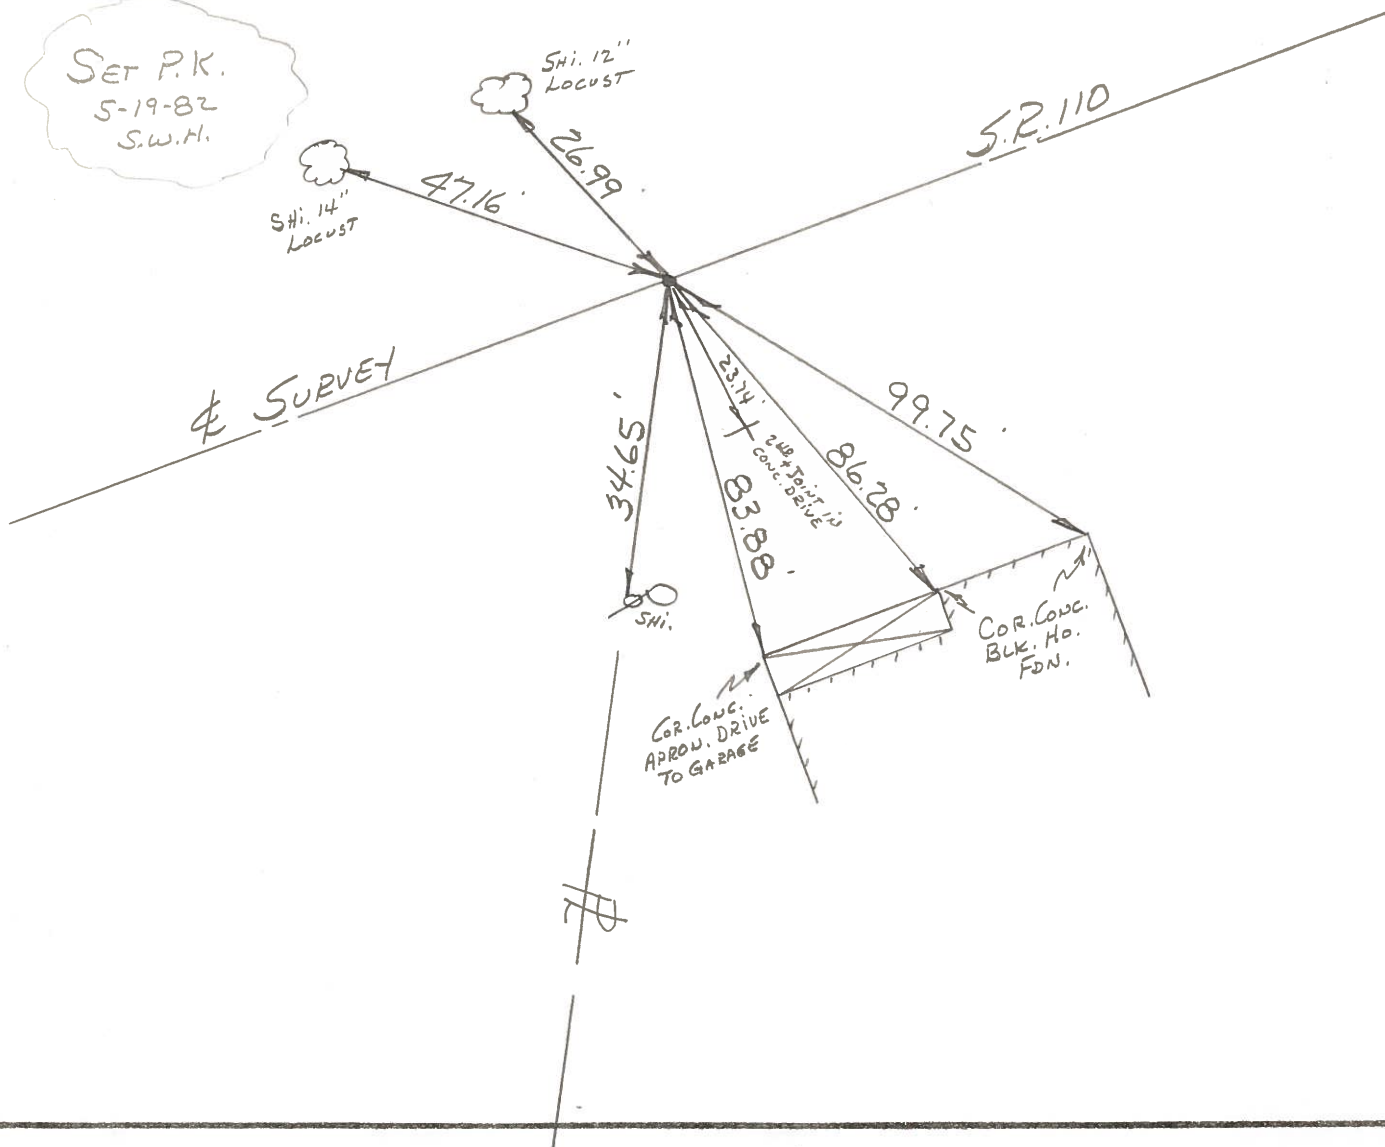

PERSONNEL	TITLE	PERSONNEL	TITLE	COUNTY	<u>HENRY</u>	DATE	<u>4-3-73</u>
<u>BUENSIDE</u>				S. R.	<u>110</u>	WEATHER	<u>CLOUDY</u>
<u>SMITH</u>				SEC.		TEMP.	<u>+42°</u>
<u>BOWERS</u>				DESCRIPTION <u>⊥ SURVEY CONTROL TIES</u>			
<u>MEAD</u>				JOB NO. _____			

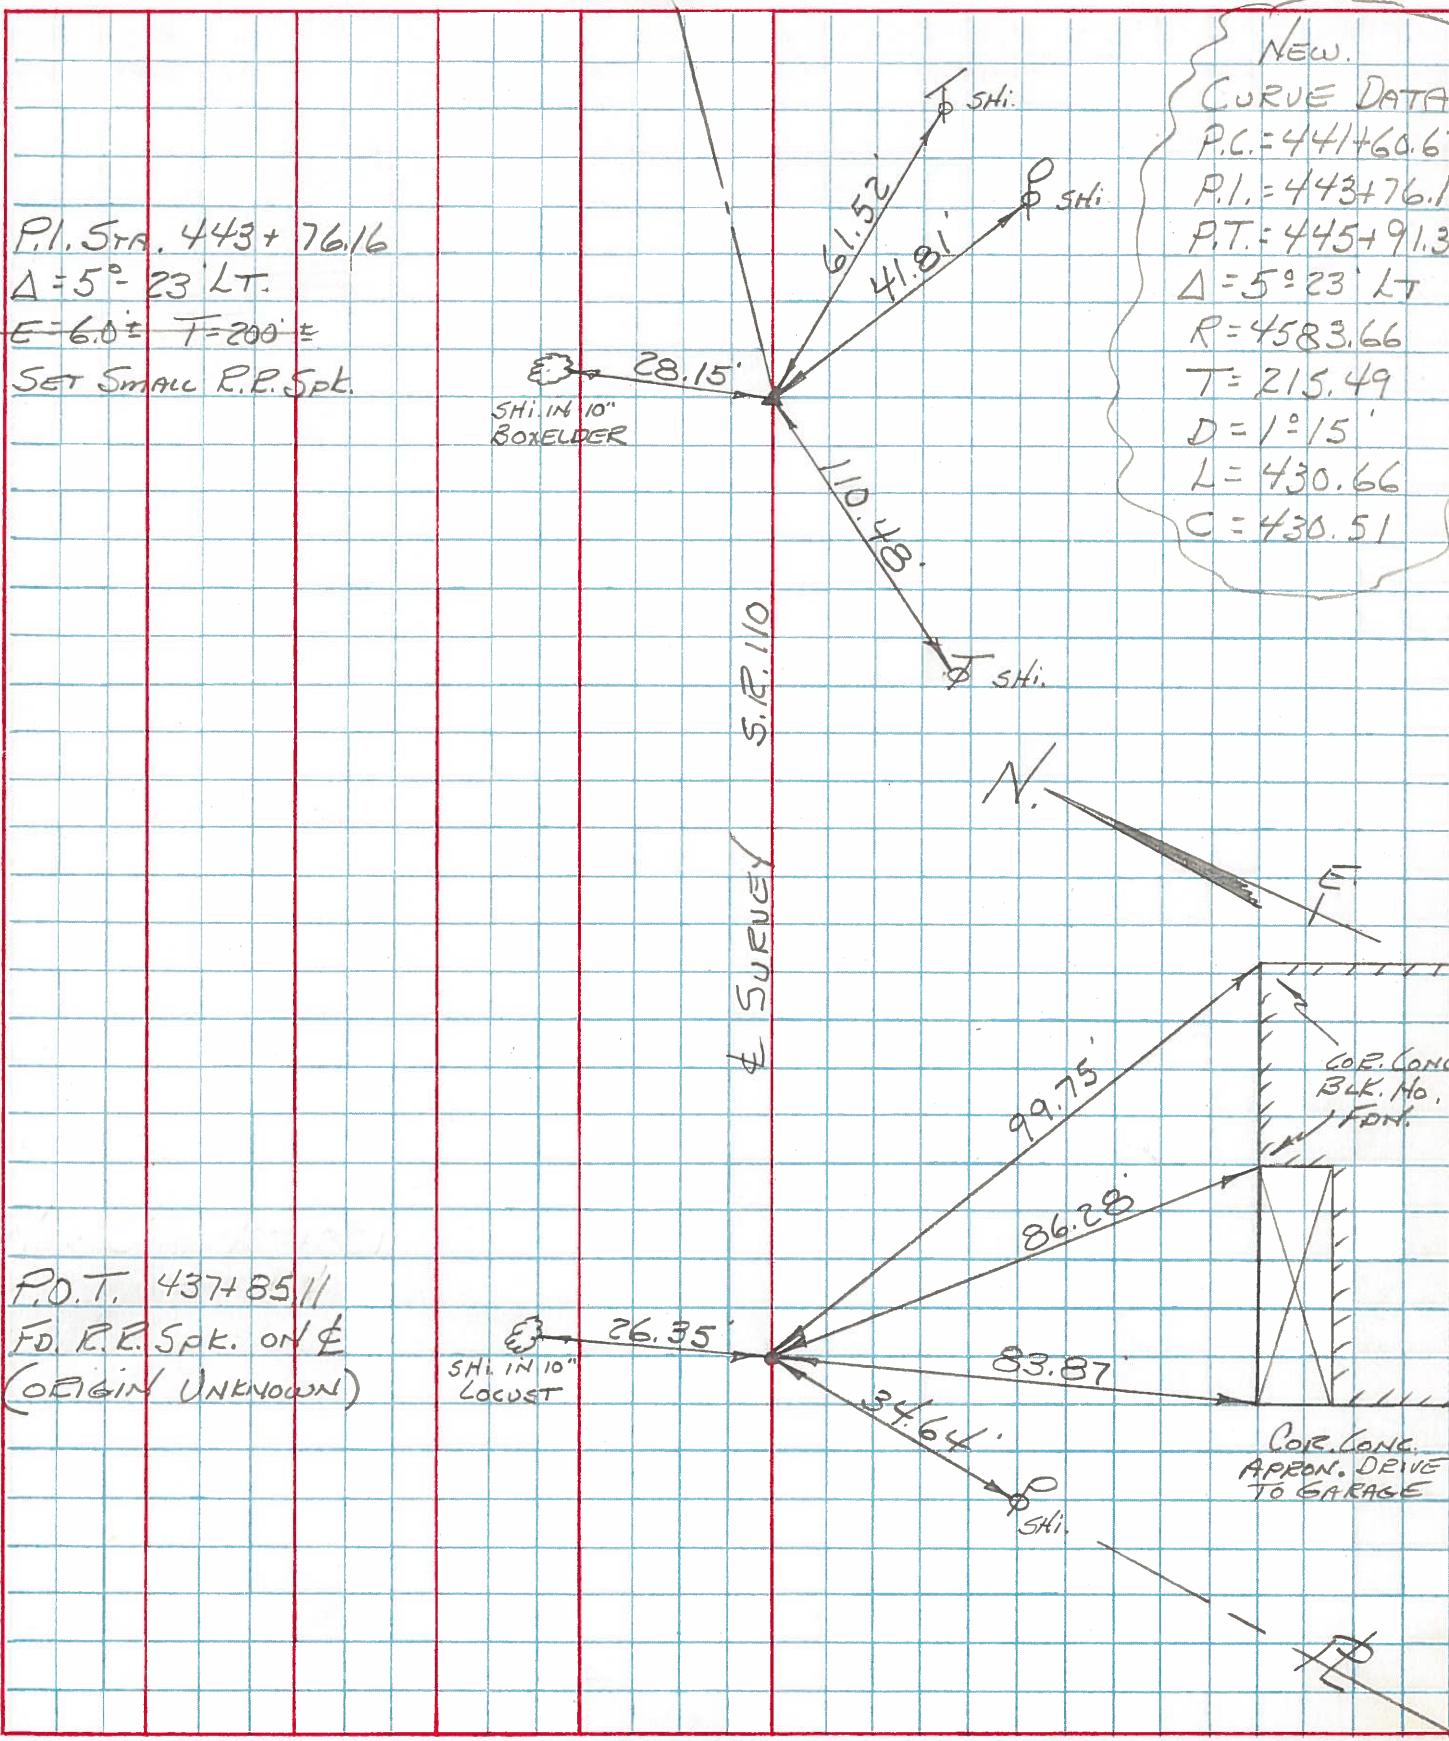

P.O.T. 437+85.11  
 FD. R.E. Spt. ON ⊥  
 (ORIGIN UNKNOWN)