


O.D.O.T. DISTRICT 2 SURVEY OFFICE (USE ONLY)


PERSONNEL _____ REFERENCE NO. 17 D SHEET 29 OF 61
 NOTES NIESE DATE 3/25/24 ROUTE SR 110
 H.C. MILLER WEATHER CLEAR COUNTY HENRY
 R.C. RHOADES TEMP. 60° TOWNSHIP DAMASCUS
 _____ SECTION 7
 DWG BY RHOADES PID 114846 T 5 N R 8 E

TYPE MONUMENT MONBOX W/1" IPIN
 ON SURFACE - ~~BELOW~~ ON
 OFFSET Q PAVEMENT ON LT : RT
11.1' TO RT EDGE PAVEMENT
 STATION: 433+40.01

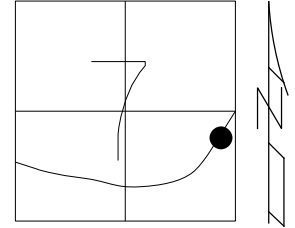

HORZ. DATUM: NAD83 2011 GEOID: NAVD88 2018
 GRID: NORTHING: 636671.926 EASTING: 1561866.682

HEN LPD
 N: 493599.187
 E: 196313.021

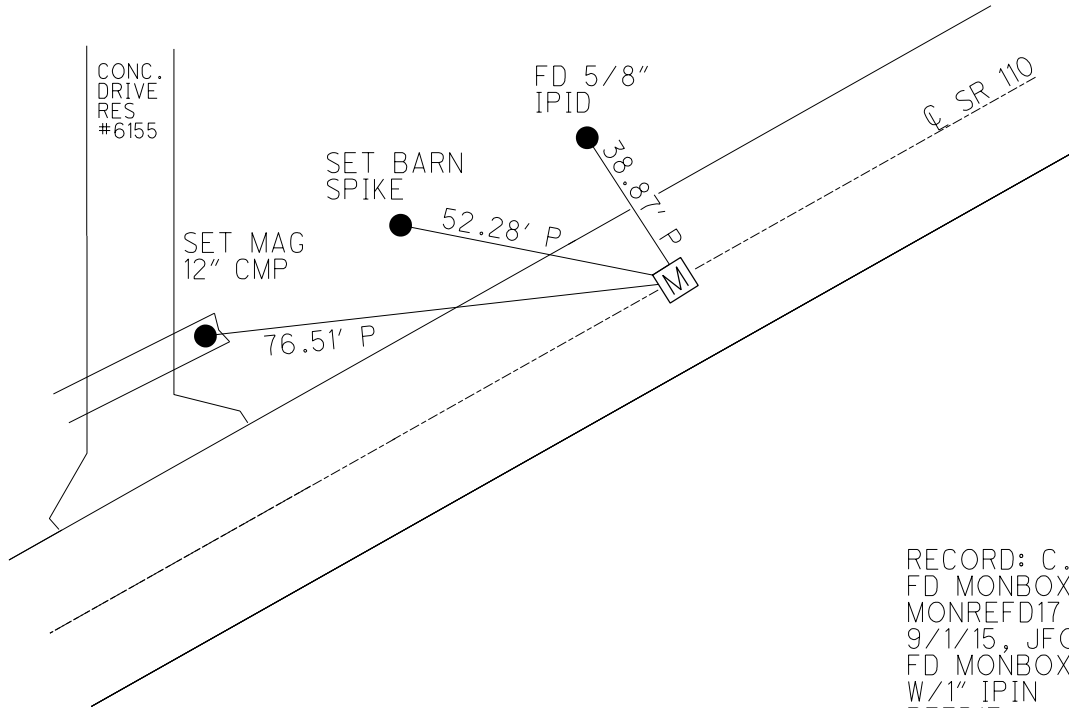


RECORD: C.S.
 FD MONBOX
 MONREFD17
 9/1/15, JFO
 FD MONBOX
 W/1" IPIN
 REF D17
 12/22/21, DSA
 CKREFD17
 3/25/24, TDN


O.D.O.T. DISTRICT 2 SURVEY OFFICE (USE ONLY)

PERSONNEL	REFERENCE NO.	<u>17D</u>	SHEET	<u>30</u>	OF	<u>58</u>
NOTES	<u>BARNHISEL</u>	DATE	<u>09/20/04</u>	ROUTE	<u>SR 110</u>	
H.C.	<u>CANTERBURY</u>	WEATHER	<u>CLEAR</u>	COUNTY	<u>HENRY</u>	
R.C.	<u>BARNHISEL</u>	TEMP.	<u>60°</u>	TOWNSHIP	<u>DAMASCUS</u>	
				SECTION	<u>07</u>	
				<u>T 5 N</u>	<u>R 8 E</u>	

TYPE MONUMENT MON. BOX W/IRON PIN
 ON SURFACE - ~~BELOW~~ ON
~~LEFT~~ - Q PAV'T - ~~RIGHT~~ ON
11.1' TO RT EDGE PAVEMENT
 S.L.M. 441+62
 Grid: Northing: 636671.897 Easting: 1561866.603

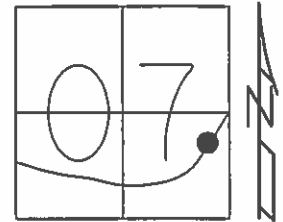

RECORD: CS.
 PLAN STA: 440+42.91
 NOTE: THIS MON. BOX SET
 DURING NEW CONST. IN 1988
 GPS, MONREFD17
 09/01/15, JFO
 FD MON BOX COVERED
 08/03/16, JFO

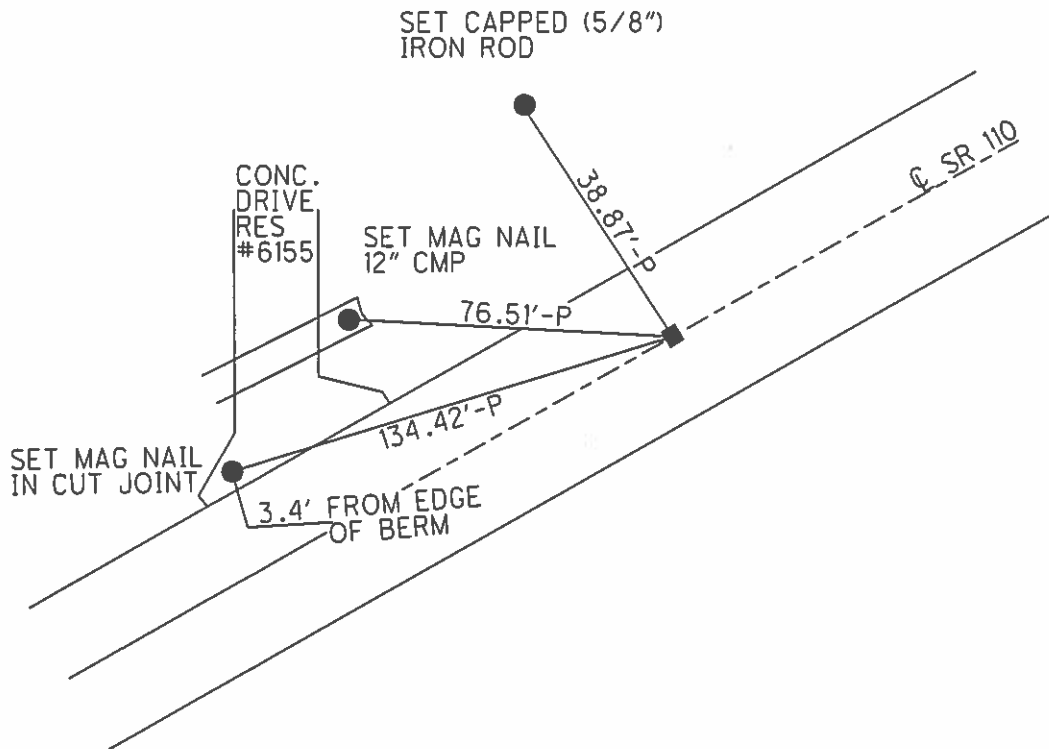

O.D.O.T. DISTRICT 2 SURVEY OFFICE

PERSONNEL _____

REFERENCE NO. ¹⁹⁸⁹ 170

SHEET 15 OF 37

NOTES BARNHISEL

DATE 09/20/04

ROUTE S.R. 110

H.C. CANTERBURY

WEATHER CLEAR

COUNTY HENRY

R.C. BARNHISEL

TEMP. +60°

TOWNSHIP DAMASCUS

SECTION 07

T 5 N R 8 E


TYPE MONUMENT MON BOX W/IRON PIN

ON SURFACE - ~~BELOW~~ YES

~~LEFT~~ - Q PAV'T - ~~RIGHT~~ YES

11.1' TO RT EDGE PAVEMENT

S.L.M. 441+62

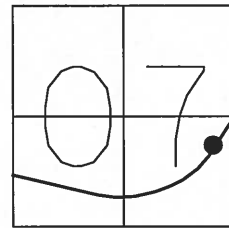

RECORD: CS.
PLAN STA: 440+42.91

NOTE: THIS MON. BOX SET DURING
NEW CONST. IN 1988.

