

County HENRY S.R. 110

Date 4-26-82

Township DAMASCUS

Weather _____

Section 7


Temp. +76

T5N, R8E

Personnel HOFFMAN

LOEHRKE

HOUSEHOLDER

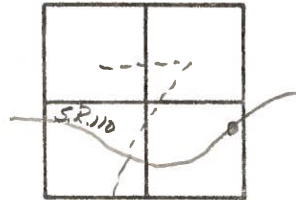

CURVE DATA:


Proj. STA. 445+04

- P.I. = 443+76.16
- P.C. = 441+60.67
- P.T. = 445+91.33
- Δ = 5°23' Lt.
- R = 4583.66
- T = 215.49
- D = 1°15'
- L = 430.66


OLD ALIGNMENT

- SMALL R.R. SPK.
- 6.3' Rt. of ♀
- 2.2' S. of E.P.
- 149' N of E.P.

SET P.K./WASHER
5-19-82
S.W.H.

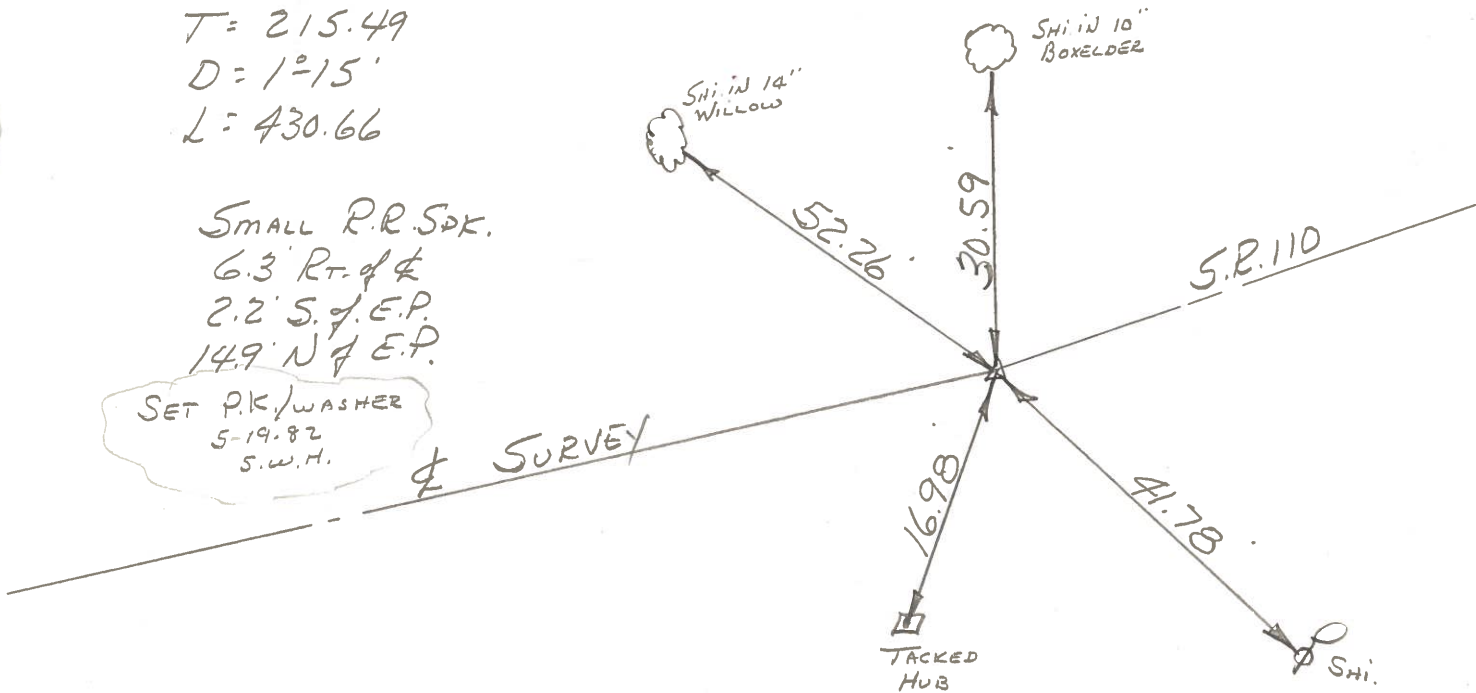

PERSONNEL	TITLE	PERSONNEL	TITLE	COUNTY	<u>HENRY</u>	DATE	<u>4-3-73</u>
<u>BUENSIDE</u>				S. R.	<u>110</u>	WEATHER	<u>CLOUDY</u>
<u>SMITH</u>				SEC.		TEMP.	<u>+42°</u>
<u>BOWERS</u>				DESCRIPTION <u>⊥ SURVEY CONTROL TIES</u>			
<u>MEAD</u>				JOB NO. _____			

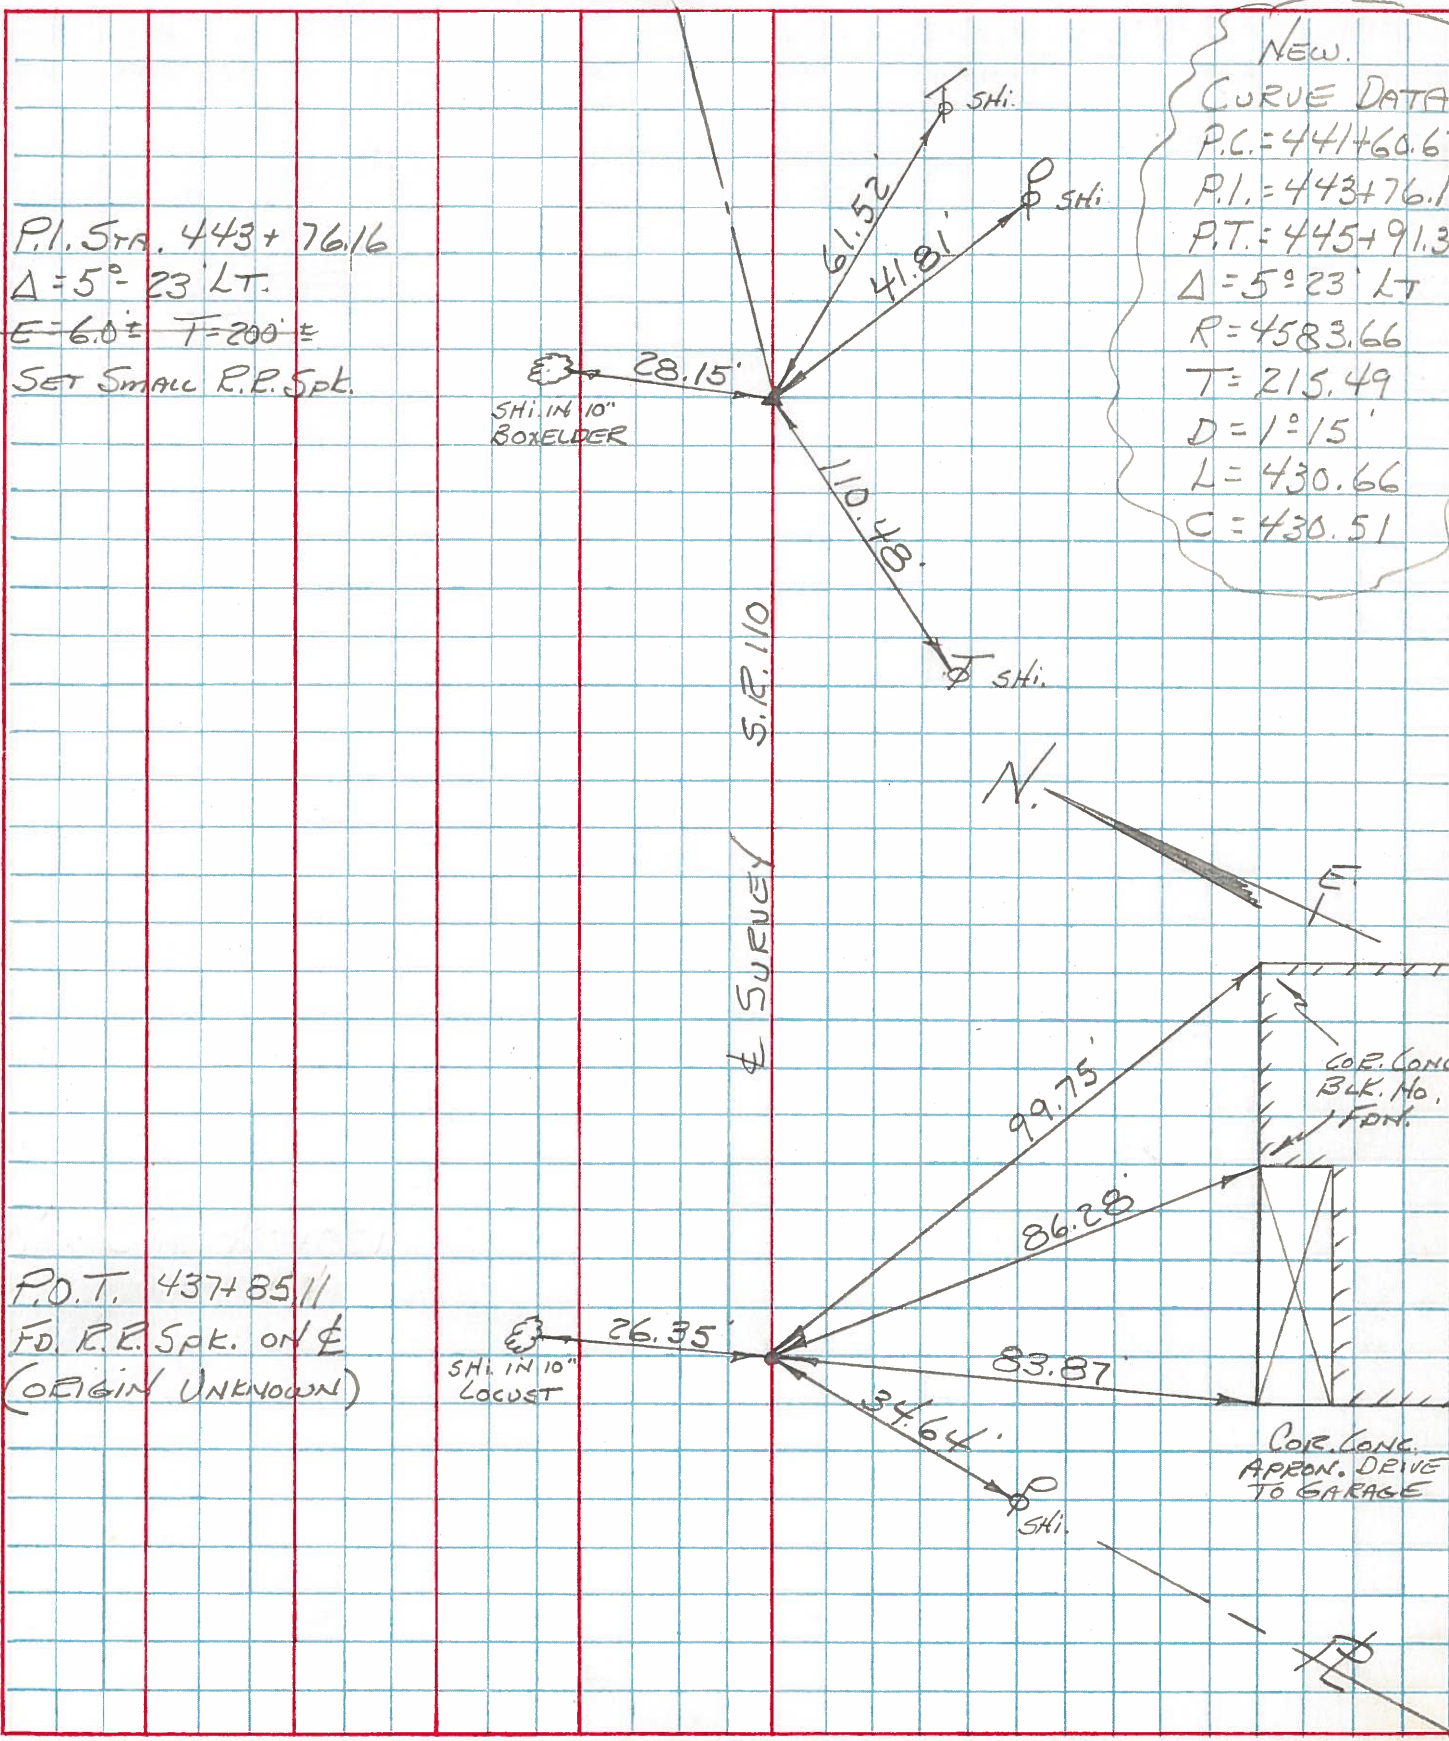

P.I. Sta. 443+76.16
 $\Delta = 5^\circ 23' LT.$
 $E = 6.0' \pm$ $T = 200' \pm$
 SET SMALL R.P. Spt.

P.O.T. 437+85.11
 FD. R.P. Spt. ON ⊥
 (ORIGIN UNKNOWN)

NEW.
 CURVE DATA
 P.C. = 441+60.6
 P.I. = 443+76.1
 P.T. = 445+91.3
 $\Delta = 5^\circ 23' LT$
 $R = 4583.66$
 $T = 215.49$
 $D = 1^\circ 15'$
 $L = 430.66$
 $C = 430.51$

COR. CONC.
 BLK. No. _____
 1 FT. H.

COR. CONC.
 APRON. DRIVE
 TO GARAGE