

O.D.O.T. DISTRICT 2 SURVEY OFFICE (USE ONLY)

PERSONNEL

REFERENCE NO. 17 F


SHEET 31 OF 61

NOTES NIESE DATE 3/25/24
H.C. MILLER WEATHER CLEAR
R.C. RHOADES TEMP. 60°

ROUTE SR 110
COUNTY HENRY
TOWNSHIP DAMASCUS
SECTION 7
T 5 N R 8 E

DWG BY RHOADES PID 114846


TYPE MONUMENT MONBOX W/1" IPIN
ON SURFACE - ~~BELOW~~ ON
OFFSET ☉ PAVEMENT ON LT : RT
11.3' TO RT EDGE PAVEMENT
STATION: 441+04.99

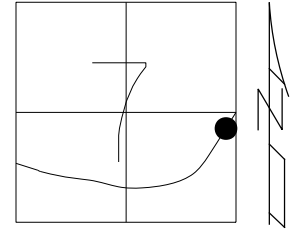

HORZ.DATUM: NAD83 2011 GEOID: NAVD88 2018
GRID: NORTHING: 637319.264 EASTING: 1562272.587

RECORD: T.S.
FD MONBOX
MONREFF17
9/01/15, JFO
FD MONBOX
W/1" IPIN
REFF17
12/22/21, DSA
CKREFF17
3/25/24, JAM


HEN LPD
N: 494253.913
E: 196707.005

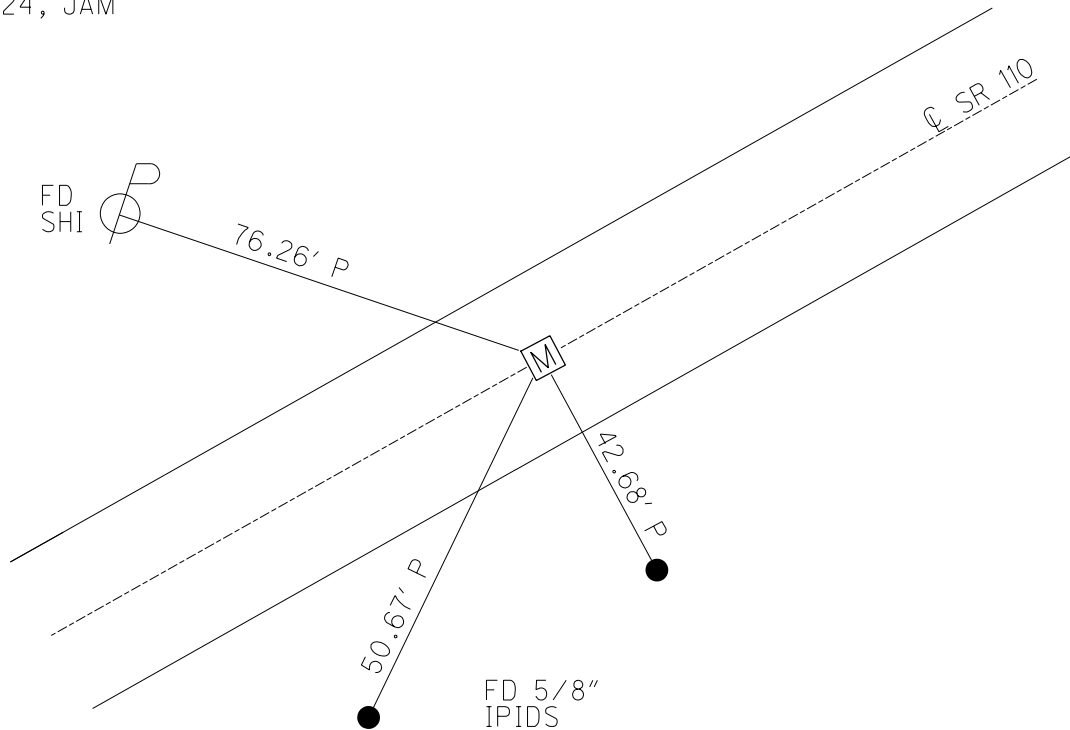


O.D.O.T. DISTRICT 2 SURVEY OFFICE (USE ONLY)

PERSONNEL _____ REFERENCE NO. 17F SHEET 32 OF 58
 NOTES BARNHESEL DATE 09/20/04 ROUTE SR 110
 H.C. CANTERBURY WEATHER CLEAR COUNTY HENRY
 R.C. BARNHESEL TEMP. 65° TOWNSHIP DAMASCUS
 _____ SECTION 07
 _____ T 5 N R 8 E

TYPE MONUMENT MON. BOX W/IRON PIN
 ON SURFACE - ~~BELOW~~ _____ ON _____
~~LEFT~~ - Q PAV'T - ~~RIGHT~~ _____ ON _____
11.3' TO RT EDGE PAVEMENT
 S.L.M. _____ 449+27
 Grid: Northing: 637319.187 Easting: 1562272.687

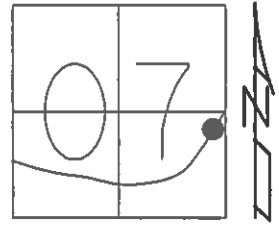

RECORD: TS.
 PLAN STA: 448+10.69
 NOTE: THIS MON. BOX SET
 DURING NEW CONST. IN 1988
 GPS, MONREFF17
 09/01/15, JFO
 FD MON BOX COVERED
 08/03/16, JFO

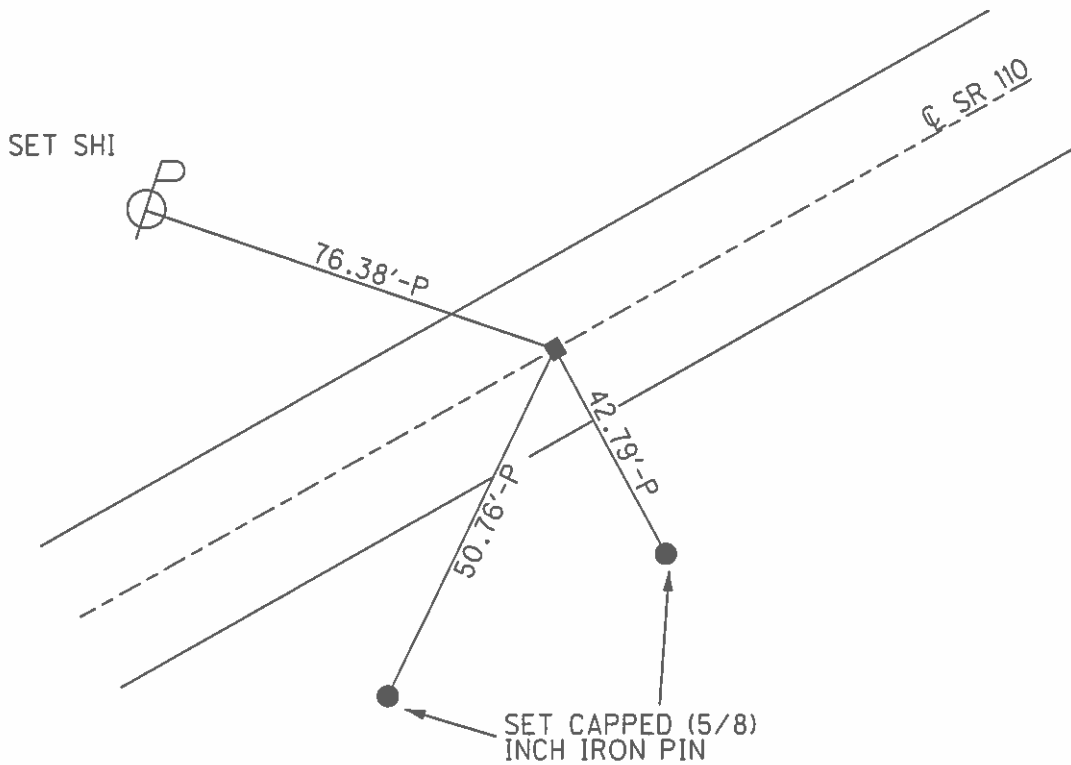

O.D.O.T. DISTRICT 2 SURVEY OFFICE

PERSONNEL

REFERENCE NO. ¹⁹⁸⁸ ~~17F~~

SHEET 17 OF 37

NOTES BARNHISEL

DATE 09/20/04

ROUTE S.R. 110

H.C. CANTERBURY

WEATHER CLEAR

COUNTY HENRY

R.C. BARNHISEL

TEMP. +65°

TOWNSHIP DAMASCUS

SECTION 07

T 5 N R 8 E


TYPE MONUMENT MON BOX W/IRON PIN

ON SURFACE - ~~BELOW~~ YES

~~LEFT - Q~~ PAV'T - ~~RIGHT~~ YES

11.3' TO RT EDGE PAVEMENT

S.L.M. 449+27

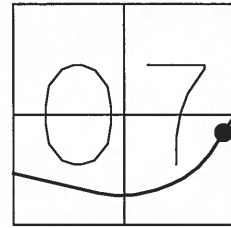

RECORD: TS
PLAN STA: 448+10.69

NOTE: THIS MON. BOX SET DURING
NEW CONST. IN 1988.

SET SHI
SE/S



76.38'-P

S.R. 110

PAVEMENT

42.79'-P

SET CAPPED (5/8)
INCH IRON PIN

50.76'-P

SET CAPPED (5/8)
INCH IRON PIN