

County HENRY S.R. 110

Date 4-26-82

Township DAMASCUS

Weather _____

Section 8


Temp. +76°

TSN, RBE

Personnel HOFFMAN

LOEHRICE

HOUSEHOLDER

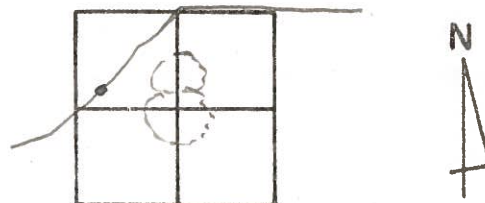

P.I. STA. 450+36.14 $\Delta = 3^{\circ}48' LT.$


Proj. STA. 451+65±

FD. 3/4" I. ROD 1.8' RT. OF
CTR PAVE. § 9.7 TO N.E.P.
§ 7.3 TO S.E.P.

OLD ALIGNMENT

NOTE I. ROD WAS SET BY
H. HELBERG 11-23, 25-60 §
USED BY C. JINGLE AUG. 7-61
SURVEYS RECORDED IN HEN.
CO. COURT HOUSE
VOL. 7 PAGE 211 §
VOL. 7 PAGE 241


SET P.K.
5-19-82
S.W.H.

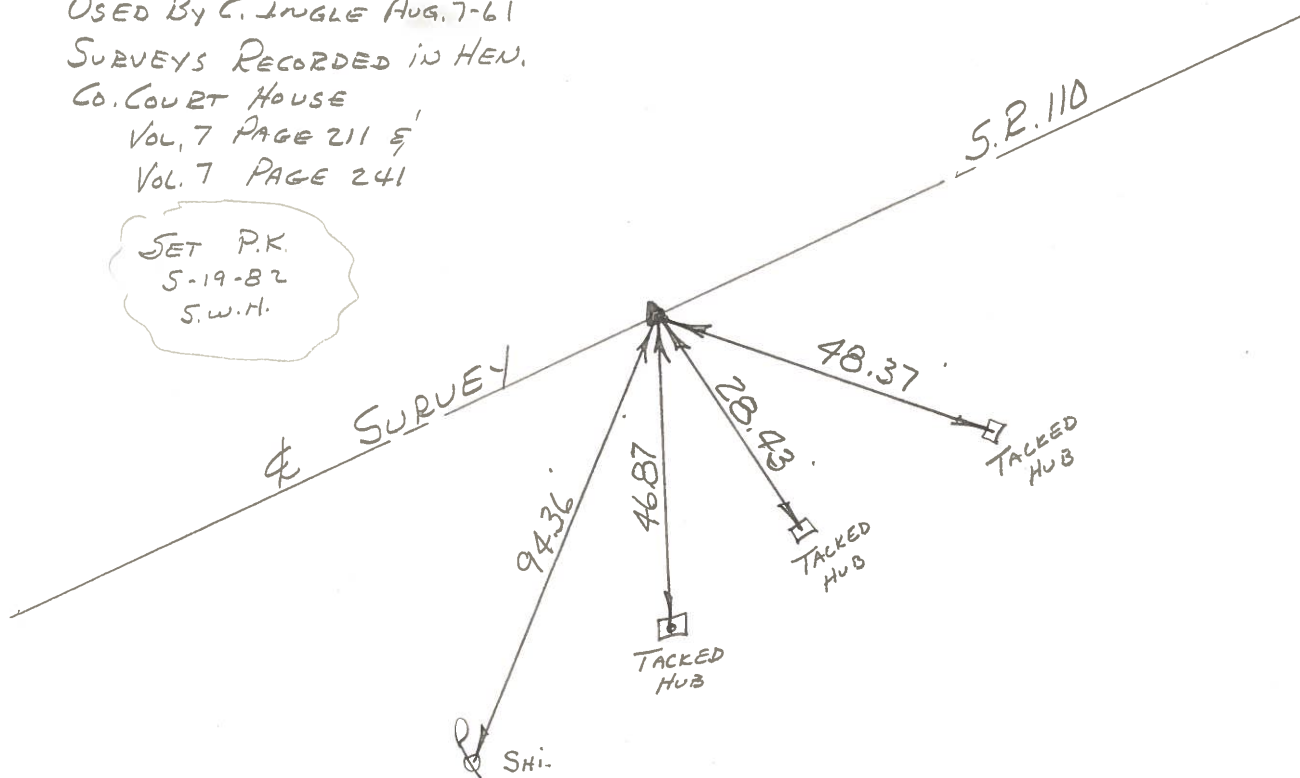

PERSONNEL BUENSIDE
 TITLE SMITH
 PERSONNEL BOWERS
 TITLE MEAD

COUNTY HENRY
 DATE 4-5-73
 S. R. 110
 WEATHER CLOUDY
 SEC. TEMP. +35

DESCRIPTION \$ SURVEY CONTROL TIES JOB NO.

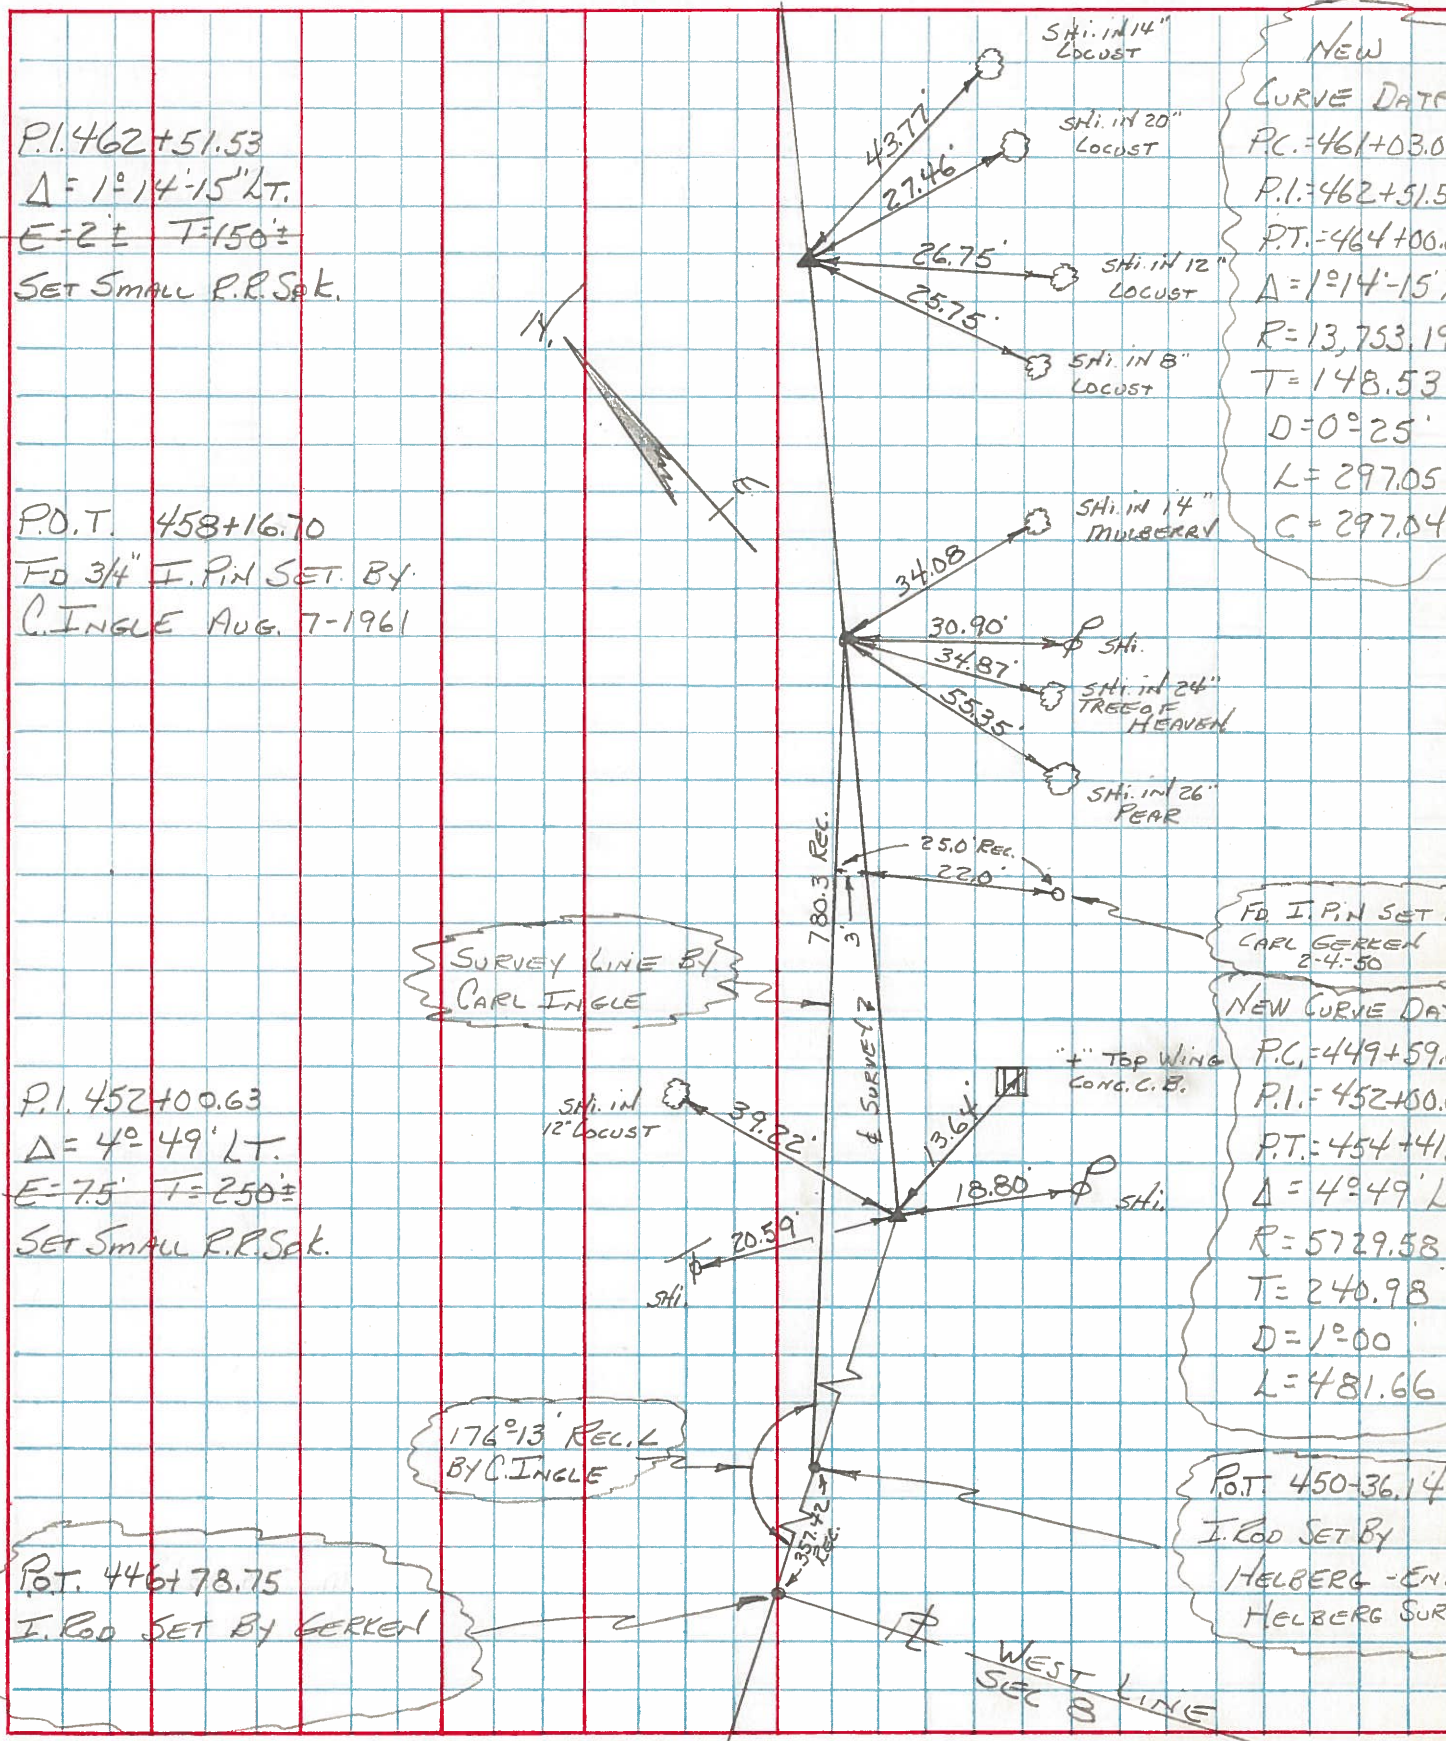

P.I. 462+51.53
 $\Delta = 1^\circ 14' 15''$ LT.
 $E = 2'$ $T = 150'$
 SET SMALL R.R. S&K.

P.O.T. 458+16.70
 FD 3/4" I.P.I.N SET BY
 C. INGLE AUG. 7-1961

P.I. 452+00.63
 $\Delta = 4^\circ 49'$ LT.
 $E = 7.5'$ $T = 250'$
 SET SMALL R.R. S&K.

P.O.T. 446+78.75
 I. ROD SET BY GERKEN

NEW CURVE DATA
 P.C. = 461+03.00
 P.I. = 462+51.5
 P.T. = 464+00.6
 $\Delta = 1^\circ 14' 15''$
 $R = 13,753.19'$
 $T = 148.53'$
 $D = 0^\circ 25'$
 $L = 297.05$
 $C = 297.04$

FD I.P.I.N SET BY
 CARL GERKEN
 2-4-50

NEW CURVE DATA
 P.C. = 449+59.6
 P.I. = 452+00.6
 P.T. = 454+41.6
 $\Delta = 4^\circ 49' L$
 $R = 5729.58'$
 $T = 240.98$
 $D = 1^\circ 00'$
 $L = 481.66$

P.O.T. 450-36.14
 I. ROD SET BY
 HELBERG - ENCL
 HELBERG SURV

SURVEY LINE BY
 CARL INGLE


176°13' REC. L
 BY C. INGLE

WEST LINE
 SEC 8

PERSONNEL	TITLE	PERSONNEL	TITLE
BURNSIDE			
SMITH			
BOWERS			
MEAD			

COUNTY HENRY DATE 4-3-73
 S. R. 110 WEATHER CLOUDY
 SEC. TEMP. +42°

DESCRIPTION $\&$ SURVEY CONTROL TIES LEFT CENTER LINE RIGHT JOB NO.

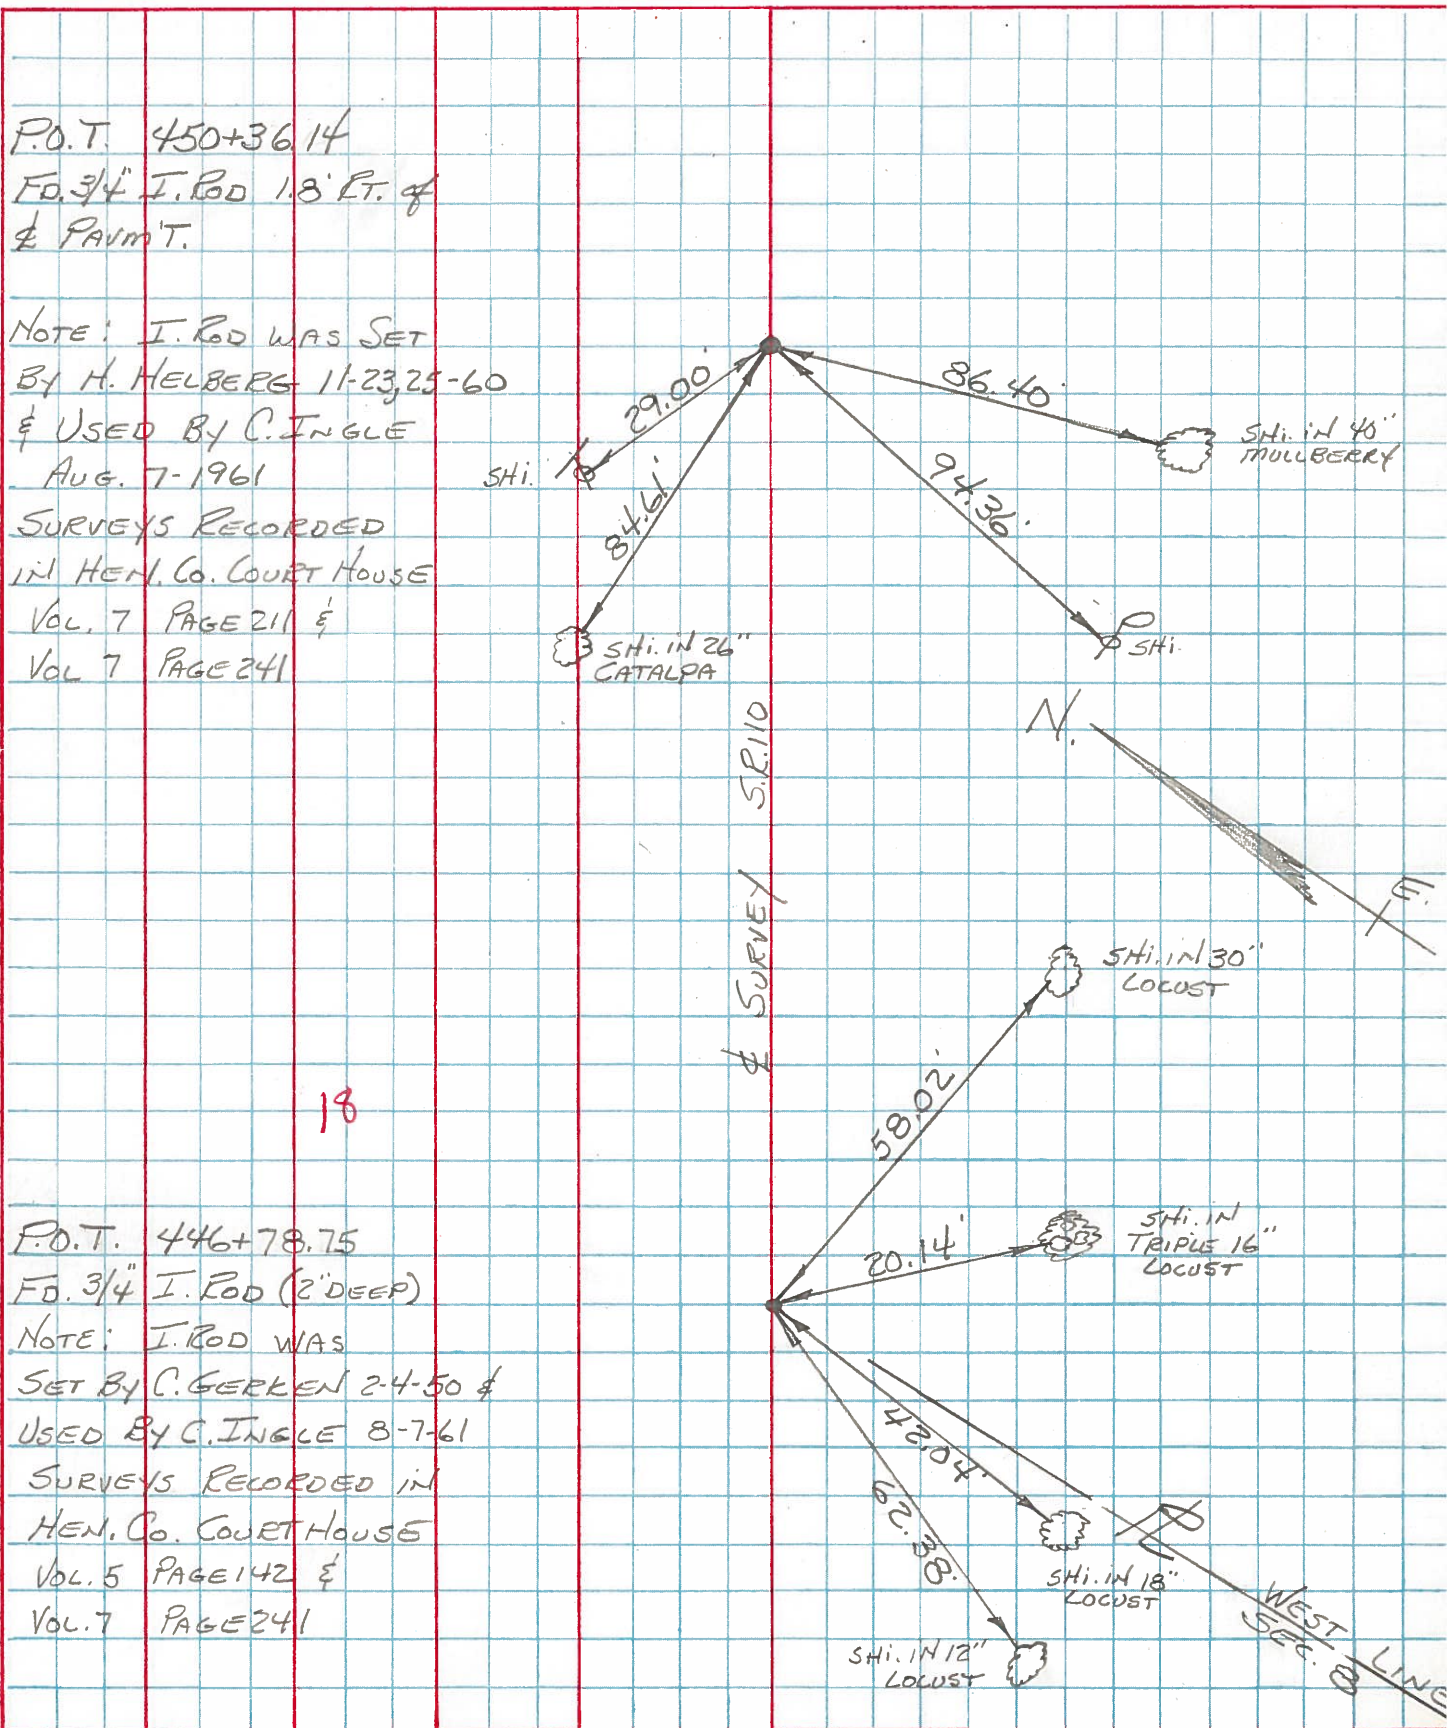

18