


O.D.O.T. DISTRICT 2 SURVEY OFFICE (USE ONLY)

PERSONNEL	REFERENCE NO. <u>17 I</u>	SHEET <u>36</u> OF <u>61</u>
NOTES <u>NIESE</u>	DATE <u>3/25/24</u>	ROUTE <u>SR 110</u>
H.C. <u>MILLER</u>	WEATHER <u>CLEAR</u>	COUNTY <u>HENRY</u>
R.C. <u>RHOADES</u>	TEMP. <u>60°</u>	TOWNSHIP <u>DAMASCUS</u>
		SECTION <u>8</u>
DWG BY <u>RHOADES</u>	PID <u>114846</u>	T <u>5</u> N R <u>8</u> E


TYPE MONUMENT MONBOX W/1" IPIN
 ON SURFACE - ~~BELOW~~ ON
 OFFSET \odot PAVEMENT ON LT : RT
8.7' TO RT EDGE PAVEMENT
 STATION: 452+23.57

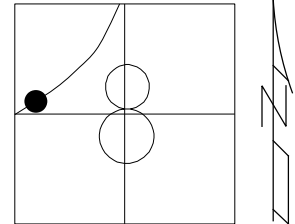

HORZ. DATUM: NAD83 2011 GEOID: NAVD88 2018
 GRID: NORTHING: 638194.886 EASTING: 1562964.358

RECORD: P.C.
 FD MONBOX
 MONREF117
 9/01/15, JFO
 FD MONBOX
 W/1" IPIN
 REF117
 12/28/21, DSA
 CKREF117
 3/25/24, JAM


HEN LPD
 N: 495142.148
 E: 197382.636

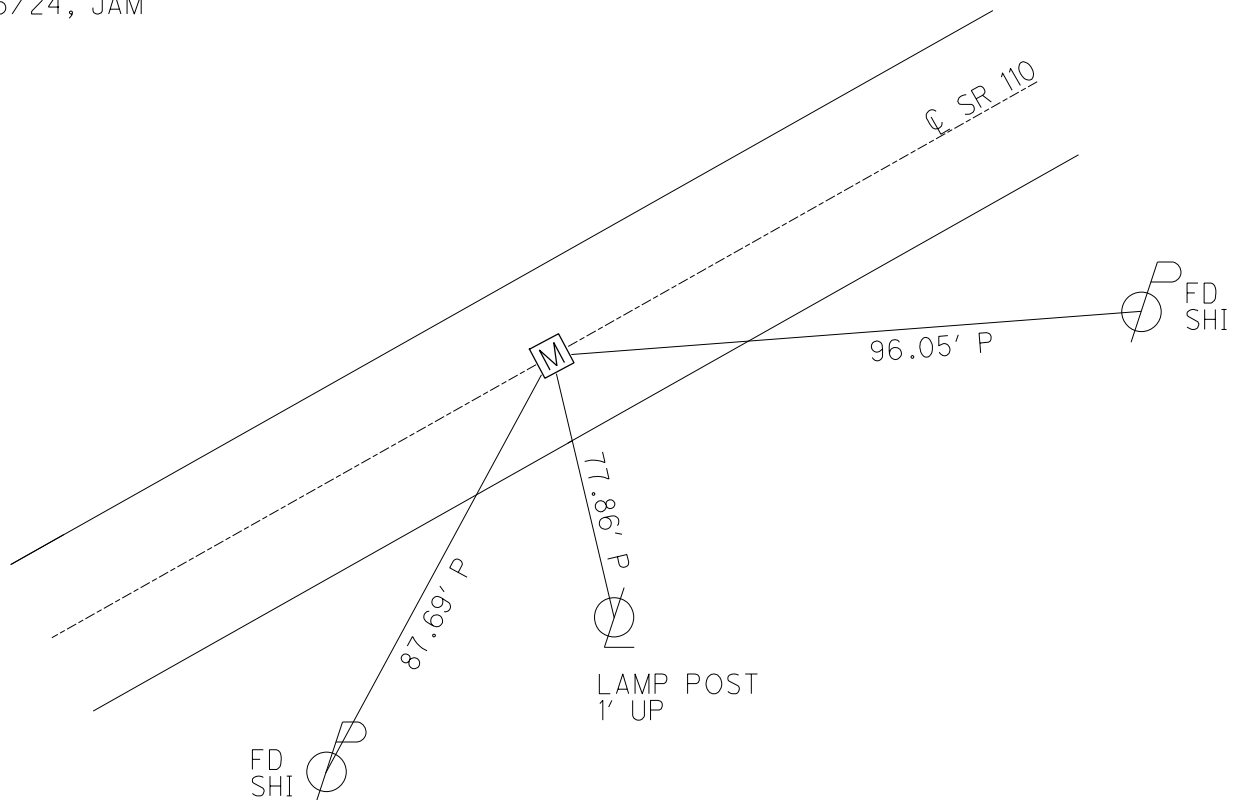


O.D.O.T. DISTRICT 2 SURVEY OFFICE (USE ONLY)

PERSONNEL _____ REFERENCE NO. 171 SHEET 37 OF 58
 NOTES CANTERBURY DATE 09/22/04 ROUTE SR 110
 H.C. CANTERBURY WEATHER CLEAR COUNTY HENRY
 R.C. HOOVER TEMP. 67° TOWNSHIP DAMASCUS
 _____ SECTION 08
 _____ T 5 N R 8 E

TYPE MONUMENT MON. BOX W/IRON PIN
 ON SURFACE - ~~BELOW~~ _____ ON _____
 LEFT - C PAV'T - ~~RIGHT~~ _____ ON _____
10.9' TO RT EDGE PAVEMENT
 S.L.M. 460+45
 Grid: Northing: 638194.894 Easting: 1562964.373

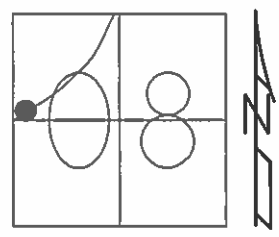

RECORD: PC
 PLAN STA: 459+29.10
 NOTE: THIS MON. BOX SET
 DURING NEW CONST. IN 1988
 GPS, MONREF117
 09/01/15, JFO
 FD MON BOX COVERED
 08/03/16, JFO

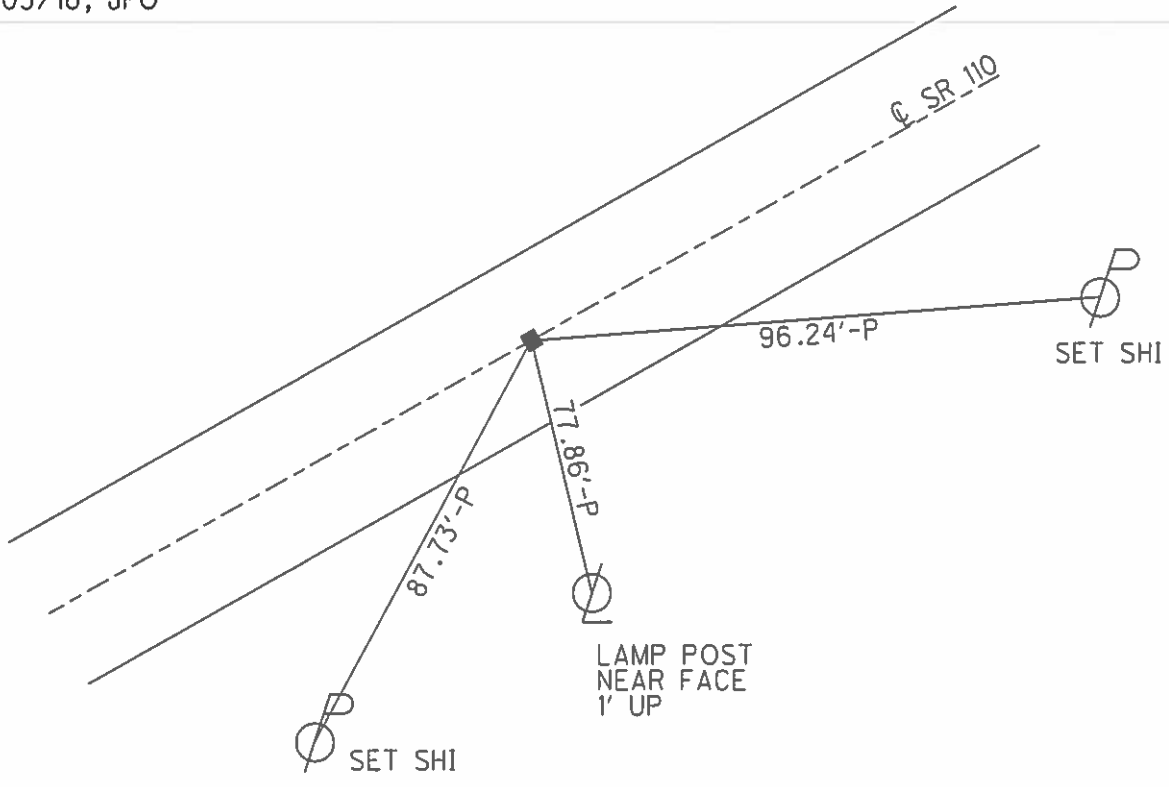

O.D.O.T. DISTRICT 2 SURVEY OFFICE

PERSONNEL _____

REFERENCE NO. ¹⁹⁸⁸ 171

SHEET 20 OF 37

NOTES CANTERBURY

DATE 09/22/04

ROUTE S.R. 110

H.C. CANTERBURY

WEATHER CLEAR

COUNTY HENRY

R.C. HOOKER

TEMP. +67°

TOWNSHIP DAMASCUS

SECTION 08

T 5 N R 8 E


TYPE MONUMENT MON BOX W/IRON PIN

ON SURFACE - ~~BELOW~~ YES

~~LEFT - Q PAV'T - RIGHT~~ YES

10.9' TO RT EDGE PAVEMENT

S.L.M. 460+45

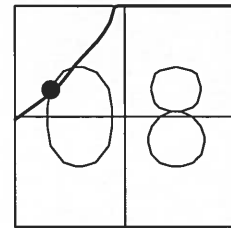

RECORD: PC
PLAN STA: 459+29.10

NOTE: THIS MON. BOX SET DURING
NEW CONST. IN 1988.

