

O.D.O.T. DISTRICT 2 SURVEY OFFICE (USE ONLY)

PERSONNEL

REFERENCE NO. 18 A

SHEET 38 OF 61

NOTES NIESE DATE 3/25/24

H.C. MILLER WEATHER CLEAR

R.C. RHOADES TEMP. 60°

ROUTE SR 110

COUNTY HENRY

TOWNSHIP DAMASCUS

SECTION 8

DWG BY RHOADES PID 114846

T 5 N R 8 E

TYPE MONUMENT MONBOX W/1" IPIN

ON SURFACE - ~~BELOW~~ ON

OFFSET ☉ PAVEMENT ON LT : RT

10.6' TO RT EDGE PAVEMENT


STATION: 454+87.85

HORZ. DATUM: NAD83 2011

GEOID: NAVD88 2018


GRID: NORTHING: 638399.889

EASTING: 1563130.031

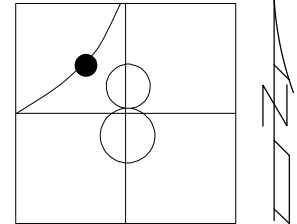

RECORD: P.T.
 FD MONBOX
 MONREFA18
 9/01/15, JFO
 FD MONBOX
 W/1" IPIN
 REFA18
 12/28/21, DSA
 CKREFA18
 3/25/24, JAM


HEN LPD
 N: 495350.173
 E: 197544.530

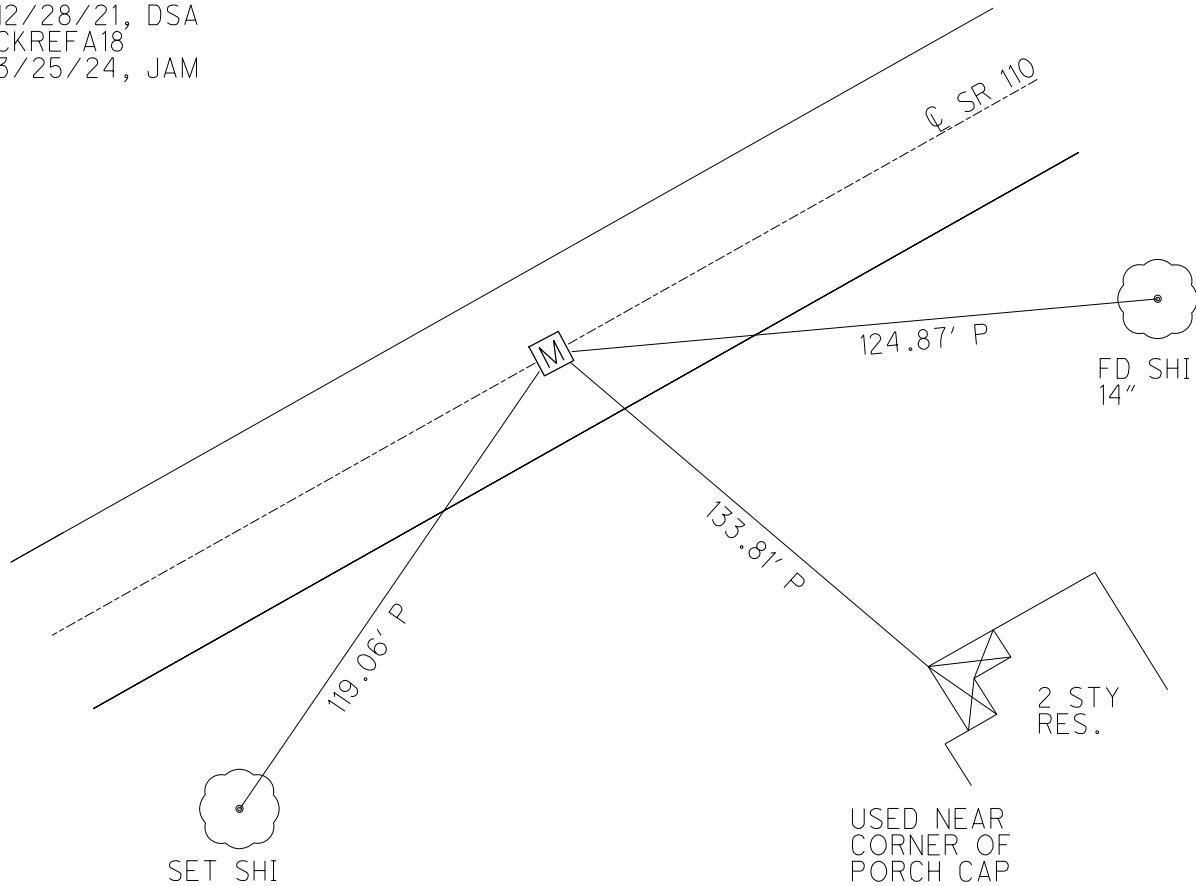

O.D.O.T. DISTRICT 2 SURVEY OFFICE (USE ONLY)


PERSONNEL	REFERENCE NO.	<u>18A</u>	SHEET	<u>39</u> OF <u>58</u>
NOTES <u>CANTERBURY</u>	DATE	<u>09/22/04</u>	ROUTE	<u>SR 110</u>
H.C. <u>CANTERBURY</u>	WEATHER	<u>CLEAR</u>	COUNTY	<u>HENRY</u>
R.C. <u>HOOKE</u>	TEMP.	<u>67°</u>	TOWNSHIP	<u>DAMASCUS</u>
			SECTION	<u>08</u>
			T <u>5</u> N R <u>8</u> E	

TYPE MONUMENT MON. BOX W/IRON PIN
 ON SURFACE - ~~BELOW~~ ON
~~LEFT~~ - CL PAV'T - ~~RIGHT~~ ON
10.6' TO RT. EDGE PAVEMENT
 S.L.M. 463+09

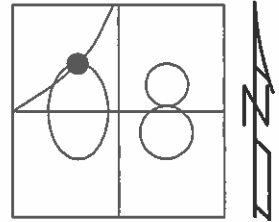

Grid: Northing: 638399.924 Easting: 1563130.028

RECORD: PT
 PLAN STA: 461+92.81
 NOTE: THIS MON. BOX SET
 DURING NEW CONST. IN 1988
 GPS, MONREFA18
 09/01/15, JFO
 FD MON BOX COVERED
 08/03/16, JFO

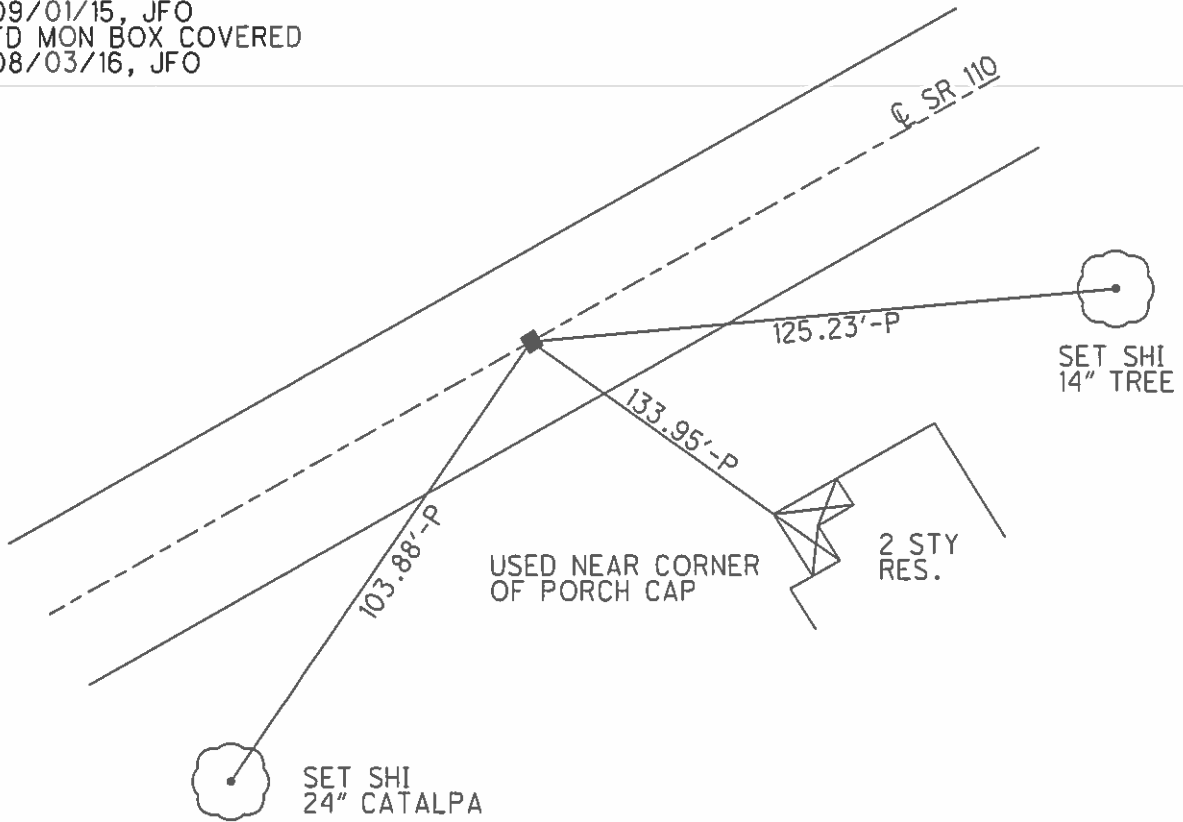

O.D.O.T. DISTRICT 2 SURVEY OFFICE

PERSONNEL _____

REFERENCE NO. ¹⁹⁸⁸ 18A

SHEET 22 OF 37

NOTES CANTERBURY

DATE 09/22/04

ROUTE S.R. 110

H.C. CANTERBURY

WEATHER CLEAR

COUNTY HENRY

R.C. HOOKER

TEMP. +67°

TOWNSHIP DAMASCUS

SECTION 08

T 5 N R 8 E


TYPE MONUMENT MON BOX W/IRON PIN

ON SURFACE - ~~BELOW~~ YES

~~LEFT~~ - Q PAV'T - ~~RIGHT~~ YES

10.6' TO RT EDGE PAVEMENT

S.L.M. 463+09

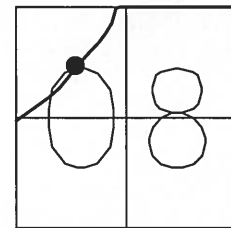

RECORD: PT
PLAN STA: 461+92.81

NOTE: THIS MON. BOX SET DURING
NEW CONST. IN 1988.

