

County HEURY S.R. 110

Date 4-27-82

Township DAMASCUS

Weather _____

Section B


Temp. +50

T5N, R8E

Personnel HOFFMAN

HOUSEHOLDER

LOEHRKE

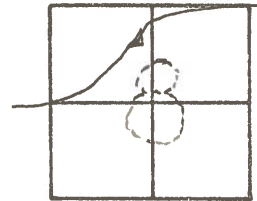

P.I. 462+51.53
 $\Delta = 1^\circ - 14' - 15''$ LT.
SET SMALL P.R. SPK.
2.4' Rt of ϕ
11.3' N. to E.P.
6.4' S. to E.P.


$R = 13,753.19$

$T = 148.53$

$D = 0^\circ - 25'$

$L = 297.05$

SET P.K./WASHER
5-19-82
S.W.H.

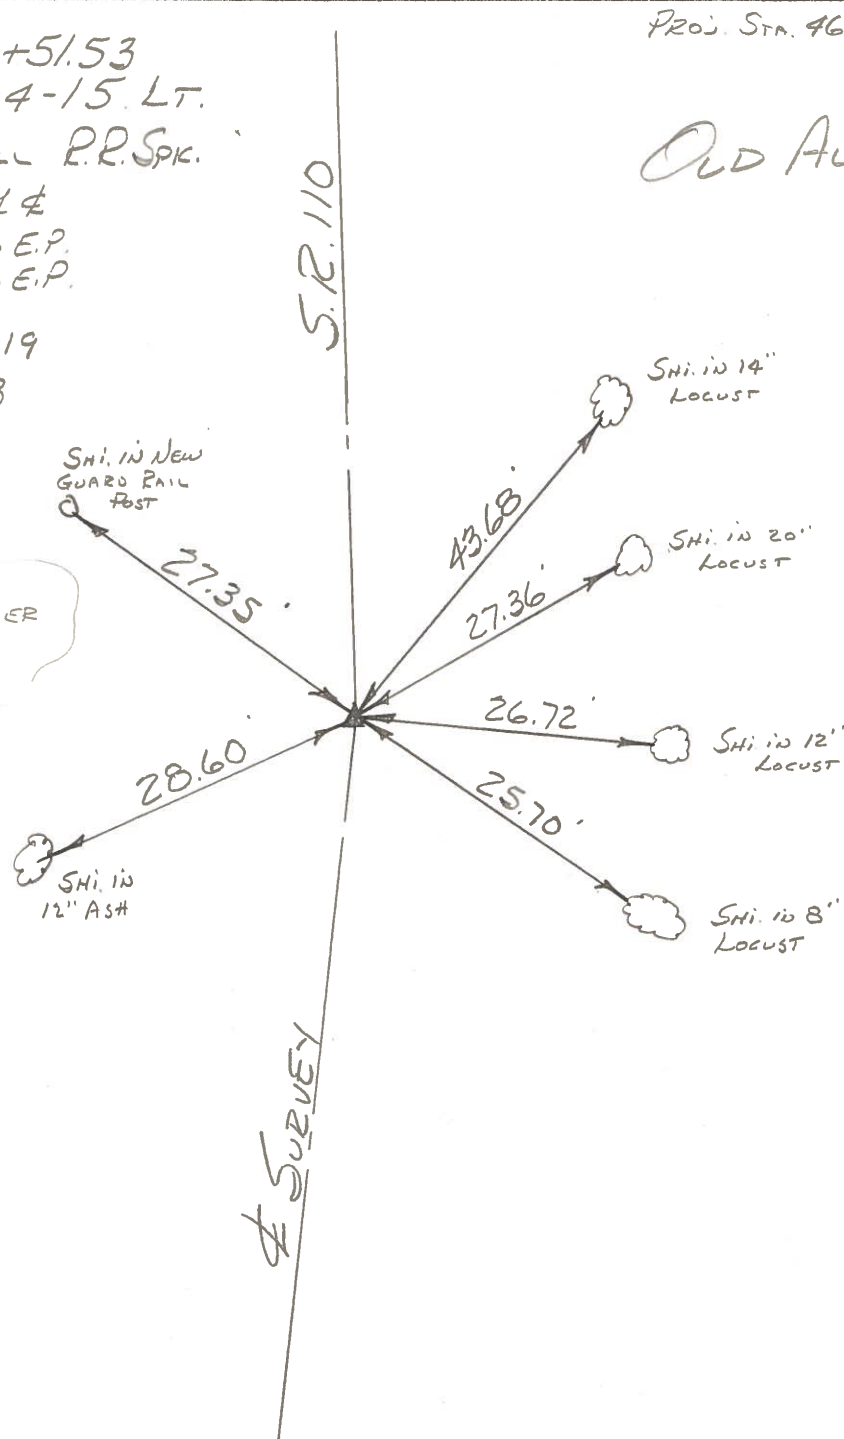


Proj. Sta. 463+80

Old Alignment

PERSONNEL BUENSIDE
 TITLE SMITH
 PERSONNEL BOWERS
 TITLE MEAD

COUNTY HENRY
 DATE 4-5-73
 S. R. 110
 WEATHER CLOUDY
 SEC. TEMP. +35

DESCRIPTION \$ SURVEY CONTROL TIES JOB NO.

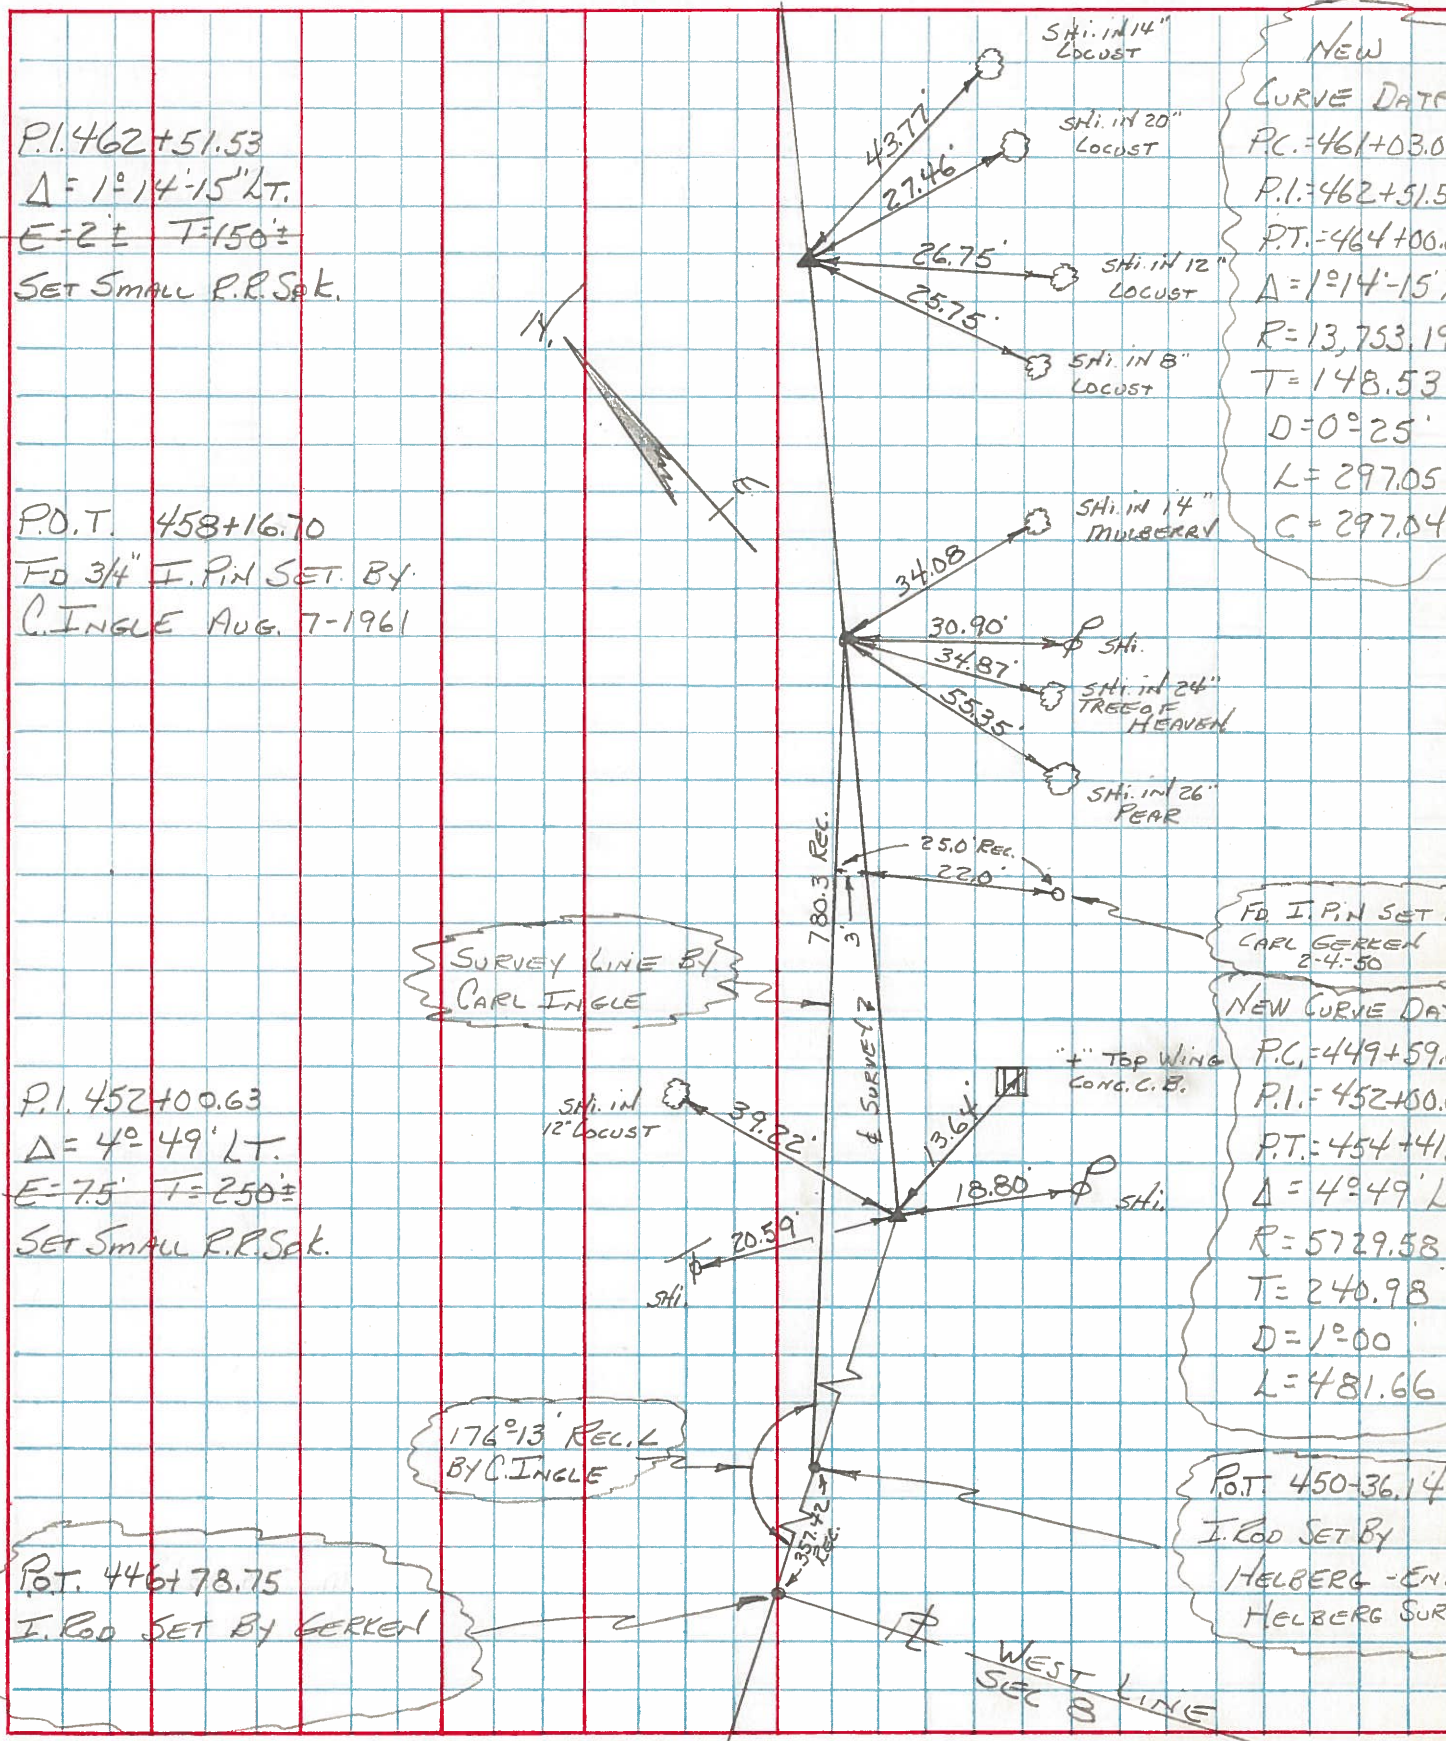

P.I. 462+51.53
 $\Delta = 1^\circ 14' 15''$ LT.
 $E = 2'$ $T = 150'$
 SET SMALL R.R. S&K.

P.O.T. 458+16.70
 FD 3/4" I.P.I.N SET BY
 C. INGLE AUG. 7-1961

P.I. 452+00.63
 $\Delta = 4^\circ 49'$ LT.
 $E = 7.5'$ $T = 250'$
 SET SMALL R.R. S&K.

P.O.T. 446+78.75
 I. ROD SET BY GERKEN

NEW CURVE DATA
 P.C. = 461+03.00
 P.I. = 462+51.53
 P.T. = 464+00.6
 $\Delta = 1^\circ 14' 15''$
 $R = 13,753.19'$
 $T = 148.53'$
 $D = 0^\circ 25'$
 $L = 297.05'$
 $C = 297.04'$

FD I.P.I.N SET BY
 CARL GERKEN
 2-4-50

NEW CURVE DATA
 P.C. = 449+59.6
 P.I. = 452+00.6
 P.T. = 454+41.6
 $\Delta = 4^\circ 49'$ LT.
 $R = 5729.58'$
 $T = 240.98'$
 $D = 1^\circ 00'$
 $L = 481.66'$

P.O.T. 450-36.14
 I. ROD SET BY
 HELBERG - ENCL
 HELBERG SURV