

O.D.O.T. DISTRICT 2 SURVEY OFFICE (USE ONLY)

PERSONNEL _____ REFERENCE NO. 18 CB SHEET 42 OF 61

NOTES NIESE DATE 3/27/24 ROUTE SR 110
 H.C. MILLER WEATHER WINDY COUNTY HENRY
 R.C. RHOADES TEMP. 25° TOWNSHIP DAMASCUS
 SECTION 8

DWG BY RHOADES PID 114846 T 5 N R 8 E

TYPE MONUMENT MONBOX W/1" IPIN

ON SURFACE - ~~BELOW~~ ON


OFFSET \odot PAVEMENT ON _____ LT : RT

10.6' TO LT EDGE PAVEMENT

STATION: 462+79.07


HORZ. DATUM: NAD83 2011 GEOID: NAVD88 2018

GRID: NORTHING: 639026.041 EASTING: 1563613.392

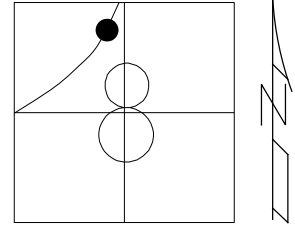

RECORD: C.S.
 FD MONBOX
 MONREFCB18
 9/01/15, JFO
 FD MONBOX
 W/1" IPIN
 REFCB18
 12/28/21, DSA
 CKREFCB18
 3/27/24, JAM


HEN LPD
 N: 495985.095
 E: 198016.321

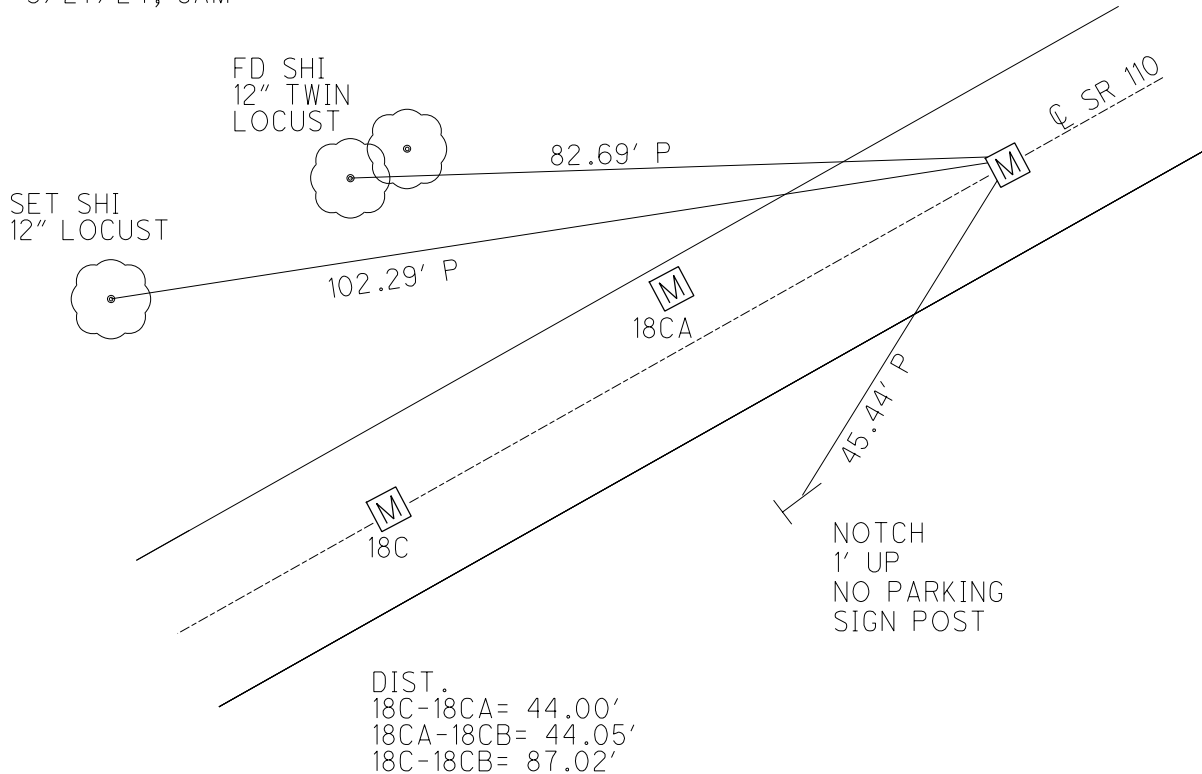


O.D.O.T. DISTRICT 2 SURVEY OFFICE (USE ONLY)

PERSONNEL	REFERENCE NO.	18CB	SHEET	43 OF 58	
NOTES	CANTERBURY	DATE	09/22/04	ROUTE	SR 110
H.C.	CANTERBURY	WEATHER	CLEAR	COUNTY	HENRY
R.C.	HOOKER	TEMP.	70°	TOWNSHIP	DAMASCUS
				SECTION	08
				T	5 N
				R	8 E

TYPE MONUMENT MON. BOX W/IRON PIN
 ON SURFACE - ~~BELOW~~ ON
~~LEFT~~ - Q PAV'T - ~~RIGHT~~ ON
10.6' TO LT EDGE PAVEMENT
 S.L.M. 471+00
 Grid: Northing: 639025.990 Easting: 1563613.480

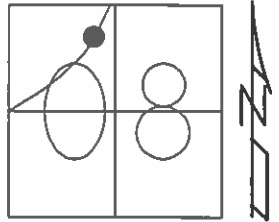

RECORD: CS
 PLAN STA: 469+84.22
 NOTE: THIS MON. BOX SET
 DURING NEW CONST. IN 1988
 GPS, MONREFCB18
 09/01/15, JFO
 FD MON BOX COVERED
 08/03/16, JFO

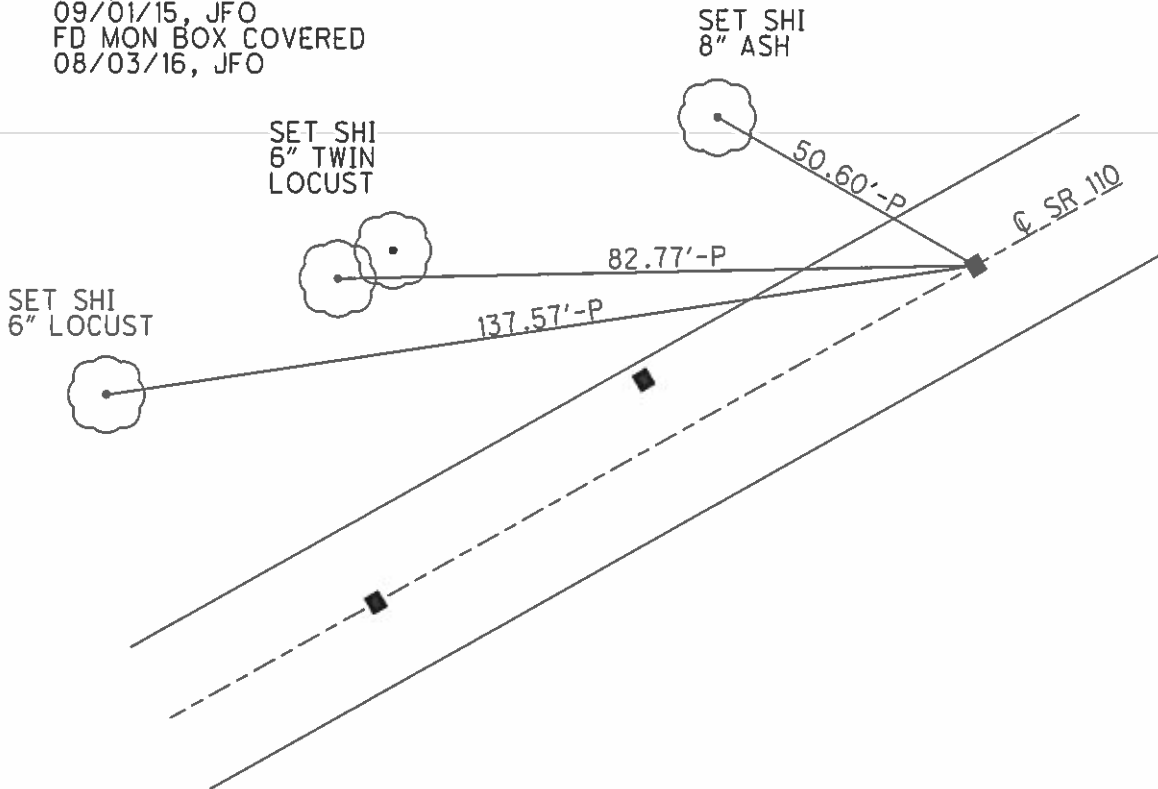

O.D.O.T. DISTRICT 2 SURVEY OFFICE

PERSONNEL _____

REFERENCE NO. ¹⁹⁸⁸ 18C

SHEET 24 OF 37

NOTES CANTERBURY

DATE 09/22/04

ROUTE S.R. 110

H.C. CANTERBURY

WEATHER CLEAR

COUNTY HENRY

R.C. HOOVER

TEMP. +70°

TOWNSHIP DAMASCUS

SECTION 08

T 5 N R 8 E


TYPE MONUMENT MON BOX W/IRON PINS

ON SURFACE - ~~BELOW~~ YES

LEFT - Q PAV'T - ~~RIGHT~~ 0.5'LT/6.5'LT/YES

TO LT EDGE PAVEMENT

S.L.M. 470+13 470+57 471+00

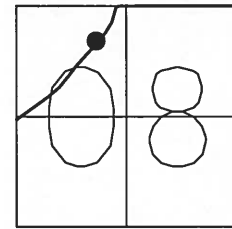


A=10.6'
B=4.5'
C=10.6'

"A"
RECORD: SC
PLAN STA: 468+96.93

"B"
RECORD: PI
PLAN STA: 469+40.90

"C"
RECORD: CS
PLAN STA: 469+84.22

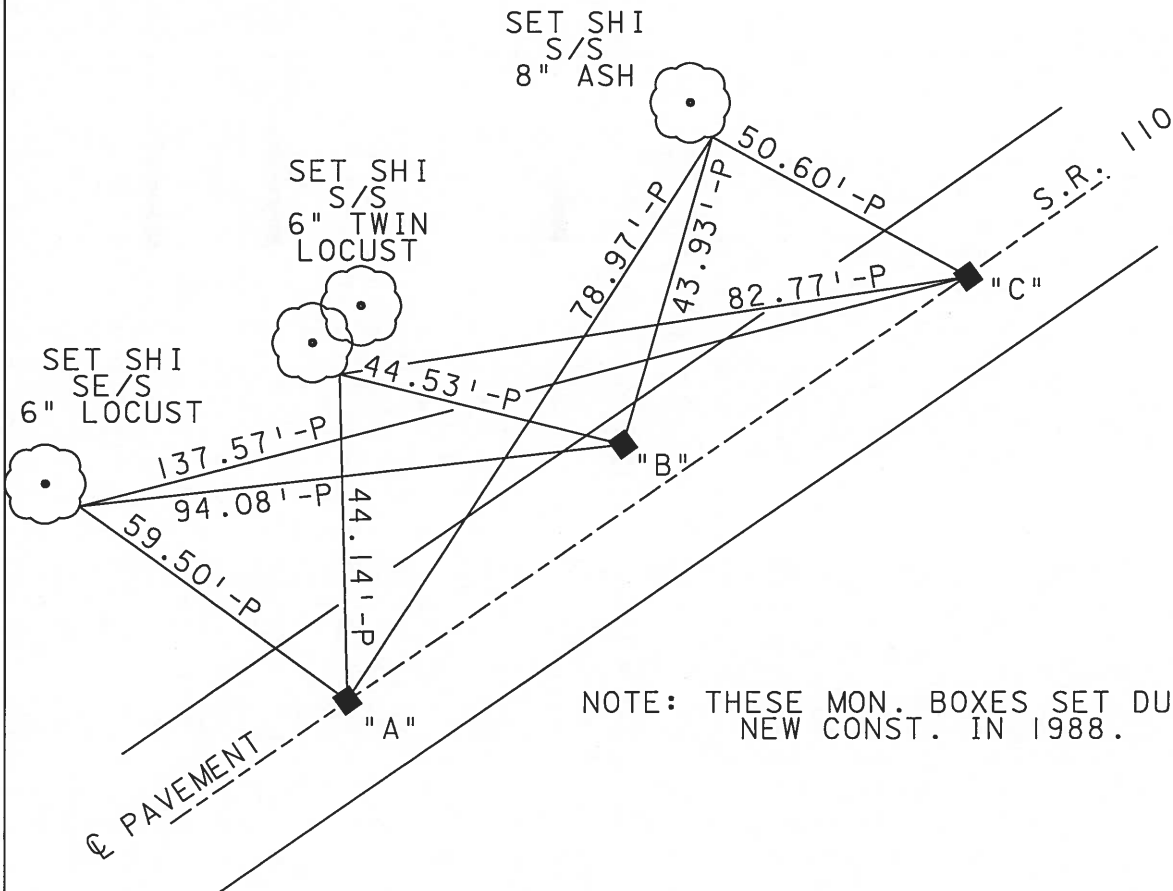

NOTE: THESE MON. BOXES SET DURING NEW CONST. IN 1988.