


O.D.O.T. DISTRICT 2 SURVEY OFFICE (USE ONLY)

PERSONNEL _____ REFERENCE NO. 18 D SHEET 43 OF 61
 NOTES NIESE DATE 3/27/24 ROUTE SR 110
 H.C. MILLER WEATHER WINDY COUNTY HENRY
 R.C. RHOADES TEMP. 25° TOWNSHIP DAMASCUS
 SECTION 8
 DWG BY RHOADES PID 114846 T 5 N R 8 E


TYPE MONUMENT MONBOX W/1" IPIN
 ON SURFACE - ~~BELOW~~ ON
 OFFSET Q PAVEMENT 0.5' LT : ~~RT~~
10.3' TO LT EDGE PAVEMENT
 STATION: 464+79.07

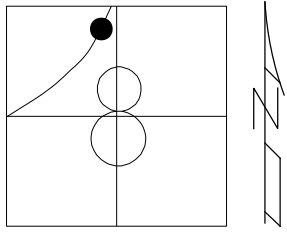

HORZ. DATUM: NAD83 2011 GEOID: NAVD88 2018
 GRID: NORTHING: 639168.553 EASTING: 1563753.685

RECORD: S.T.
 FD MONBOX
 MONREFD18
 9/01/15, JFO
 FD MONBOX
 W/1" IPIN
 REFD18
 12/28/21, DSA
 CKREFD18
 3/27/24, JAM


HEN LPD
 N: 496130.156
 E: 198153.942

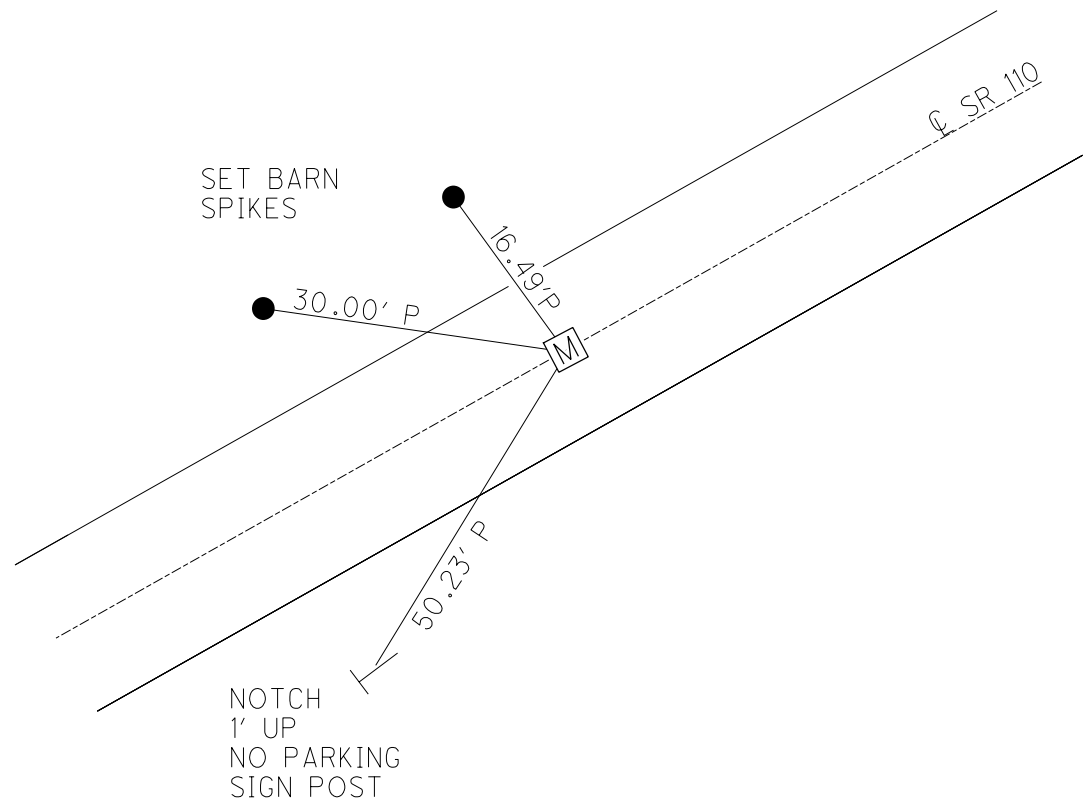


O.D.O.T. DISTRICT 2 SURVEY OFFICE (USE ONLY)

PERSONNEL	REFERENCE NO.	18D	SHEET	44	OF	58
NOTES	CANTERBURY	DATE	09/22/04	ROUTE	SR 110	
H.C.	CANTERBURY	WEATHER	CLEAR	COUNTY	HENRY	
R.C.	HOOKER	TEMP.	70°	TOWNSHIP	DAMASCUS	
				SECTION	08	
				T	5	N
				R	8	E

TYPE MONUMENT MON. BOX W/IRON PIN
 ON SURFACE - ~~BELOW~~ ON
 LEFT - ~~C~~ PAV'T - RIGHT 0.5'
10.3' TO LT EDGE PAVEMENT
 S.L.M. 473+00
 Grid: Northing: 639168.573 Easting: 1563753.659

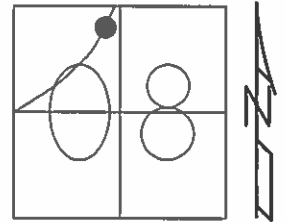

RECORD: ST
 PLAN STA: 471+84.22 BK
 PLAN STA: 471+84.33 AH
 NOTE: THIS MON. BOX SET
 DURING NEW CONST. IN 1988
 GPS, MONREFD18
 09/01/15, JFO
 FD MON BOX COVERED
 08/03/16, JFO

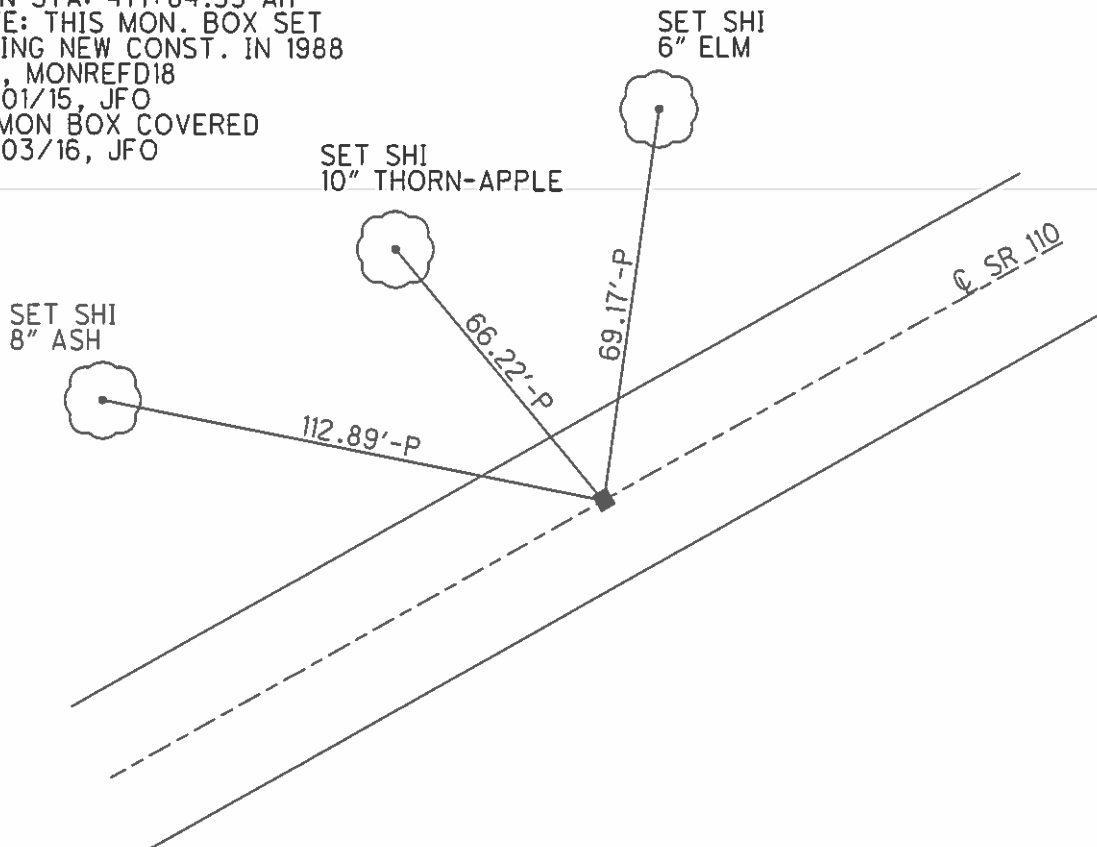

O.D.O.T. DISTRICT 2 SURVEY OFFICE

PERSONNEL _____

REFERENCE NO. ¹⁹⁸⁸ 18D

SHEET 25 OF 37

NOTES CANTERBURY

DATE 09/22/04

ROUTE S.R. 110

H.C. CANTERBURY

WEATHER CLEAR

COUNTY HENRY

R.C. HOOVER

TEMP. +70°

TOWNSHIP DAMASCUS

SECTION 08

T 5 N R 8 E


TYPE MONUMENT MON BOX W/IRON PIN

ON SURFACE - ~~BELOW~~ YES


LEFT - Q PAV'T - ~~RIGHT~~ 0.5'

10.3' TO LT EDGE PAVEMENT

S.L.M. 473+00

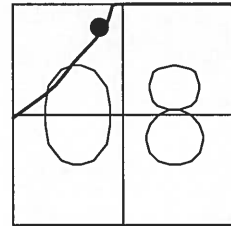

RECORD: ST
 PLAN STA: 471+84.22 BK
 PLAN STA: 471+84.33 AH

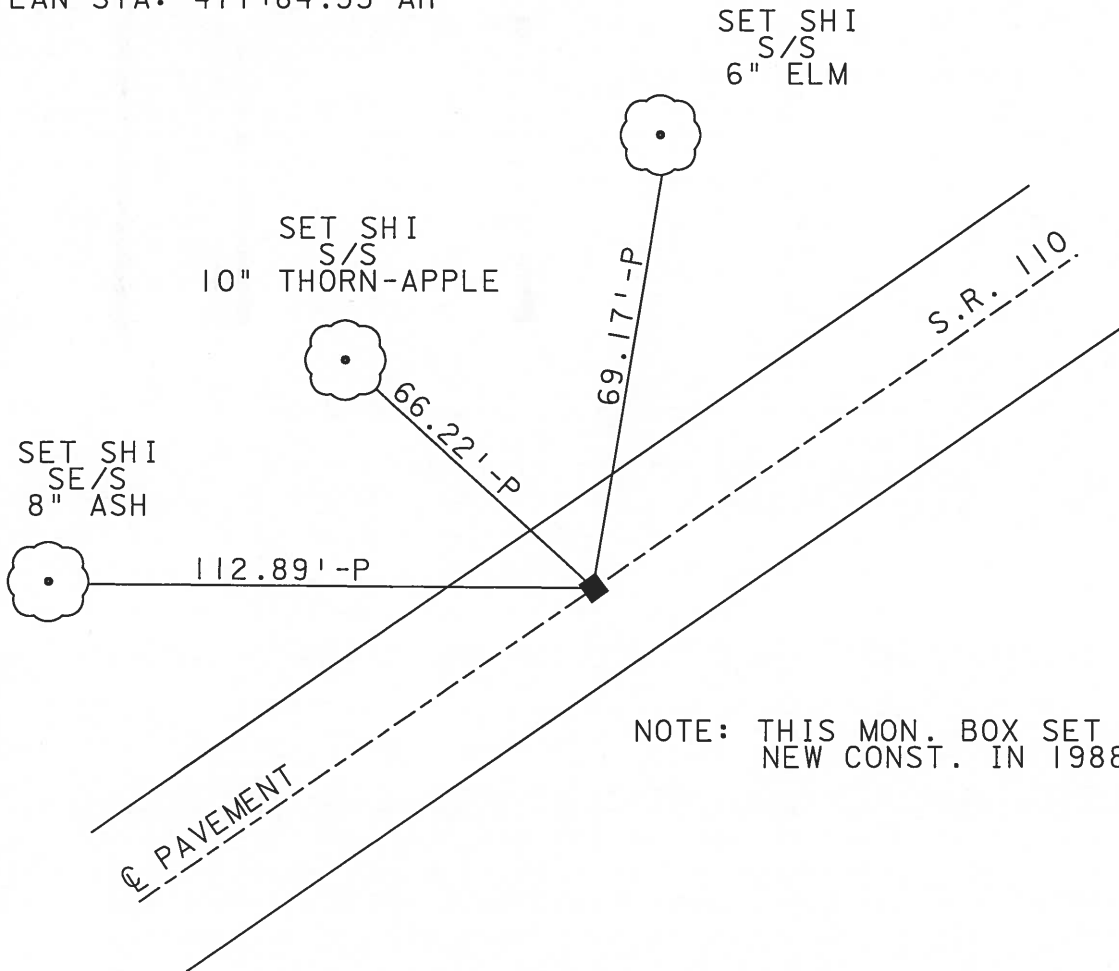

NOTE: THIS MON. BOX SET DURING
 NEW CONST. IN 1988.