

O.D.O.T. DISTRICT 2 SURVEY OFFICE (USE ONLY)

PERSONNEL

REFERENCE NO. 18 E

SHEET 44 OF 61

NOTES NIESE DATE 3/27/24

H.C. MILLER WEATHER WINDY

R.C. RHOADES TEMP. 25°

ROUTE SR 110

COUNTY HENRY

TOWNSHIP DAMASCUS

SECTION 8

DWG BY RHOADES PID 114846

T 5 N R 8 E

TYPE MONUMENT MONBOX W/1" IPIN

ON SURFACE - ~~BELOW~~ ON

OFFSET \odot PAVEMENT ON LT : RT

10.5' TO LT EDGE PAVEMENT


STATION: 467+93.93

HORZ.DATUM: NAD83 2011

GEOID: NAVD88 2018


GRID: NORTHING: 639389.530

EASTING: 1563978.869

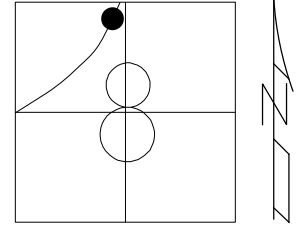

RECORD: P.O.T.
 FD MONBOX
 MONREFE18
 9/01/15, JFO
 FD MONBOX
 W/1" IPIN
 REFE18
 12/29/21, DSA
 CKREFE18
 3/27/24, JAM


HEN LPD
 N: 496355.277
 E: 198375.062

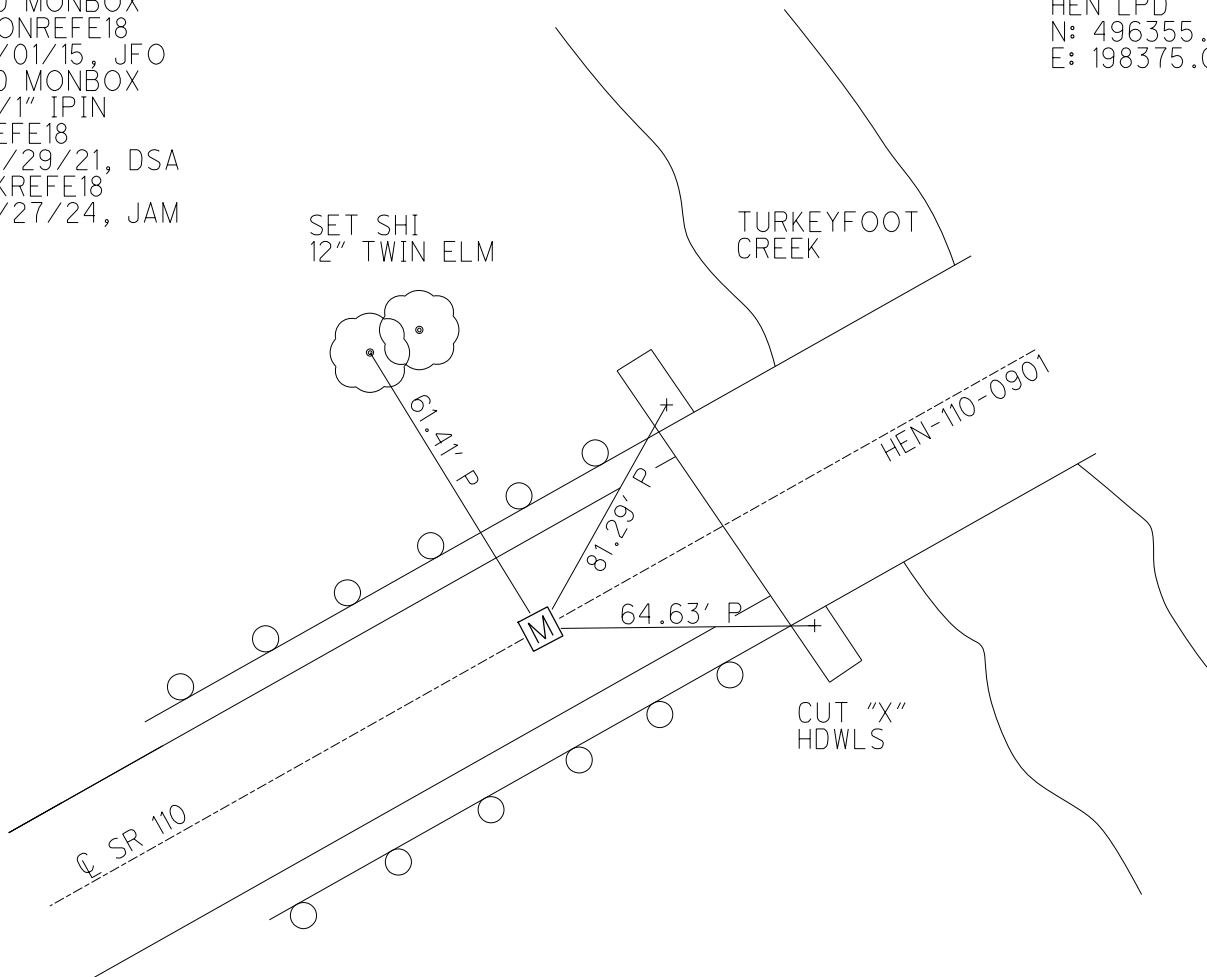

O.D.O.T. DISTRICT 2 SURVEY OFFICE (USE ONLY)


PERSONNEL	REFERENCE NO.	<u>18E</u>	SHEET	<u>45</u>	OF	<u>58</u>
NOTES	<u>CANTERBURY</u>	DATE	<u>09/22/04</u>	ROUTE	<u>SR 110</u>	
H.C.	<u>CANTERBURY</u>	WEATHER	<u>CLEAR</u>	COUNTY	<u>HENRY</u>	
R.C.	<u>HOOKER</u>	TEMP.	<u>70°</u>	TOWNSHIP	<u>DAMASCUS</u>	
				SECTION	<u>08</u>	
				T	<u>5</u>	R
				N	<u>8</u>	E

TYPE MONUMENT MON. BOX W/IRON PIN
 ON SURFACE - ~~BELOW~~ ON
~~LEFT~~ - PAV'T - ~~RIGHT~~ ON
10.5' TO LT EDGE PAVEMENT
 S.L.M. 476+16

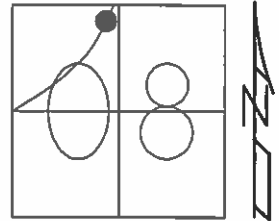

Grid: Northing: 639389.545 Easting: 1563978.800

RECORD: POT
 PLAN STA: 475+00
 NOTE: THIS MON. BOX SET
 DURING NEW CONST. IN 1988
 GPS, MONREFE18
 09/01/15, JFO
 FD MON BOX COVERED
 08/03/16, JFO

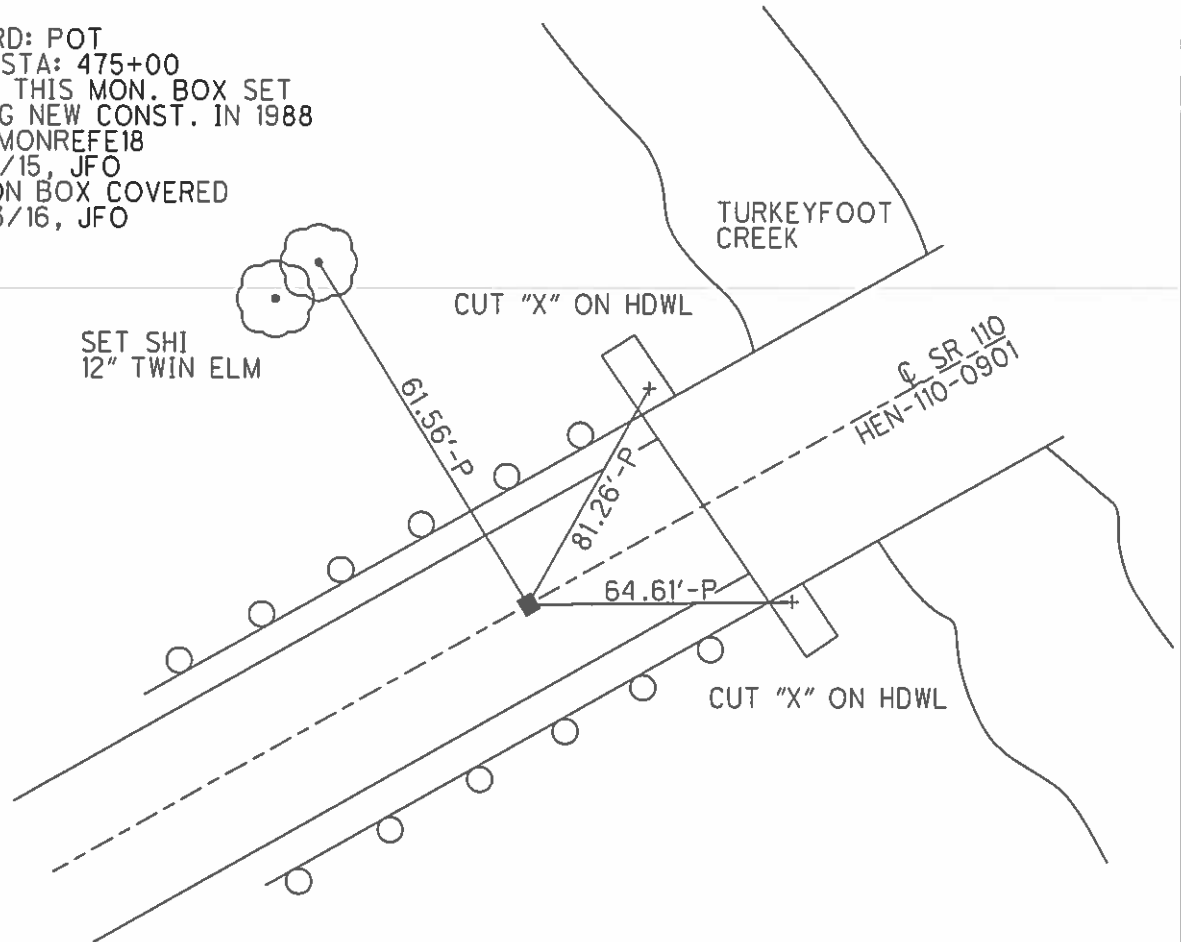

O.D.O.T. DISTRICT 2 SURVEY OFFICE

PERSONNEL _____

REFERENCE NO. ¹⁹⁸⁸ 18E

SHEET 26 OF 37

NOTES CANTERBURY

DATE 09/22/04

ROUTE S.R. 110

H.C. CANTERBURY

WEATHER CLEAR

COUNTY HENRY

R.C. HOOKER

TEMP. +70°

TOWNSHIP DAMASCUS

SECTION 08

T 5 N R 8 E


TYPE MONUMENT MON BOX W/IRON PIN

ON SURFACE - ~~BELOW~~ YES

~~LEFT - C~~ PAV'T - ~~RIGHT~~ YES

10.5' TO LT EDGE PAVEMENT

S.L.M. 476+16

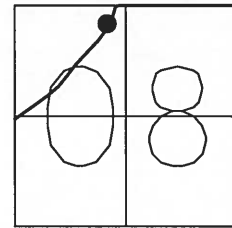

RECORD: POT
PLAN STA: 475+00

SET SHI
S/S
12" TWIN ELM

