


O.D.O.T. DISTRICT 2 SURVEY OFFICE (USE ONLY)

PERSONNEL _____ REFERENCE NO. 19 SHEET 46 OF 61
 NOTES NIESE DATE 3/27/24 ROUTE SR 110
 H.C. MILLER WEATHER WINDY COUNTY HENRY
 R.C. RHOADES TEMP. 25° TOWNSHIP DAMASCUS
 DWG BY RHOADES PID 114846 SECTION 8
 T 5 N R 8 E


TYPE MONUMENT MONBOX W/1" IPIN
 ON SURFACE - ~~BELOW~~ ON
 OFFSET Q PAVEMENT 11.4' ~~RT~~ : RT
0.6' RT TO RT EDGE PAVEMENT
 STATION: 472+79.44

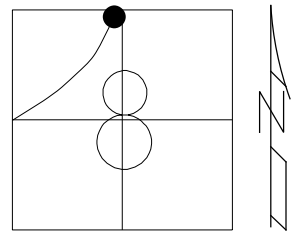

HORIZ.DATUM: NAD83 2011 GEOID: NAVD88 2018
 GRID: NORTHING: 639729.424 EASTING: 1564325.342

RECORD: P.I.
 FD MONBOX
 MONREFG18
 9/01/15, JFO
 FD MONBOX
 W/1" IPIN
 REFG18
 12/29/21, DSA
 CKREFG18
 3/27/24, JAM


HEN LPD
 N: 496701.676
 E: 198715.378

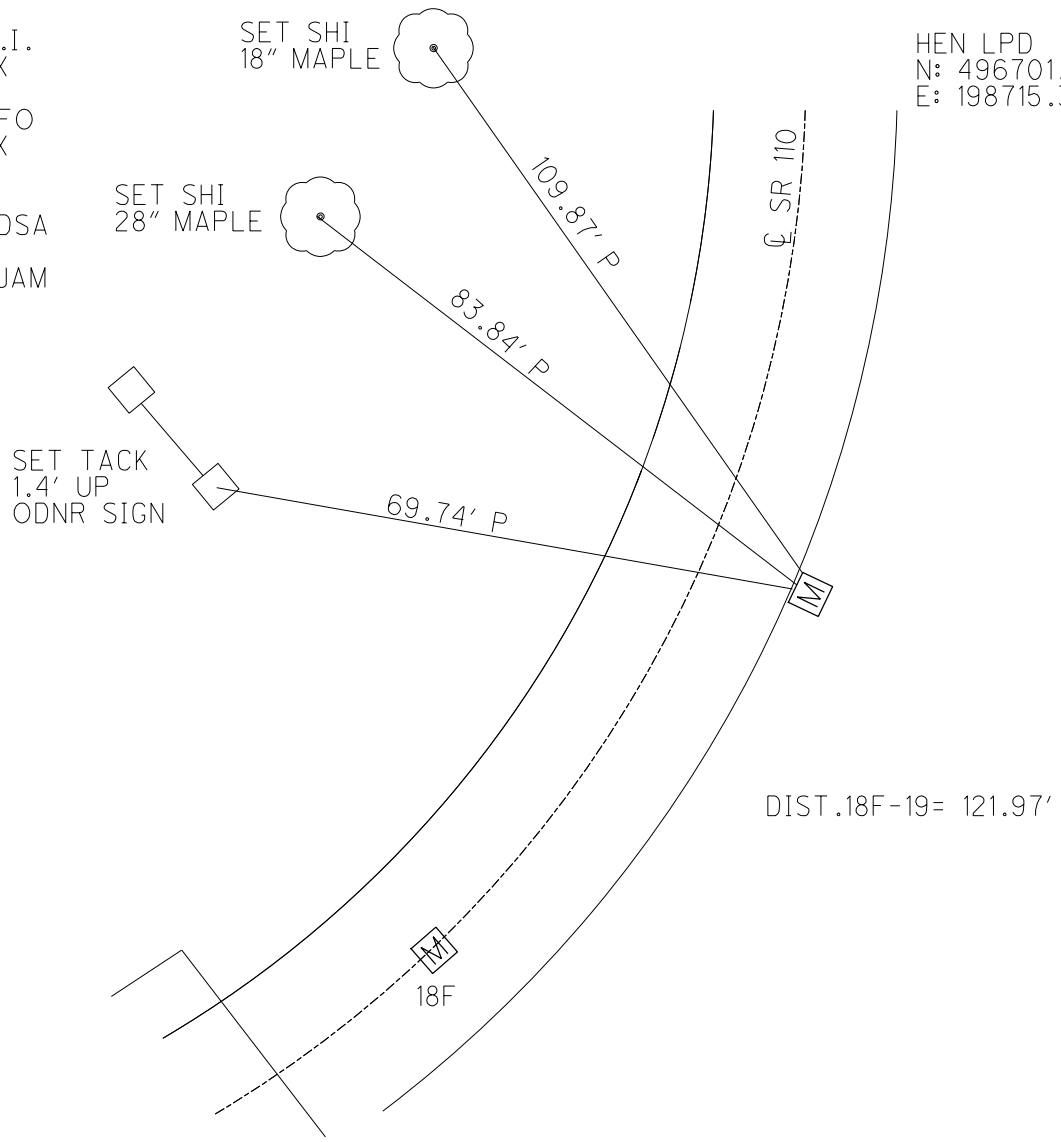


O.D.O.T. DISTRICT 2 SURVEY OFFICE (USE ONLY)

PERSONNEL	REFERENCE NO.	18G	SHEET	47 OF	58
NOTES	CANTERBURY	DATE	09/22/04	ROUTE	SR 110
H.C.	CANTERBURY	WEATHER	CLEAR	COUNTY	HENRY
R.C.	HOOKER	TEMP.	80°	TOWNSHIP	DAMASCUS
				SECTION	08
				T	5 N R 8 E

TYPE MONUMENT MON. BOX W/IRON PIN
 ON SURFACE - ~~BELOW~~ ON
~~LEFT - C PAV'T~~ - RIGHT 11.4'
0.6' TO RT EDGE PAVEMENT
 S.L.M. 481+00
 Grid: Northing: 639729.488 Easting: 1564325.329

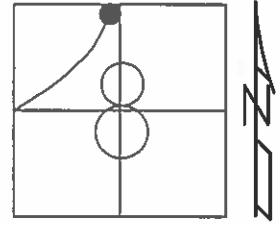

RECORD: PI 1940 PLAN
 DEF=25°-39' LT
 D=8°-00', R=716.20'
 T=163.05', E=18.32'
 L=320.63', PI=84+50.06,
 PC=82+87.01, PT=86+07.64
 NOTE: THIS MON. BOX SET
 DURING NEW CONST. IN 1988
 GPS, MON REFG18
 09/01/15, JFO
 FD MON BOX COVERED
 08/03/16, JFO

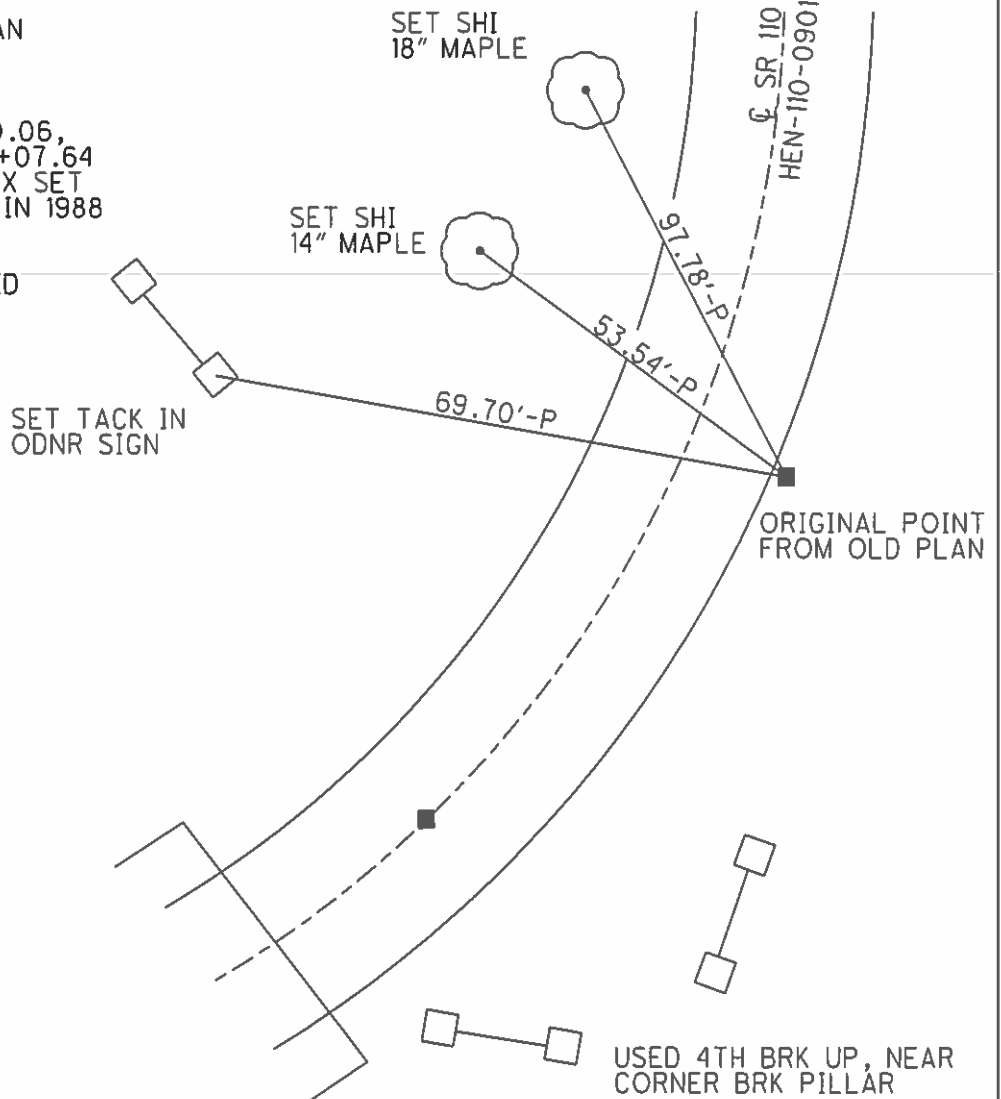

O.D.O.T. DISTRICT 2 SURVEY OFFICE

PERSONNEL

REFERENCE NO. ¹⁹⁸⁸ ~~18F~~


SHEET 27 OF 37

NOTES CANTERBURY
 H.C. CANTERBURY
 R.C. HOOKER

DATE 09/22/04
 WEATHER CLEAR
 TEMP. +80°

ROUTE S.R. 110
 COUNTY HENRY
 TOWNSHIP DAMASCUS
 SECTION 8
T 5 N R 8 E


TYPE MONUMENT MON BOX W/IRON PIN
 ON SURFACE - ~~BELOW~~ YES
~~LEFT~~ - Q PAV'T - RIGHT YES 11.4' RT
11.4' RT OF RT EDGE PAVEMENT
 S.L.M. "A" = 479+79 "B" = 481+00

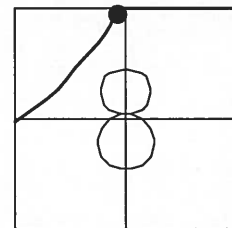

A=10.3'
 B=0.6'

"A"
 RECORD: PC
 PLAN STA: 478+63.26

"B"
 RECORD: PI
 1940 PLAN
 DEF=25°-39' LT
 D=8°-00'
 R=716.20'
 T=163.05'
 E=18.32'
 L=320.63'
 PI=84+50.06
 PC=82+87.01
 PT=86+07.64

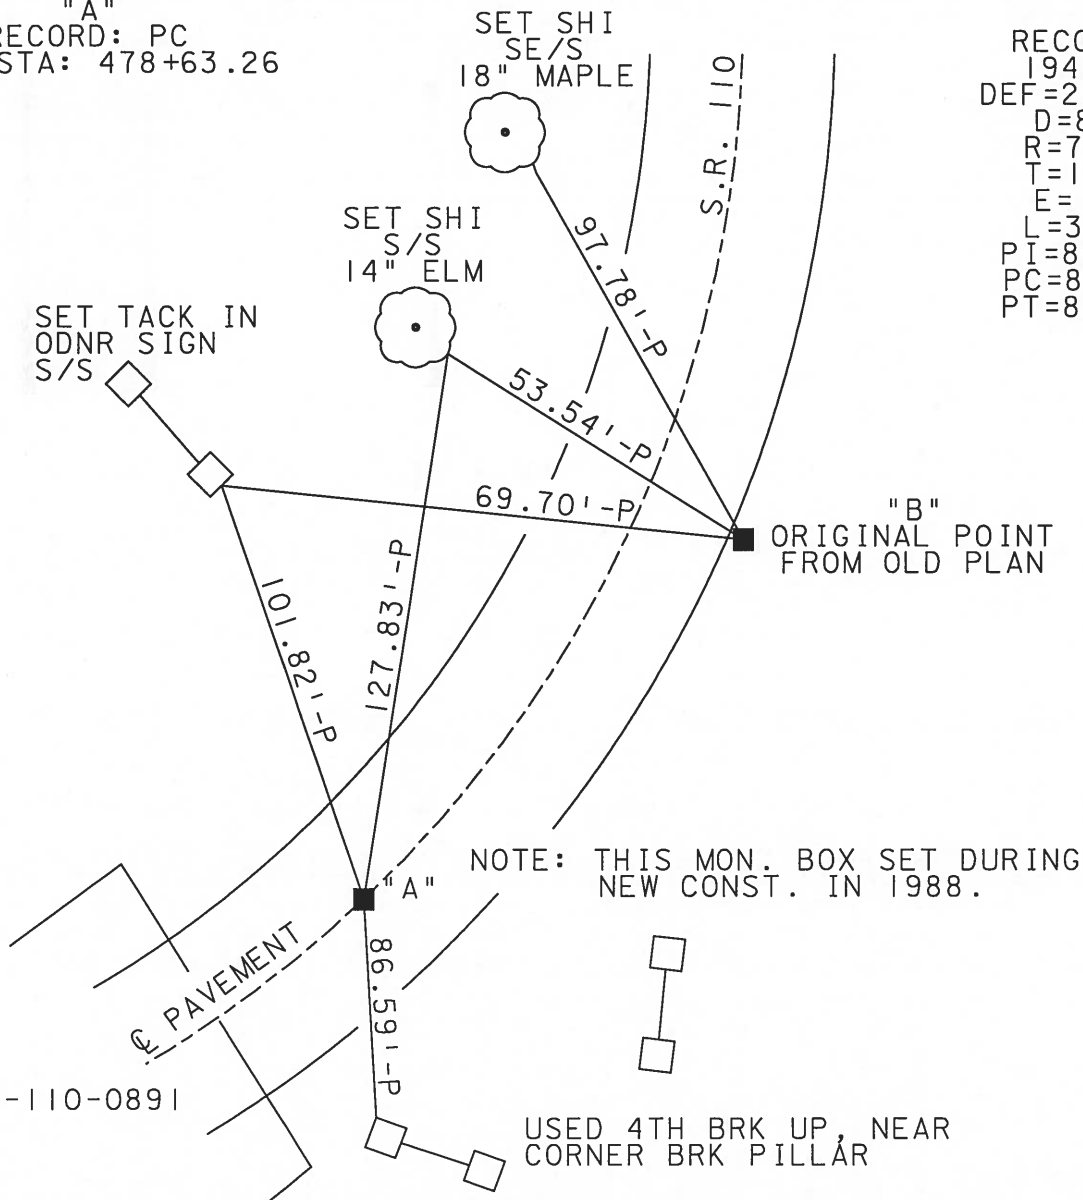

PERSONNEL	TITLE	PERSONNEL	TITLE	COUNTY	HENRY	DATE	8-2-77
BURNSIDE				S. R.	110	WEATHER	CLEAR
SMITH				SEC.	TURKEYFOOT BRIDGE	TEMP.	+82°
KNAPPE				DESCRIPTION	ALIGNMENT @ PROPOSED PARK SITE		JOB NO.
MEAD							

