


O.D.O.T. DISTRICT 2 SURVEY OFFICE (USE ONLY)


PERSONNEL _____ REFERENCE NO. 19 SHEET 48 OF 58
 NOTES BARNHISEL DATE 09/25/90 ROUTE SR 110
 H.C. BARNHISEL WEATHER WINDY-CLEAR COUNTY HENRY
 R.C. HOFFMAN TEMP. 70° TOWNSHIP DAMASCUS
 _____ SECTION 08
 _____ T 5 N R 8 E

TYPE MONUMENT _____ MON BOX _____
 ON SURFACE - ~~BELOW~~ _____ ON _____
~~LEFT - C PAVT~~ - RIGHT 11.3'
1.0' TO RT EDGE PAVEMENT
 S.L.M. _____ 481+04

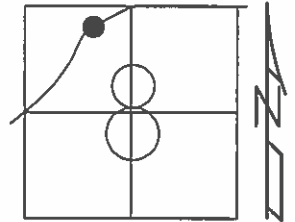

Grid: Northing: 639729.488 Easting: 1564325.329

RECORD:
 $\Delta=25^{\circ}-39'$ LT, $D=8^{\circ}-00'$
 $R=716.20'$, $T=163.05'$, $E=18.32'$
 $L=320.63'$, $PI=84+50.06$
 $PC=82+87.01$, $PT=86+07.64$
 DID NOT COVER 9/28/90
 NOTE: DID NOT OPEN MON.
 BOX, MEASURED TO CTR OF LID
 NOTE: END OF NEW PAVT & NEW
 ALIGNMENT 481+21

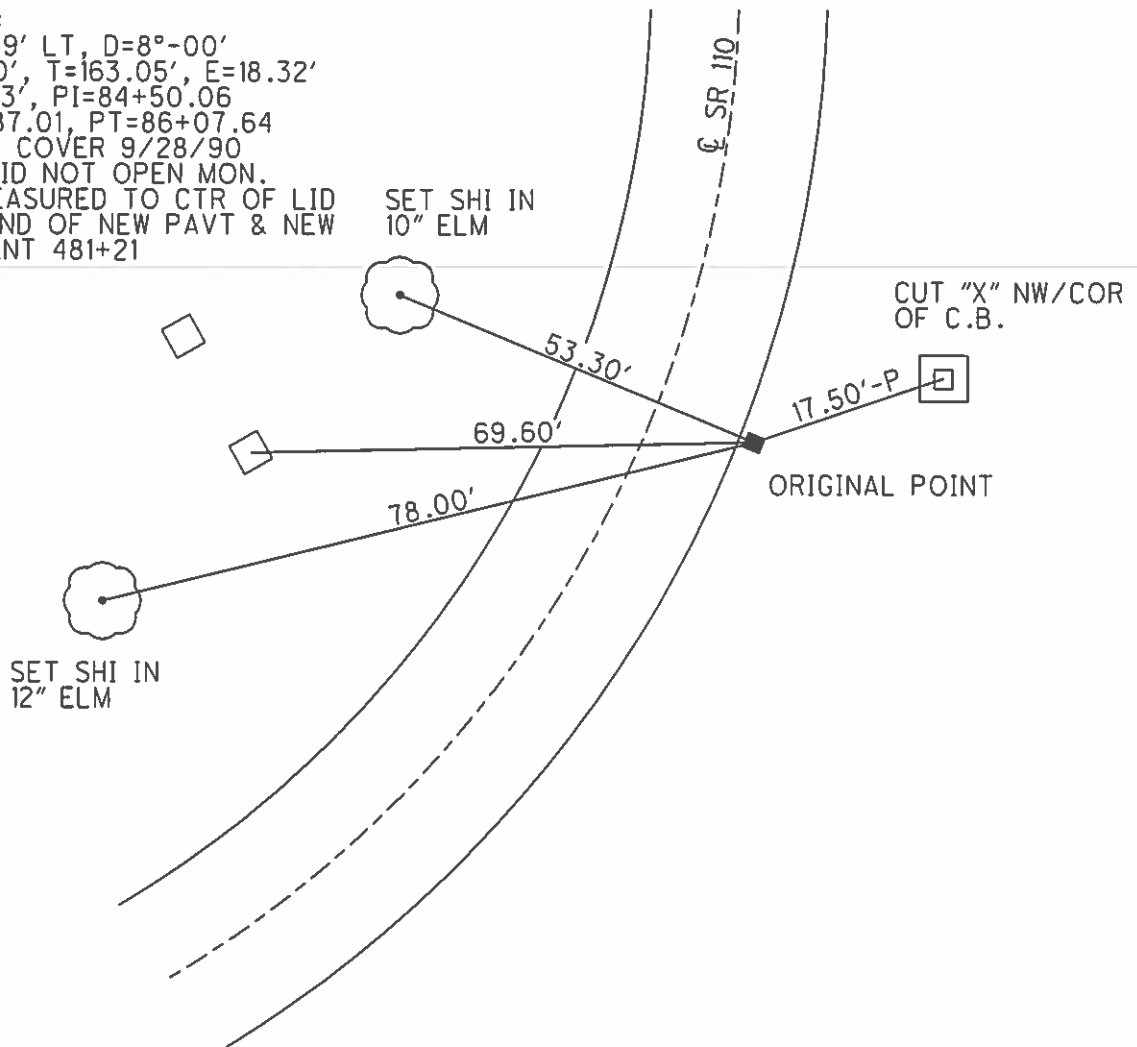

O.D.O.T. DISTRICT 2 SURVEY OFFICE

PERSONNEL _____

REFERENCE NO. 19-I.P.M SHEET 28 OF 37

NOTES BARNHISEL

H.C. " " "

DATE 9-25-90

ROUTE 110

R.C. HOFFMAN

WEATHER Windy - Clear

COUNTY HENRY

TEMP. +70°

TOWNSHIP DAMASCUS

SECTION 8


T. S N. R 8 E.

TYPE MONUMENT 1" IRON PIN & MON. BOX
ON SURFACE - BELOW yes

LEFT - € PAV'T. - RIGHT Pt. "A" 18.3 Pt. "B" 11.3

7.5 11.0 RT RT OF RT EDGE PAVEMENT

S.L.M. Pt. "A" 480+63 Pt. "B" 481+04

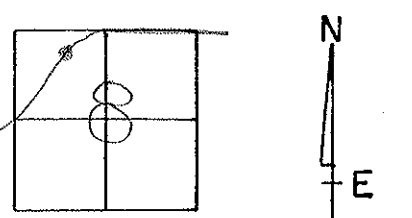


Pt. "A"
Pt. "B"

Did not cover
9-28-90

NOTE: Did not open Mon. Box,
measured to CTR of LID

Sign in no longer existing,
just the posts

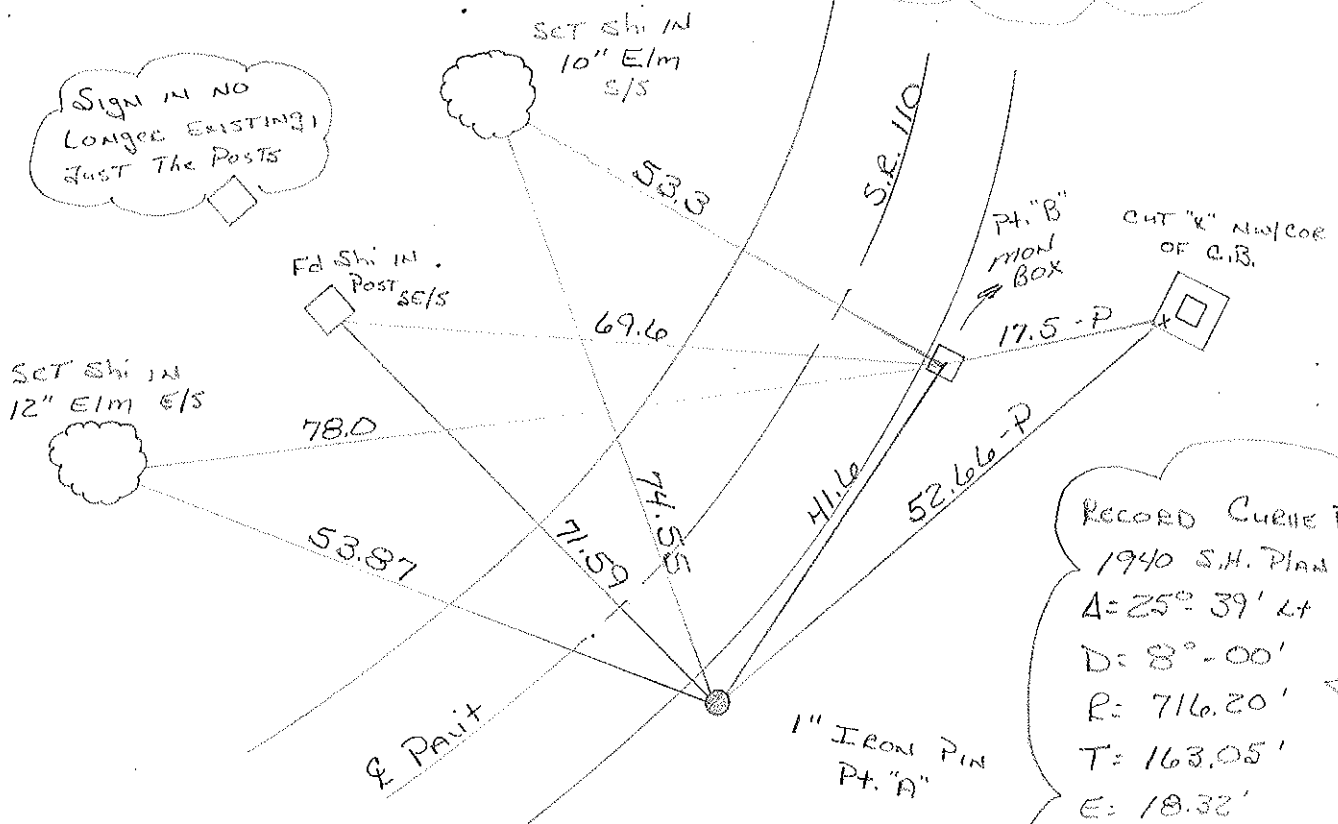

RECORD CURVE DATA:
1940 S.H. Plan
A = 25° 39' Lt
D = 8° - 00'
R = 716.20'
T = 163.05'
E = 18.32'
L = 320.63'
PI = 84+50.06
PC = 82+87.01
PT = 86+07.64

NOTE: END OF New Pav't
& New Alignment 481+21

O.D.O.T. DISTRICT 2 SURVEY OFFICE

PERSONNEL

REFERENCE NO. 19-I.P.N SHEET 28a OF 37

NOTES BARNHISEL

H.C. " "

R.C. HOFFMAN

DATE 9-25-90

WEATHER Windy - Clear

TEMP. +70°

ROUTE 110

COUNTY HENRY

TOWNSHIP DAMASCUS

SECTION 8

T. 5 N. R. 8 E.

Pt. "A" Pt. "B"


TYPE MONUMENT 1" IRON PIN & MON. BOX

ON SURFACE - BELOW YES

LEFT - Q PAVT. - RIGHT Pt. "A" 18.3 Pt. "B" 11.3

7.6 OF RT RT EDGE PAVEMENT

S.L.M. Pt. "A" 480+63 Pt. "B" 481+04

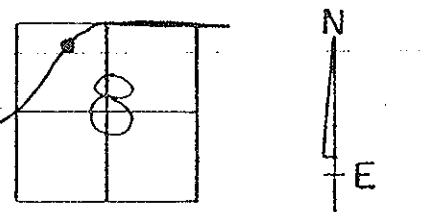


Pt "A" 7.6
Pt "B" 1.0

Did not cover
9-28-90

NOTE: Did NOT open Mon. Box,
measured to CTR of MID

Sign in no longer existing,
just the posts

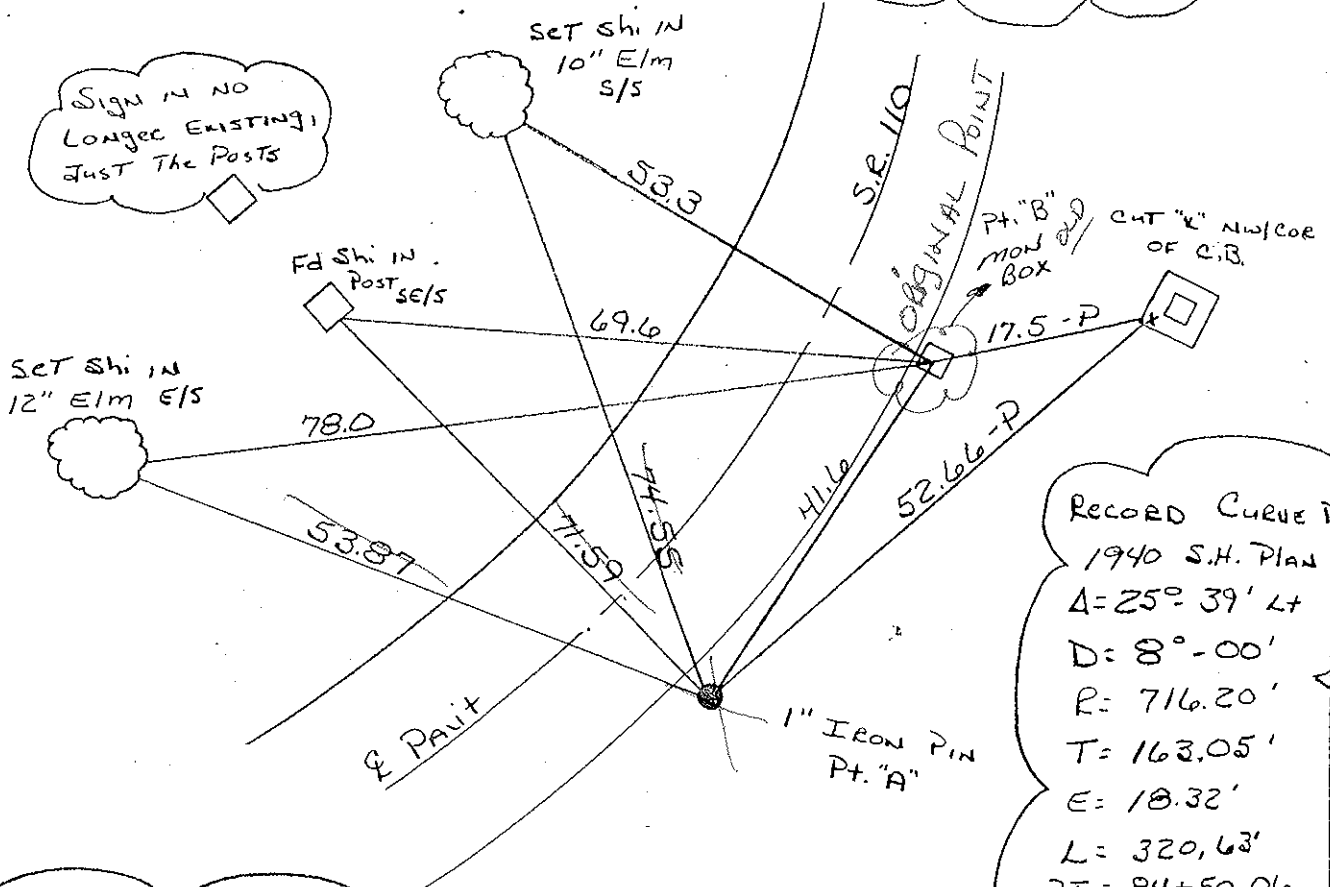

RECORD CURVE DATA:
1940 S.H. PLAN
 $\Delta = 25^\circ - 39' \text{ LT}$
 $D = 8^\circ - 00'$
 $R = 716.20'$
 $T = 163.05'$
 $E = 18.32'$
 $L = 320.63'$
 $PI = 84+50.06$
 $PC = 82+87.01$
 $PT = 86+07.64$

NOTE: END OF New PAVT & New Alignment 481+21

County HENRY S.R. 110

Township DAMASCUS

Section 8

T, N, R, E

Personnel HOFFMAN

HOUSEHOLDER


LOEHRKE

#19


Date 4-27-82

Weather _____

Temp. +50°

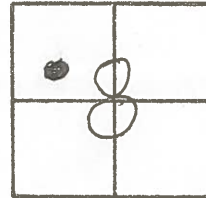

Old ALIGNMENT

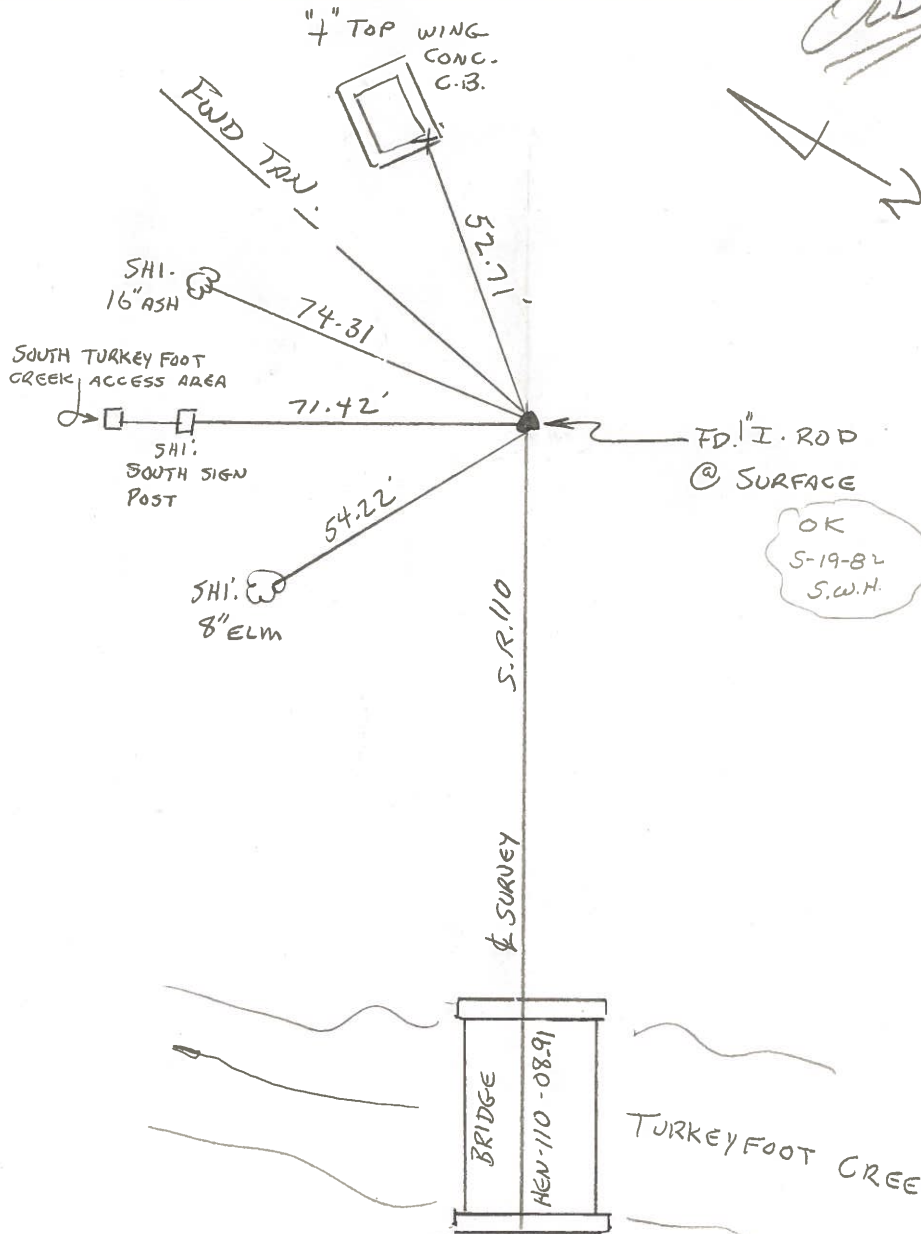

CURVE DATA

1940 S.H. PLAN

$\Delta = 25^{\circ}-39' LT.$

$D = 8^{\circ}-00'$

$R = 716.20'$

$T = 163.05'$

$E = 18.32'$

$L = 320.63'$

$P.I. = 84+50.0'$

$P.C. = 82+87.0'$

$P.T. = 86+07.6'$

OK
5-19-82
S.W.H.


$P.C. = 472+60.03'$

$P.I. = 474+23.0'$

$P.T. = 475+80.6'$


$\Delta = 25^{\circ}-39' LT.$

PERSONNEL	TITLE	PERSONNEL	TITLE	COUNTY	HENRY	DATE	8-2-77
BURNSIDE				S. R.	110	WEATHER	CLEAR
SMITH				SEC.	TURKEYFOOT BRIDGE	TEMP.	+82°
KNAPPE				DESCRIPTION	ALIGNMENT @ PROPOSED PARK SITE		JOB NO.
MEAD							

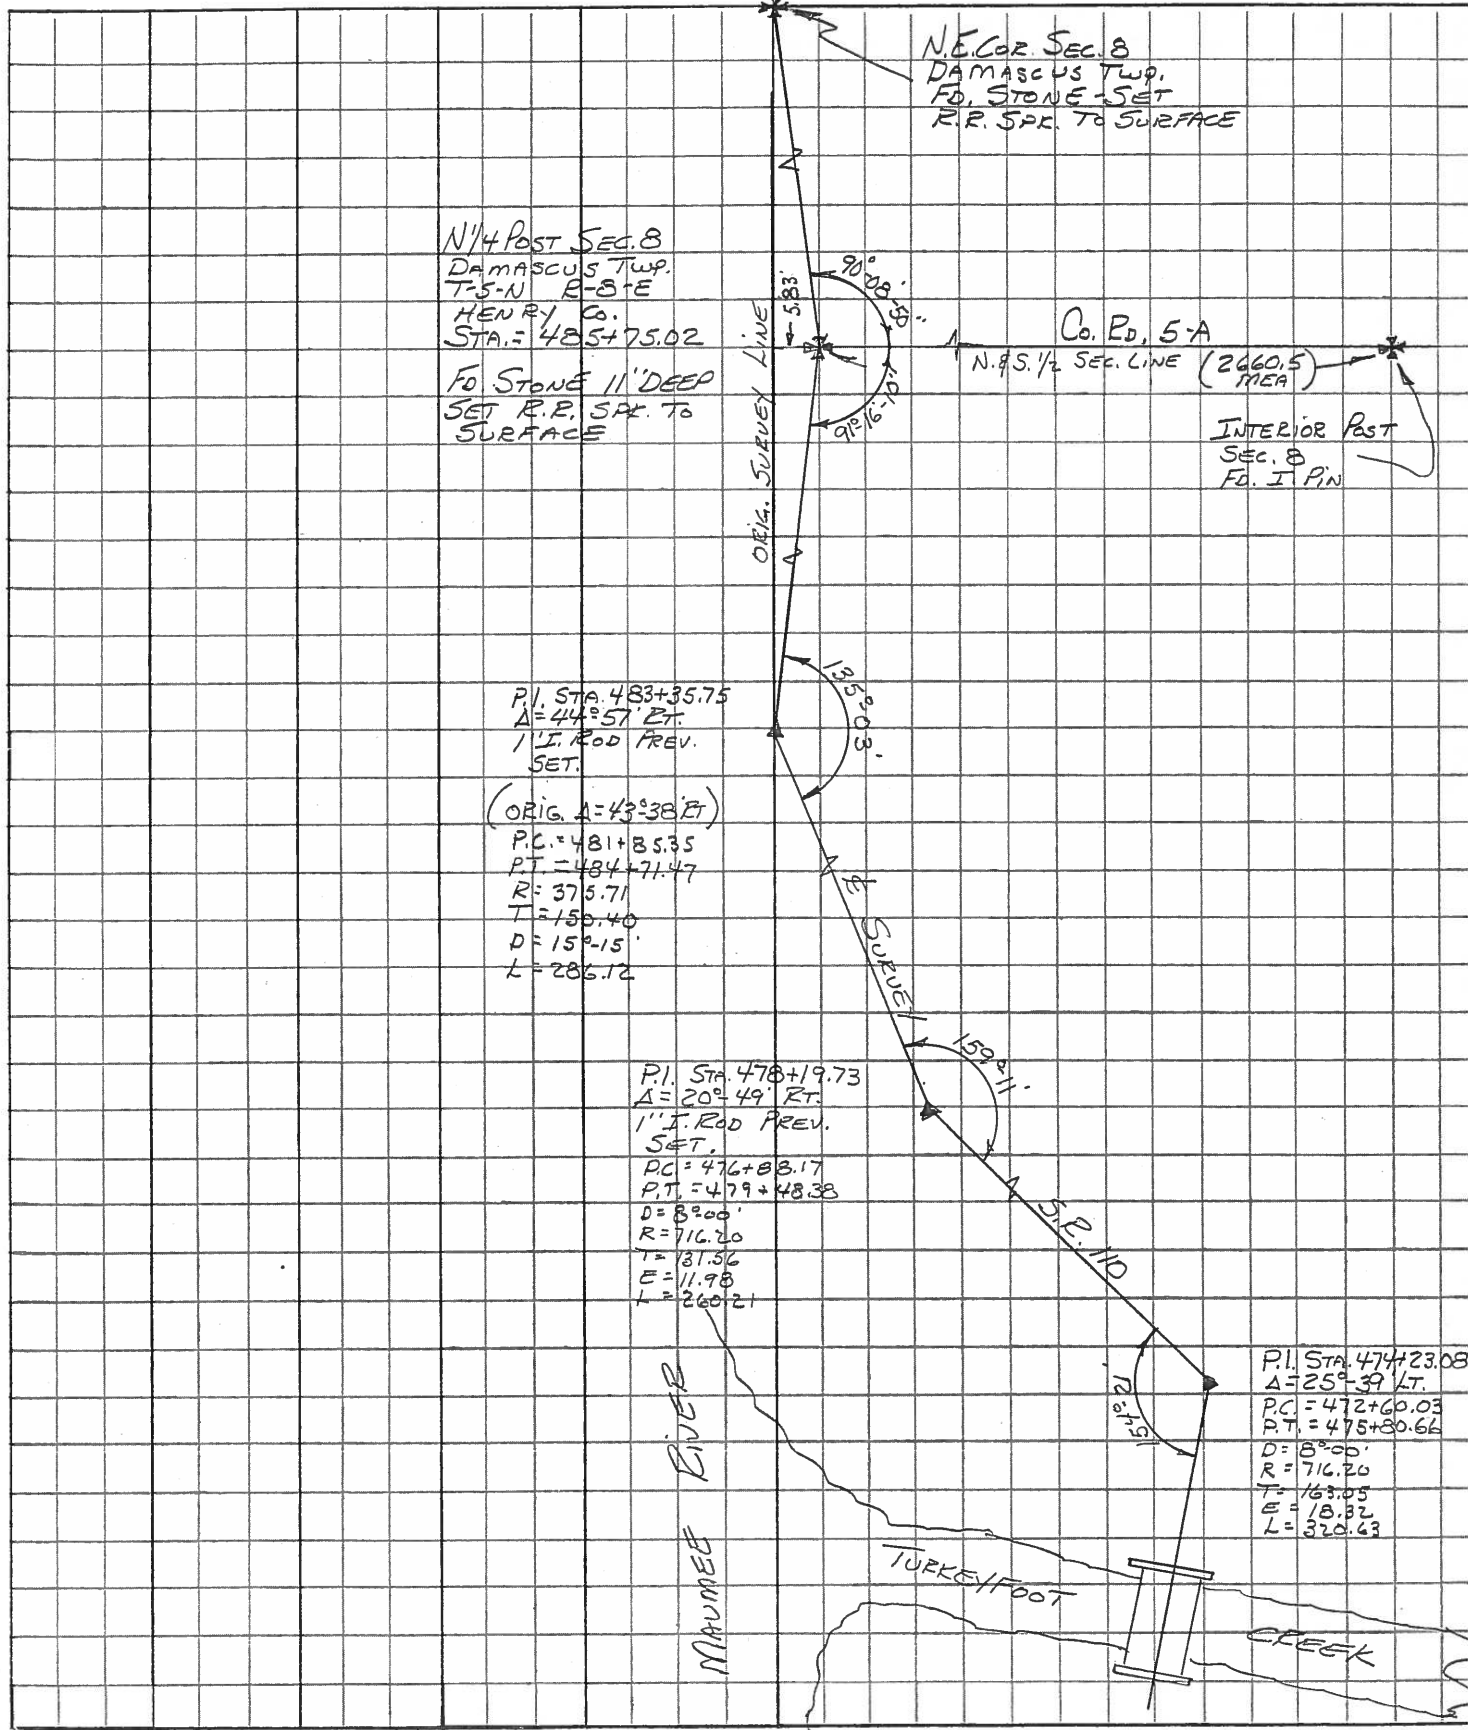

PERSONNEL TITLE PERSONNEL TITLE COUNTY HENRY DATE 4-5-73
BURNSIDE _____
SMITH _____ S. R. 110 WEATHER CLOUDY
BOWERS _____
MEAD _____ SEC. _____ TEMP. +35°

DESCRIPTION 1/2 SURVEY & RW AS PER PLAN OF 1940 JOB NO. _____

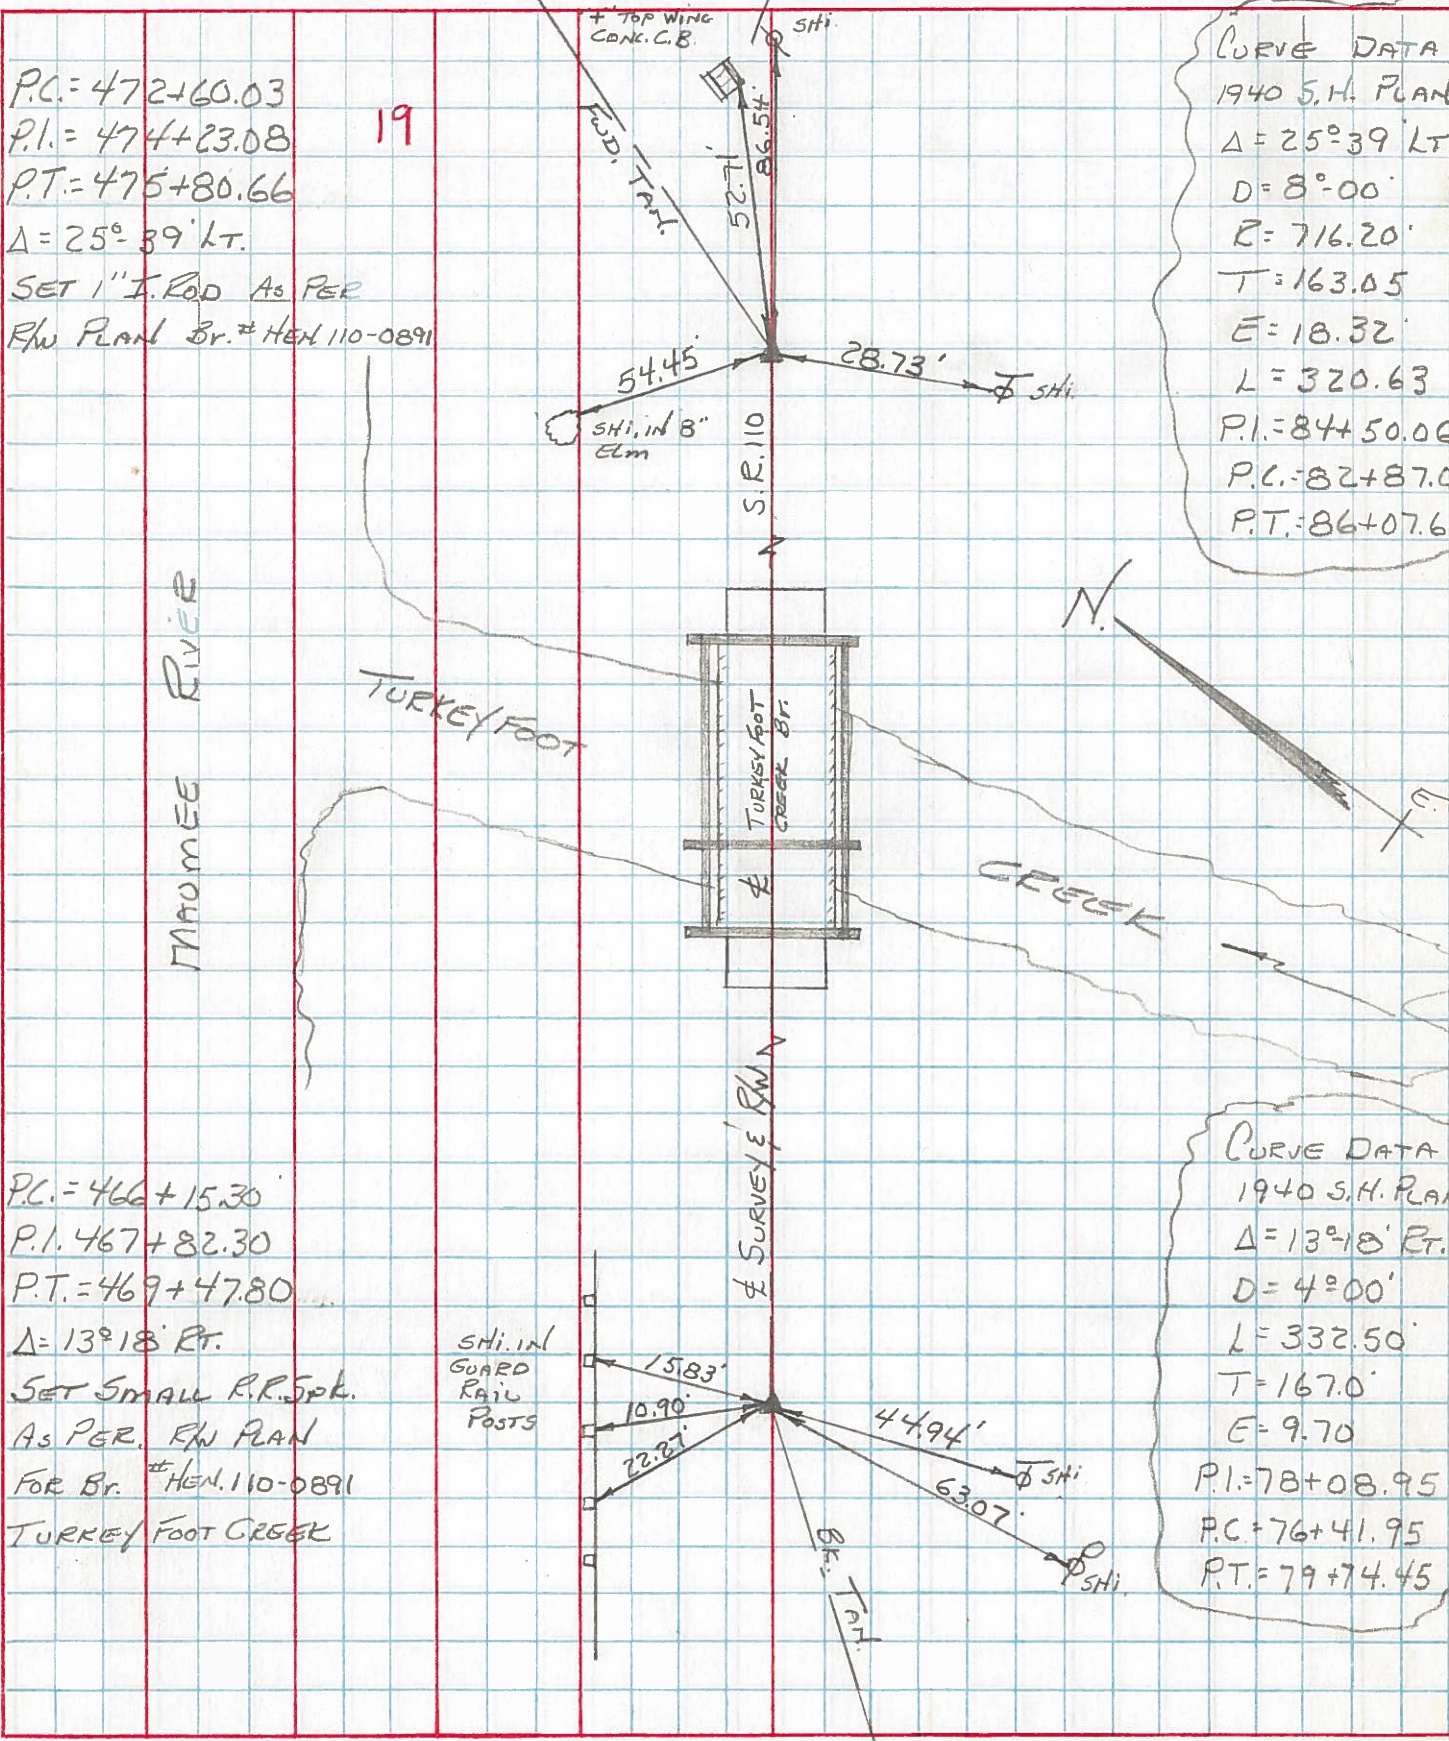

CURVE DATA
 1940 S.H. PLAN
 $\Delta = 25^\circ 39' LT$
 $D = 8^\circ 00'$
 $R = 716.20'$
 $T = 163.05'$
 $E = 18.32'$
 $L = 320.63'$
 $P.I. = 84+50.06$
 $P.C. = 82+87.0$
 $P.T. = 86+07.6$


CURVE DATA
 1940 S.H. PLAN
 $\Delta = 13^\circ 18' RT.$
 $D = 4^\circ 00'$
 $L = 332.50'$
 $T = 167.0'$
 $E = 9.70'$
 $P.I. = 78+08.95$
 $P.C. = 76+41.95$
 $P.T. = 79+74.45$

P.C. = 472+60.03
 P.I. = 474+23.08
 P.T. = 475+80.66
 $\Delta = 25^\circ 39' LT.$
 SET 1" I. ROD AS PER
 RW PLAN Br. # HEN 110-0891

P.C. = 466+15.30
 P.I. = 467+82.30
 P.T. = 469+47.80
 $\Delta = 13^\circ 18' RT.$
 SET SMALL R.R. SPK.
 AS PER RW PLAN
 FOR BR. # HEN. 110-0891
 TURKEY FOOT CREEK

PERSONNEL BURNSIDE TITLE _____ PERSONNEL SMITH TITLE _____
 COUNTY HENRY DATE 4-5-73
 S. R. 110 WEATHER CLOUDY
 MEAD _____ SEC. _____ TEMP. +35°

DESCRIPTION 1/2 SURVEY & RW AS PER PLAN OF 1940 JOB NO. _____

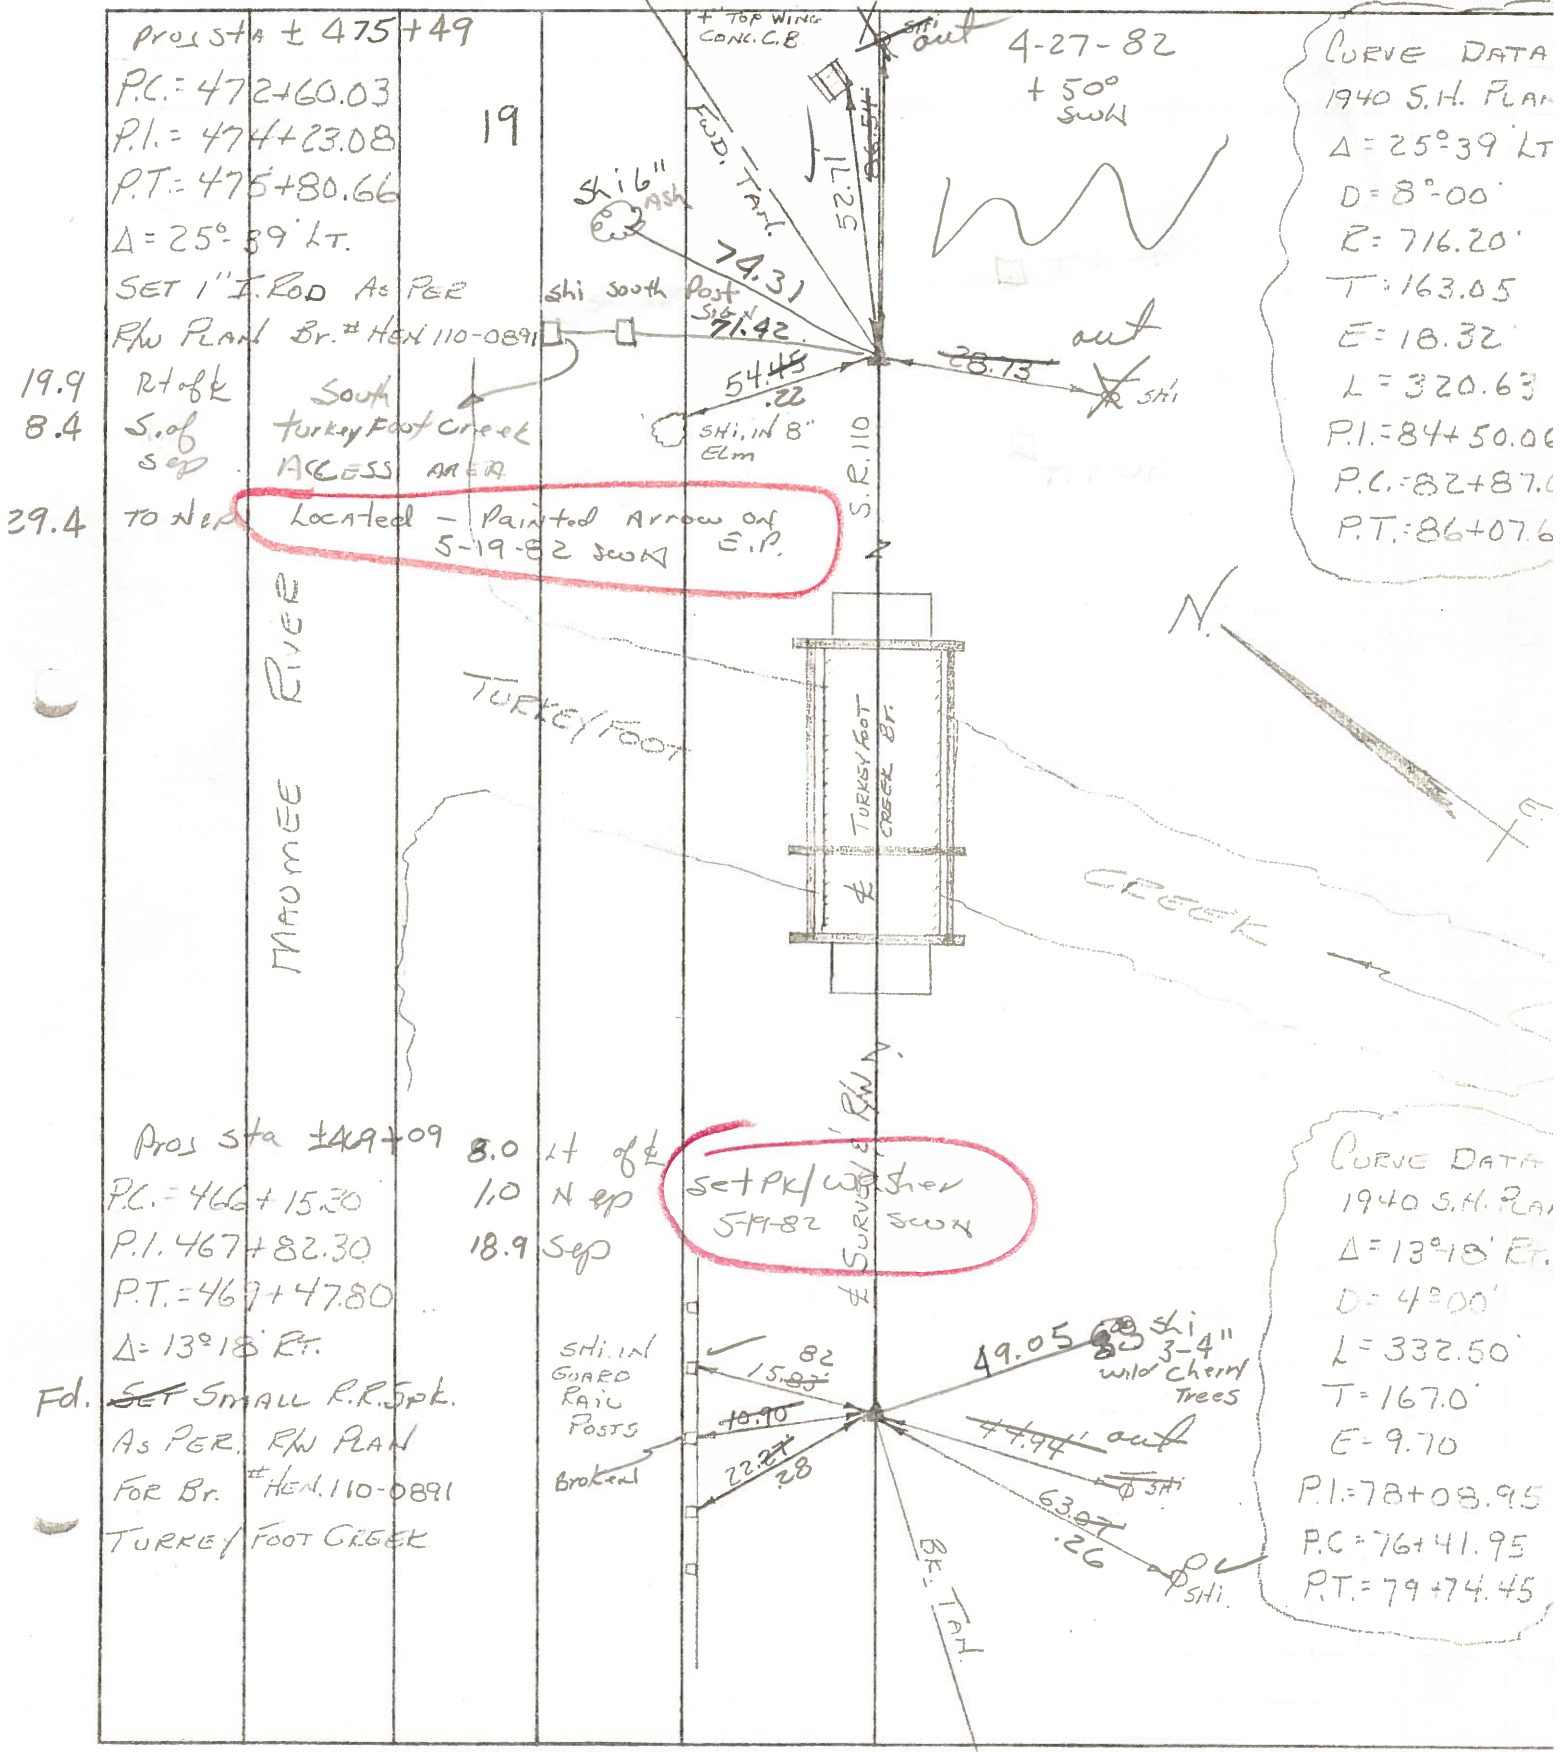

CURVE DATA
 1940 S.H. PLAN
 $\Delta = 25^\circ 39' LT$
 $D = 8^\circ 00'$
 $R = 716.20'$
 $T = 163.05'$
 $E = 18.32'$
 $L = 320.63'$
 $P.I. = 84+50.06$
 $P.C. = 82+87.6$
 $P.T. = 86+07.6$

CURVE DATA
 1940 S.H. PLAN
 $\Delta = 13^\circ 18' RT$
 $D = 4^\circ 00'$
 $L = 332.50'$
 $T = 167.0'$
 $E = 9.70'$
 $P.I. = 78+08.95$
 $P.C. = 76+41.95$
 $P.T. = 79+74.45$

19.9
 8.4
 29.4

PROV STA $\pm 475+49$
 $P.C. = 472+60.03$
 $P.I. = 474+23.08$
 $P.T. = 475+80.66$
 $\Delta = 25^\circ 39' LT$
 SET 1" I. ROD AS PER
 RW PLAN BR. # HEN. 110-0891

PROV STA $\pm 469+09$
 $P.C. = 466+15.30$
 $P.I. = 467+82.30$
 $P.T. = 469+47.80$
 $\Delta = 13^\circ 18' RT$
 Fd. SET SMALL R.R. SPK.
 AS PER RW PLAN
 FOR BR. # HEN. 110-0891
 TURKEY FOOT CREEK

8.0 Lt of
 1.0 N ep
 18.9 Sep
 SET PK/W/SHI SWN
 5-19-82