

O.D.O.T. DISTRICT 2 SURVEY OFFICE (USE ONLY)

PERSONNEL

REFERENCE NO. 19 A

SHEET 47 OF 61

NOTES ASTON

DATE 5/26/23

ROUTE SR 110

H.C. AUBLE

WEATHER CLEAR

COUNTY HENRY

R.C. RHOADES

TEMP. 71°

TOWNSHIP DAMASCUS

SECTION 8

DWG BY RHOADES

PID 114846

T 5 N R 8 E

TYPE MONUMENT 1" IPIN

ON SURFACE - ~~BELOW~~ ON

OFFSET  $\odot$  PAVEMENT 15.8' LT : ~~RT~~

5.1' LT TO LT EDGE PAVEMENT


STATION: 476+37.92

HORIZ.DATUM: NAD83 2011


GEOID: NAVD88 2018

GRID: NORTHING: 640053.443

EASTING: 1564484.439

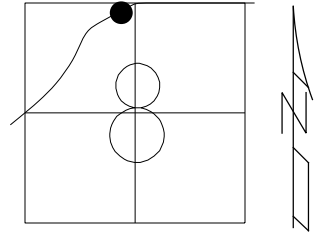


RECORD: P.I.  
FD 1" IPIN  
REFA19  
9/01/15, JFO  
FD 1" IPIN  
REFA19  
12/29/21, DSA

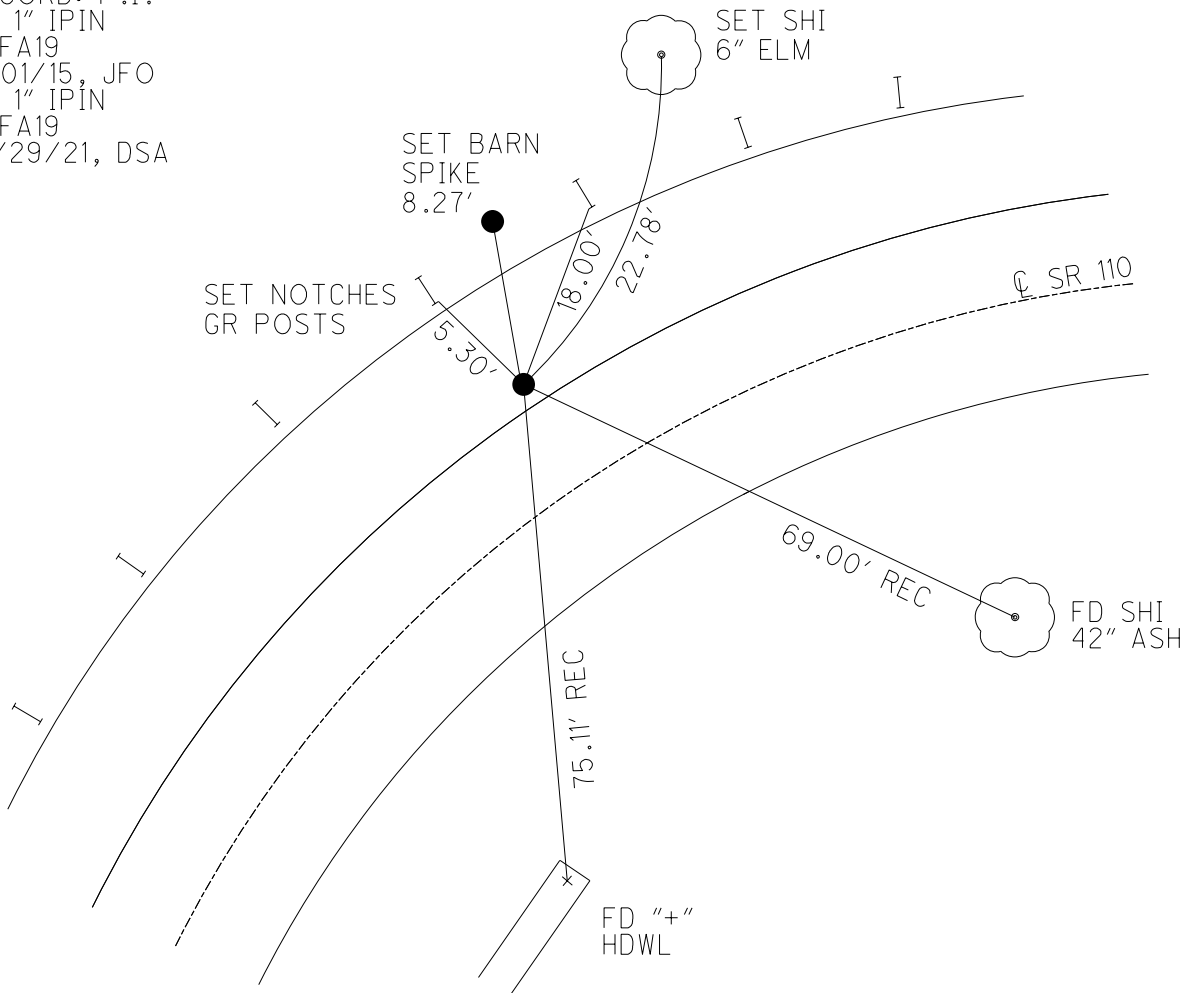


O.D.O.T. DISTRICT 2 SURVEY OFFICE (USE ONLY)

PERSONNEL	REFERENCE NO.	19-A	SHEET	49	OF	58
NOTES	BARNHISEL	DATE	09/25/90	ROUTE	SR 110	
H.C.	BARNHISEL	WEATHER	WINDY-CLEAR	COUNTY	HENRY	
R.C.	HOFFMAN	TEMP.	65°	TOWNSHIP	DAMASCUS	
				SECTION	08	
				T	5	N
				R	8	E

TYPE MONUMENT 1" IRON PIN  
 ON SURFACE - ~~BELOW~~ ON  
~~LEFT~~ - ~~C PAV'T~~ - RIGHT 15.8'  
5.1' TO LT EDGE PAVEMENT  
 S.L.M. 484+59  
 Grid: Northing: 640053.445 Easting: 1564484.438

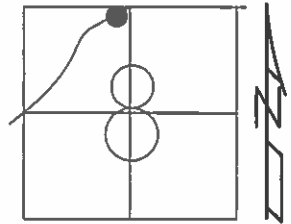

RECORD: PI 1940 PLAN  
 DEF=20°-49' RT, D=8°-00'  
 R=716.20', E=11.98', L=260.21'  
 PI=88+46.7, PC=87+15.14  
 PT=89+75.35, STA.: 88+60 ON  
 CL OF EXISTING R/W  
 (D.N.F. 1" PIN) FD 3/4" I PIN  
 (TREADED) GPS 4.4' LT OF LT EP  
 REFA19  
 09/01/15, JFO  
 NOT COVERED  
 08/03/16, JMR

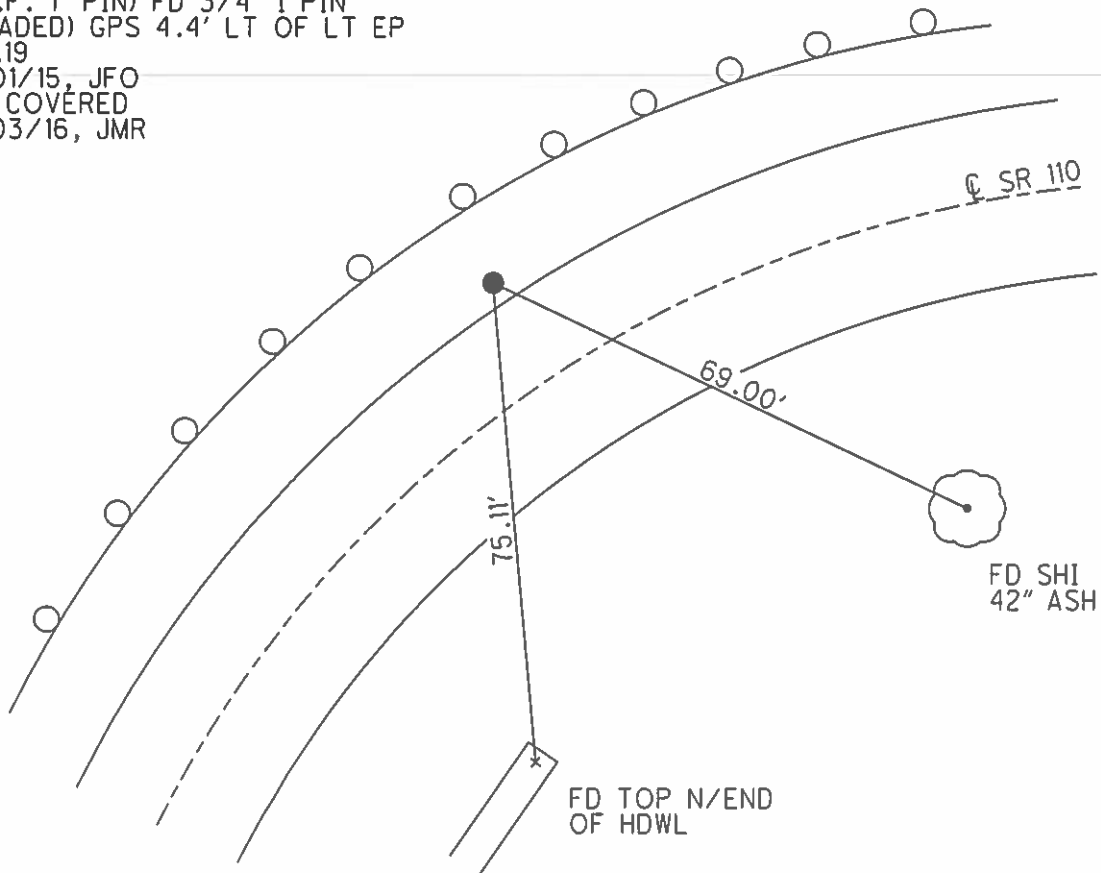

O.D.O.T. DISTRICT 2 SURVEY OFFICE

PERSONNEL

REFERENCE NO. 19-A

SHEET 29 OF 37

NOTES BARNHISEL

DATE 9-25-90

ROUTE S.R. 110

H.C. BARNHISEL

WEATHER WINDY-CLEAR

COUNTY HENRY

R.C. HOFFMAN

TEMP. +65°

TOWNSHIP DAMASCUS

SECTION 8

T 5 N R 8 E



TYPE MONUMENT 1" IRON PIN

ON SURFACE - ~~BELOW~~ YES


LEFT - Q PAV'T - ~~RIGHT~~ 15.8'

5.1' LT OF RT. EDGE PAVEMENT

S.L.M. 484+59

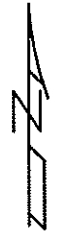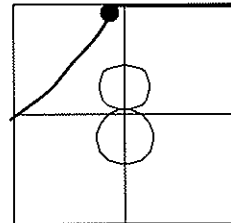

RECORD: PI  
 1940 PLAN  
 DEF=20°-49' RT  
 D=8°-00'  
 R=716.20'  
 E=11.98'  
 L=260.21'  
 PI=88+46.7  
 PC=87+15.14  
 PT=89+75.35  
 STA: 88+60 ON  
 CL OF EXISTING  
 R/W

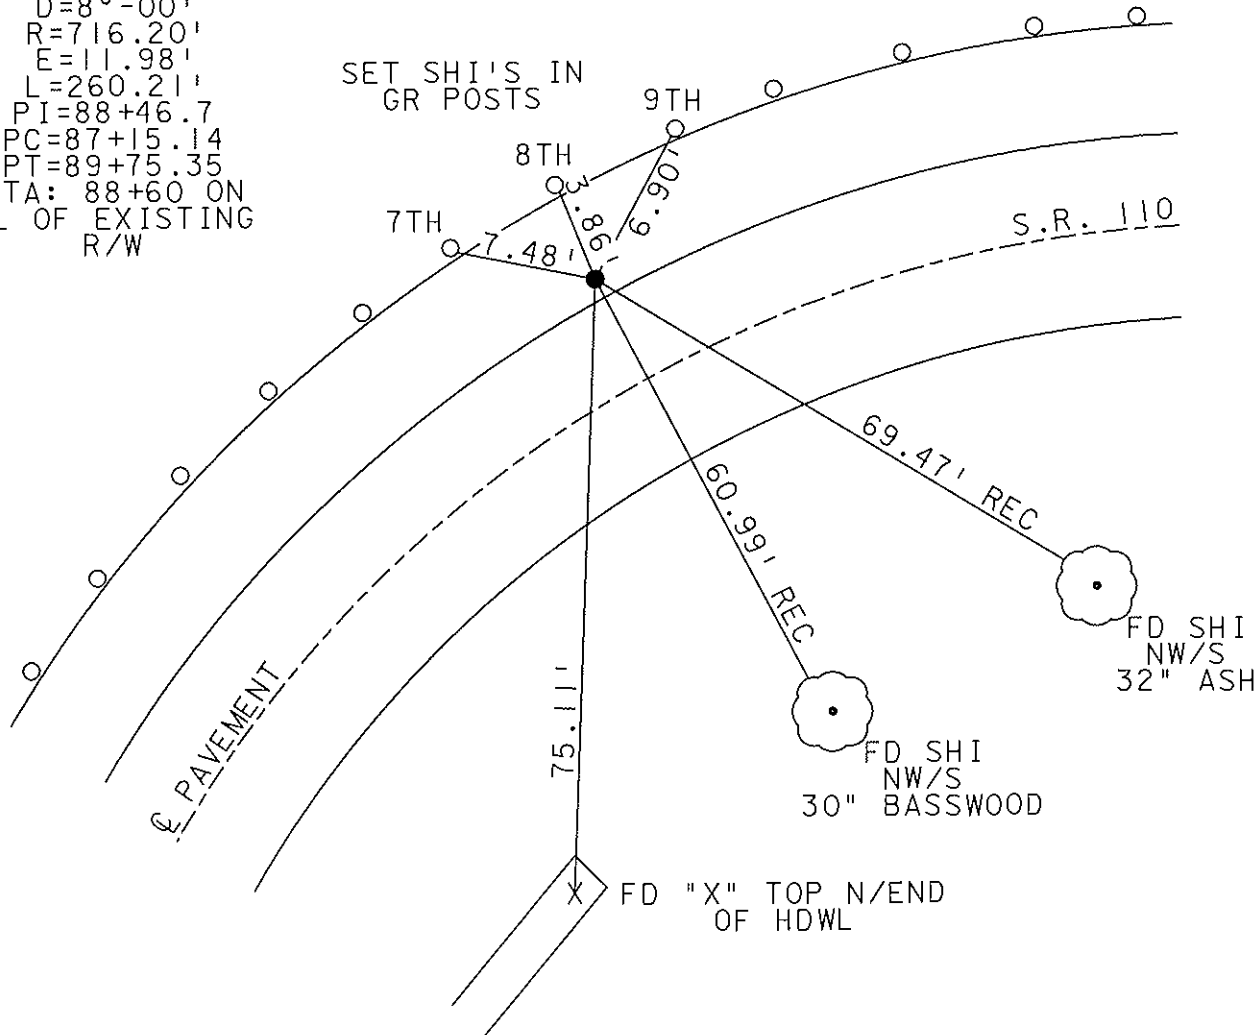

County HENRY S.R. 110

Township DAMASCUS

Section 8

T. N, R. E

Personnel HOFFMAN

HOUSEHOLDER


LOENRKE

19-A

Date 4-27-28


Weather \_\_\_\_\_

Temp. +50°

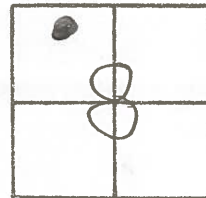


P.C. = 476+88.17  
 P.I. = 478+19.73  
 P.T. = 479+48.38  
 Δ = 20°-49' RT.

CURVE DATA  
 1940 S.H. PLAN  
 Δ = 20°-49' RT.  
 D = 8°-00'  
 R = 716.20'  
 E = 11.98'  
 L = 260.21'  
 P.I. = 88+46.7  
 STA. 88+50 ON Δ  
 EXIST. R/W  
 P.C. = 87+15.14  
 P.T. = 89+75.35

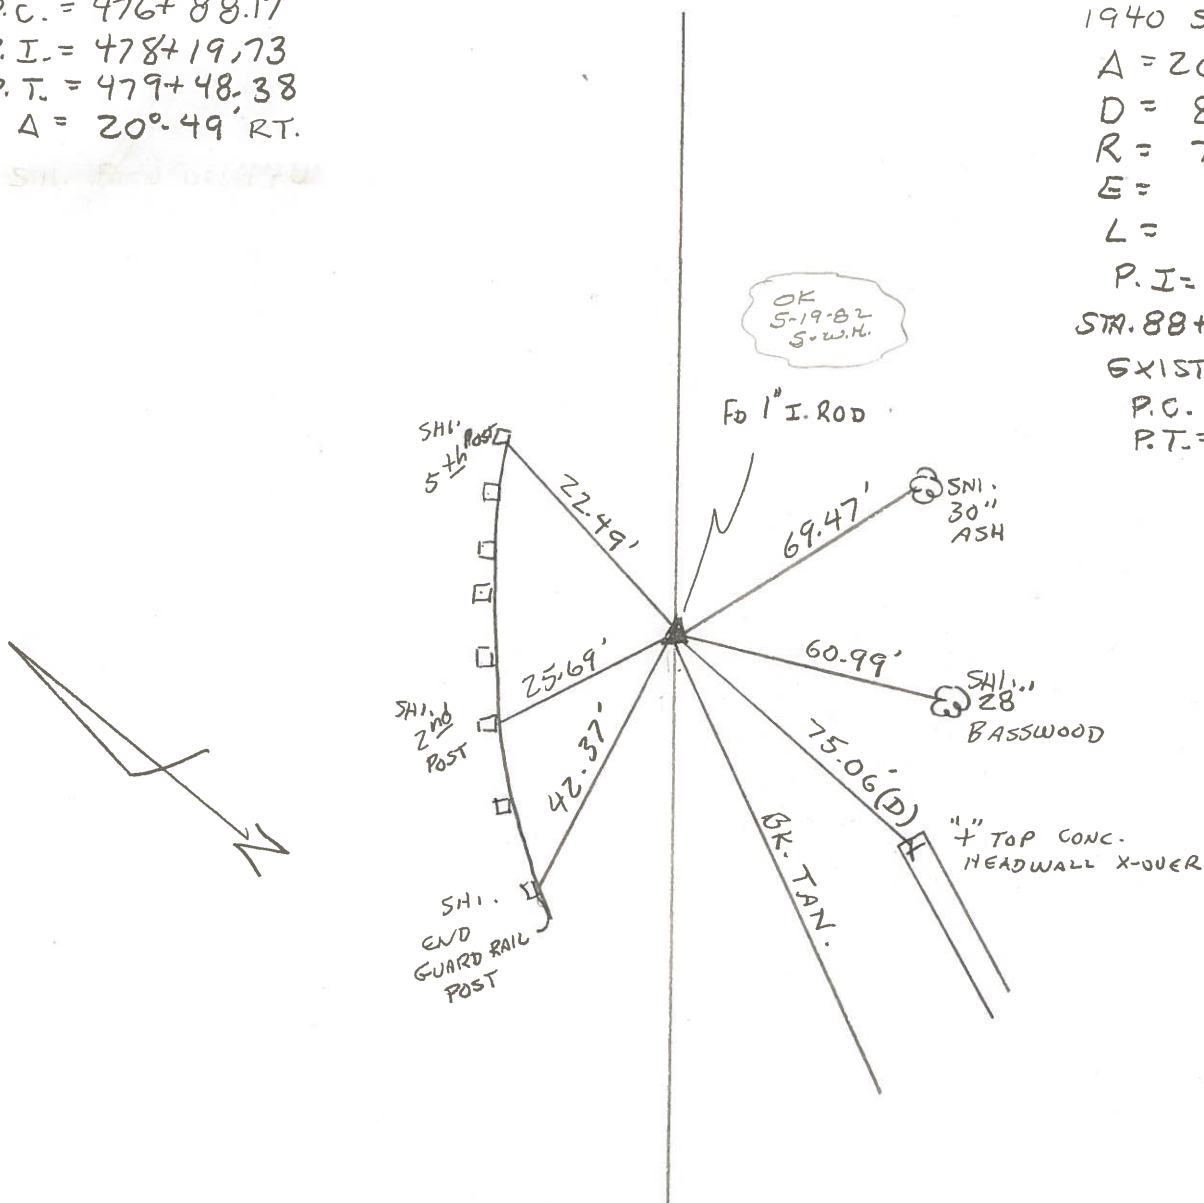

PERSONNEL	TITLE	PERSONNEL	TITLE	COUNTY	HENRY	DATE	8-2-77
BURNSIDE				S. R.	110	WEATHER	CLEAR
SMITH				SEC.	TURKEYFOOT BRIDGE	TEMP.	+82°
KNAPE							
MEAD							

DESCRIPTION: ALIGNMENT @ PROPOSED PARK SITE

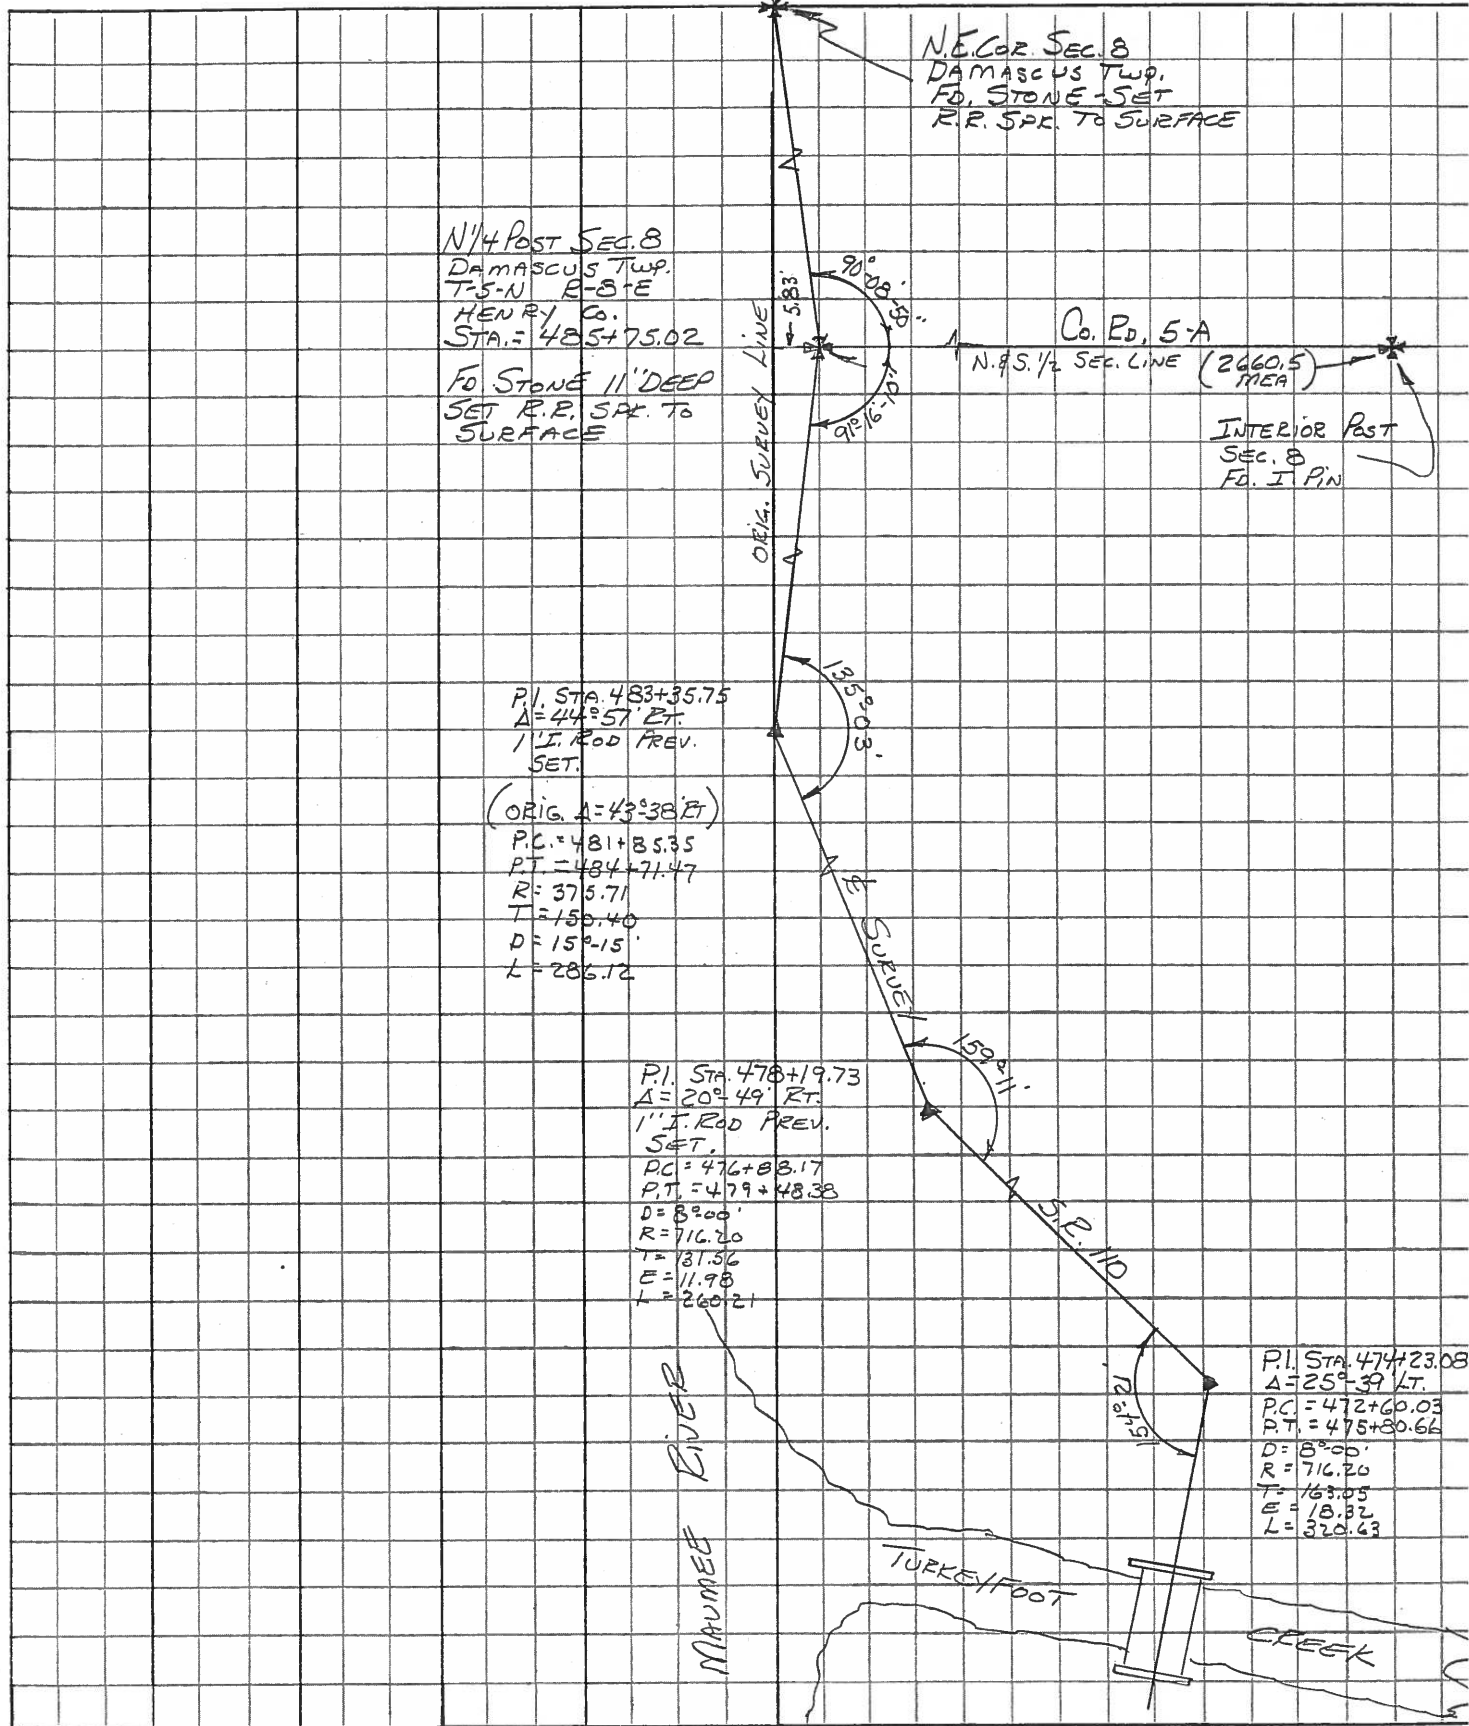



PERSONNEL BURNSIDE TITLE \_\_\_\_\_ PERSONNEL SMITH TITLE \_\_\_\_\_ COUNTY HENRY DATE 4-5-73  
 PERSONNEL BOWERS TITLE \_\_\_\_\_ S. R. 110 WEATHER PT. CLOUD.  
 PERSONNEL MEAD TITLE \_\_\_\_\_ SEC. \_\_\_\_\_ TEMP. +38°

DESCRIPTION ± RW AS PER S.H. PLAN OF 1940 JOB NO. \_\_\_\_\_

