

O.D.O.T. DISTRICT 2 SURVEY OFFICE (USE ONLY)

PERSONNEL

REFERENCE NO. 19 B

SHEET 48 OF 61

NOTES ASTON

DATE 5/26/23

ROUTE SR 110

H.C. AUBLE

WEATHER CLEAR

COUNTY HENRY

R.C. RHOADES

TEMP. 71°

TOWNSHIP DAMASCUS

SECTION 8

DWG BY RHOADES PID 114846

T 5 N R 8 E

TYPE MONUMENT 1" IPIN

ON SURFACE - ~~BELOW~~ ON

OFFSET ☉ PAVEMENT 31.4' LT : ~~RT~~

21.3' LT TO LT EDGE PAVEMENT


STATION: 481+53.72

HORZ. DATUM: NAD83 2011

GEOID: NAVD88 2018

GRID: NORTHING: 640407.051

EASTING: 1564863.953

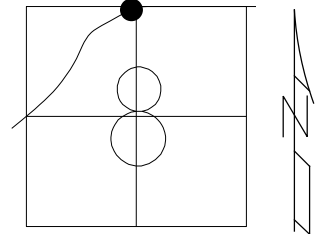


RECORD: P.I.
 FD 1" IPIN
 REFB19
 9/01/15, JFO
 FD 1" IPIN
 REFB19
 12/29/21, DSA

SET SHI
 6"
 5.29'

SET SHI
 6"
 4.58'


SET NOTCH
 GR POST
 16.45'

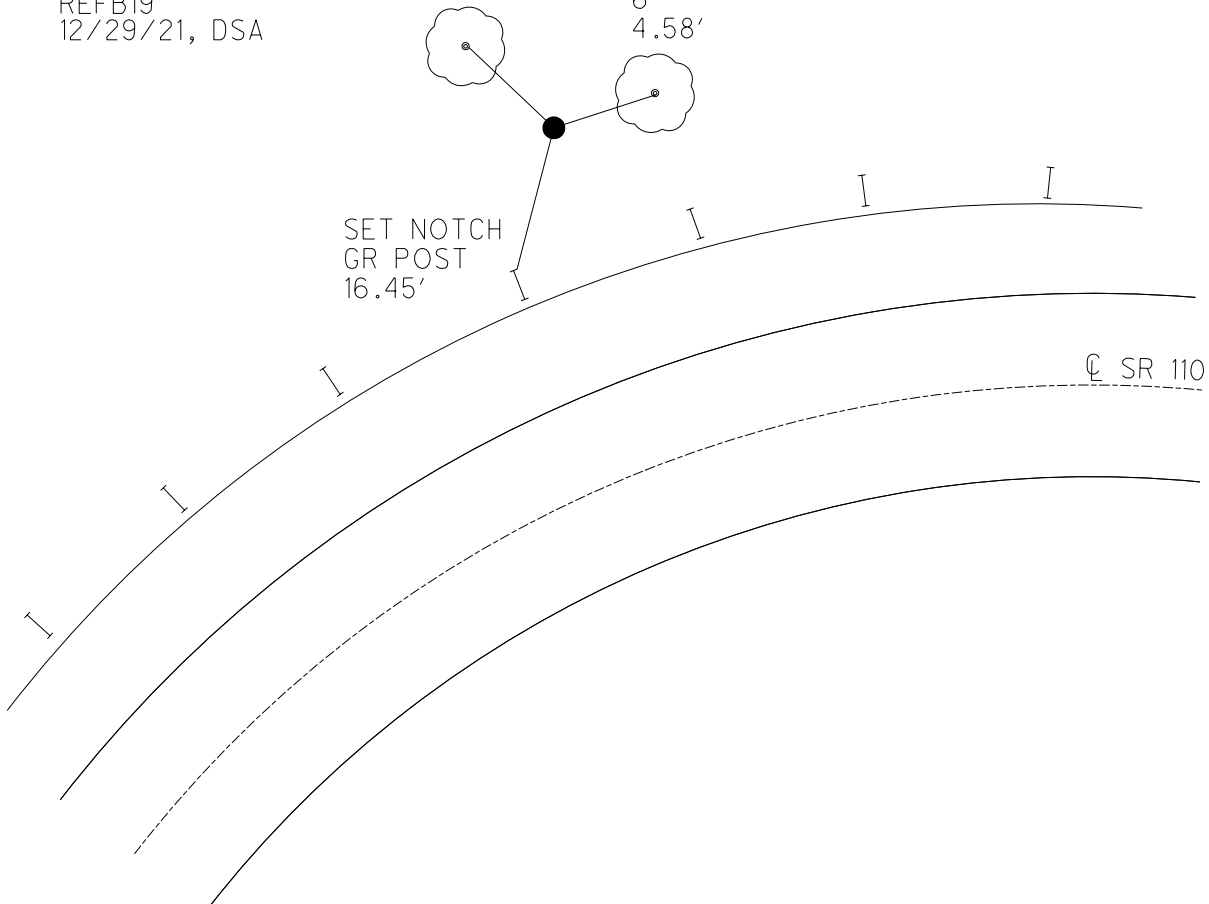

O.D.O.T. DISTRICT 2 SURVEY OFFICE (USE ONLY)


PERSONNEL	REFERENCE NO.	<u>19-B</u>	SHEET	<u>50</u>	OF	<u>58</u>
NOTES	<u>BARNHISEL</u>	DATE	<u>09/25/90</u>	ROUTE	<u>SR 110</u>	
H.C.	<u>BARNHISEL</u>	WEATHER	<u>CLEAR</u>	COUNTY	<u>HENRY</u>	
R.C.	<u>HOFFMAN</u>	TEMP.	<u>65°</u>	TOWNSHIP	<u>DAMASCUS</u>	
				SECTION	<u>08</u>	
				T	<u>5</u>	R
					<u>N</u>	<u>E</u>

TYPE MONUMENT 1" IRON PIN
 ON SURFACE - ~~BELOW~~ ON
~~LEFT - C PAV'T~~ - RIGHT 31.4'
21.3' TO LT EDGE PAVEMENT
 S.L.M. 489+68

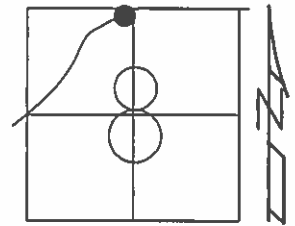

Grid: Northing: 640406.961 Easting: 1564863.893

RECORD: PI
 PI OF EXISTING CL.
 STA: 93+68.9
 DEF.=43°-35' RT
 GPS, REFB19
 NOT COVERED
 08/03/16, JMR

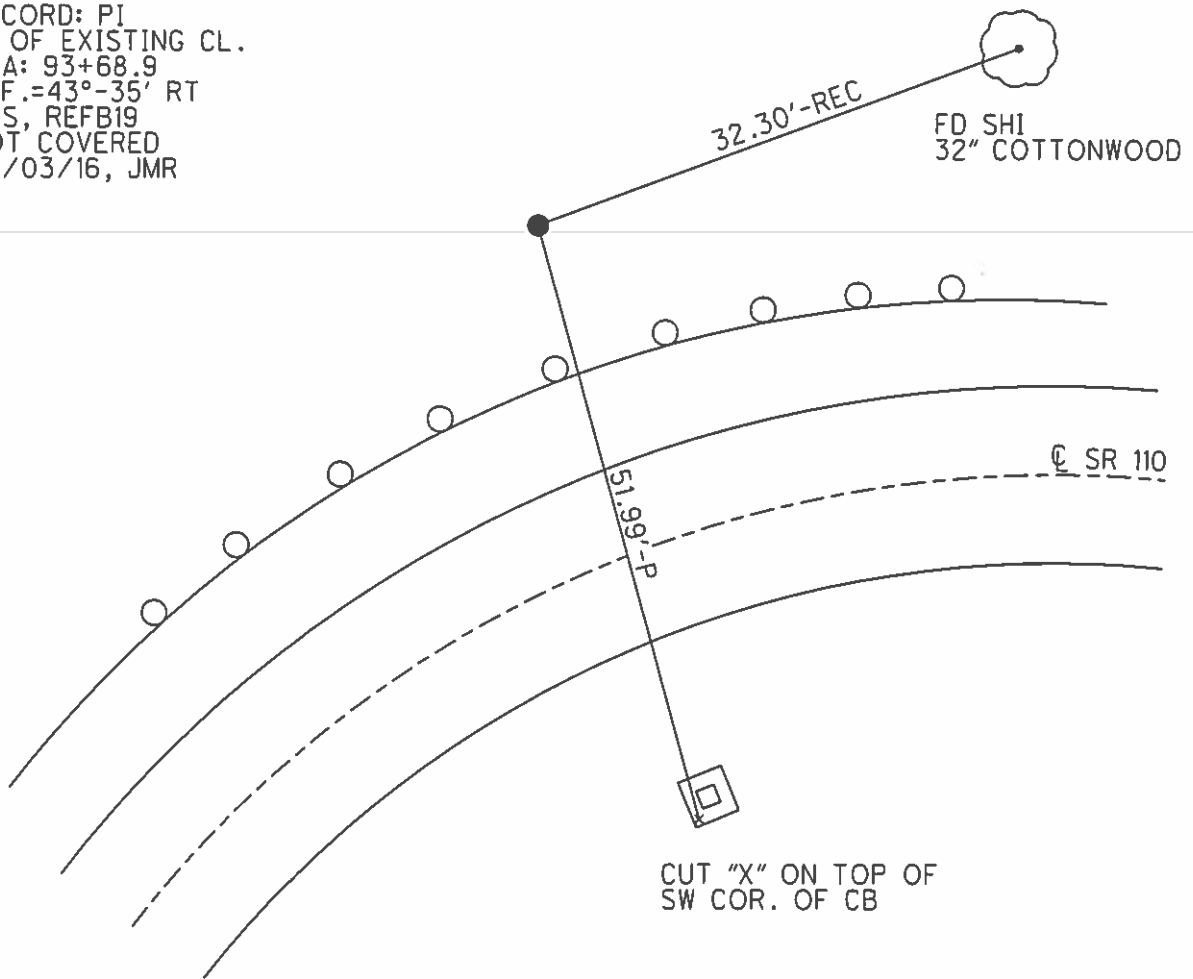

CUT "X" ON TOP OF SW COR. OF CB

O.D.O.T. DISTRICT 2 SURVEY OFFICE

PERSONNEL

REFERENCE NO. 19-B

SHEET 30 OF 37

NOTES BARNHISEL

DATE 9-25-90

ROUTE S.R. 110

H.C. BARNHISEL

WEATHER WINDY-CLEAR

COUNTY HENRY

R.C. HOFFMAN

TEMP. +65°

TOWNSHIP DAMASCUS

SECTION 8

T 5 N R 8 E


TYPE MONUMENT 1" IRON PIN

ON SURFACE - ~~BELOW~~ YES

LEFT - Q PAV'T - ~~RIGHT~~ 31.4'


21.3' LT OF LT EDGE PAVEMENT

S.L.M. 489+68

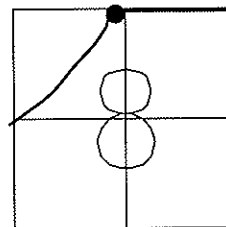

RECORD: PI
PI OF EXISTING CL.
STA: 93+68.9
DEF. = 43°-35' RT

FD SHI
W/S
32" COTTONWOOD

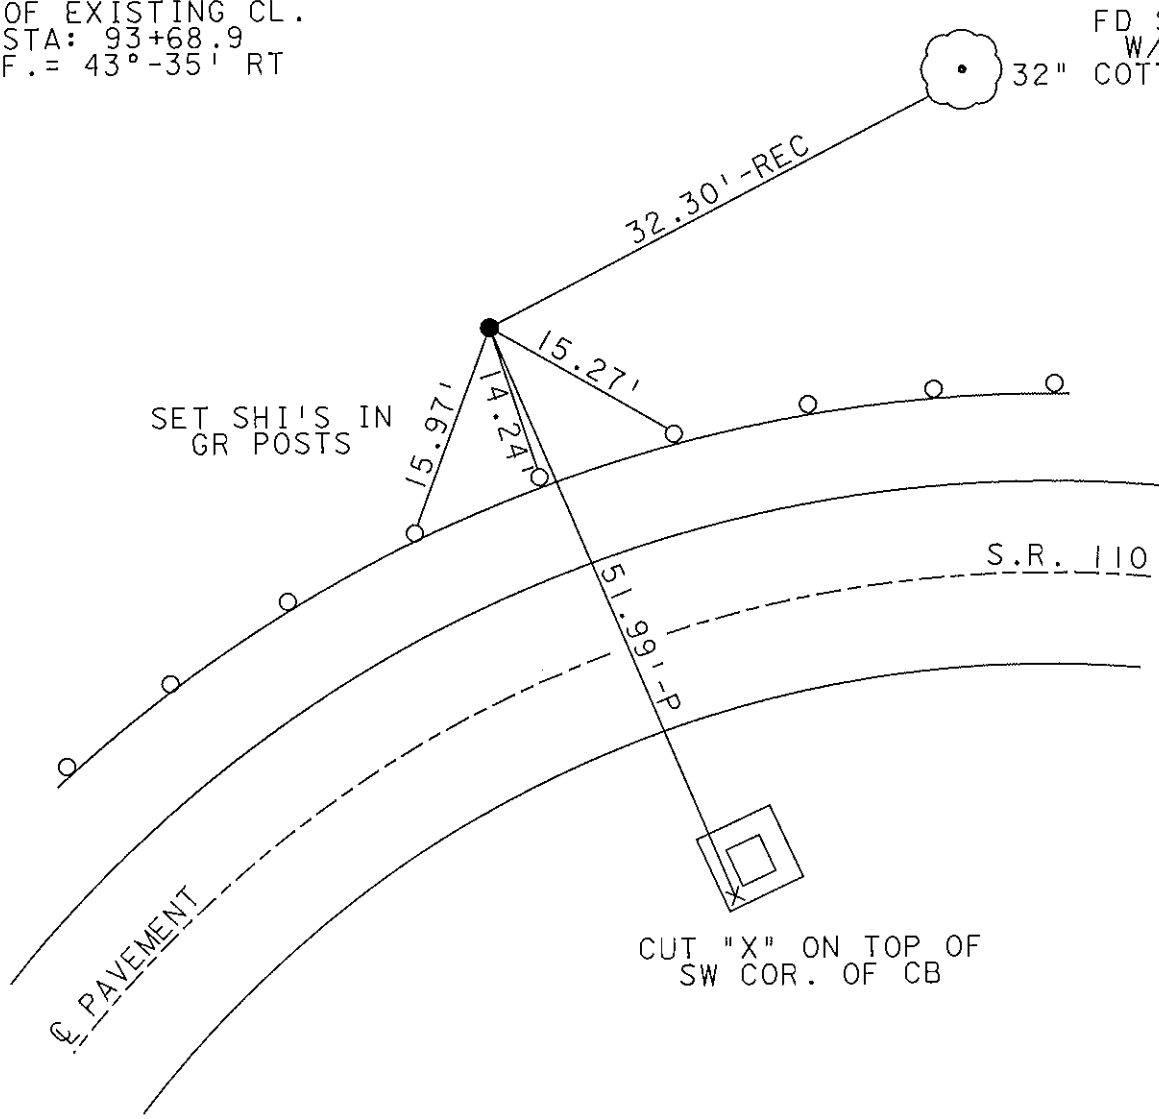

County HENRY S.R. 110

Date 4-27-82

Township DAMASCUS

Weather _____


Section 8

Temp. +50°

T N, R E

Personnel NOFFMAN
HOUSEHOLDER
LOGHRKE


19-B

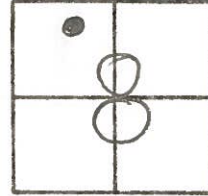

P.I. 483+35.75

$\Delta = 43^\circ 35' RT.$

P.I. ON EXIST. ϕ
STA. 93+68.9
 $\Delta = 43^\circ 35' RT.$

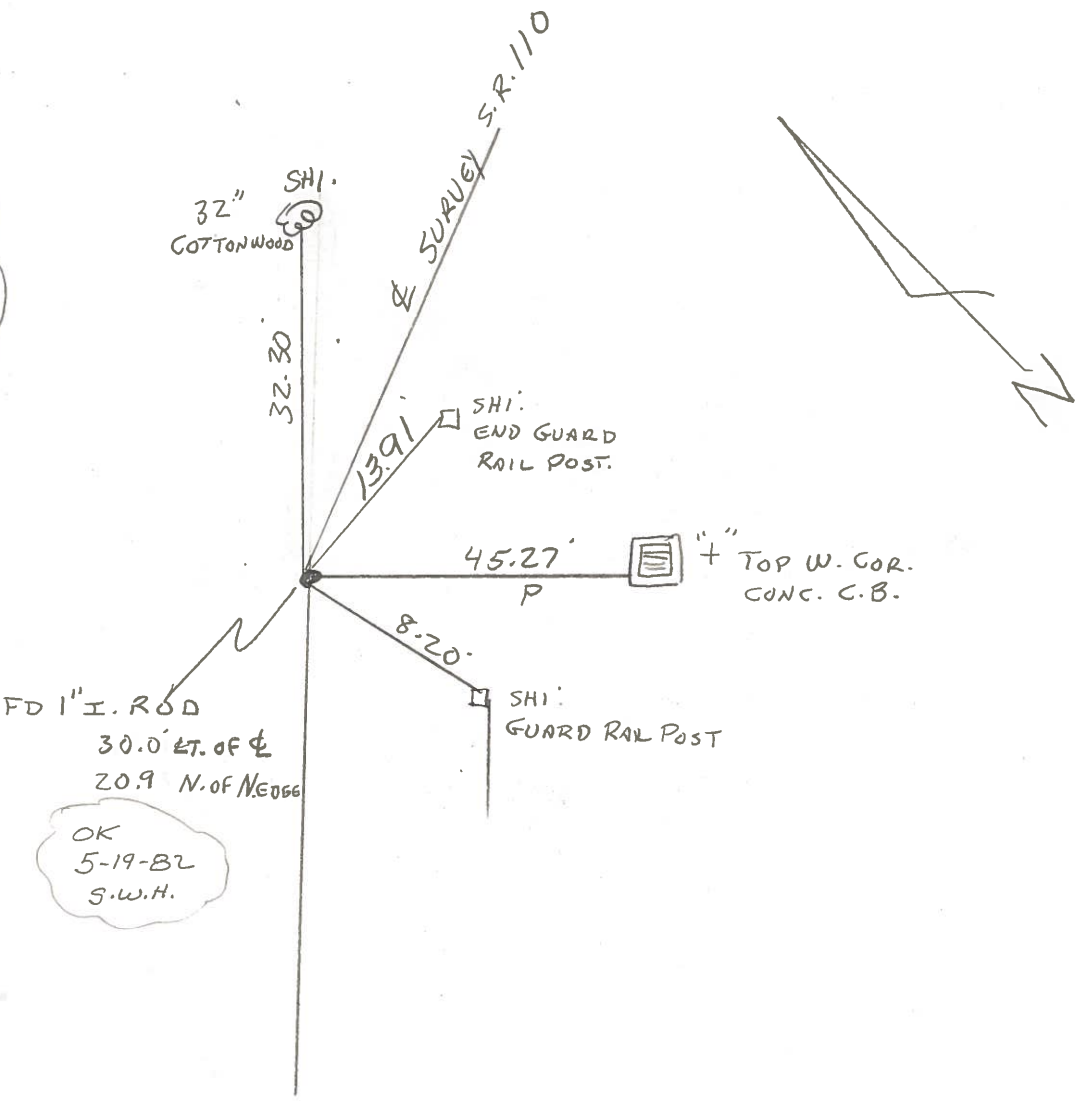


OK
5-19-82
S.W.H.

483+35.75
93+68.9
483+35.75
93+68.9
PERSONNEL	TITLE	PERSONNEL	TITLE	COUNTY	HENRY	DATE	8-2-77
BURNSIDE				S. R.	110	WEATHER	CLEAR
SMITH				SEC.	TURKEYFOOT BRIDGE	TEMP.	+82°
KNAPE							
MEAD							

DESCRIPTION: ALIGNMENT @ PROPOSED PARK SITE

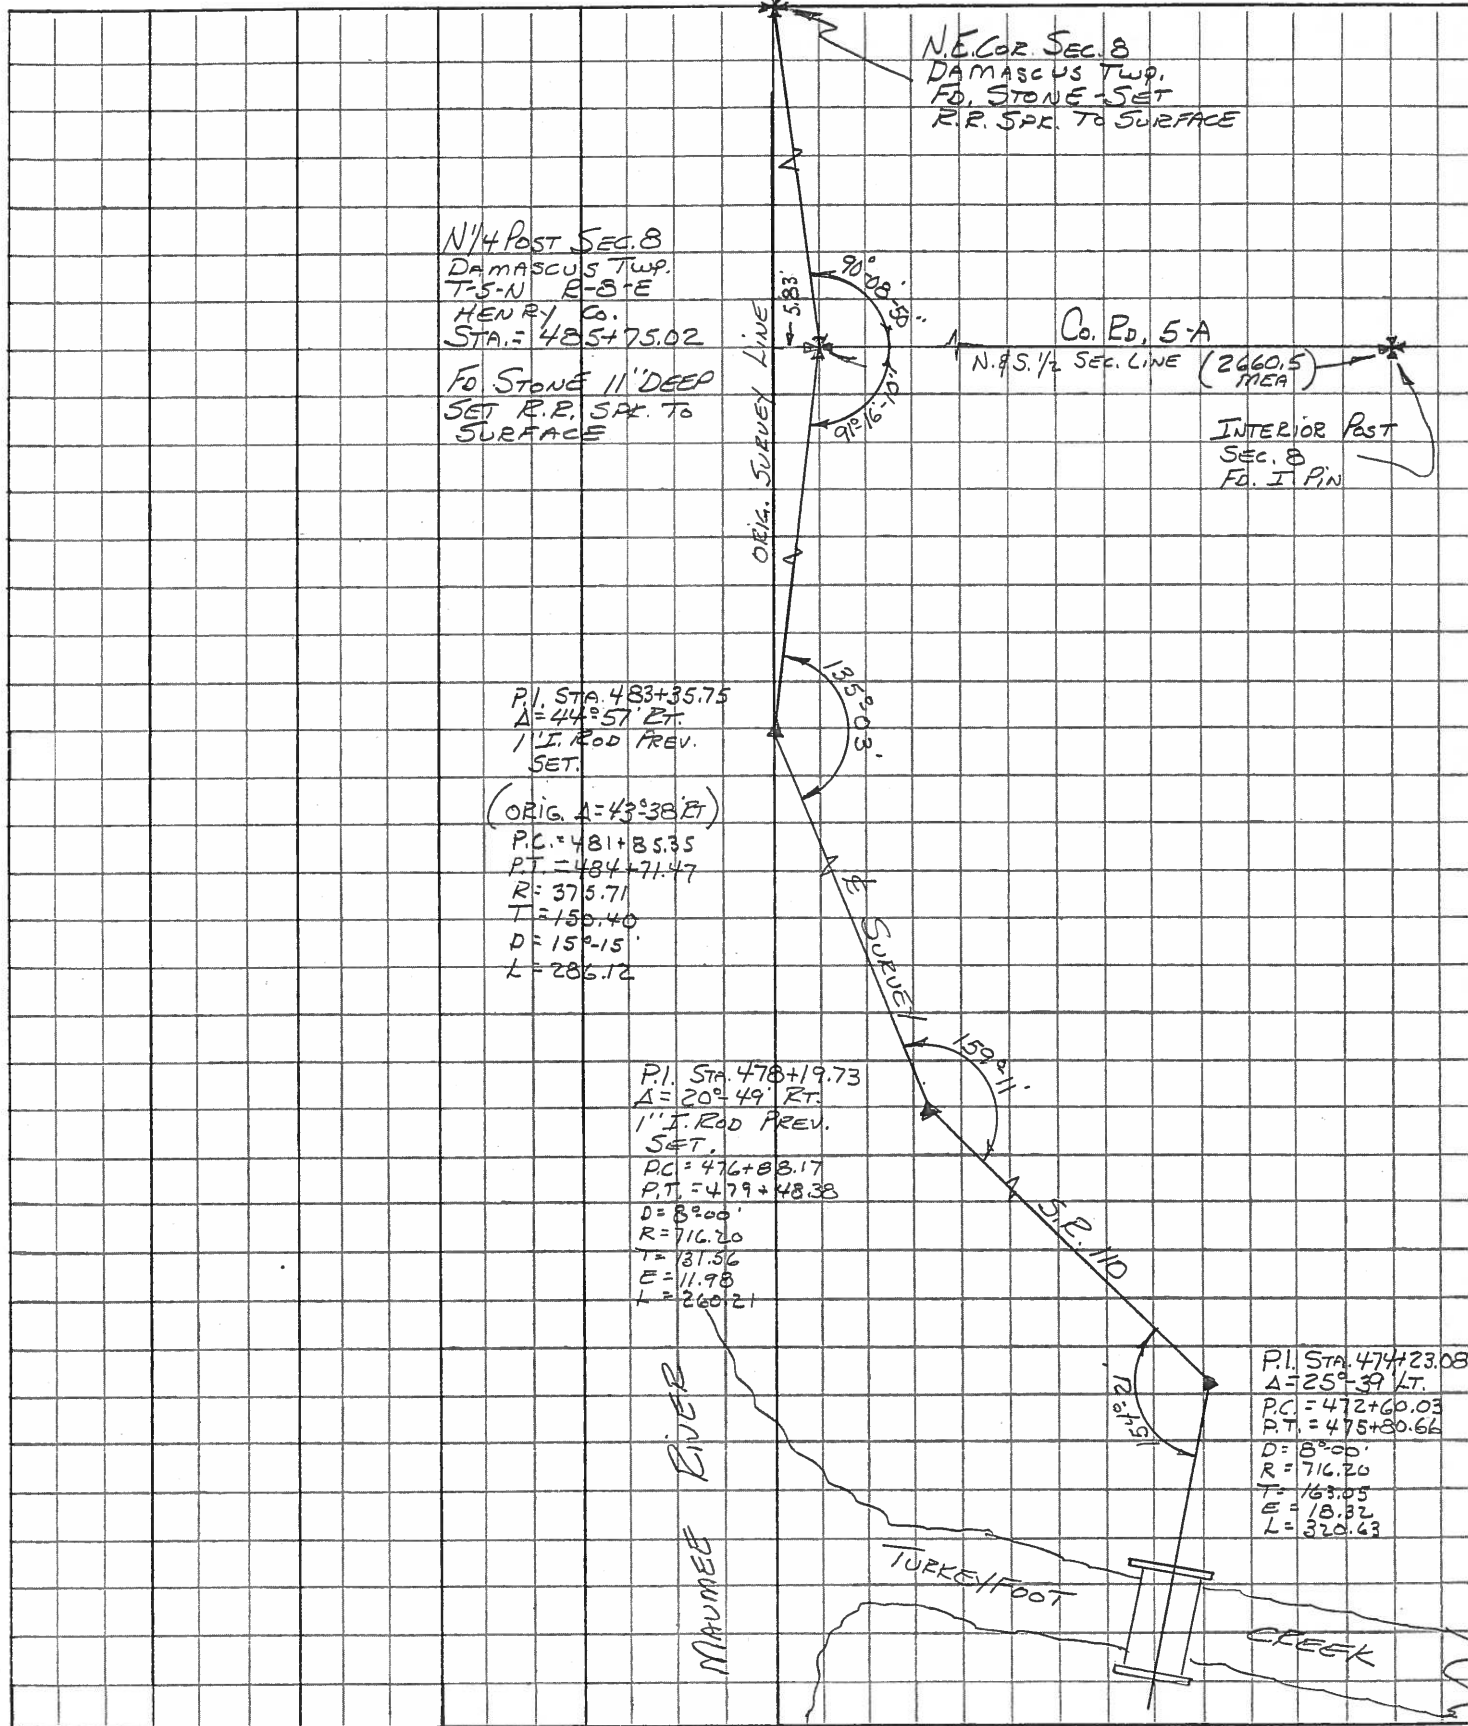

PERSONNEL TITLE PERSONNEL TITLE COUNTY HENRY DATE 4-5-73
BURNSIDE _____
SMITH _____
BOWERS _____
MEAD _____
 S. R. 110 WEATHER P. Cloud
 SEC. _____ TEMP. +38°

DESCRIPTION ± RW AS PER S.H. PLAN OF 1940 JOB NO. _____
 LEFT CENTER LINE RIGHT

