

O.D.O.T. DISTRICT 2 SURVEY OFFICE (USE ONLY)

PERSONNEL

REFERENCE NO. 22 B

SHEET 56 OF 61

NOTES MILLER DATE 12/19/23

H.C. AUBLE WEATHER CLOUDY

R.C. RHOADES TEMP. 27°

ASTON

ROUTE SR 110

COUNTY HENRY

TOWNSHIP DAMASCUS

SECTION 9

DWG BY RHOADES PID 119499

T 5 N R 8 E

TYPE MONUMENT MAG/WASHER

ON SURFACE - ~~BELOW~~ ON

OFFSET CL PAVEMENT 5' ~~LT~~ : RT

5.4' TO RT EDGE PAVEMENT


STATION: 547+07.93

HORZ. DATUM: NAD83 2011

GEOID: NAVD88 2018

GRID: NORTHING: 640325.945

EASTING: 1571333.364

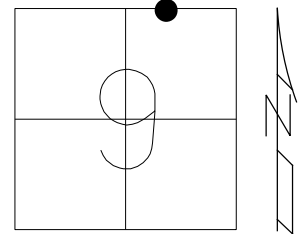

RECORD:  
PROPERTY LINE  
SET MAG/WASHER  
PL2  
12/19/23, DSA

HEN LDP  
N: 497426.627  
E: 205711.712

