

O.D.O.T. DISTRICT 2 SURVEY OFFICE (USE ONLY)

PERSONNEL

REFERENCE NO. 4 B

SHEET 7 OF 20

NOTES RHOADES

DATE 6-7-18

ROUTE SR 281

H.C. O'DONNELL

WEATHER CLOUDY

COUNTY HENRY

R.C. TRENKA

TEMP. 65°

TOWNSHIP FLAT ROCK

DWG BY JAMES

PID 102763

SECTION 29

T 4 N R 6 E

TYPE MONUMENT P.K. SHANK

ON SURFACE - ~~BELOW~~ ON

OFFSET CL PAVEMENT 4' ~~LT~~ : RT

6.6' TO RT EDGE PAVEMENT


STATION: 76+48.17

HORZ.DATUM: NAD83 2011


GEOID: NAVD88 2012A

GRID: NORTHING: 593126.832

EASTING: 1501410.527

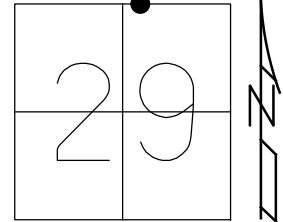


RECORD:
 FD P.K.NAIL
 1985
 SET P.K./WASHER
 6-8-95, KPM
 FD P.K./WASHER
 8-20-09, KPM
 SET MAG/WASHER
 10-19-09, KPM
 FD P.K. SHANK
 REF B4
 6-7-18, JFO

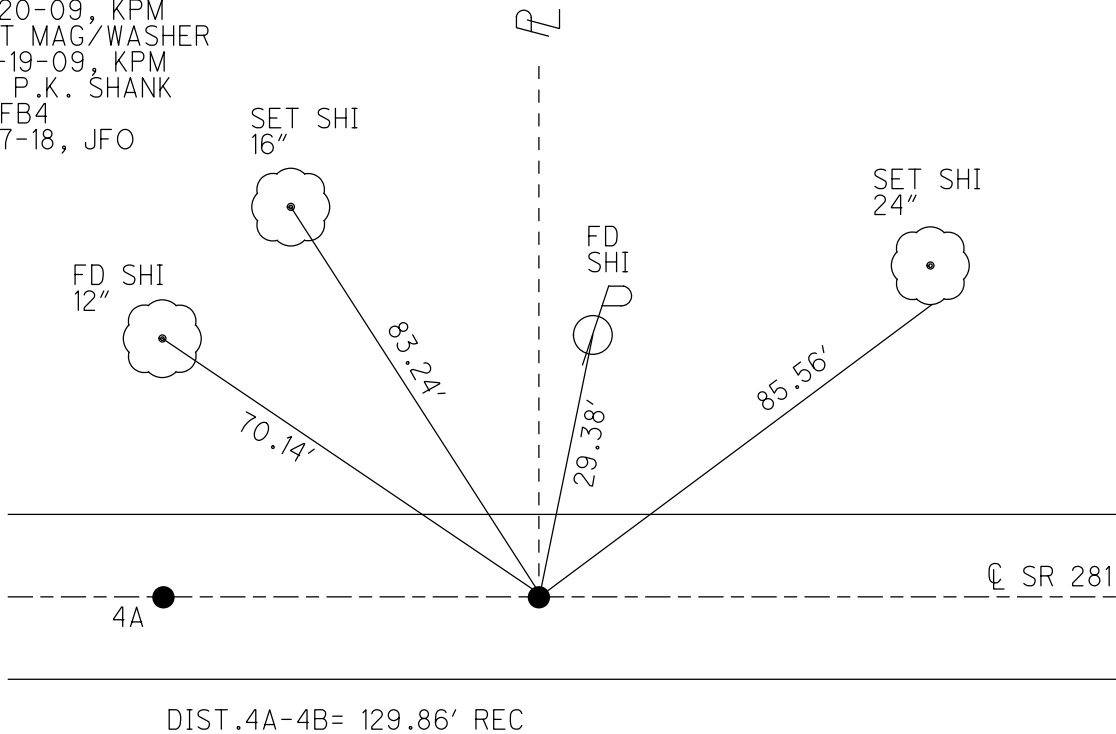

O.D.O.T. DISTRICT 2 SURVEY OFFICE (USE ONLY)


PERSONNEL	REFERENCE NO. <u>4 B</u>	SHEET <u>5</u> OF <u>14</u>
NOTES <u>MOSER</u>	DATE <u>8/20/09</u>	ROUTE <u>SR 281</u>
H.C. <u>GOLDBERG</u>	WEATHER <u>CLOUDY</u>	COUNTY <u>HENRY</u>
R.C. <u>MOSER</u>	TEMP. <u>75°</u>	TOWNSHIP <u>FLAT ROCK</u>
		SECTION <u>29</u>
		T <u>4</u> N R <u>6</u> E

TYPE MONUMENT P.K./WASHER
 ON SURFACE - ~~BELOW~~ ON
~~LEFT = C~~ PAV'T - RIGHT 3.2'
6.6' TO RT EDGE PAVEMENT
 S.L.M. 76+44

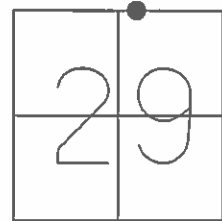

GRID: NORTHING: 593126.832 EASTING: 1501410.527

RECORD:
 FD P.K.NAIL
 1985
 SET P.K./WASHER
 6/8/95, KPM
 SET MAG/WASHER
 10/19/09, KPM

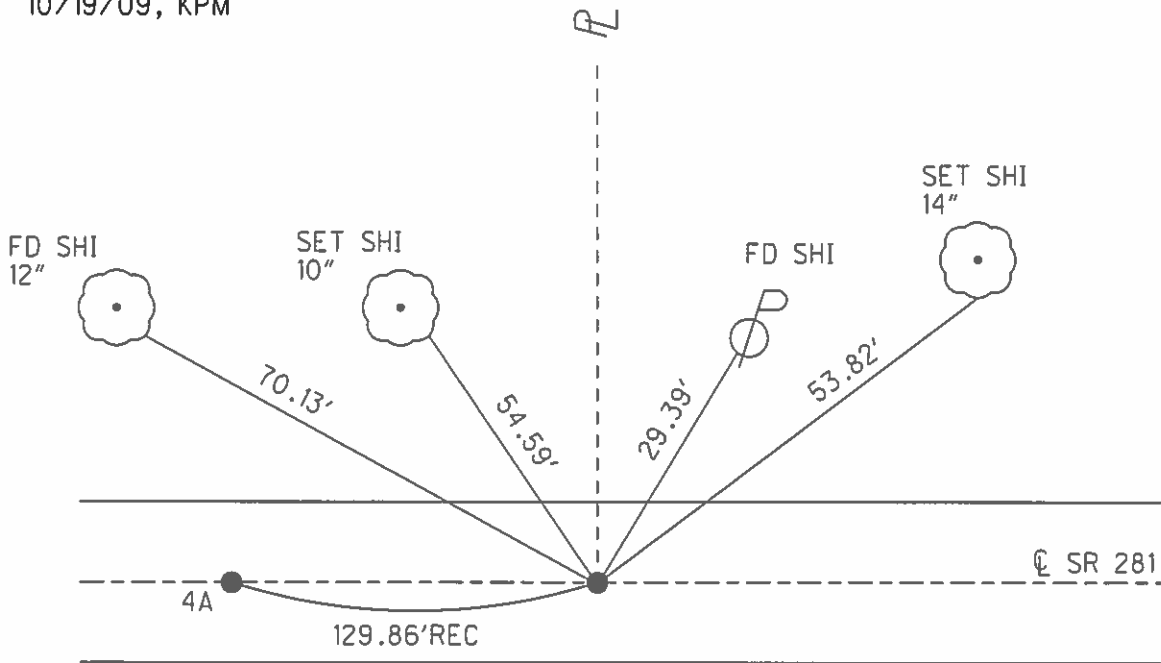

O.D.O.T. DISTRICT 2 SURVEY OFFICE

PERSONNEL

REFERENCE NO. 4-A-B-C SHEET 5 OF 13

NOTES HUSS

H.C. VAN DUSEN

R.C. MOSEB

DATE 6-8-95

WEATHER CLOUDY

TEMP. +62°F

ROUTE S.R. 281

COUNTY HENRY

TOWNSHIP FLAT ROCK

SECTION 29

T 4 N R 6 E

TYPE MONUMENT PK/WASHER



ON SURFACE - BELOW YES

LEFT - E PAVT. - RIGHT

TO EDGE, PAVEMENT

S.L.M. PT. A 75+00

PT. B = 76+39
PT. C = 77+69

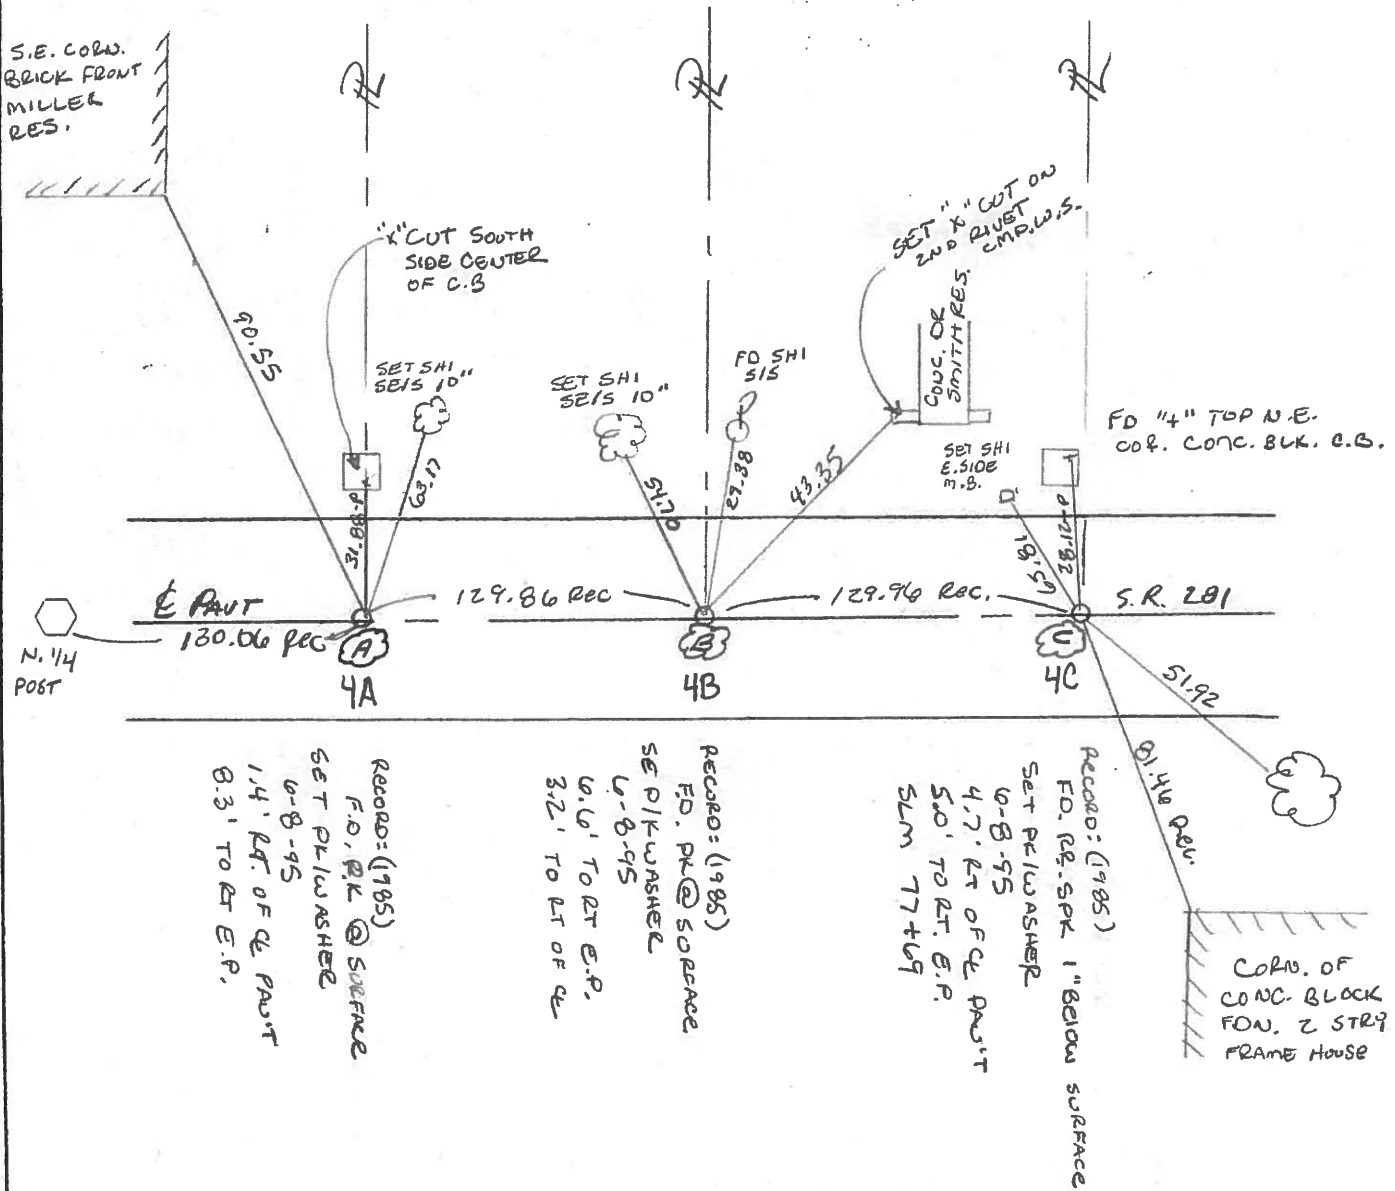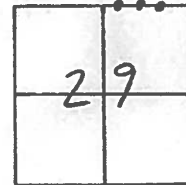

County HENRY S.R. 281

Township FLATROCK

Section 29



T4N, R6E

Personnel Hoffman R.C.
BARNHISEL H.C.

Date 4-15-85

Weather Clear


Temp. 60°

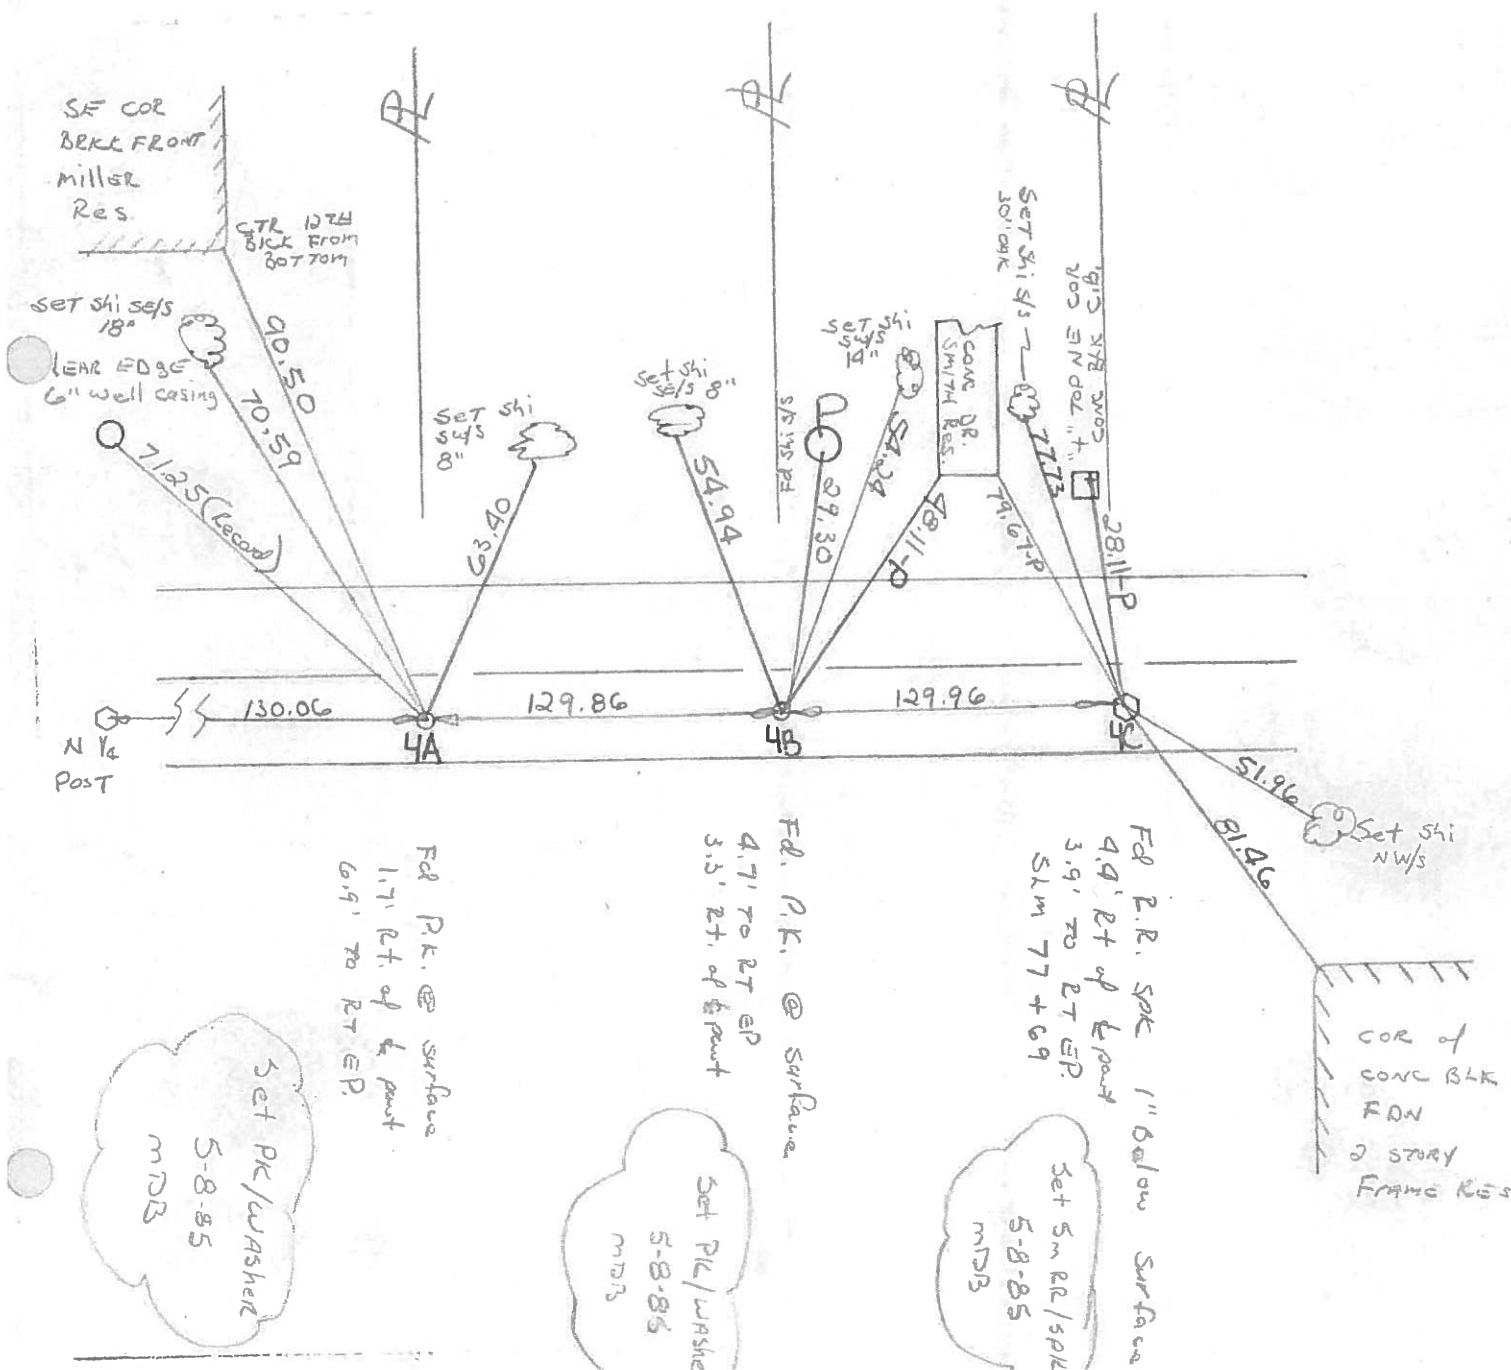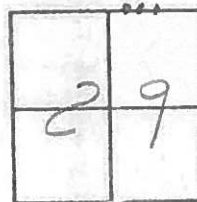

PERSONNEL TITLE PERSONNEL TITLE
 BURNSIDE _____
 SMITH _____
 BOWERS _____
 MEAD _____

COUNTY HENRY DATE 6-24-77
 S. R. 281 WEATHER CLOUDY
 SEC. _____ TEMP. +74°

DESCRIPTION LEFT CENTER LINE RIGHT JOB NO.

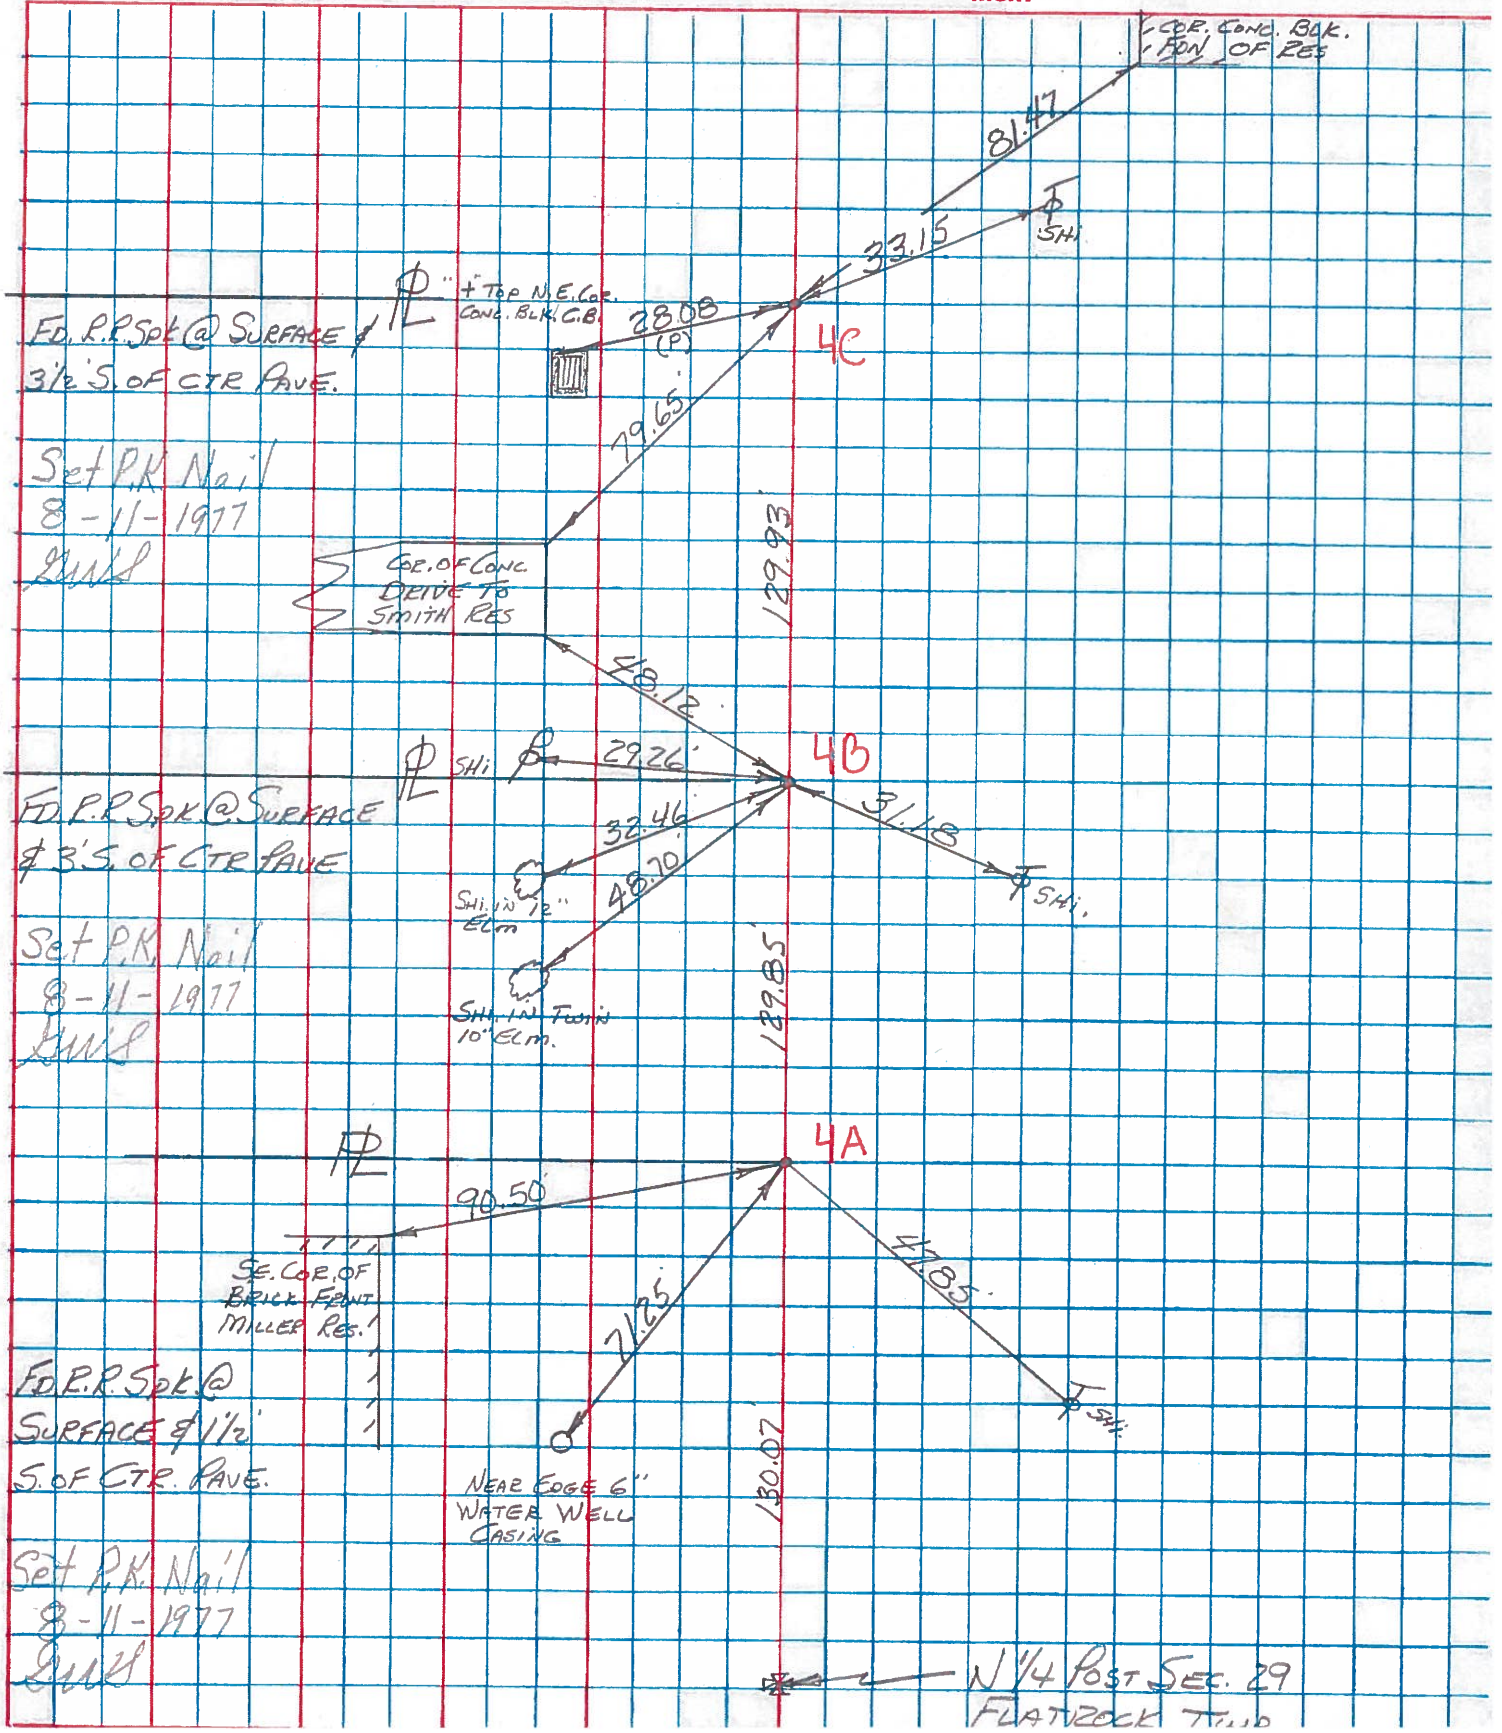

N 1/4 Post Sec. 29
 FLAT ROCK TWP

County HENRY S.R. 281

Township FLATROCK

Section 29

T4N, R6E

Personnel BURNSIDE

SMITH

BOWERS

MEAD

Date 6-24-77

Weather CLOUDY

Temp. +74°

