

O.D.O.T. DISTRICT 2 SURVEY OFFICE (USE ONLY)

PERSONNEL

REFERENCE NO. 4 C

SHEET 8 OF 20

NOTES RHOADES DATE 6-7-18
 H.C. O'DONNELL WEATHER CLOUDY
 R.C. TRENKA TEMP. 65°

ROUTE SR 281
 COUNTY HENRY
 TOWNSHIP FLAT ROCK
 SECTION 29

DWG BY JAMES PID 102763

T 4 N R 6 E

TYPE MONUMENT MAG/WASHER

ON SURFACE - ~~BELOW~~ ON

OFFSET 5.4' ~~LT~~ : RT

5.0' TO RT EDGE PAVEMENT


STATION: 77+78.13

HORZ.DATUM: NAD83 2011


GEOID: NAVD88 2012A

GRID: NORTHING: 593122.885

EASTING: 1501540.408

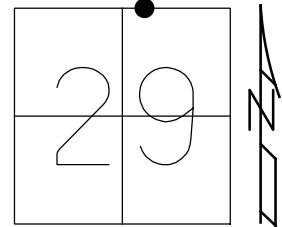


RECORD:
 FD R.R.SPIKE
 1" DOWN
 1985
 SET P.K./WASHER
 6-8-95, KPM
 FD P.K./WASHER
 8-20-09, KPM
 SET MAG/WASHER
 10-19-09, KPM
 FD MAG/WASHER
 REFC4
 6-7-18, JFO

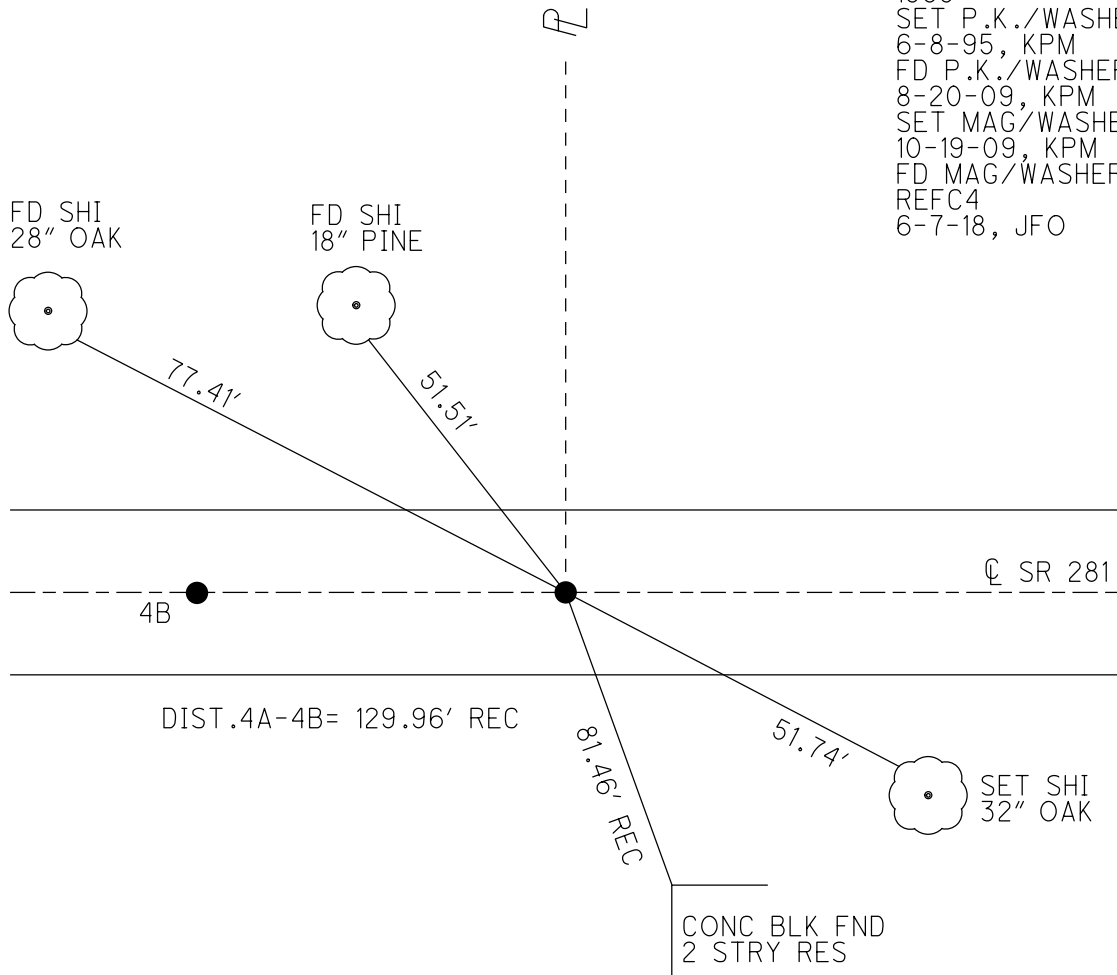


O.D.O.T. DISTRICT 2 SURVEY OFFICE (USE ONLY)

PERSONNEL _____ REFERENCE NO. 4 C SHEET 6 OF 14
 NOTES MOSER _____ DATE 8/20/09 ROUTE SR 281
 H.C. GOLDBERG WEATHER CLOUDY COUNTY HENRY
 R.C. MOSER TEMP. 75° TOWNSHIP FLAT ROCK
 _____ SECTION 29
 _____ T 4 N R 6 E

TYPE MONUMENT P.K./WASHER
 ON SURFACE - ~~BELOW~~ ON _____
~~LEFT =~~ ☉ PAV'T - RIGHT 4.7'
5.0' TO RT EDGE PAVEMENT
 S.L. M7+74
 GRID: NORTHING 593122.885 EASTING: 1501540.408

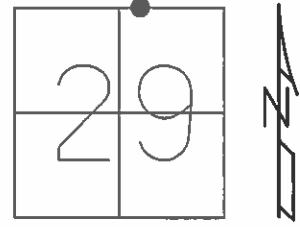

RECORD:
 FD R.R. SPIKE
 1" BELOW
 1985
 SET P.K./WASHER
 6/8/95, KPM
 SET MAG/WASHER
 10/19/09, KPM

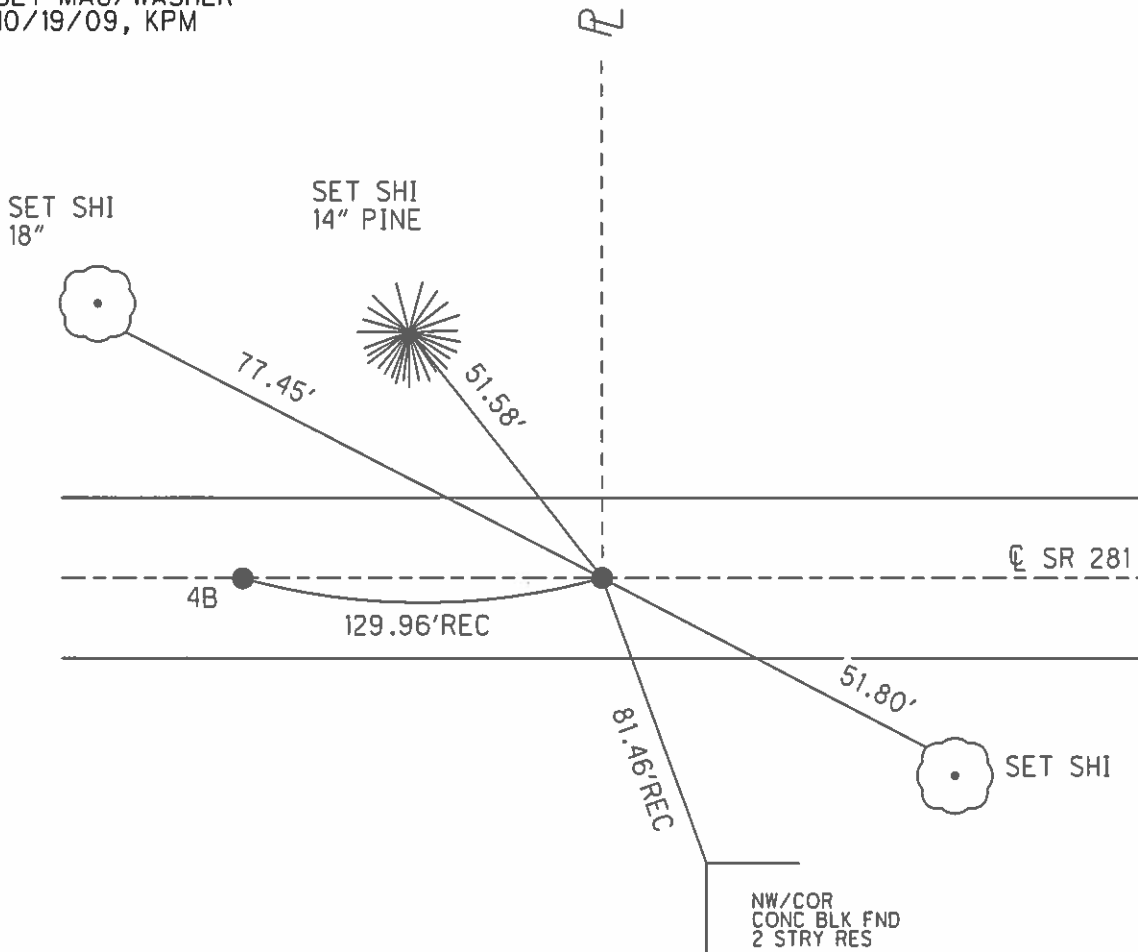

O.D.O.T. DISTRICT 2 SURVEY OFFICE

PERSONNEL

REFERENCE NO. 4-A-B-C SHEET 5 OF 13

NOTES HUSS

H.C. VAN DUSEN

DATE 6-8-95

ROUTE S.R. 281

R.C. MOSEB

WEATHER CLOUDY

COUNTY HENRY

TEMP. +62°F

TOWNSHIP FLAT ROCK

SECTION 29

T 4 N R 6 E

TYPE MONUMENT PK/WASHER



ON SURFACE - BELOW YES

LEFT - E PAVT. - RIGHT

TO EDGE, PAVEMENT

S.L.M. PT. A 75+00

PT. B = 76+39
PT. C = 77+69

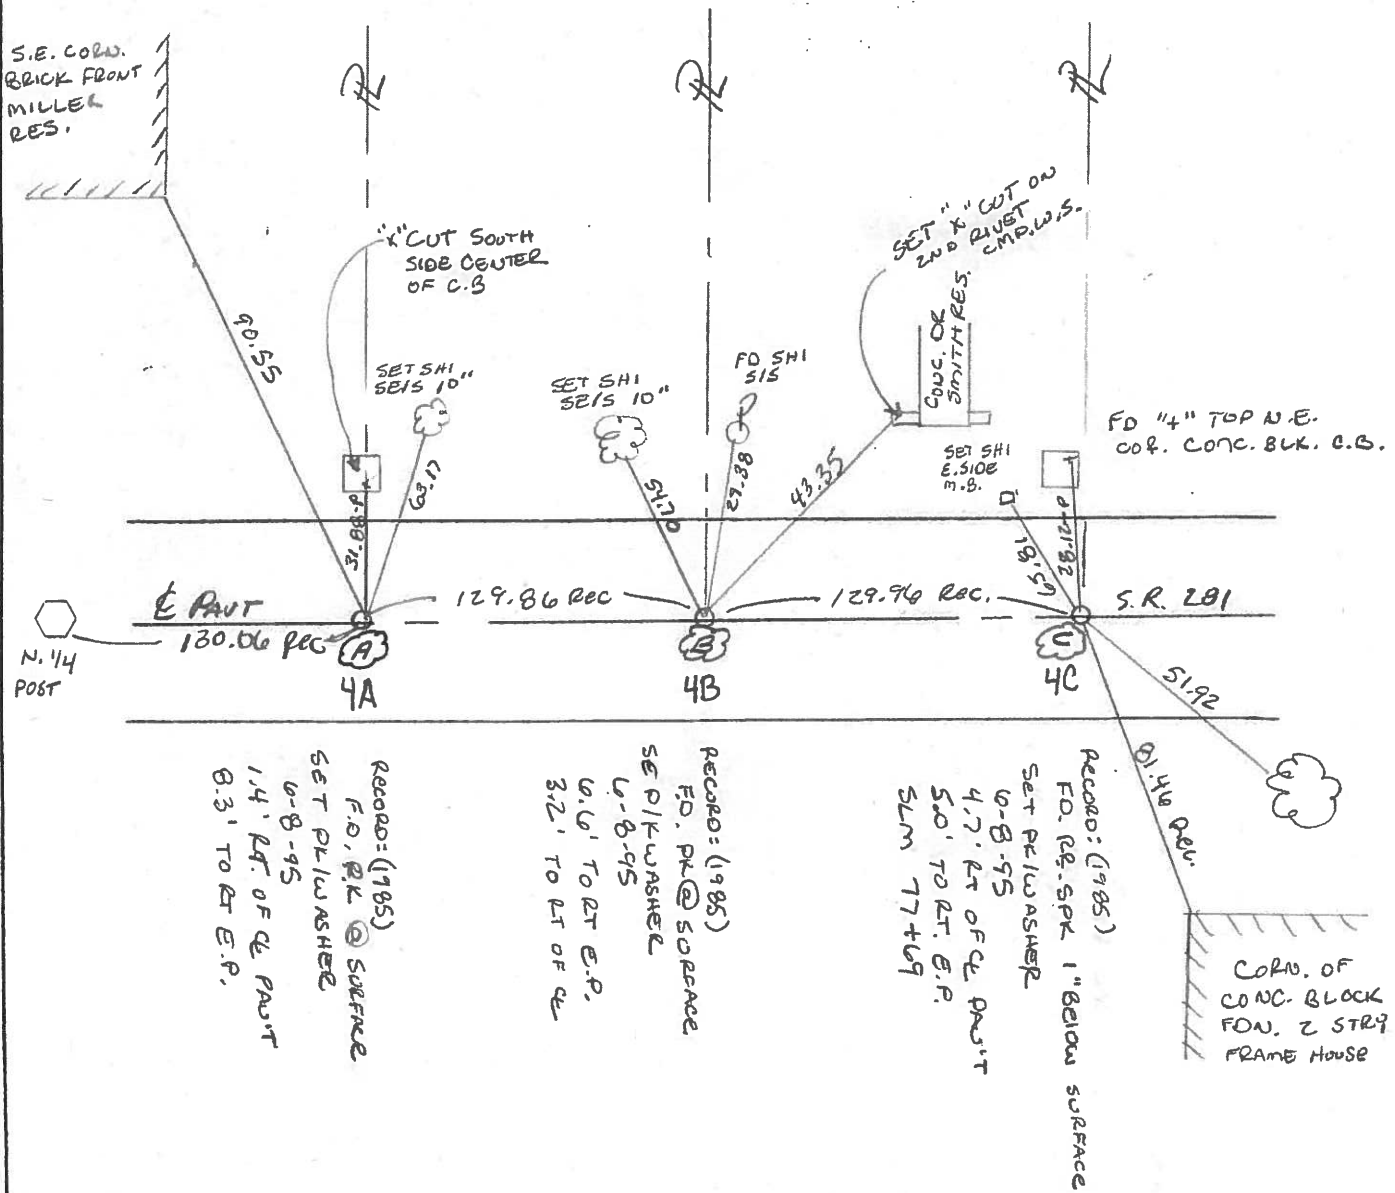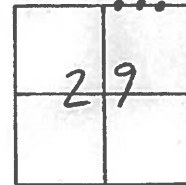

County HENRY S.R. 281

Township FLAT ROCK

Section 29



T4N, R6E

Personnel Hoffman R.C.
BARNHISEL H.C.

Date 4-15-85

Weather Clear


Temp. 60°

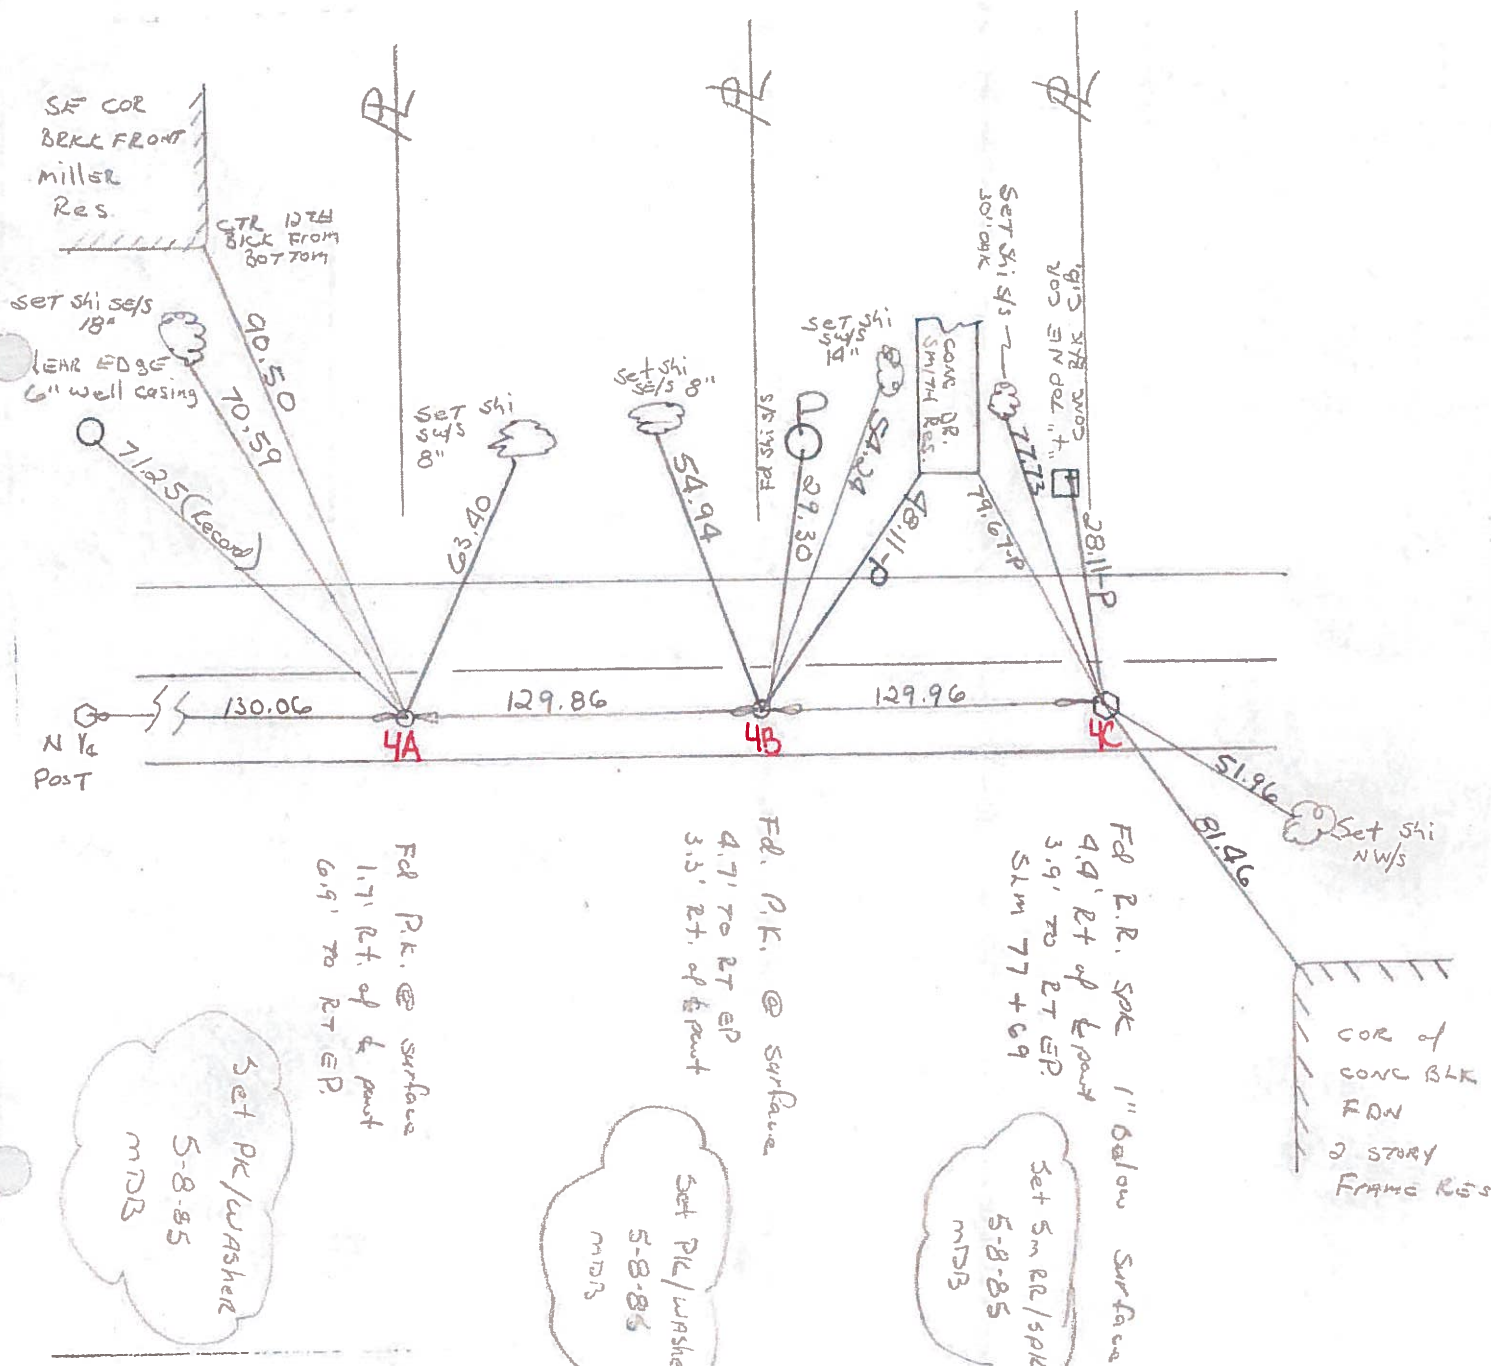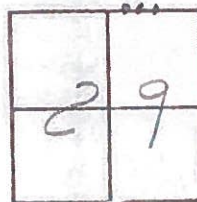

PERSONNEL TITLE PERSONNEL TITLE
KURNSIDE _____
SMITH _____
BOWERS _____
MEAD _____

COUNTY HENRY DATE 6-24-77
 S. R. 281 WEATHER CLOUDY
 SEC. _____ TEMP. +74°

DESCRIPTION LEFT CENTER LINE RIGHT JOB NO.

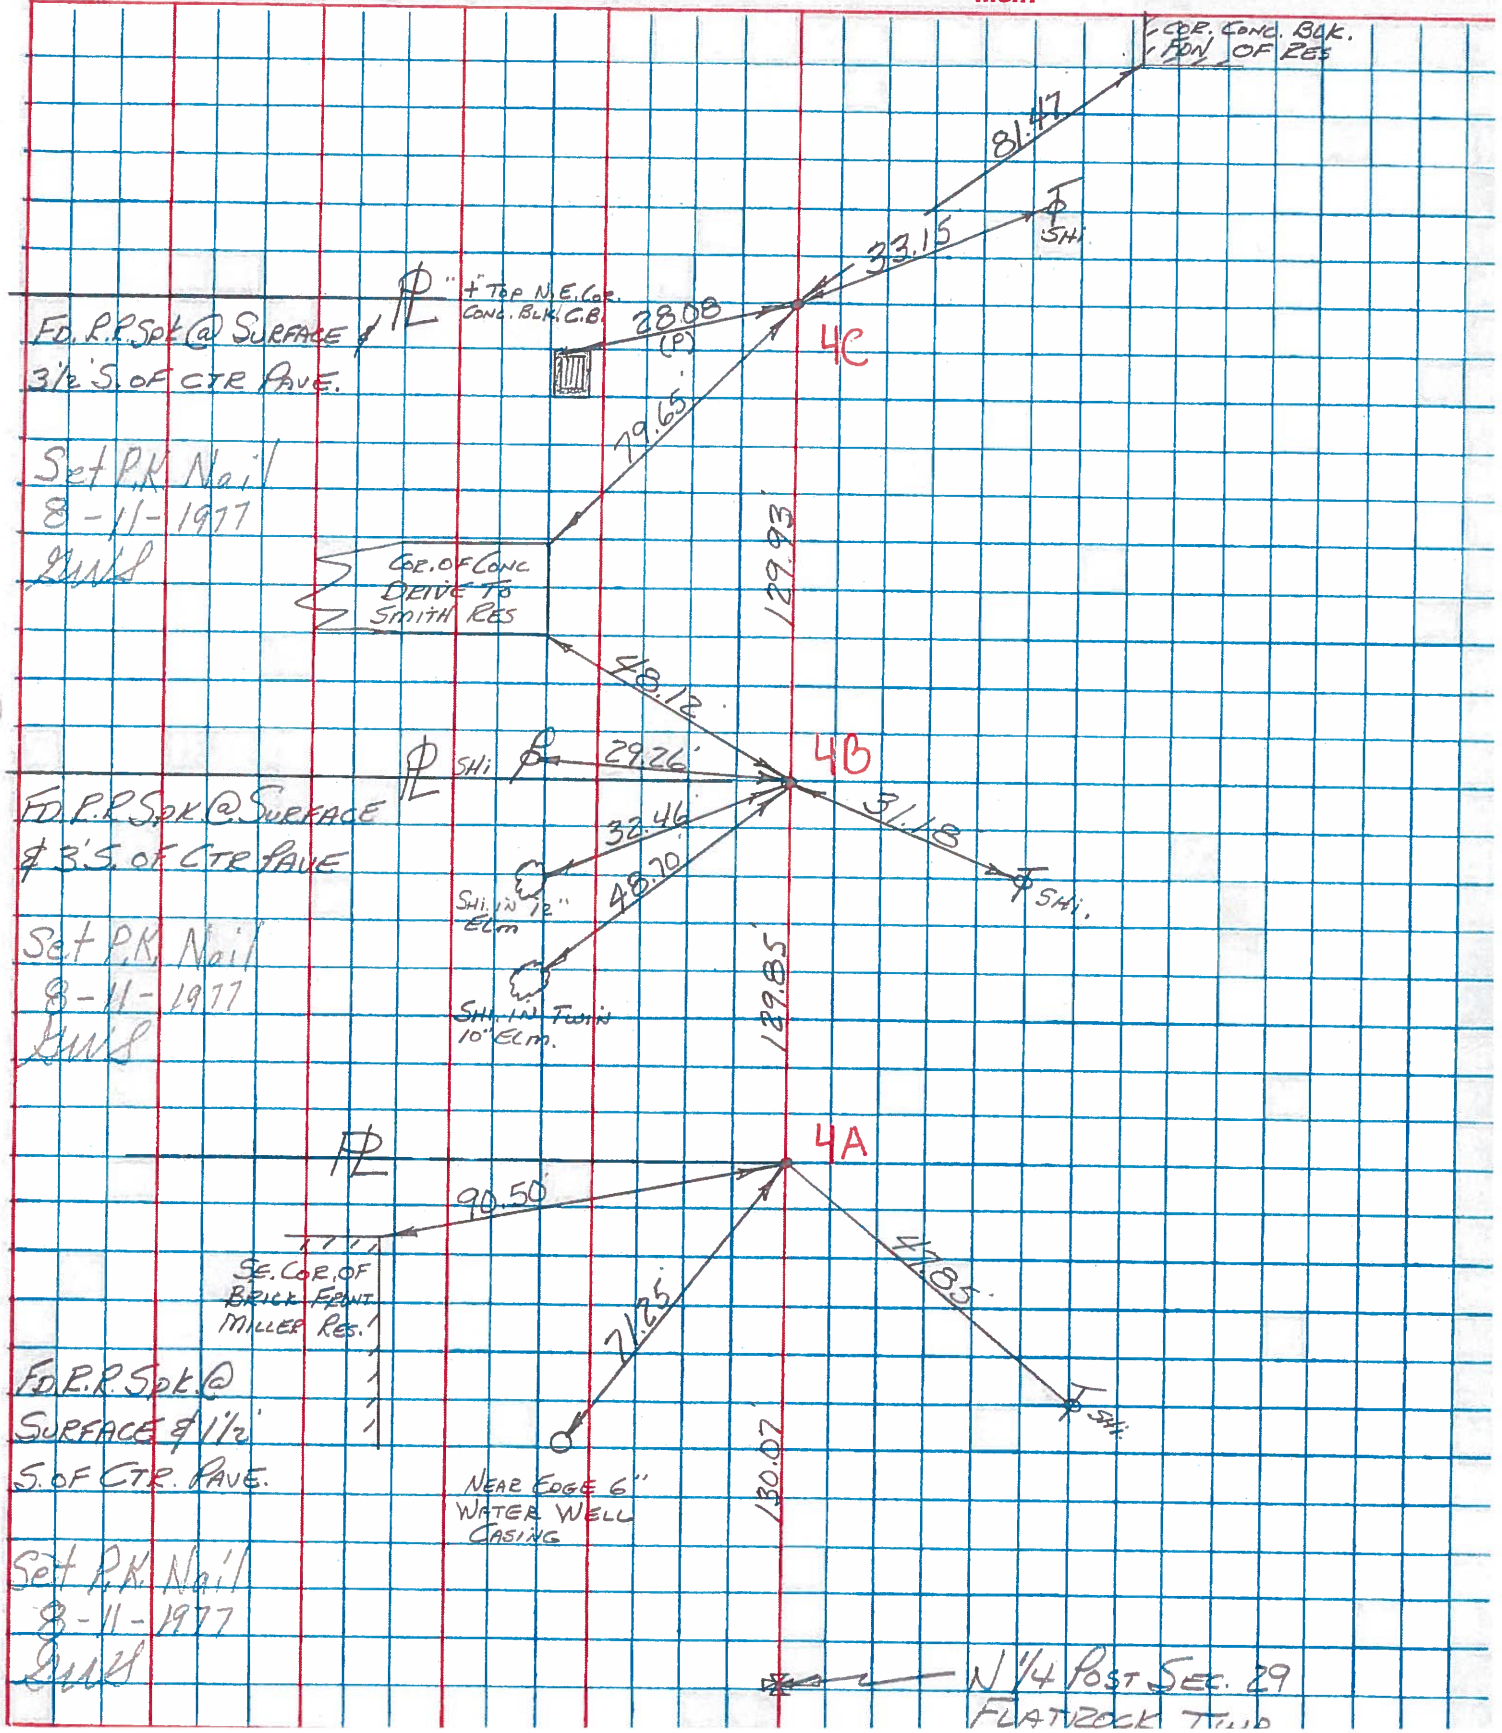

County HENRY S.R. 281

Township FLATROCK

Section 29

T4N, R6E

Personnel BURNSIDE
SMITH
BOWERS
MEAD

Date 6-24-77

Weather CLOUDY

Temp. +74°

