

O.D.O.T. DISTRICT 2 SURVEY OFFICE (USE ONLY)

PERSONNEL

REFERENCE NO. 16 AA

SHEET 7 OF 34

NOTES PRESTON-COLVIN DATE 11/26/24
 H.C. NEISE WEATHER WINDY
 R.C. PRESTON-COLVIN TEMP. 40°

ROUTE SR 281
 COUNTY HENRY
 TOWNSHIP MONROE
 SECTION 20

DWG BY PRESTON-COLVIN PID PAVING TRAIN

T 4 N R 7 E

TYPE MONUMENT PK NAIL

ON SURFACE - ~~BELOW~~ ON

OFFSET \odot PAVEMENT 4.4' ~~LT~~ : RT

6.9' TO RT EDGE PAVEMENT

STATION: 403+83

HORZ. DATUM: NAD83 2011


GEOID: 18

GRID: NORTHING: 592785.291

EASTING: 1534175.495

LDP: NORTHING: 449208.4

EASTING: 169429.7

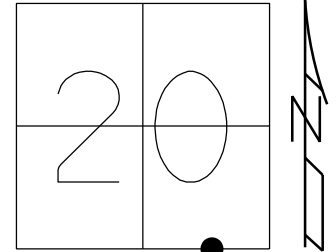

NOTE:
 FD MAG NAIL DIST. 16AA-16A= 1.06'
 ORIGIN UNKNOWN
 REFAA16
 FD MAG NAIL
 REF 16AA
 7/22/24, TDN
 FD MAG NAIL
 11/26/24, TDN

