

O.D.O.T. DISTRICT 2 SURVEY OFFICE (USE ONLY)

PERSONNEL

REFERENCE NO. 36 A

SHEET 32 OF 34

NOTES CANTERBURY

DATE 6/2/98

ROUTE SR 281

H.C. ROUSOS

WEATHER WINDY

COUNTY HENRY

R.C. NUHFER

TEMP. 75°

TOWNSHIP RICHFIELD

SECTION 25

DWG BY NIESE

PID CHIP_2

T 4 N R 8 E

TYPE MONUMENT MONBOX

ON SURFACE - ~~BELOW~~ ON

OFFSET 11.0' ~~±~~ : RT

0.3' LT TO RT EDGE PAVEMENT


STATION: 936+03.62

HORIZ.DATUM: NAD83(2011)


GEOID: 2012A

GRID: NORTHING: 592318.170

EASTING: 1587371.210

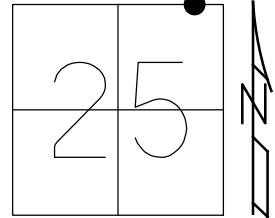

RECORD:
 FD MONBOX
 W/BOLT
 SHOT TOP CTR LID
 REFA36
 9/7/18, JFO
 7/25/19, JMR

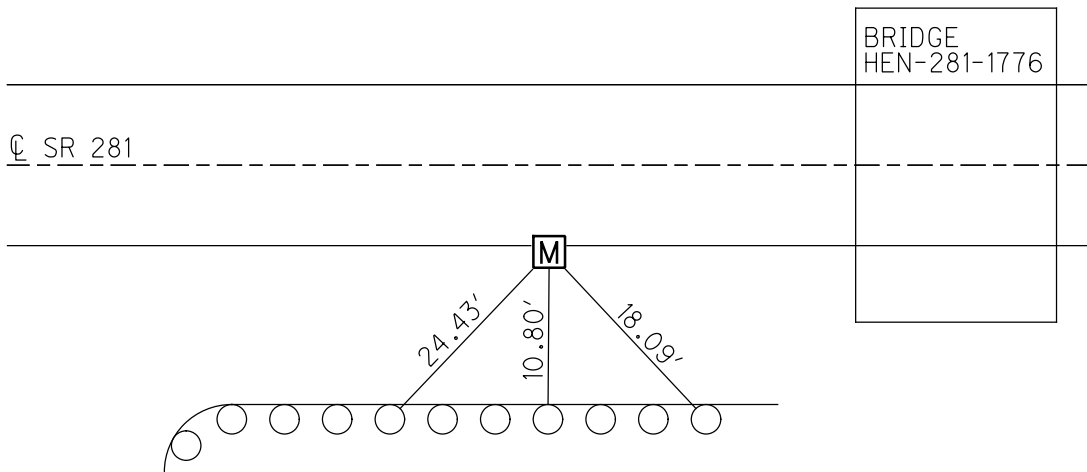

SET SHI'S
 GR POSTS
 ALL MEAS. TO
 CTR OF LID