


O.D.O.T. DISTRICT 2 SURVEY OFFICE (USE ONLY)


PERSONNEL	REFERENCE NO.	<u>4</u>	SHEET	<u>4</u>	OF	<u>48</u>
NOTES	<u>HOMAN</u>	DATE	<u>03/06/12</u>	ROUTE	<u>SR 424</u>	
H.C.	<u>HOMAN</u>	WEATHER	<u>CLOUDY</u>	COUNTY	<u>HENRY</u>	
R.C.	<u>ROUSOS</u>	TEMP.	<u>40°</u>	TOWNSHIP	<u>FLATROCK</u>	
				SECTION	<u>7</u>	
				T	<u>4</u>	R
					<u>N</u>	<u>6</u>
					<u>E</u>	

TYPE MONUMENT 2" SPK/WASHER
 ON SURFACE - ~~BELOW~~ ON
 LEFT - ~~C PAV'T~~ - ~~RIGHT~~ 3.3
8.8 TO LT EDGE PAVEMENT
 S.L.M. 36+41

Grid: Northing: 603607.686 Easting: 1496131.947

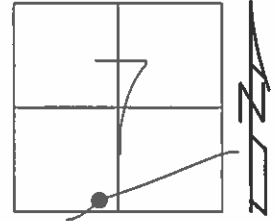

RECORD:
 SLM STA. 36+39.37
 SET PK/WASHER
 5-9-91
 OK 12/29/08
 #103
 REF5
 FD PK
 02/15/12, DCH

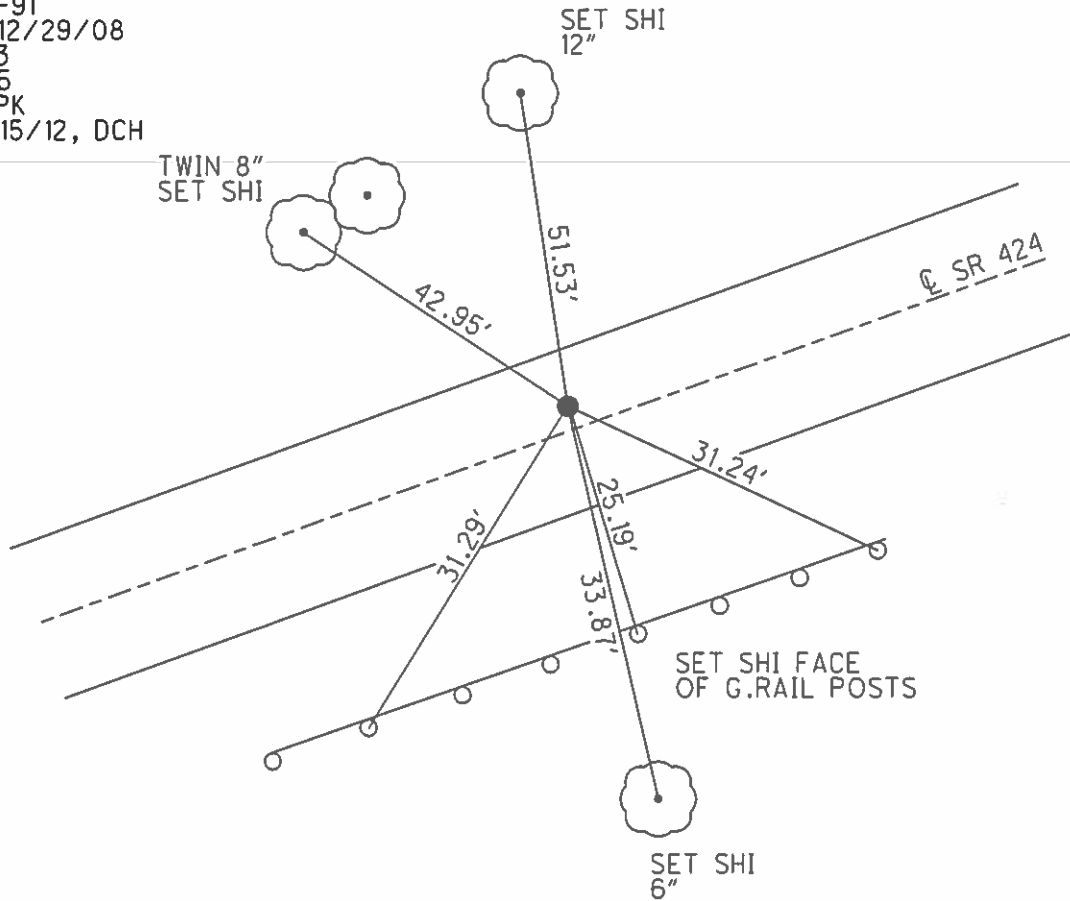

O.D.O.T. DISTRICT 2 SURVEY OFFICE

PERSONNEL

REFERENCE NO. 4

SHEET 4 OF 43

NOTES HOFFMAN

H.C. LOEHKE

R.C. BARNISEL

DATE 4-1-91

WEATHER CLOUDY

TEMP. 40°

ROUTE SR 424

COUNTY HENRY

TOWNSHIP FLATROCK

SECTION 7

T. 4 N. R. 6 E.

Set P.K./WASHER
5-9-91


TYPE MONUMENT 2" SPK/WASHER

ON SURFACE - BELOW YES


LEFT-CL PAV'T. - RIGHT 3.3

8.8 TO LT EDGE PAVEMENT

S.L.M. 36+41

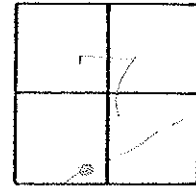

RECORDS:
SLM sta. 36+39.37

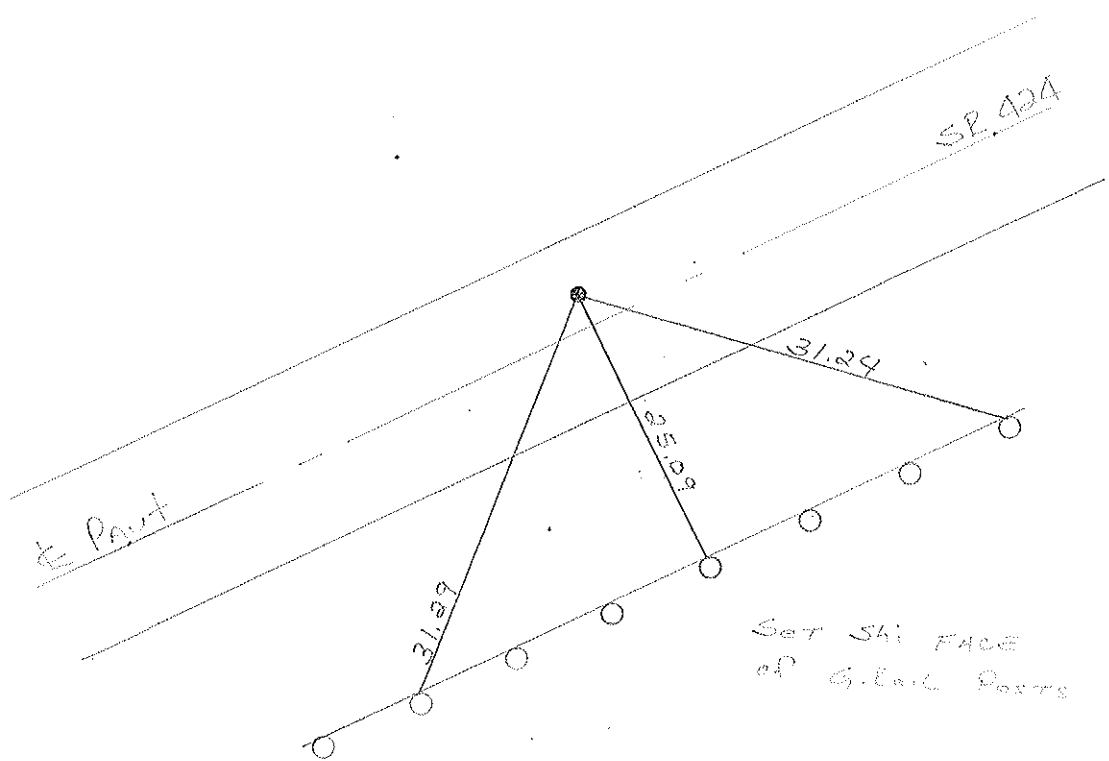

OK
10-19-81
S.W.H.

County HENRY S.R. 424

Date 6-18-81

Township FLATROCK


Weather CLEAR

Section 7

Temp. +70°

T4N, R6E

Personnel HOFFMAN

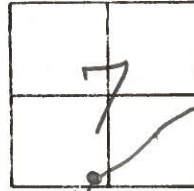

HOUSEHOLDER

4

Fd. R.R. SPK @ SURFACE

PROJECT STA. ± 36+51

3.2' Lt. of & PAUT. S.R. 424


9.0' to N. Edge PAUT.

14.7' to S. Edge PAUT.

RE-SET 2" SPK/WASHER

STA. 36+39.37

S.L.M. - REC

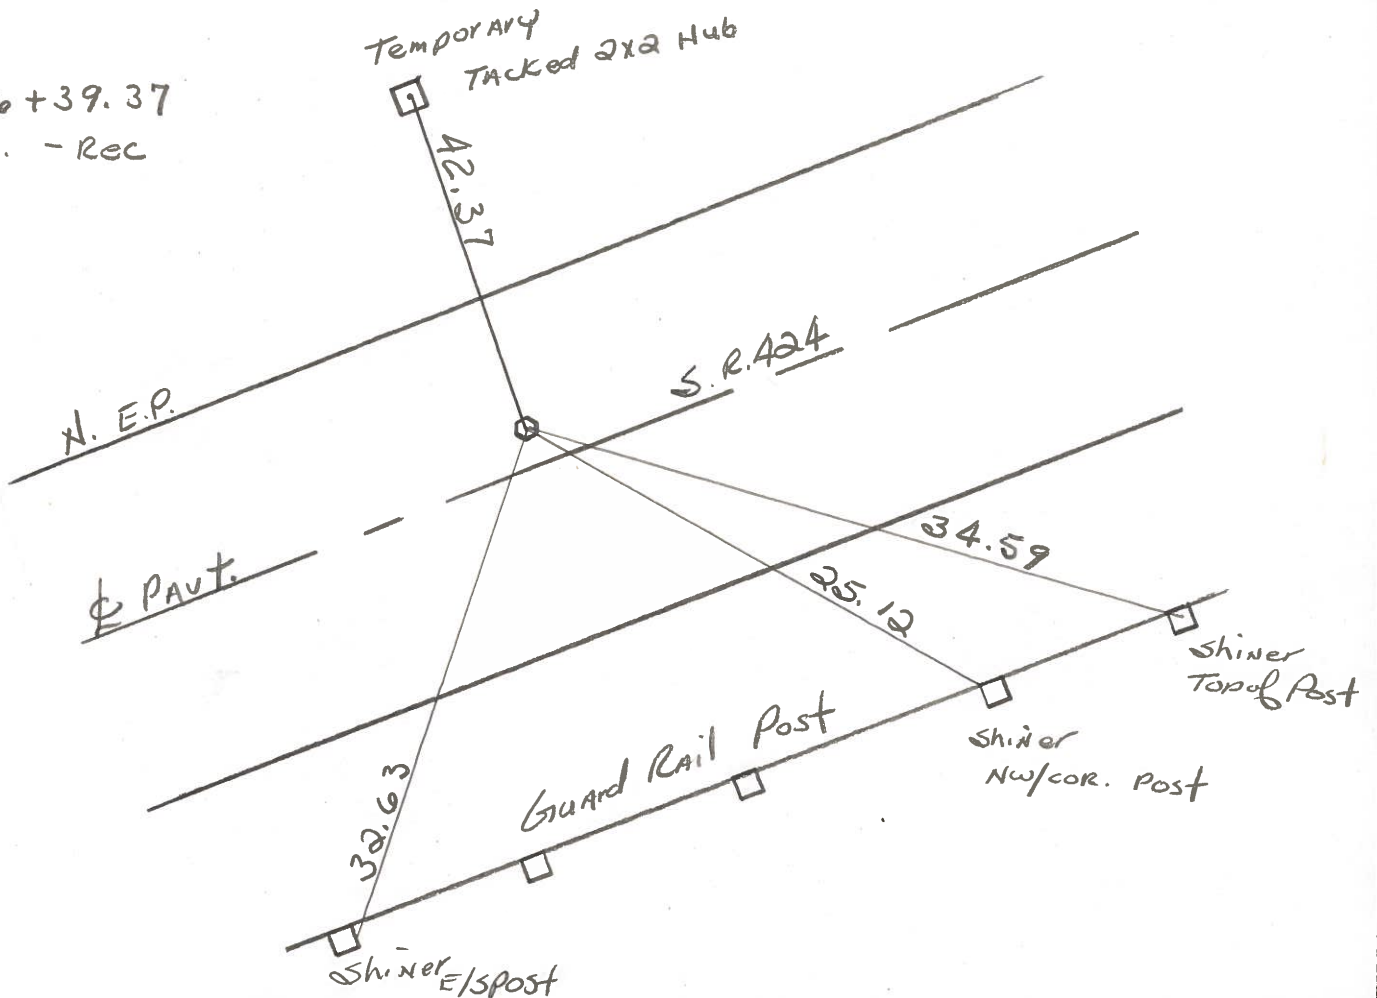


PERSONNEL TITLE PERSONNEL TITLE

Tomsic
Neuser
Yanyo

COUNTY Henry DATE MAY-2-74
S. R. 424 WEATHER cloudy
SEC. TEMP. 60°

DESCRIPTION Reference 424 LEFT CENTER LINE RIGHT JOB NO.

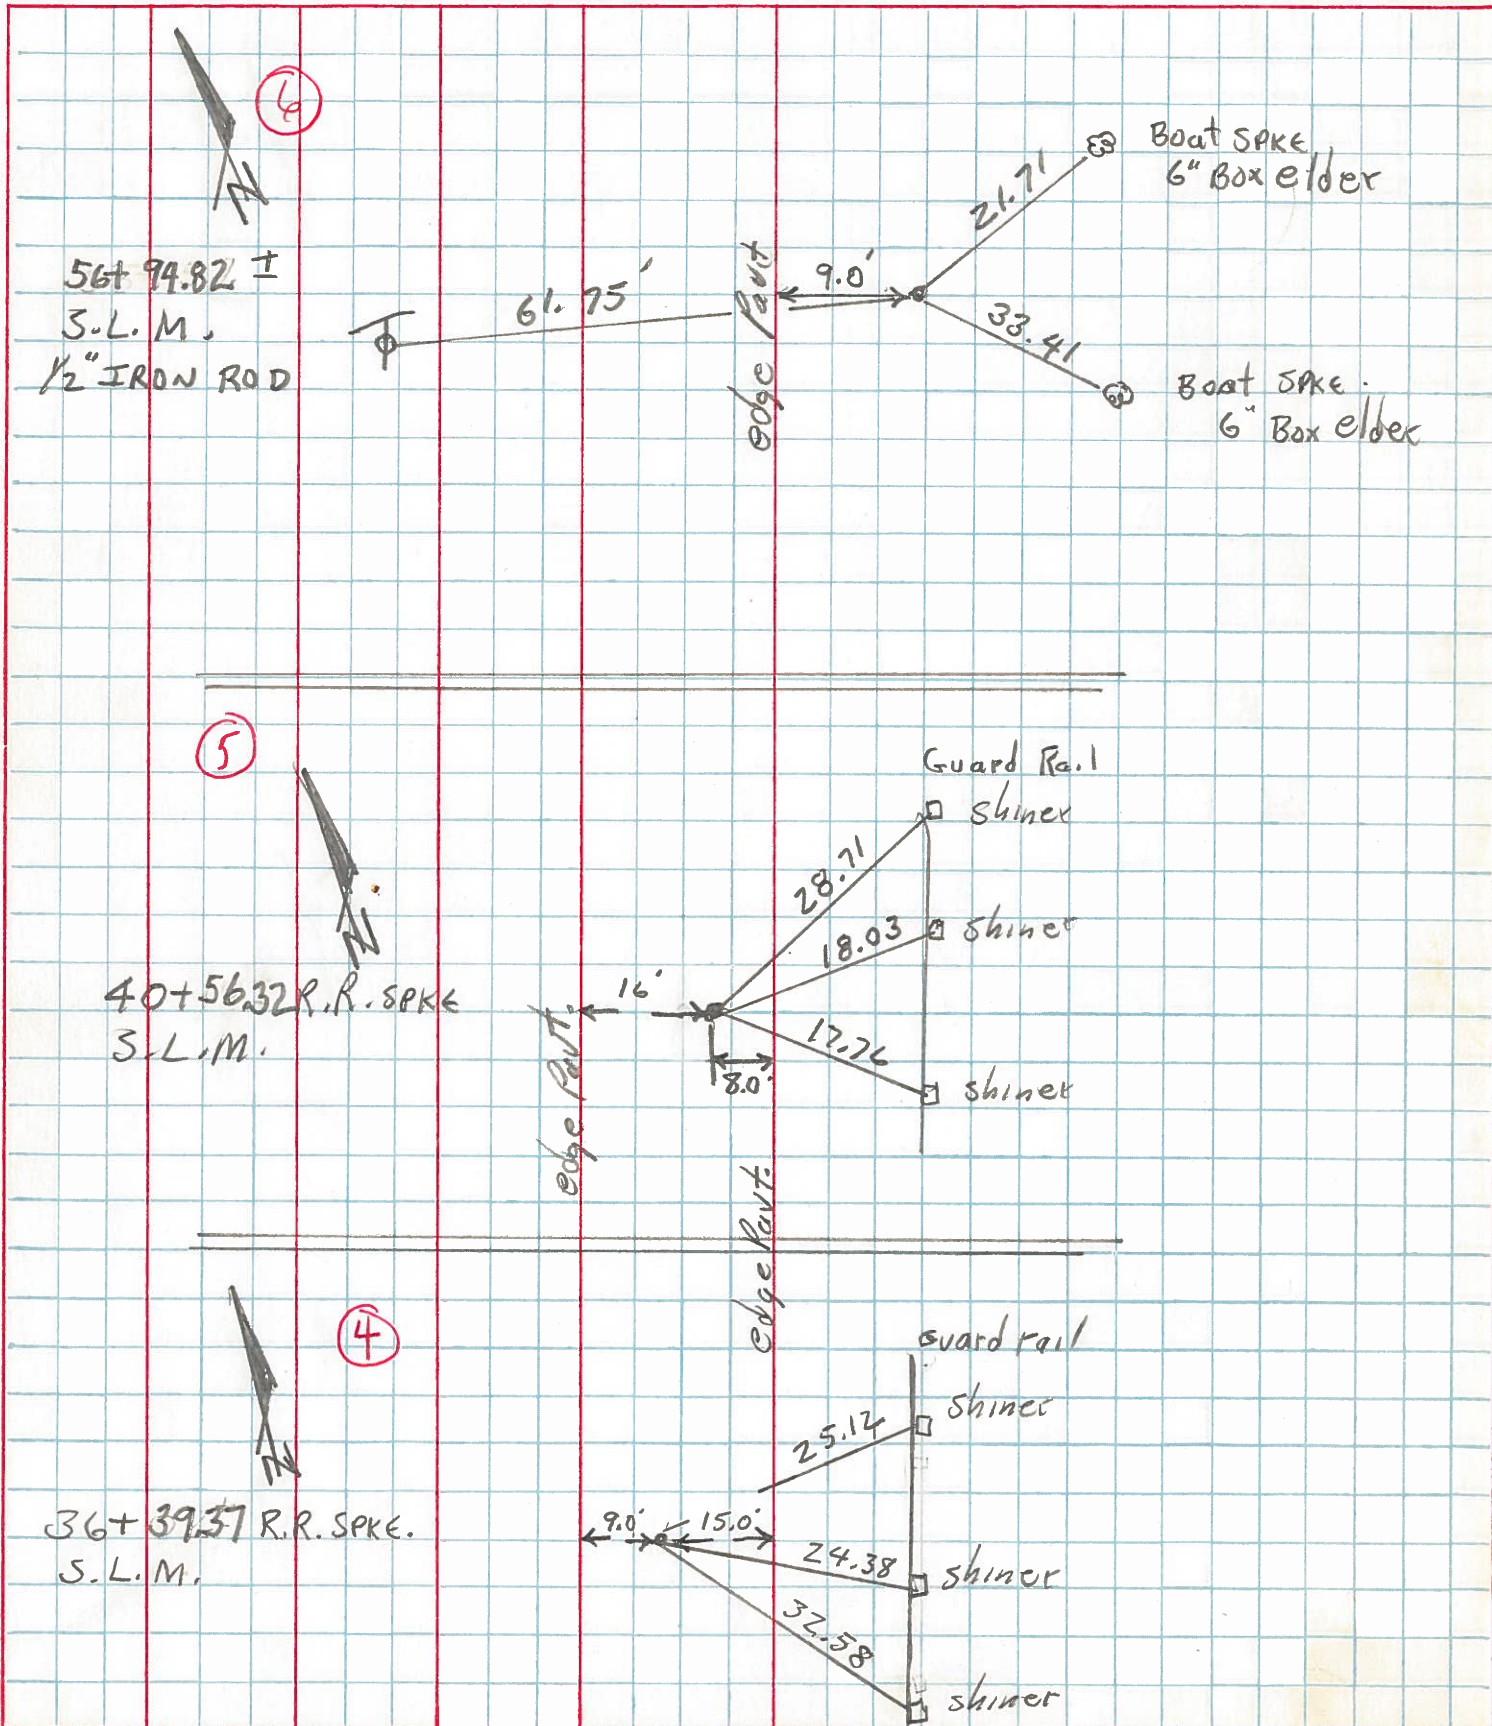

PERSONNEL	TITLE	PERSONNEL	TITLE	PERSONNEL	TITLE	PERSONNEL	TITLE
Loays							
Peschall							
Ruffer							
Wise							

COUNTY He DATE 12-14-54
 S. R. 24 WEATHER Cloudy
 SEC. Def. Co. Line to east TEMP. 36°
 DESCRIPTION Witnesses to Control Points JOB NO. _____

