


O.D.O.T. DISTRICT 2 SURVEY OFFICE (USE ONLY)


PERSONNEL \_\_\_\_\_ REFERENCE NO. 5 SHEET 5 OF 48  
 NOTES HOMAN DATE 03/06/12 ROUTE SR 424  
 H.C. ROUSOS WEATHER CLOUDY COUNTY HENRY  
 R.C. HARBAUGH TEMP. 40° TOWNSHIP FLATROCK  
 \_\_\_\_\_ SECTION 7  
 \_\_\_\_\_ T 4 N R 6 E

TYPE MONUMENT \_\_\_\_\_ PK SHANK \_\_\_\_\_  
 ON SURFACE - ~~BELOW~~ 1 1/2"  
~~LEFT - C PAV'T - RIGHT~~ 5.1  
6.8 TO RT EDGE PAVEMENT  
 S.L.M. 40+59

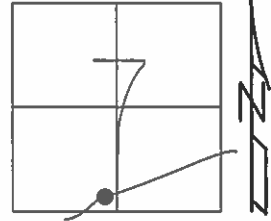

Grid: Northing: 603847.250 Easting: 1496473.493

RECORD:  
 SLM STA. 40+56.32  
 SET PK/WASHER  
 05/09/91, CL  
 OK FD  
 12/28/08  
 #104  
 REF6  
 FD PK 1 1/2" DOWN  
 02/15/12, DCH

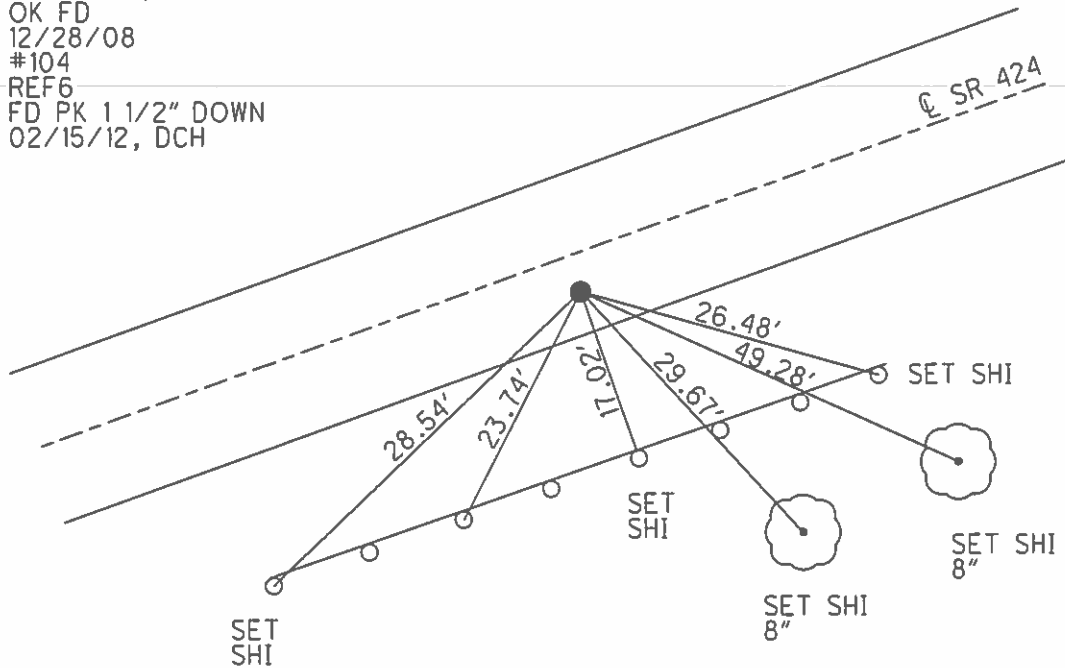

# O.D.O.T. DISTRICT 2 SURVEY OFFICE

PERSONNEL \_\_\_\_\_

REFERENCE NO. 5

SHEET 5 OF 43

NOTES Hoffman

H.C. LOGHURKE

R.C. Baranick

DATE 4-1-91

WEATHER CLOUDY

TEMP. 40°

ROUTE SR 424

COUNTY HENRY

TOWNSHIP FLATROCK

SECTION 7

Set P.K./WASHER

5-9-91

C.L.

T 4 N R 6 E


TYPE MONUMENT 2" SPI/WASHER

ON SURFACE - BELOW USS


LEFT - CL PAV'T. - RIGHT S.I

6.8 TO RT EDGE PAVEMENT

S.L.M. 40+59

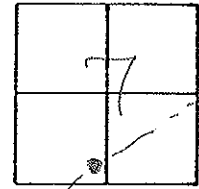

RECORD:  
SLM sta. 40+56.32

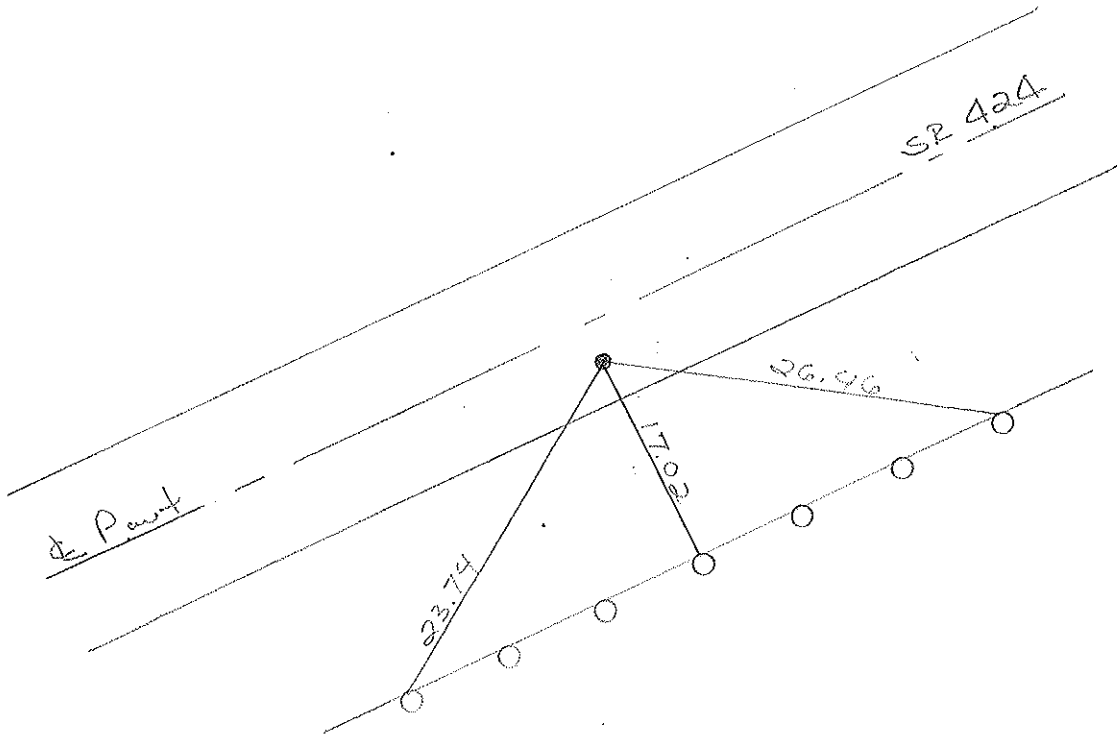

County HENRY S.R. 424

Township FLATROCK

Section 7

T4N, R6E

Personnel HOFFMAN

HOUSEHOLDER


Date 6-18-81

Weather Clear

Temp. +70°


OK  
10-26-81  
S.W.H

#5

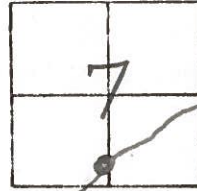

Fd. R.R. SPK @ SURFACE  
5'4.0' Rt. of R PAUT. SR424  
16.0' to N. Edge PAUT.  
7.1' to S. Edge PAUT.  
RE-SET 2" SPK/WASHER

PROJECT STA. ± 40+68

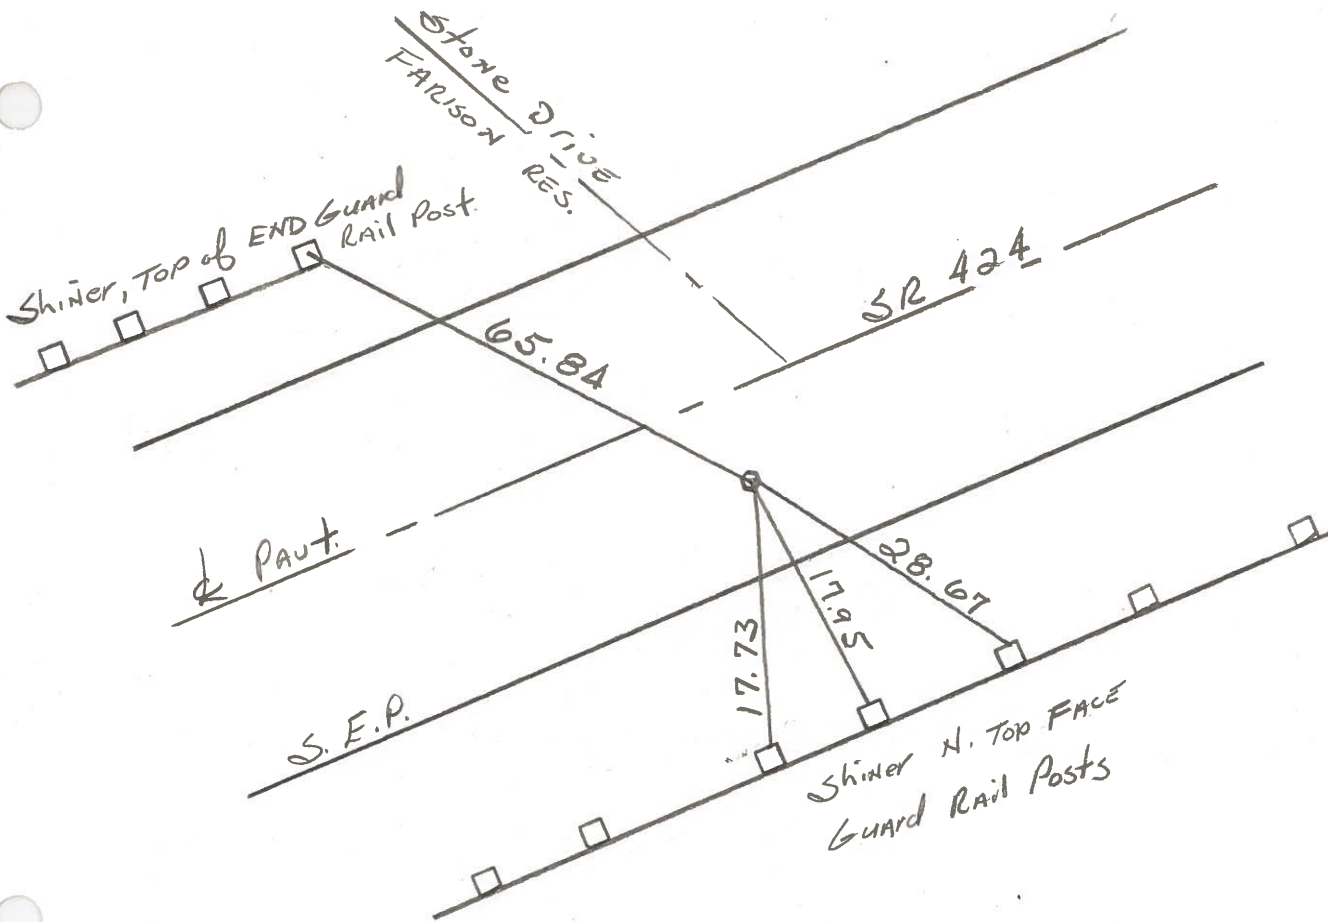


STA. 40+56.32 S.L.M. REC.

PERSONNEL	TITLE	PERSONNEL	TITLE
Tomsic			
Neuser			
Yango			

COUNTY Henry DATE MAY-2-74  
 S. R. 424 WEATHER cloudy  
 SEC. \_\_\_\_\_ TEMP. 60°

DESCRIPTION Reference 424 JOB NO. \_\_\_\_\_  
 LEFT CENTER LINE RIGHT

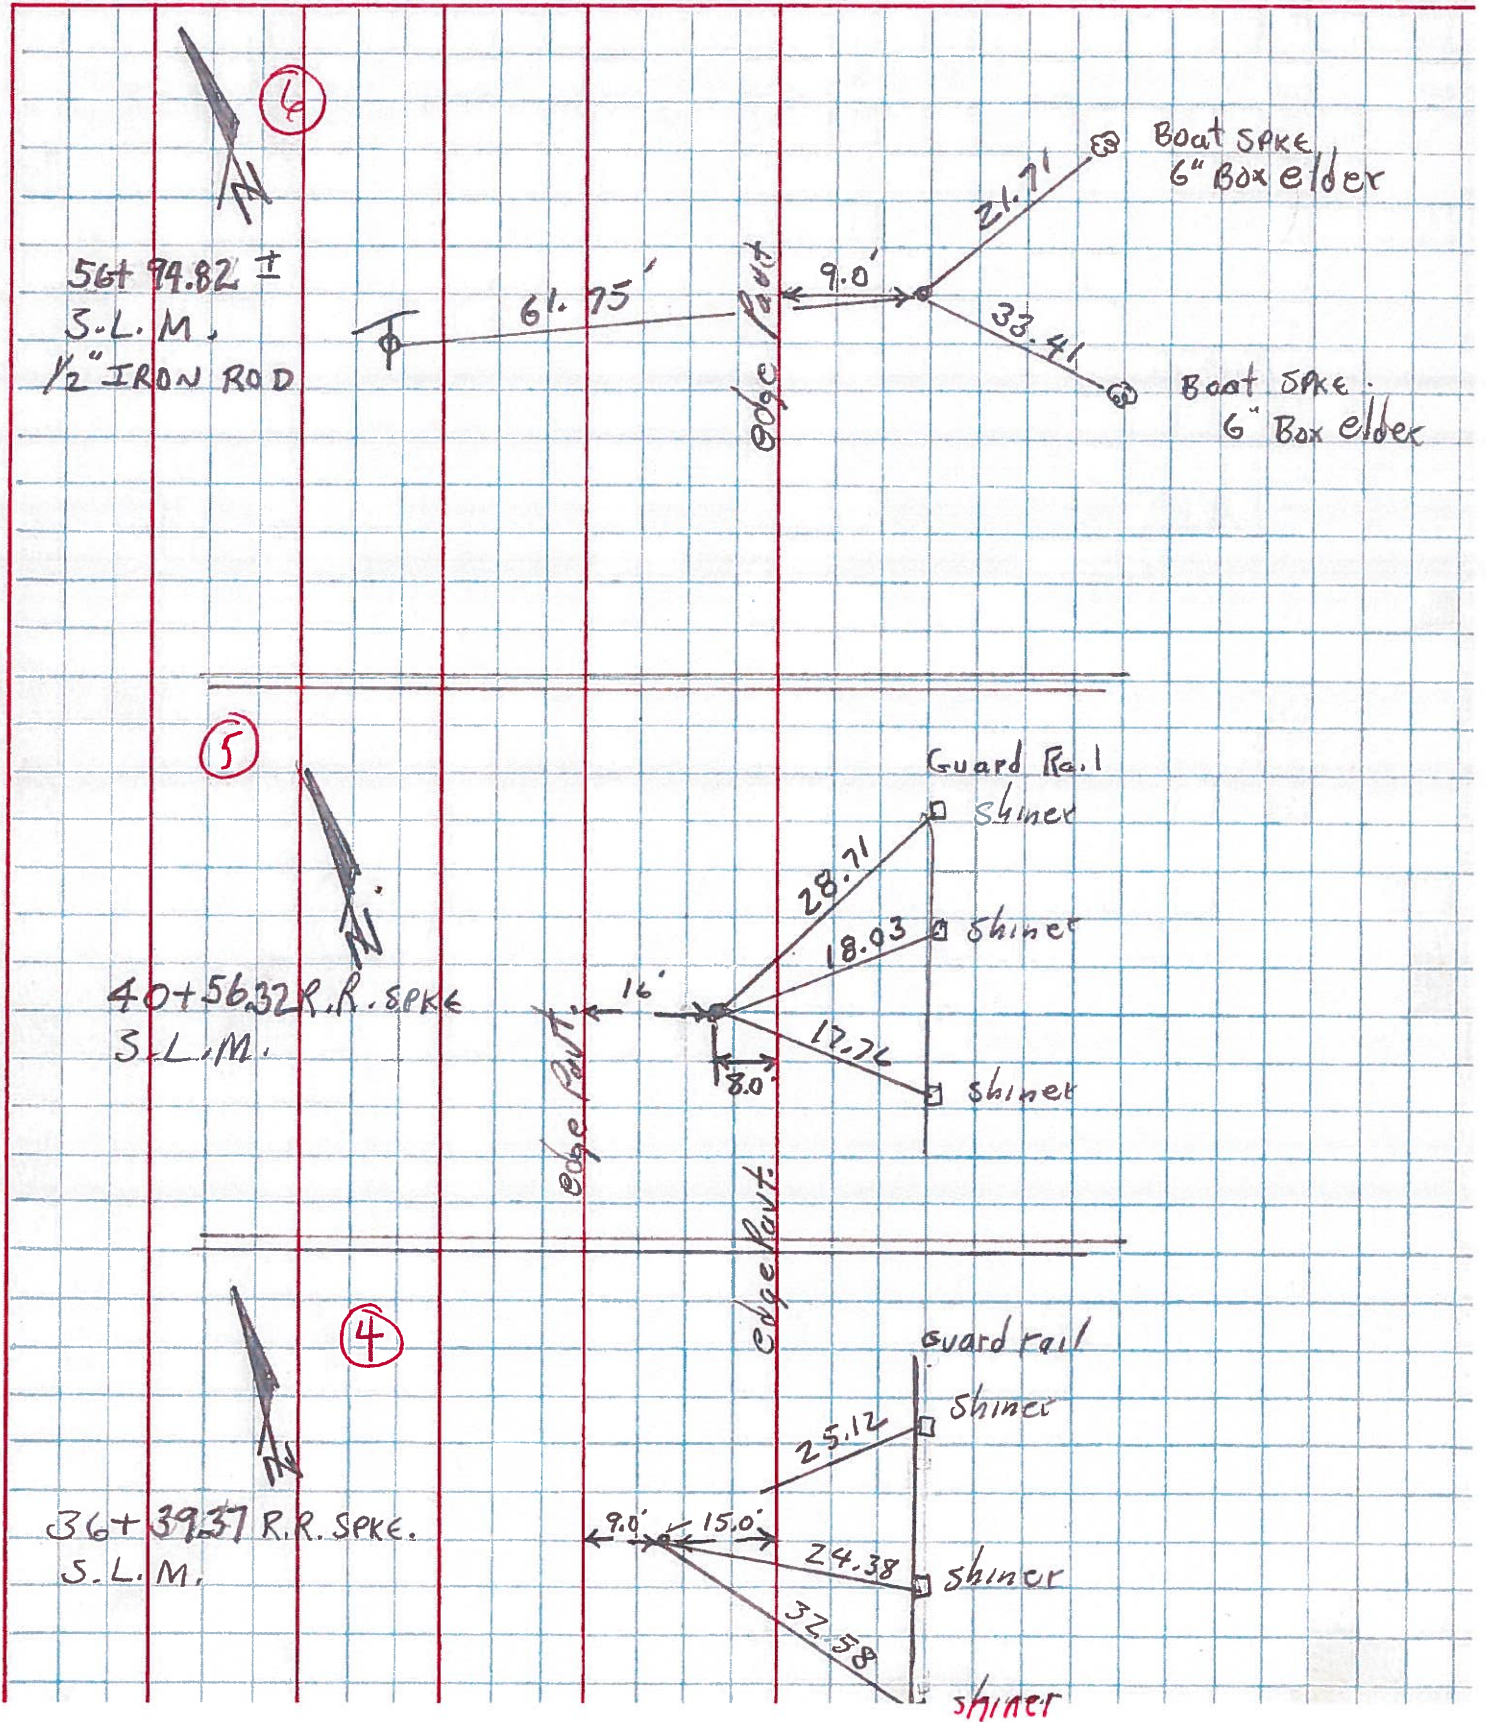



PERSONNEL	TITLE	PERSONNEL	TITLE	PERSONNEL	TITLE	PERSONNEL	TITLE
Loays							
Peschall							
Ruffer							
Wise							

COUNTY He DATE 12-14-54

S. R. 24 WEATHER Cloudy

SEC. Def. Co. Line to east TEMP. 36°

DESCRIPTION Witnesses to Control Points JOB NO.

