



O.D.O.T. DISTRICT 2 SURVEY OFFICE (USE ONLY)

PERSONNEL _____ REFERENCE NO. 6 SHEET 6 OF 48
 NOTES HOMAN DATE 03/06/12 ROUTE SR 424
 H.C. HOMAN WEATHER CLOUDY COUNTY HENRY
 R.C. ROUSOS TEMP. 40° TOWNSHIP FLATROCK
 _____ SECTION 7
 _____ T 4 N R 6 E

TYPE MONUMENT 1/2" IRON ROD
~~ON SURFACE~~ - BELOW 3"
~~LEFT - C PAV'T~~ - RIGHT 21.6
10.8 TO RT EDGE PAVEMENT
 S.L.M. 56+95
 Grid: Northing: 604851.251 Easting: 1497768.037

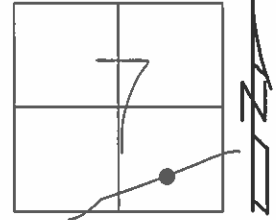

RECORD:
 SLM ST. 56+94.82±
 OK FD
 12/29/08
 #105
 REF7
 FD 5/8" IPIN
 02/16/12, DCH

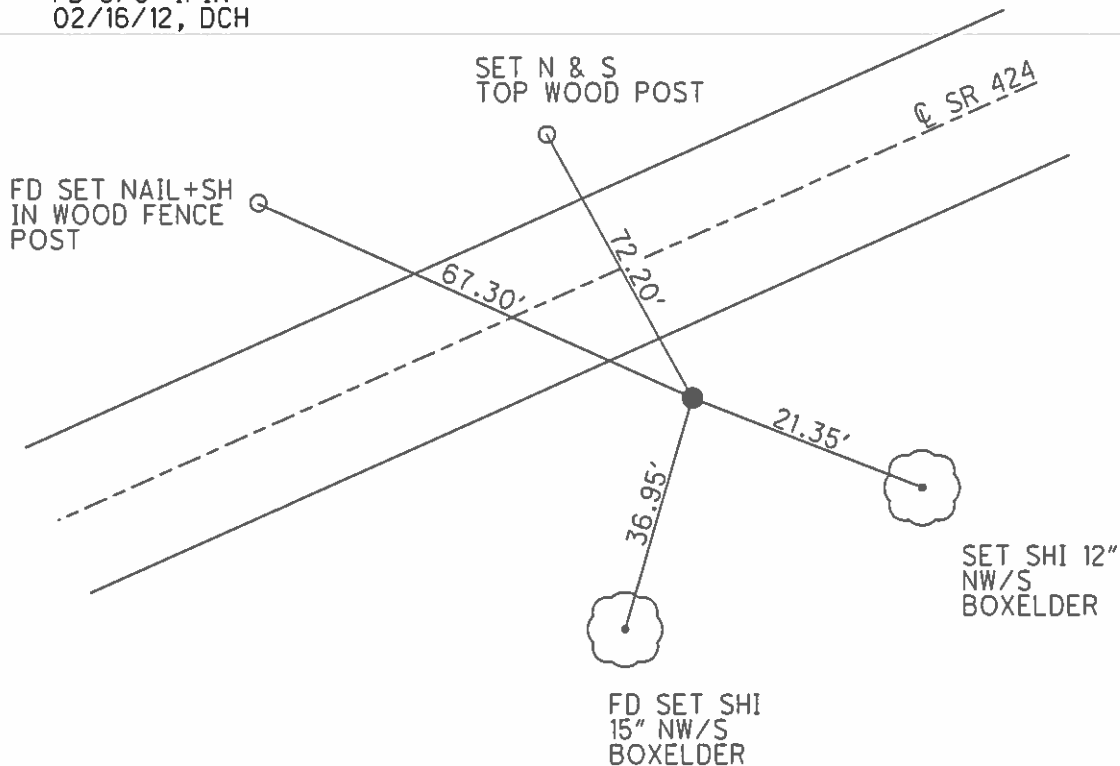

O.D.O.T. DISTRICT 2 SURVEY OFFICE

PERSONNEL _____

REFERENCE NO. 60

SHEET 6 OF 43

NOTES Hoffman

H.C. Lowell

DATE 4.1-91

ROUTE SR 424

R.C. Brinkley

WEATHER cloudy

COUNTY HENRY

TEMP. 40°

TOWNSHIP FLAT ROCK

SECTION 7

T4 N R 6 E


TYPE MONUMENT 1/2" IRON ROD

ON SURFACE - BELOW 3"


LEFT - CL PAV'T. - RIGHT 21.6

10.8 TO RT. EDGE PAVEMENT

S.L.M. 56+95

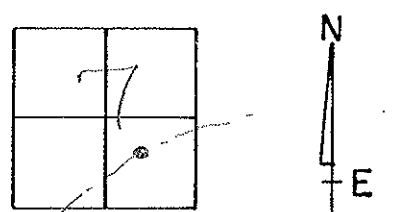

RECORD!
SLM sta. 56+94.82±

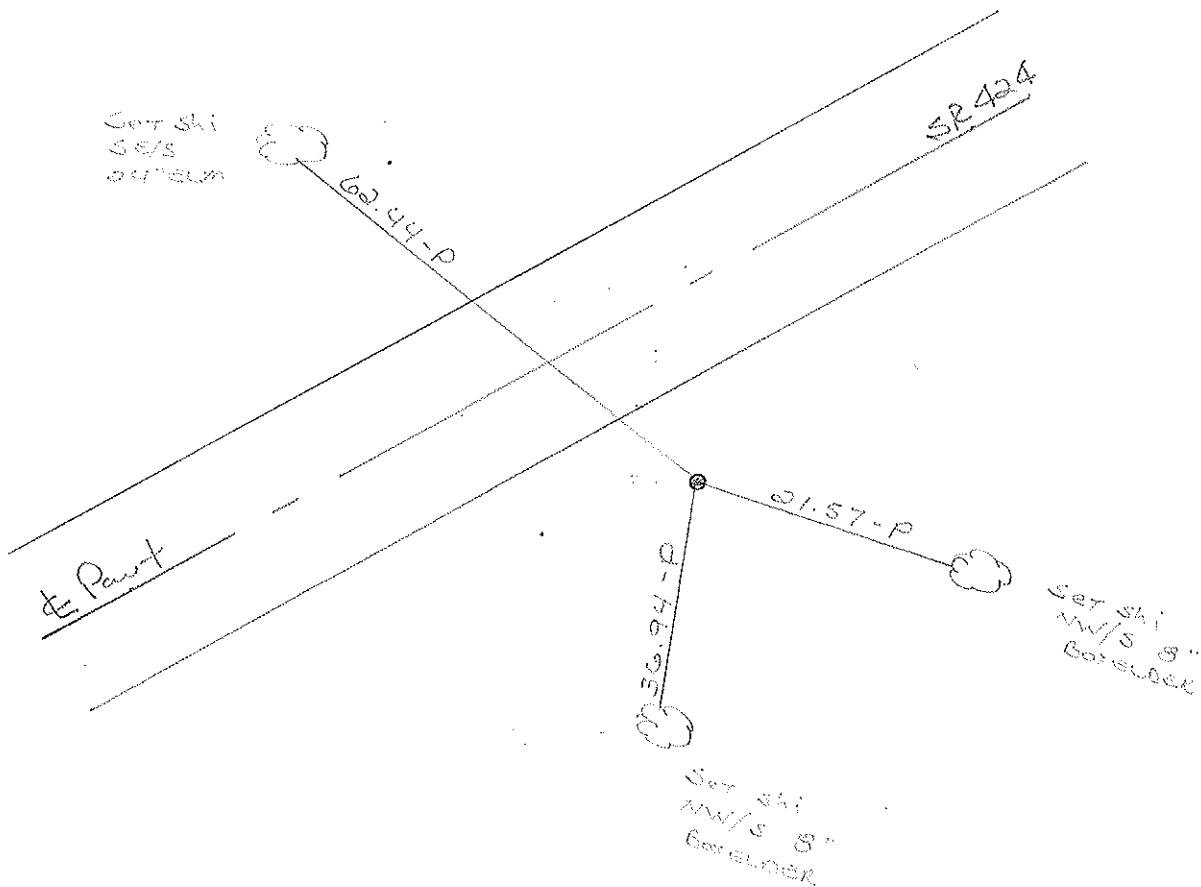

County HENRY S.R. 424

Township FLATROCK

Section 7

T4N, R6E

Personnel Hoffman
Householder


Date 10-26-81

Weather overcast

Temp. +50°


OK
10-26-81
S.W.H.

#6

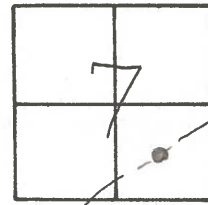

Fd 1/2" Iron Rod 2" Below Surface

Sta. 56 + 94.82 ± - Rec.

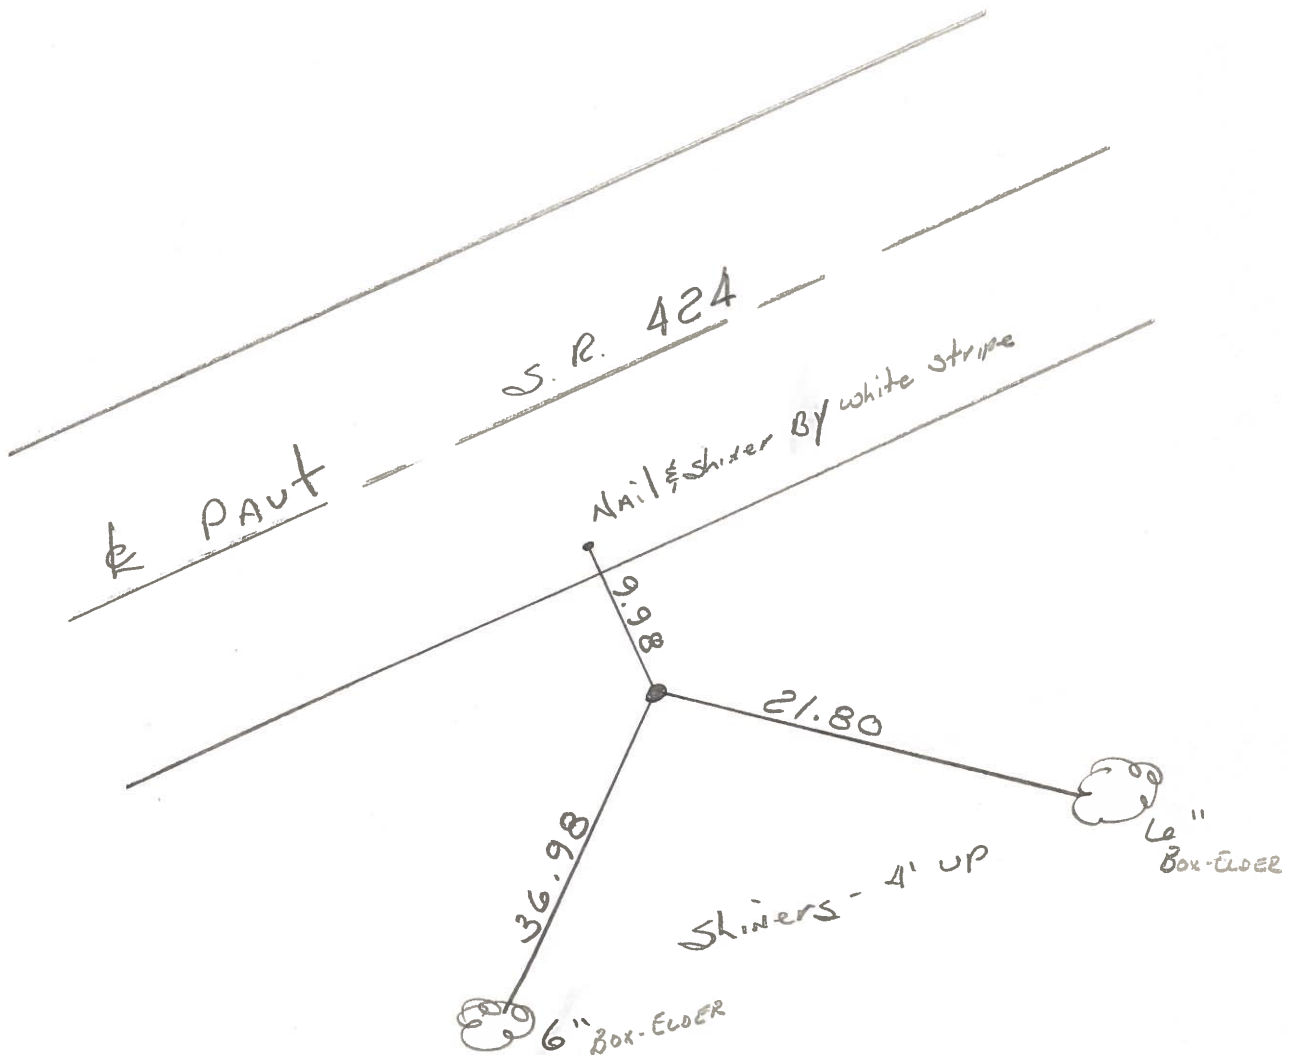


PERSONNEL	TITLE	PERSONNEL	TITLE
Tomsic			
Neuser			
Vango			

COUNTY Henry DATE MAY-2-74

S. R. 424 WEATHER cloudy

SEC. _____ TEMP. 60°

DESCRIPTION Reference 424 JOB NO. _____

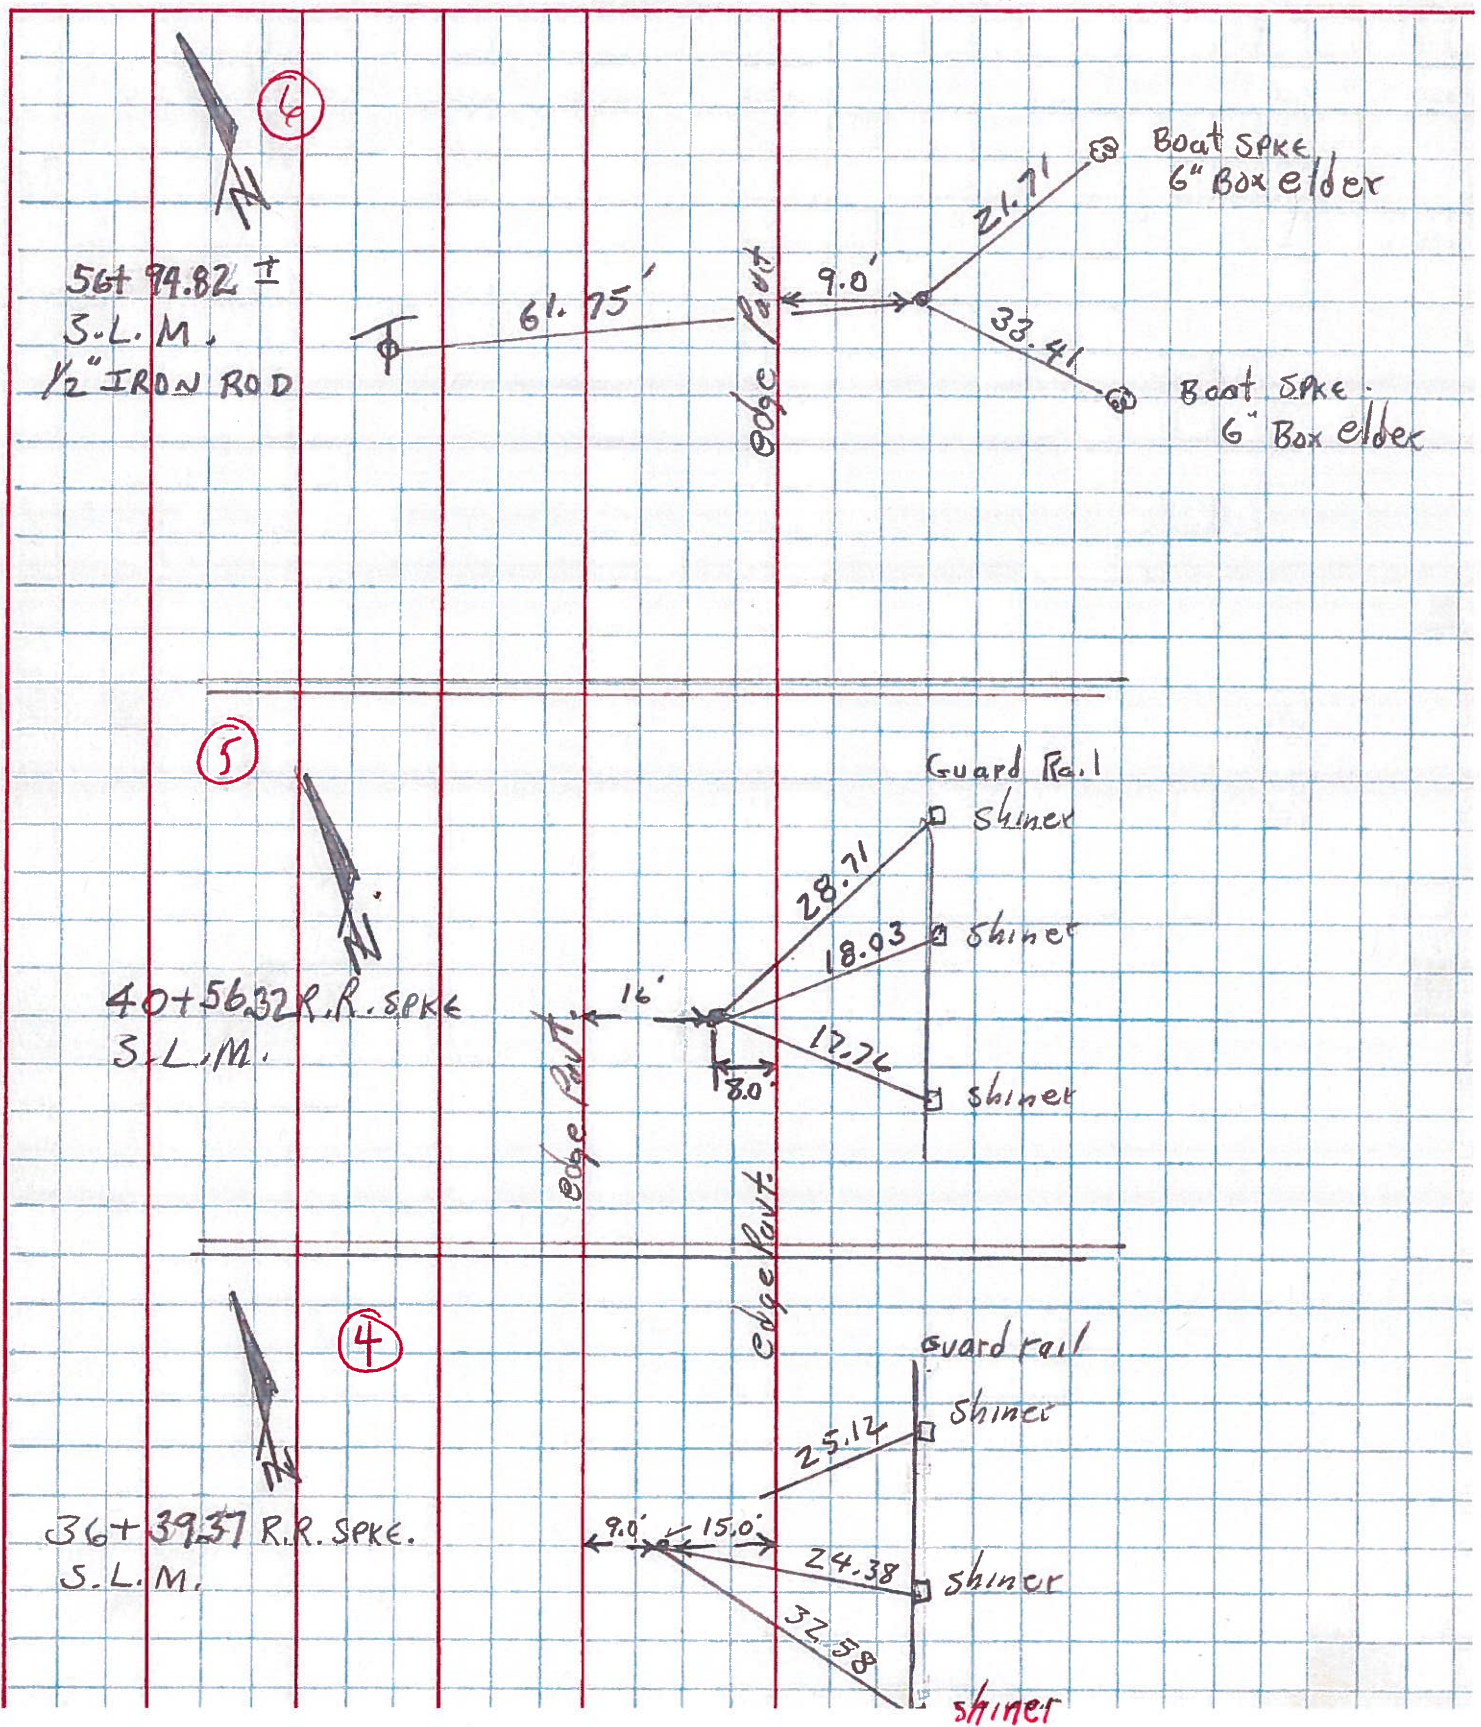

PERSONNEL	TITLE	PERSONNEL	TITLE	PERSONNEL	TITLE	PERSONNEL	TITLE
Loays							
Peschall							
Ruffer							
Wise							

COUNTY He DATE 12-14-54
 S. R. 24 WEATHER Cloudy
 SEC. Def. Co. Line to east TEMP. 36°
 DESCRIPTION Witnesses to Control Points JOB NO. _____

