


O.D.O.T. DISTRICT 2 SURVEY OFFICE (USE ONLY)


PERSONNEL _____ REFERENCE NO. 7 SHEET 7 OF 48
 NOTES HOMAN DATE 05/08/12 ROUTE SR 424
 H.C. ROUSOS WEATHER CLOUDY COUNTY HENRY
 R.C. HARBAUGH TEMP. 40° TOWNSHIP FLATROCK
 _____ SECTION 7
 _____ T 4 N R 6 E

TYPE MONUMENT 1" IRON ROD
~~ON SURFACE~~ - BELOW 1"
 LEFT - ~~C PAV'T~~ - RIGHT 15.1
3.0 TO LT EDGE PAVEMENT
 S.L.M. 65+06

Grid: Northing: 605549.139 Easting: 1498189.264

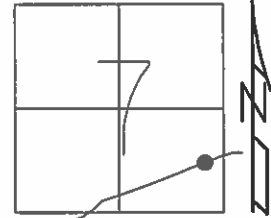

RECORD:
 SLM STA. 65+05.77
 OK FD
 12/29/08
 #106
 REF8
 FD 5/8" IPIN
 02/16/12, DCH

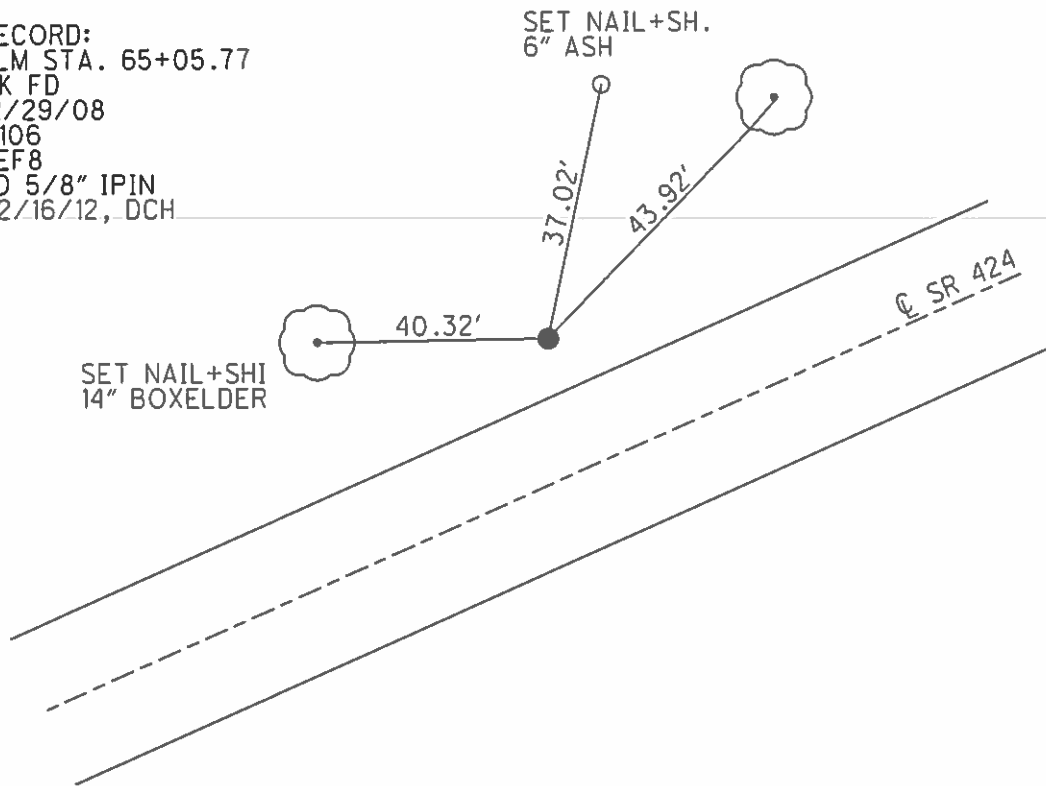

O.D.O.T. DISTRICT 2 SURVEY OFFICE

PERSONNEL

REFERENCE NO. 7

SHEET 7 OF 43

NOTES HOFFMAN

H.C. COCHISE

R.C. BANDEROL

DATE 4-1-91

WEATHER CLOUDY

TEMP. 40°

ROUTE SR 424

COUNTY HENRY

TOWNSHIP FLATROCK

SECTION 7

T4 N R 6 E


TYPE MONUMENT 1" IRON ROD

ON SURFACE - BELOW 1


LEFT- & PAV'T. - RIGHT 15.1

3.0 TO LT EDGE PAVEMENT

S.L.M. 65+06

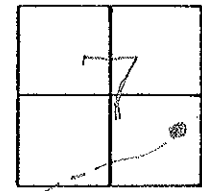

RECORD!
SLM STA. 65+05.77

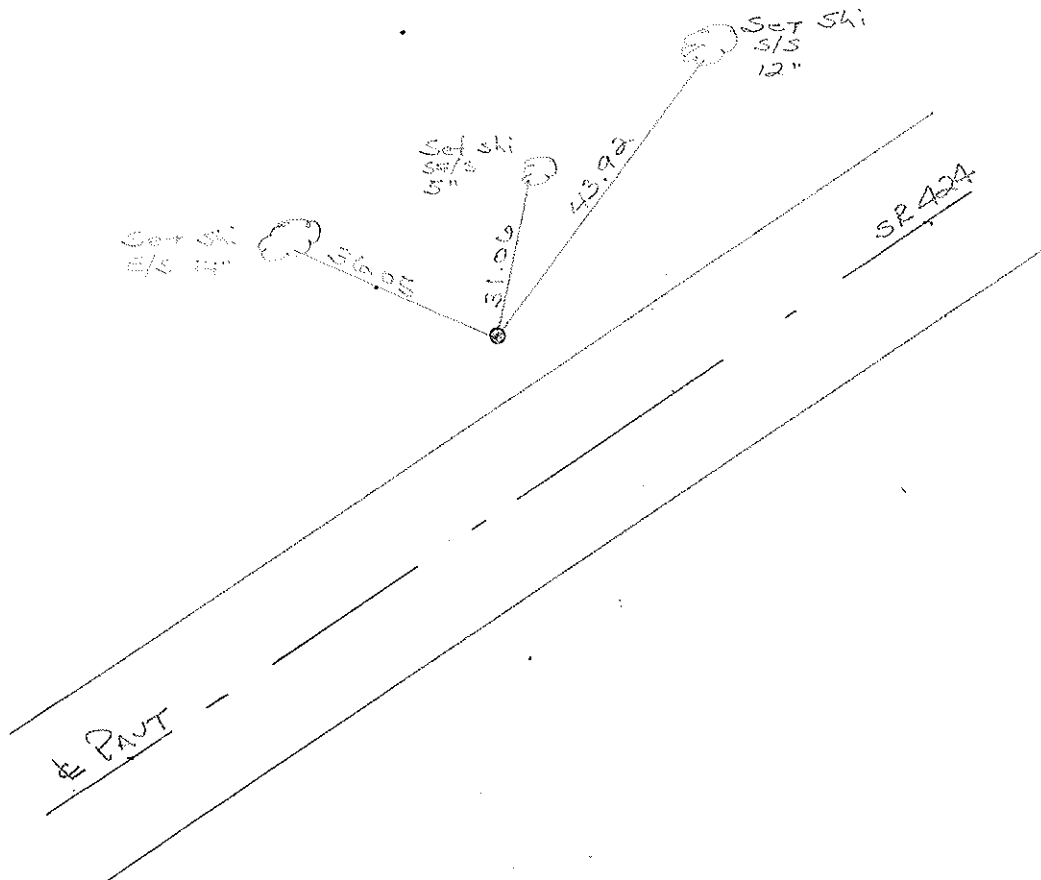

County HENRY S.R. 424

Township FLAT ROCK

Section 7

T4N, R6E

Personnel Hoffman

Householder


Date 6-17-81

Weather clear

Temp. +65°


OK
10-26-81
S.W.H.

#7

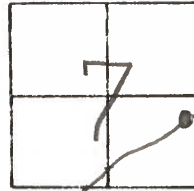

Fd. 1" IRON Rod 1" Below Surface
15' N. OF E PAVE.

PROJECT STA. ± 65+16

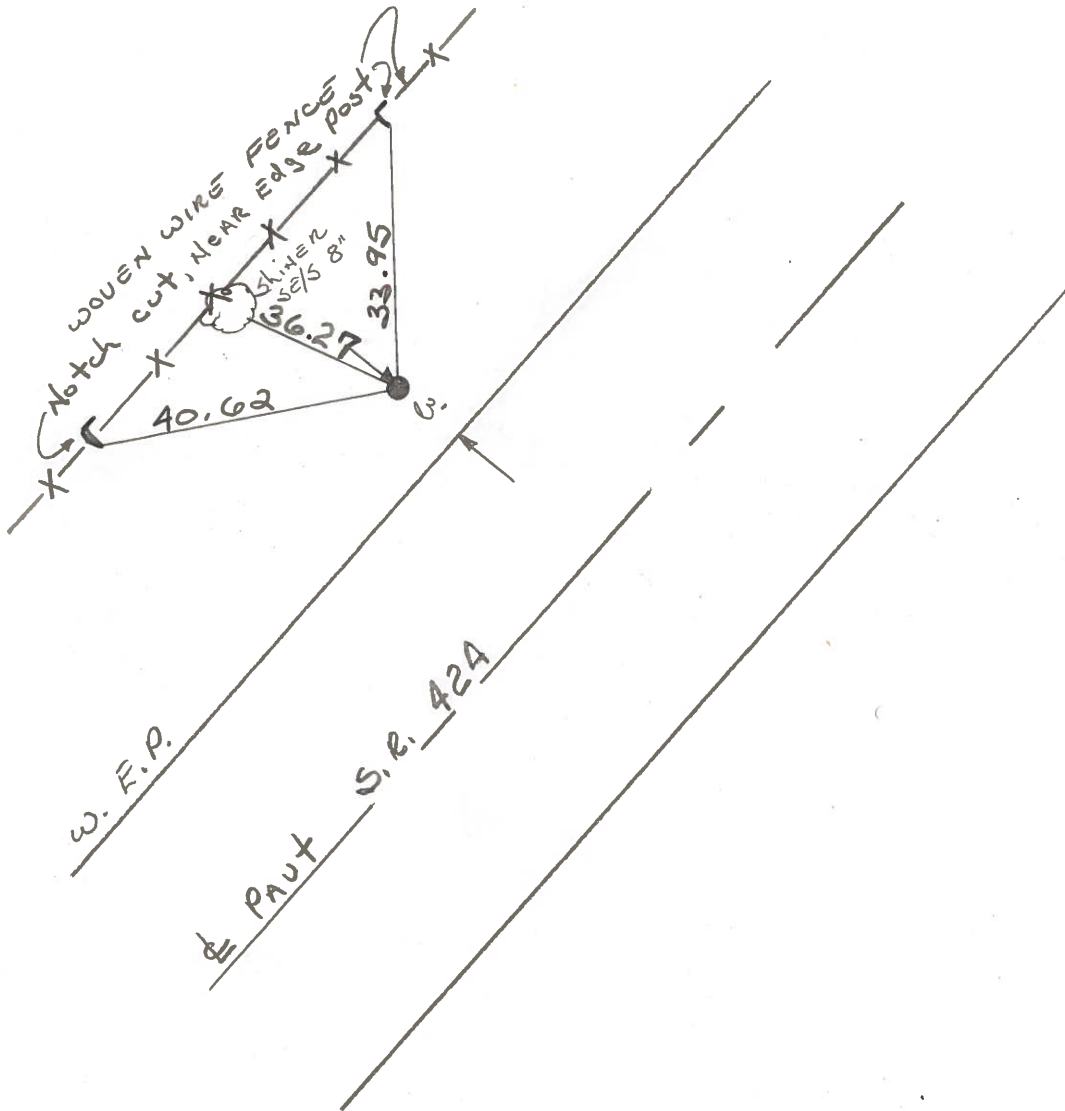

S.L.M. 65+05.77 - REC.

PERSONNEL	TITLE	PERSONNEL	TITLE
Tomsic			
Neuser			
Vango			

COUNTY HENRY DATE MAY - 2 - 74

S. R. 424 WEATHER cloudy

SEC. _____ TEMP. 60°

DESCRIPTION Reference 424 0+00 = Defiance Co. line. JOB NO. _____

