


O.D.O.T. DISTRICT 2 SURVEY OFFICE (USE ONLY)


PERSONNEL	REFERENCE NO.	<u>12</u>	SHEET	<u>12</u>	OF	<u>48</u>
NOTES	<u>HOFFMAN</u>	DATE	<u>4-3-91</u>	ROUTE	<u>SR 424</u>	
H.C.	<u>LOEHRKE</u>	WEATHER	<u>CLEAR</u>	COUNTY	<u>HENRY</u>	
R.C.	<u>BARNHISEL</u>	TEMP.	<u>40°</u>	TOWNSHIP	<u>FLATROCK</u>	
				SECTION	<u>8-IN FLORIDA</u>	
				T	<u>4</u>	N
				R	<u>6</u>	E

TYPE MONUMENT R.R. SPK
~~ON SURFACE~~ - BELOW 1 1/2"
~~LEFT - C PAV'T - RIGHT~~ 1.8'
20.8 TO RT EDGE PAVEMENT
 S.L.M. 109+13

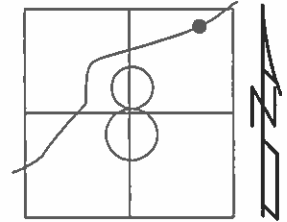

Grid: Northing: 607953.370 Easting: 1501682.383

RECORD:
 P.I. STA 109+10.68
 REF. DESTROYED
 12/29/08
 REF13 CN PT
 FROM REFERENCE
 TIES 2-16-12 DCH
 RNI

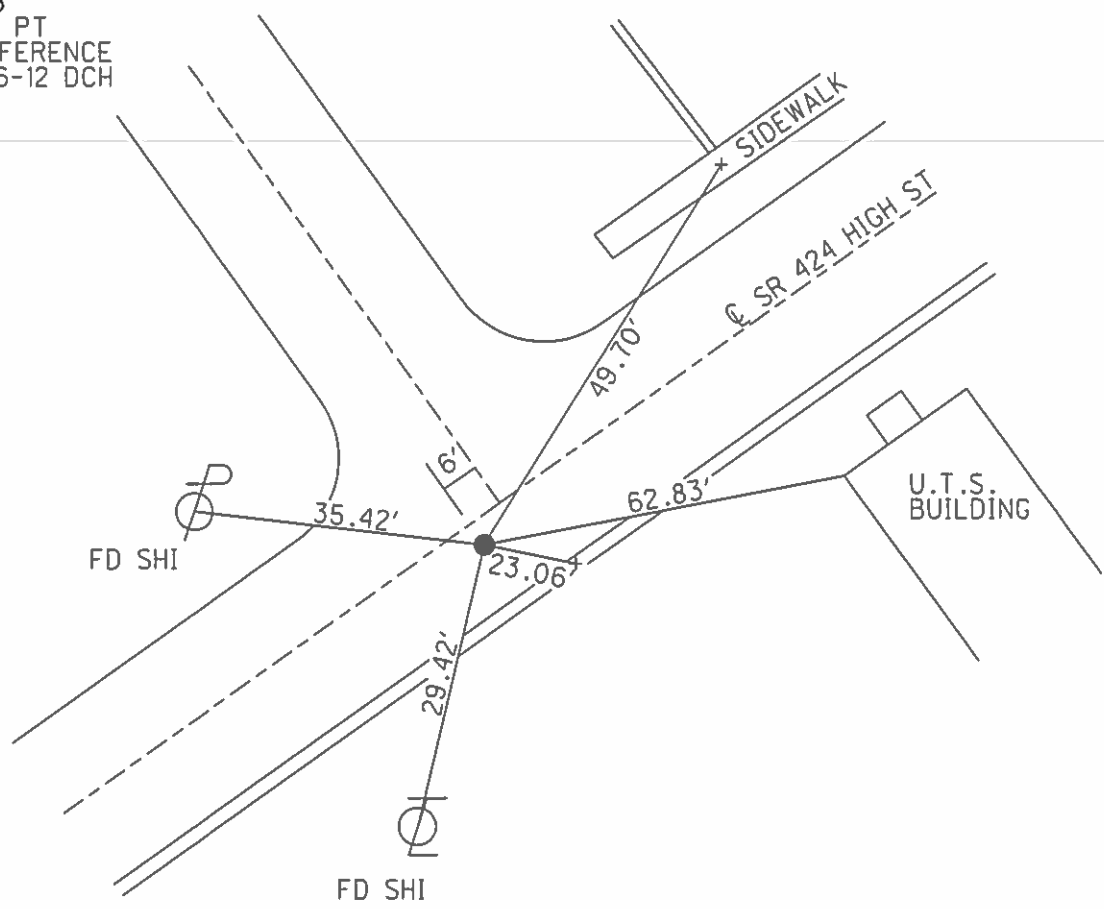

O.D.O.T. DISTRICT 2 SURVEY OFFICE

PERSONNEL _____

REFERENCE NO. 12

SHEET 12 OF 43

NOTES HOFFMAN

H.C. LOANER

R.C. BRUNNEN

DATE 4-3-91

WEATHER CLEAR

TEMP. 40°

ROUTE SR 424

COUNTY HENRY

TOWNSHIP FLAT ROCK

SECTION 8 - 1 N FLORIDA

T.4 N R.6 E

Set P.K. / WASHER
5-23-91
G.L.


TYPE MONUMENT R.L. SPK

ON SURFACE - BELOW 1 1/2"


LEFT- & PAW'T. - RIGHT 1.8'

20.8 TO RT EDGE PAVEMENT (C106)

S.L.M. 109 + 13

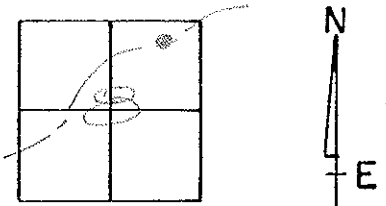

RECORDS:
P.I. sta. 109 + 10.68

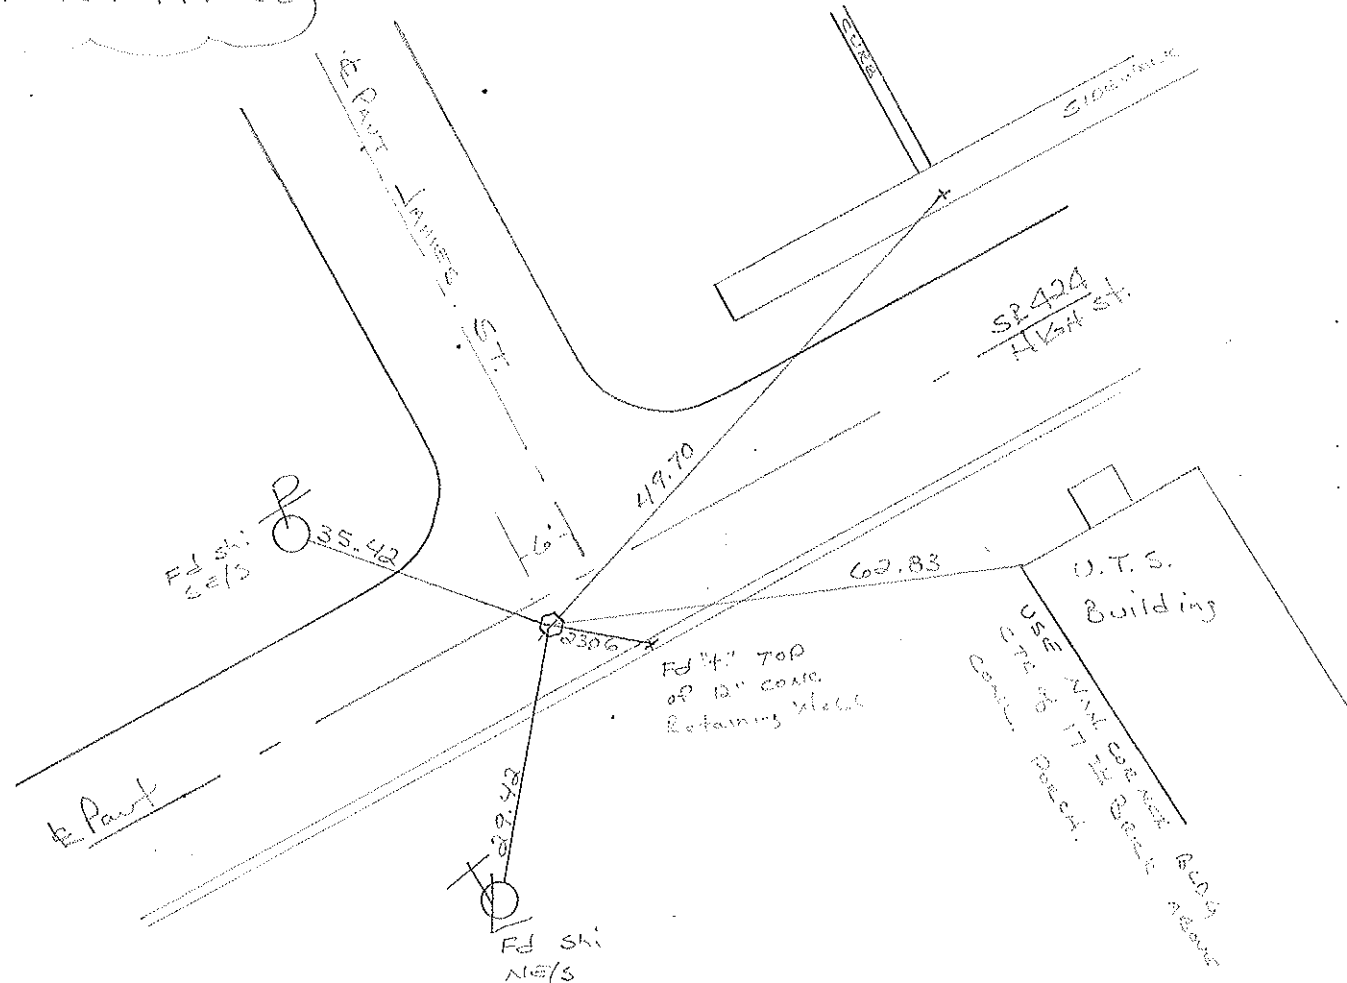

County HENRY S.R. 424

Township FLAT ROCK

Section 8 - IN FLORIDA LIMITS
T4N, R6E

Personnel Hoffman
Householder


Date 6-17-81

Weather Clear

Temp. +70°


OK
10-26-81
S.W.H.

12

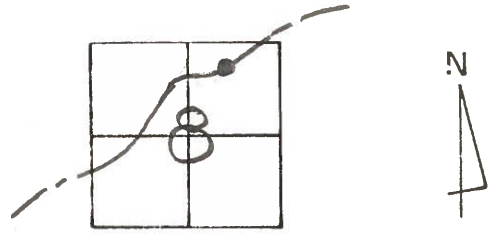

Fd. R.R. SPK @ SURFACE
1.3' Rt. of & PAUT SR 424


PROJECT STA ± 109+22

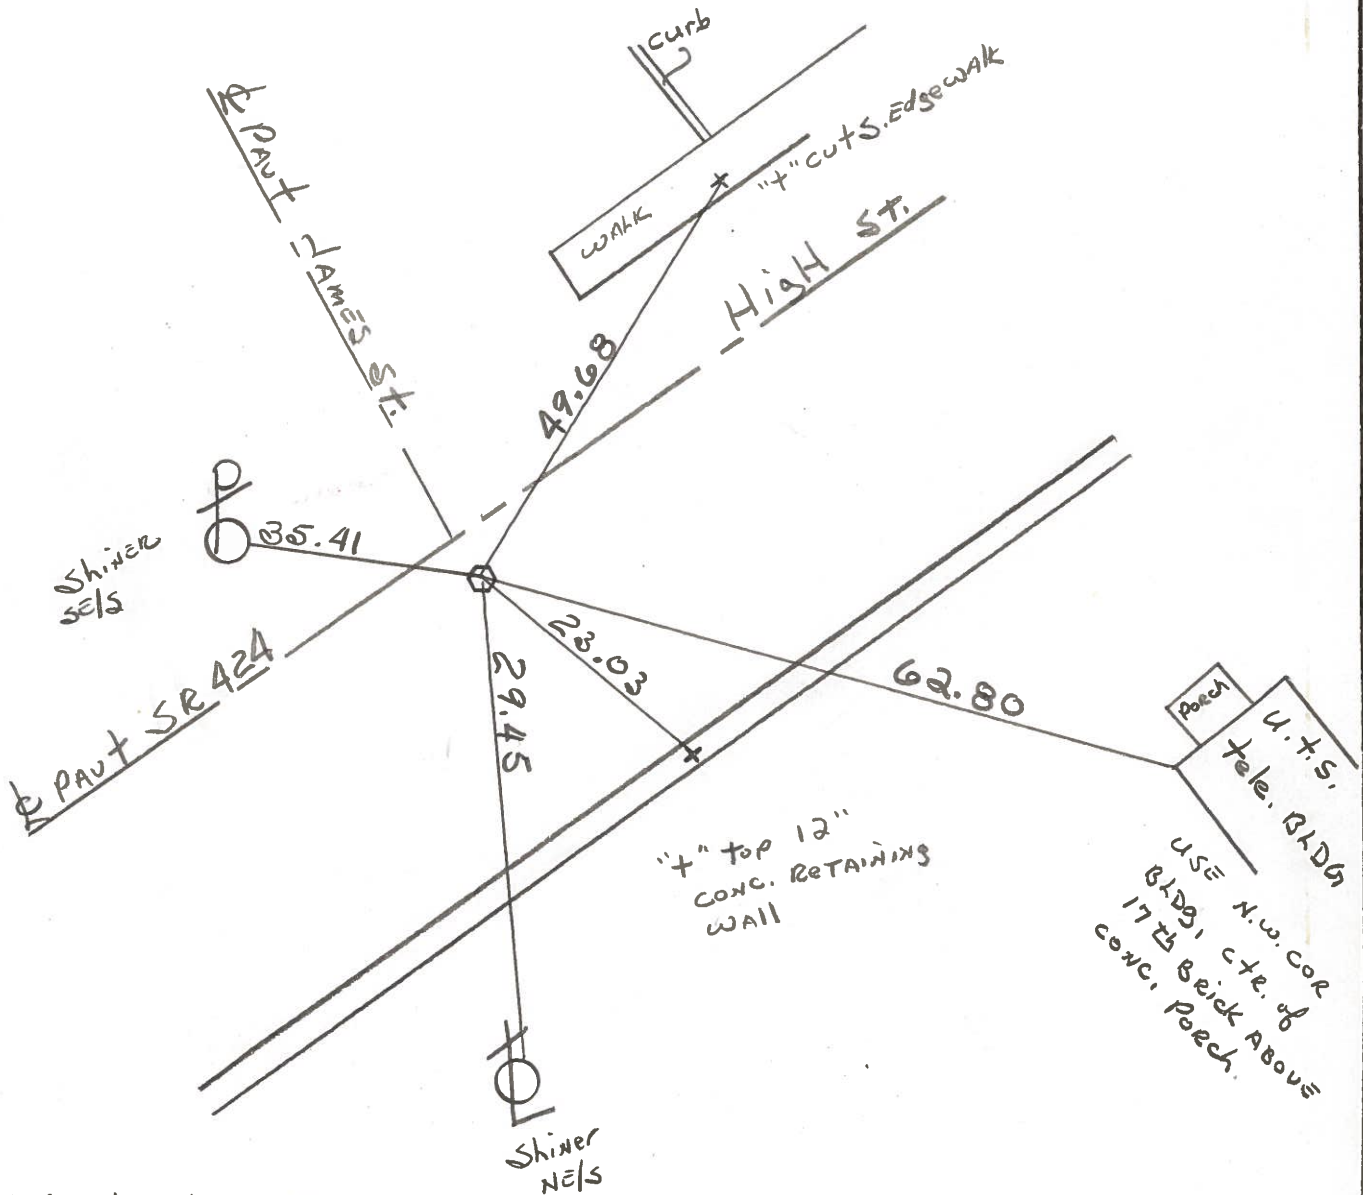

P.I. STA. 109+10.68

PERSONNEL	TITLE	PERSONNEL	TITLE	COUNTY	DATE
Tomsik				HENRY	MAY 23, 1974
Neuser				S. R.	424
Granata				WEATHER	clear
Vanzo				SEC.	TEMP. 70's


DESCRIPTION	LEFT	CENTER LINE	RIGHT	JOB NO.
-------------	------	-------------	-------	---------

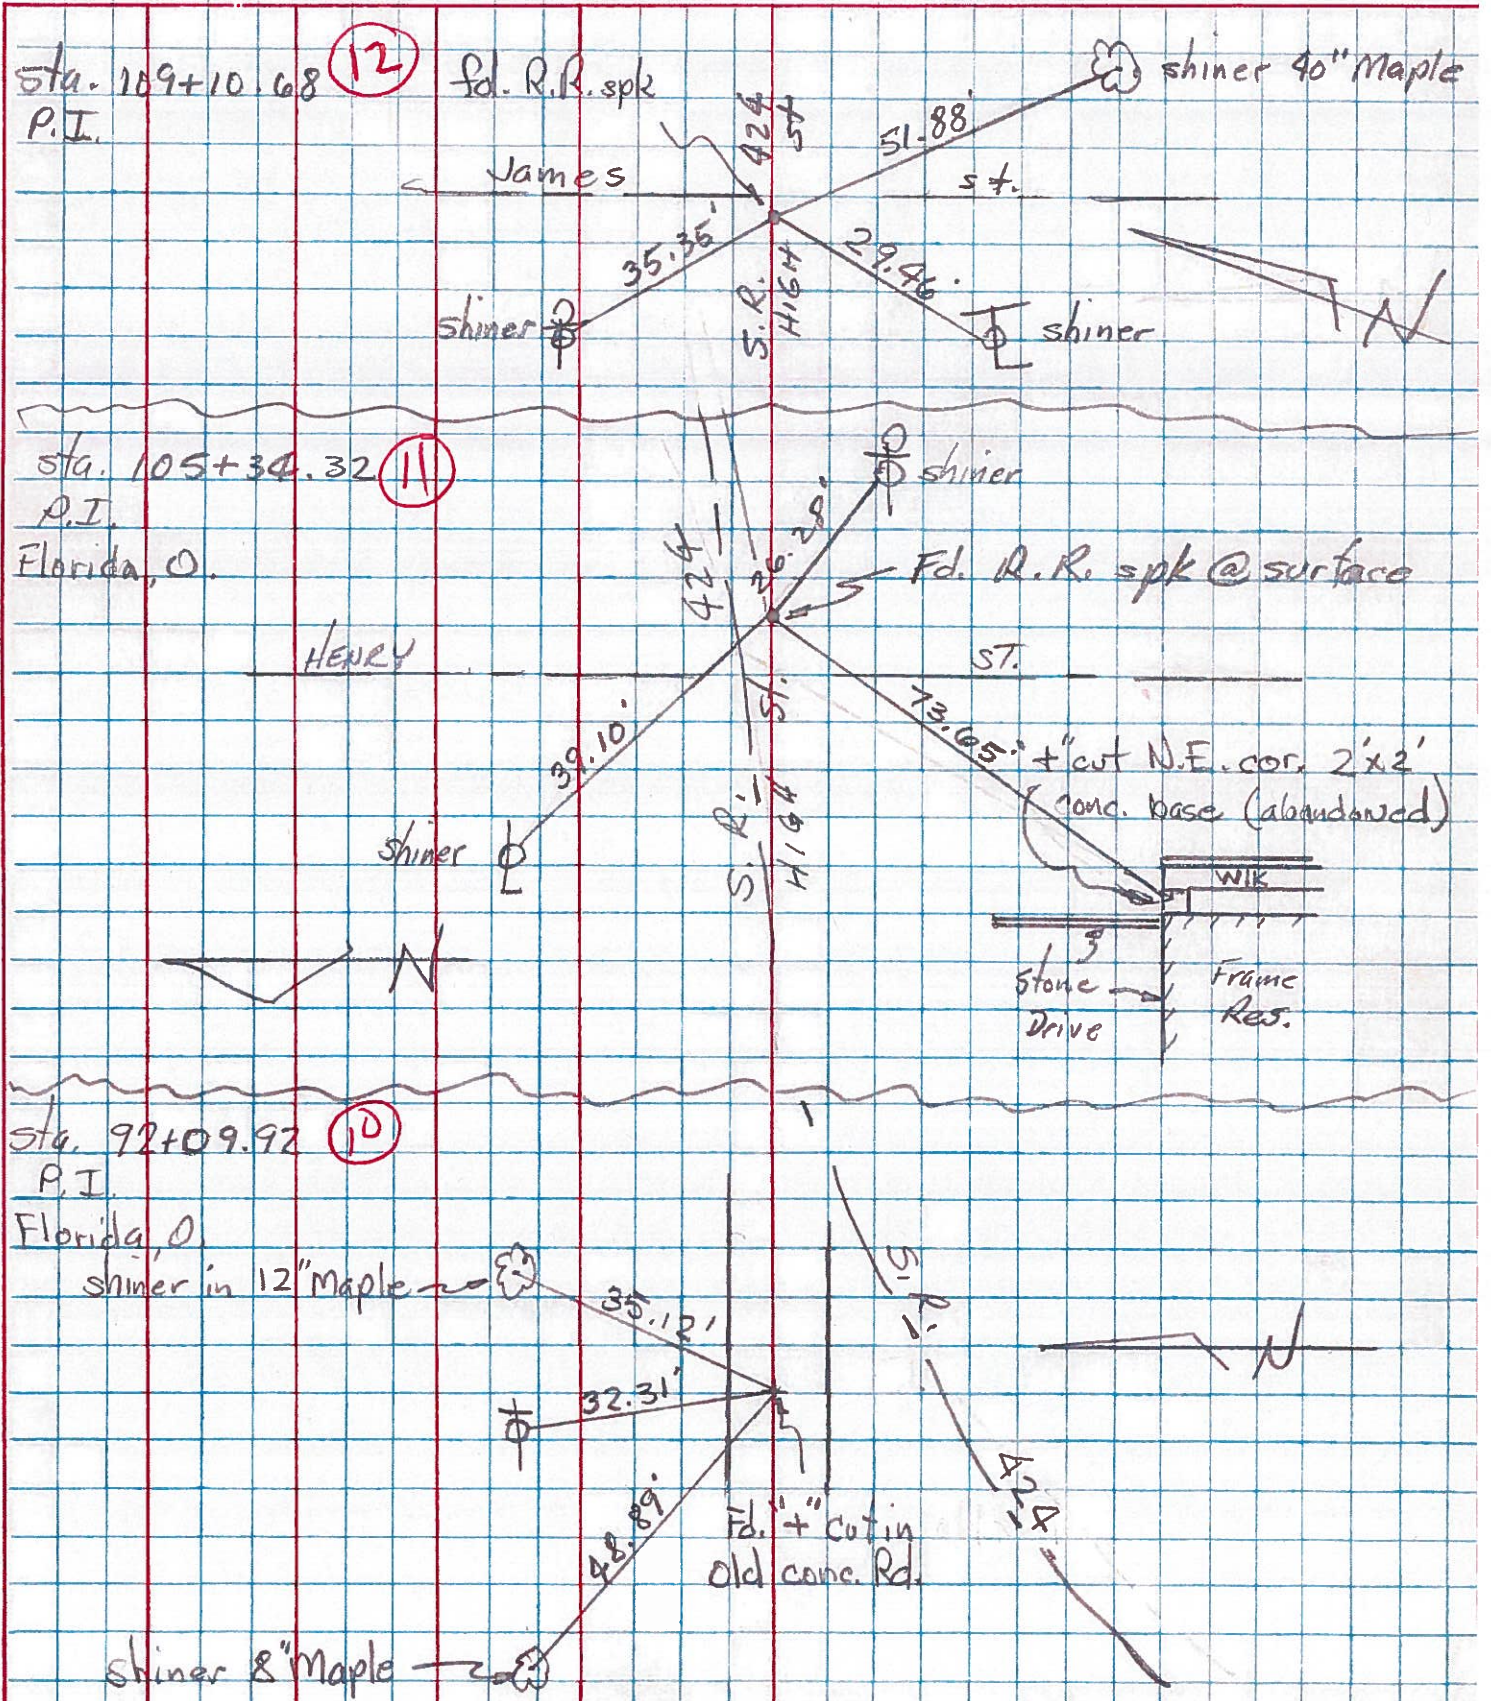


PERSONNEL	TITLE	PERSONNEL	TITLE	PERSONNEL	TITLE	PERSONNEL	TITLE
Lougs				COUNTY	He.	DATE	12-21-54
Persehall				S. R.	24	WEATHER	Fair.
Beck				SEC.	Def. Co. Line to East	TEMP.	12°
DESCRIPTION				Witnesses to Control Points		JOB NO.	
LEFT		CENTER LINE		RIGHT			

(12)

P.I. Sta. 109+10.68 (Lay Skrew in Par't)
 $\Delta = 5^{\circ} - 20' \text{ Lt.}$
 $D = 2^{\circ} - 00'$
 $T = 133.43$

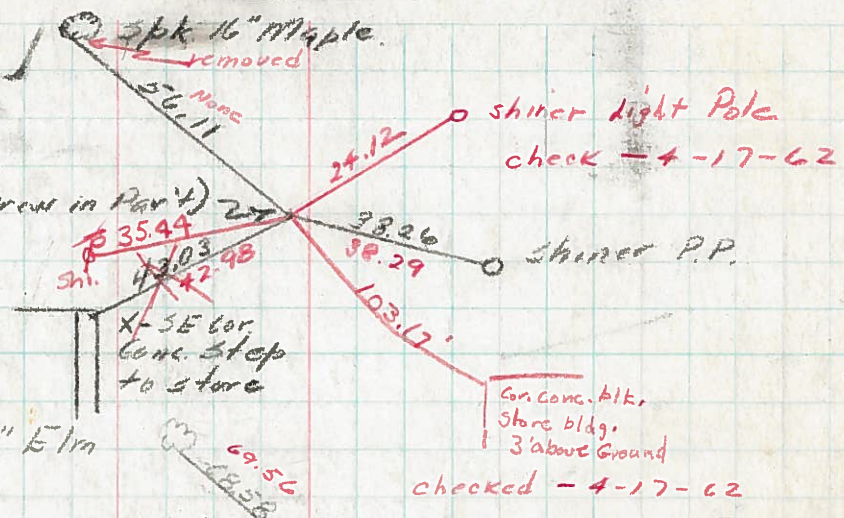

P.C. Sta. 136+17.21 (R.R. spike in Par't)

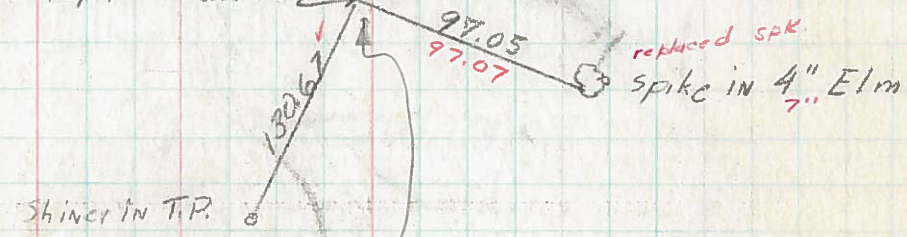

P.C. Sta. 136+17.21
 New Short Ties
 6/11/62
 Morrison.

