


O.D.O.T. DISTRICT 2 SURVEY OFFICE (USE ONLY)


PERSONNEL	REFERENCE NO.	12-A	SHEET	13	OF	48
NOTES	HOMAN	DATE	03/06/12	ROUTE	SR 424	
H.C.	HOMAN	WEATHER	CLEAR	COUNTY	HENRY	
R.C.	ROUSOS	TEMP.	40°	TOWNSHIP	FLATROCK	
				SECTION	8-IN FLORIDA	
				T	4	N
				R	6	E

TYPE MONUMENT SHANK & NAIL  
~~ON SURFACE~~ - BELOW 1 1/2"  
 LEFT - ~~C PAV'T~~ - RIGHT 2.6'  
9.1 TO LT EDGE PAVEMENT  
 S.L.M. 119+19

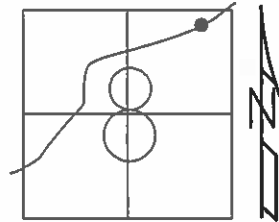

Grid: Northing: 608622.927 Easting: 1502431.186

SET P.K./WASHER  
 5-23-91, CL  
 RESET MAGNAIL & SA  
 12/29/08  
 #111  
 REF 14  
 FD MAG  
 02/21/12, DCH

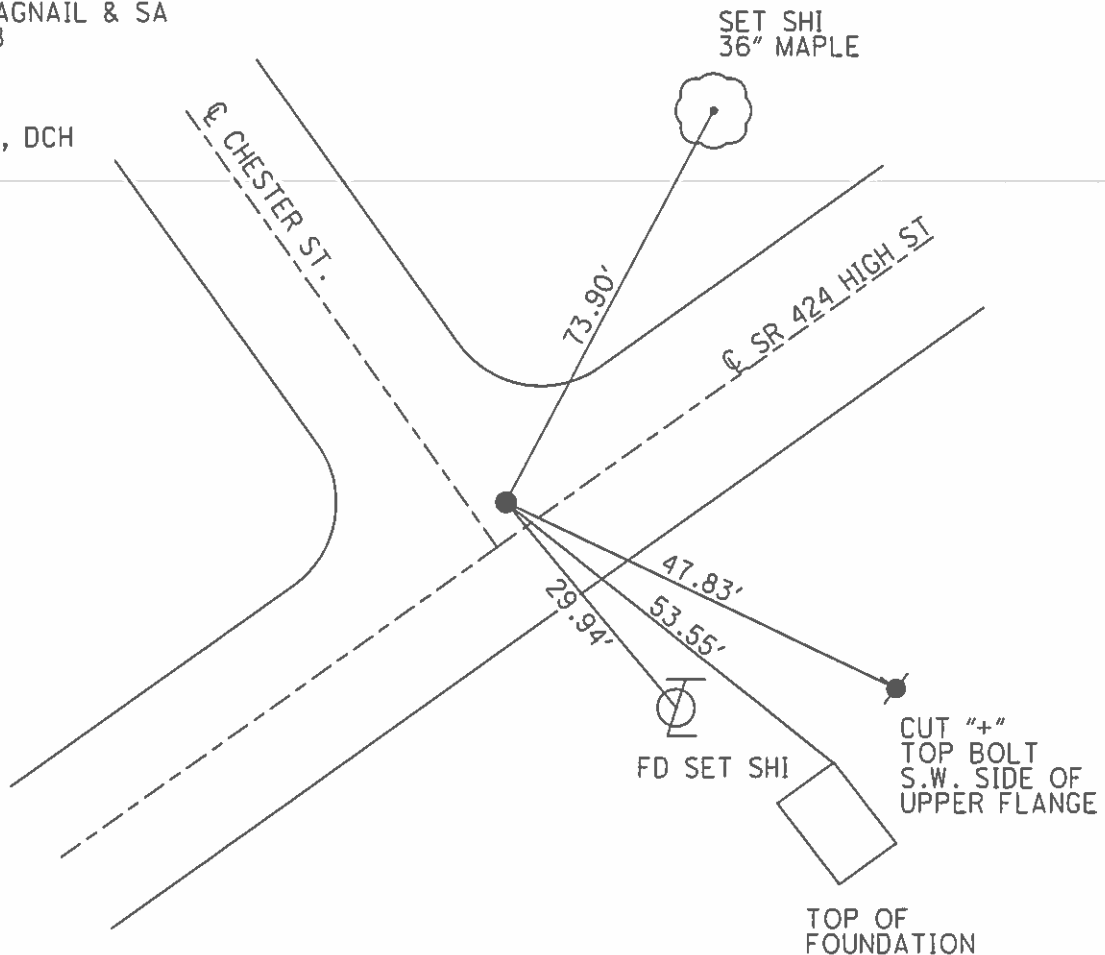

# O.D.O.T. DISTRICT 2 SURVEY OFFICE

PERSONNEL \_\_\_\_\_

REFERENCE NO. 12-A

SHEET 13 OF 43

NOTES HOFFMAN

H.C. LOCHHEAD

DATE 4-3-91

ROUTE SP 424

R.C. BRUNDELL

WEATHER CLEAR

COUNTY HENRY

TEMP. 40°

TOWNSHIP FLATROCK

SECTION 8 - 1 N FLORIDA

T4 N R 6 E

TYPE MONUMENT SHANK OF NAIL



SET P.K./WASHER  
5-23-91  
C.L.

ON SURFACE - BELOW 1 1/2'

LEFT- & PAV'T. - RIGHT 2.6'

9.1 TO LT EDGE PAVEMENT

S.L.M. 119 + 19

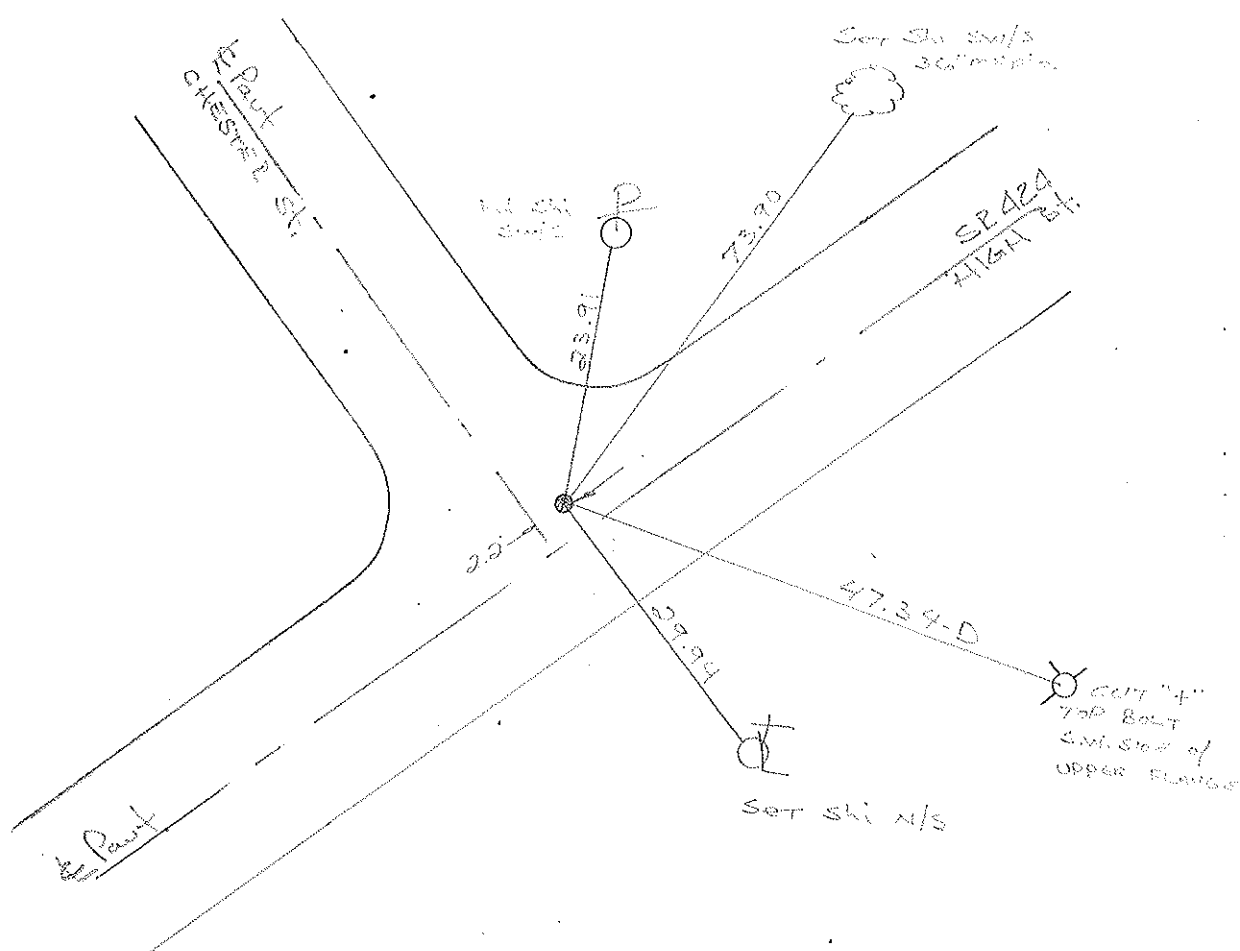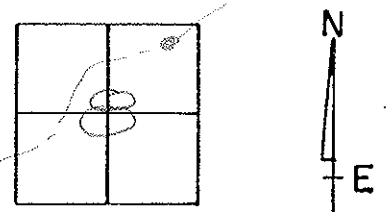

OK  
10-26-81  
S.W.F.

County HENRY S.R. 424

Date 6-17-81

Township FLATROCK

Weather clear

Section 8 - in village of Florida


Temp. +70°

T4N, R6E

Personnel HOFFMAN

Householder

# 12-A

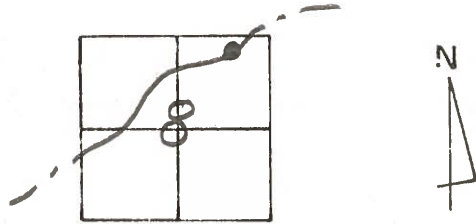


Fd. Nail 1" below surface

2.5' Lt. of & PAUT SR 224

14.0' to S. E.P.

RE-SET P.K. & WASHER


PROJECT STA. ± 119+25

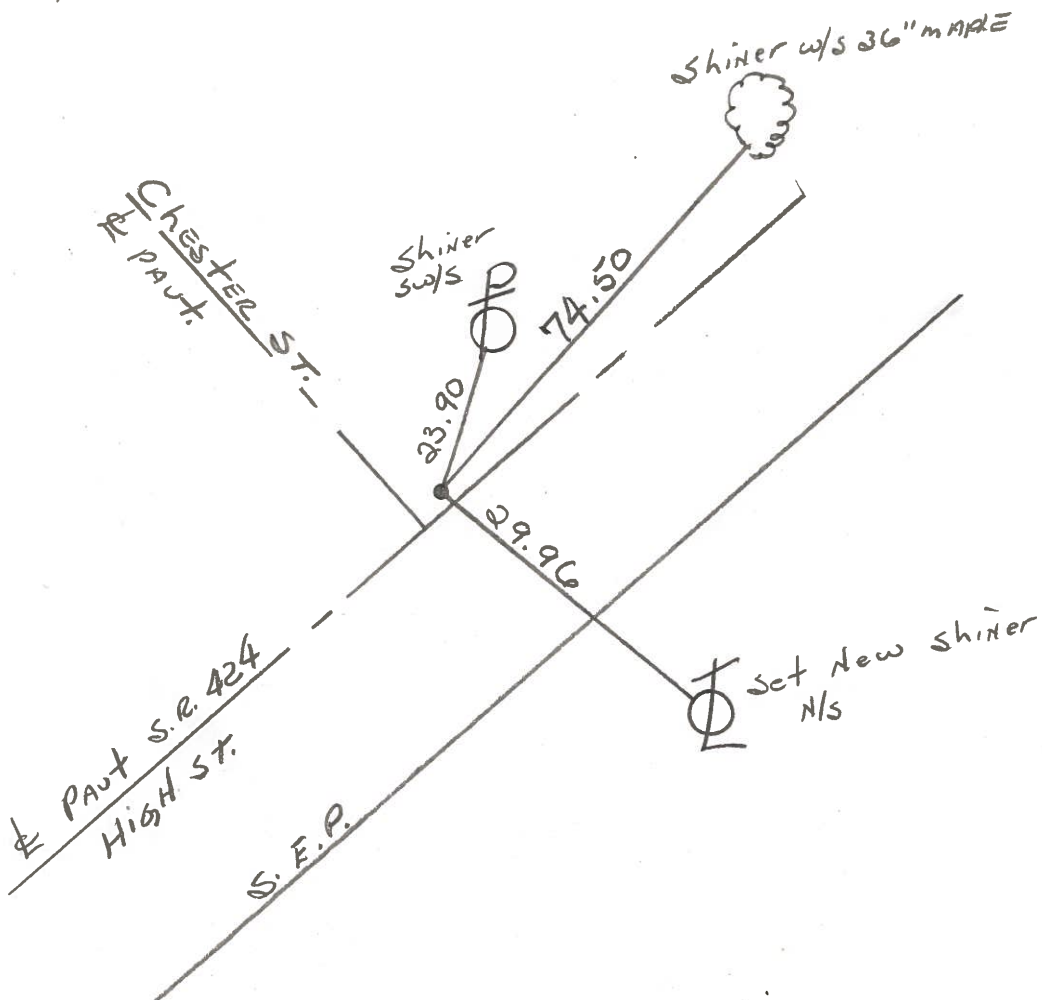

PERSONNEL	TITLE	PERSONNEL	TITLE
Tomasic			
Neuser			
Granata			
Vanyo			

COUNTY HENRY DATE May 28, 1974  
 S. R. 424 WEATHER cool  
 SEC. \_\_\_\_\_ TEMP. \_\_\_\_\_

DESCRIPTION \_\_\_\_\_ LEFT \_\_\_\_\_ CENTER LINE \_\_\_\_\_ RIGHT \_\_\_\_\_ JOB NO. \_\_\_\_\_

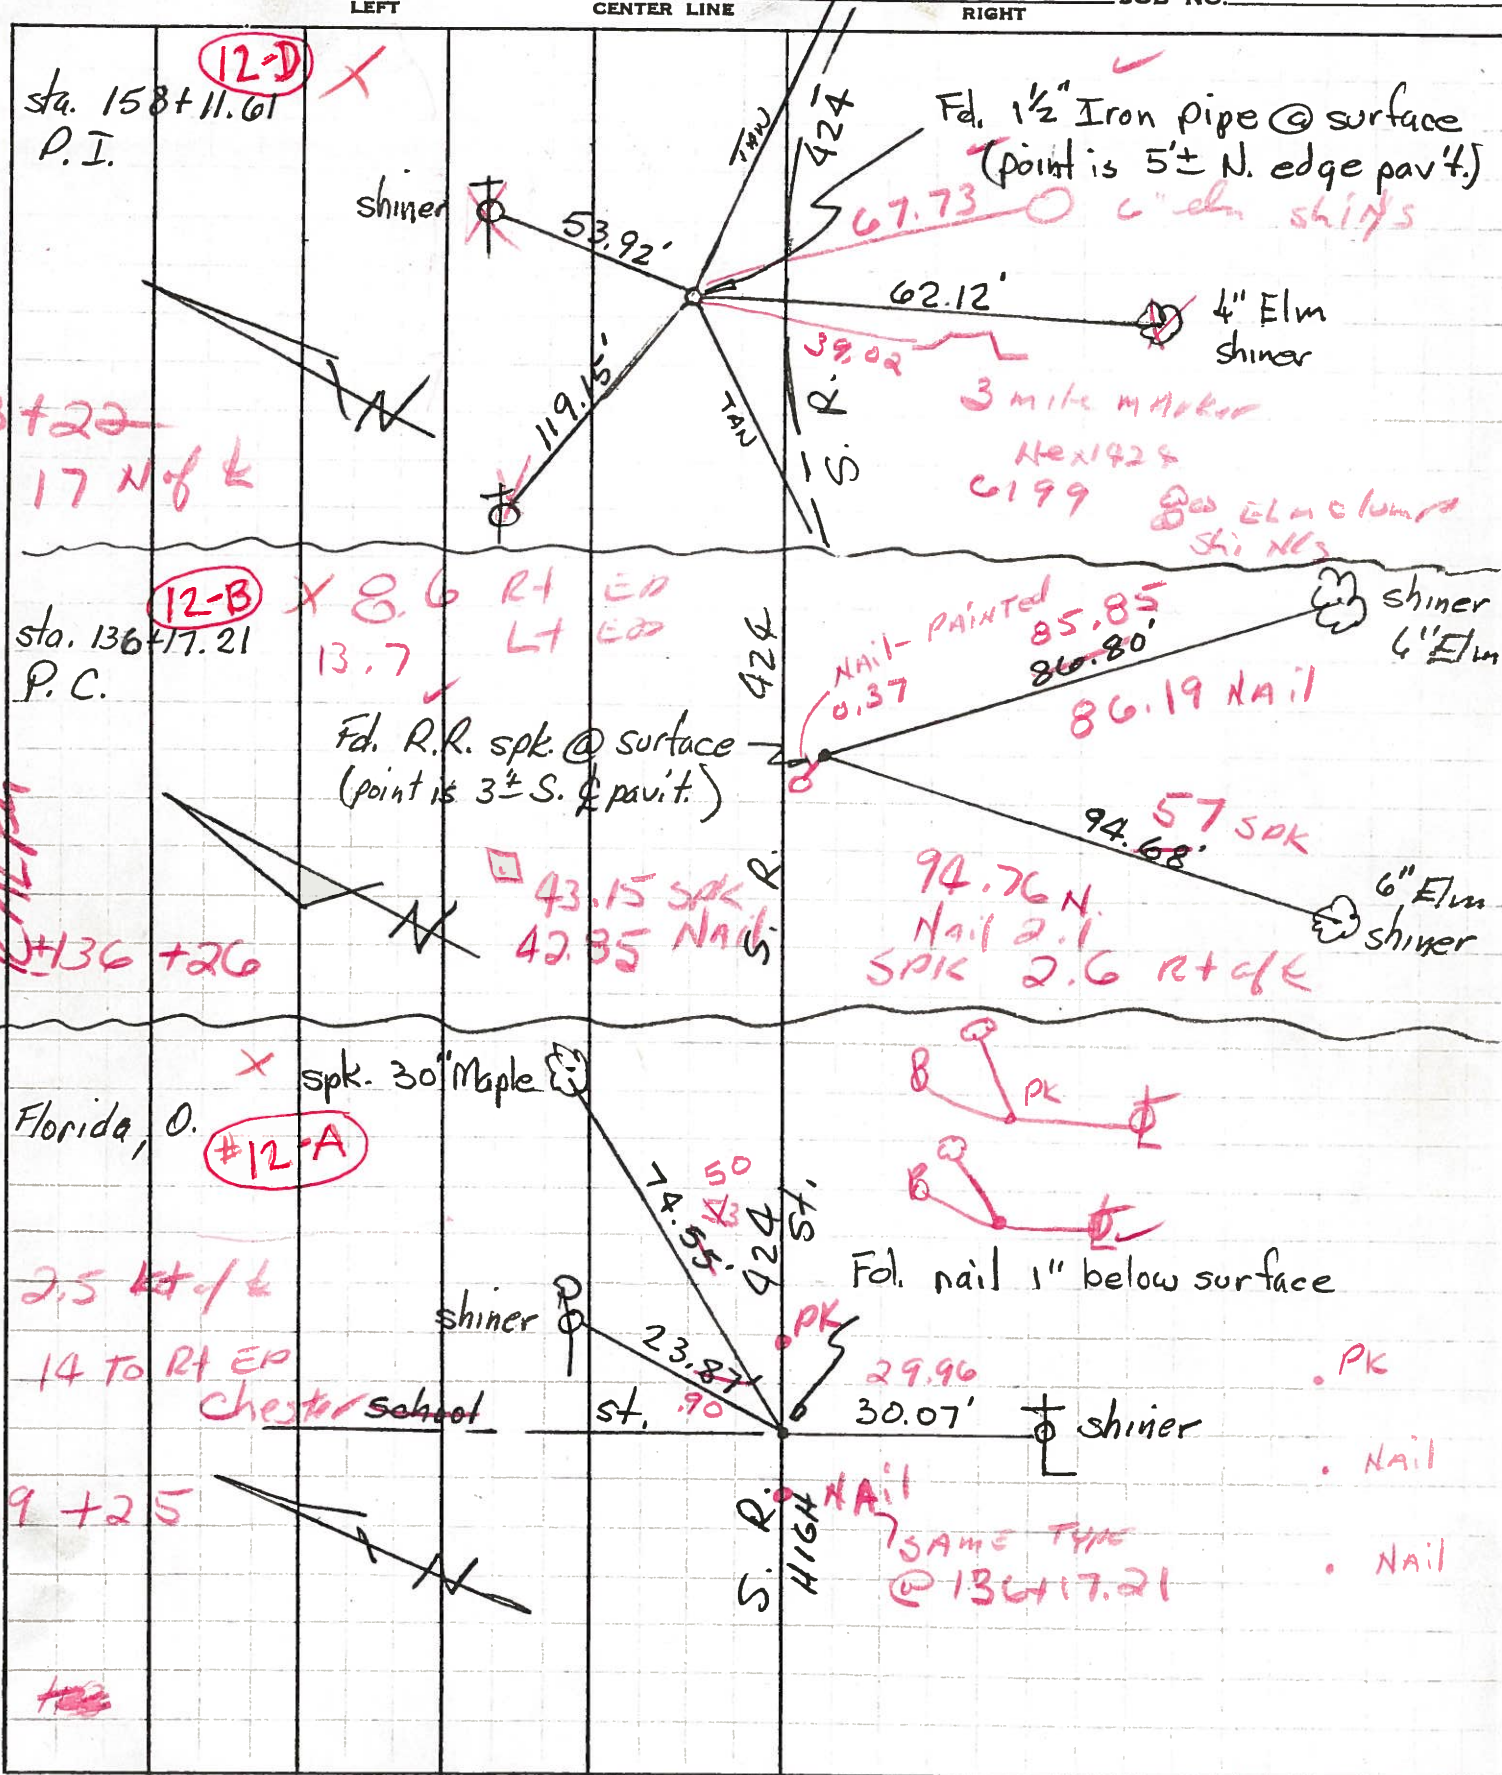

158+22  
17 N of k

ASK  
H 136+26

119+25

12-D

12-B

#12-A

shiner

F.d. R.R. spk. @ surface  
(point is 3 1/2 S. of pavit.)

spk. 30" Maple

shiner

chester school

F.d. 1 1/2" Iron pipe @ surface  
(point is 5' ± N. edge pav't.)

4" Elm shiner

3 mile marker  
HENRY 424  
6199 800 ELM clump  
Shi No 3

shiner 4" Elm

6" Elm shiner

F.d. nail 1" below surface

shiner

HIGH NAIL  
SAME TYPE @ 136+17.21

53.92'

119.15'

62.12'

39.02'

S. R.

424

S. R.

424

S. R.

74.95

23.87

29.96

30.07'

424

424

