


O.D.O.T. DISTRICT 2 SURVEY OFFICE (USE ONLY)


PERSONNEL	REFERENCE NO.	12-B	SHEET	14	OF	48
NOTES	HOMAN	DATE	03/06/12	ROUTE	SR 424	
H.C.	HOMAN	WEATHER	CLEAR	COUNTY	HENRY	
R.C.	ROUSOS	TEMP.	40°	TOWNSHIP	FLATROCK	
				SECTION	5	
				T	4	N
				R	6	E

TYPE MONUMENT _____ PK _____
 ON SURFACE - ~~BELOW~~ _____ ON _____
~~LEFT - C PAVT~~ - RIGHT _____ 2.7' _____
 9.5 TO RT EDGE PAVEMENT
 S.L.M. _____ 136+21 _____

Grid: Northing: 609756.260 Easting: 1503699.947

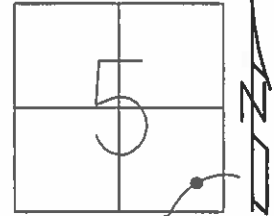

RECORD:
 P.C. STA 136+21
 SET PK/WASHER
 05/23/91, CL
 OK FD
 12/29/08
 #112
 REF15
 FD PK
 02/21/12, DCH

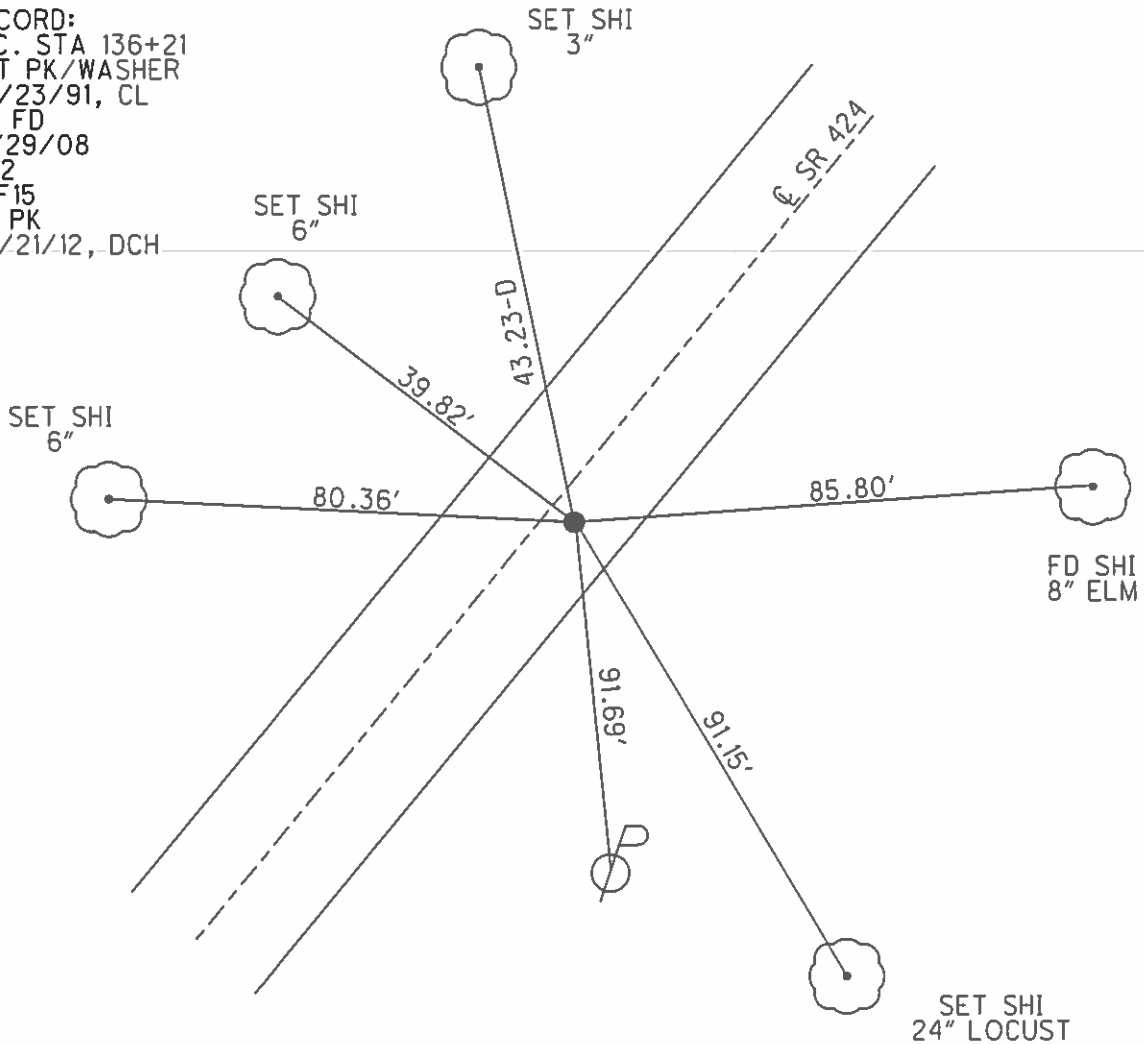

O.D.O.T. DISTRICT 2 SURVEY OFFICE

PERSONNEL

REFERENCE NO. 12-B

SHEET 14 OF 43

NOTES HOFFMAN

H.C. LOEHRKE

DATE 4-3-91

ROUTE SR 424

R.C. BRENNISSEL

WEATHER CLEAR

COUNTY HENRY

TEMP. 40°

TOWNSHIP FLATROCK

SECTION 5

SET P.K./WASHER
5-23-91
C.L.

T.4 N R.6 E


TYPE MONUMENT 2" SPIK/WASHER

ON SURFACE - BELOW YES

LEFT - 0 PAV'T. - RIGHT 2.7'


9.5 TO RT. EDGE PAVEMENT

S.L.M. 136 + 21

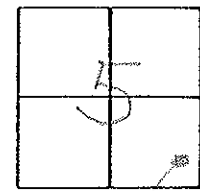

RECORD:

P.C. Sta. 136 + 17.21

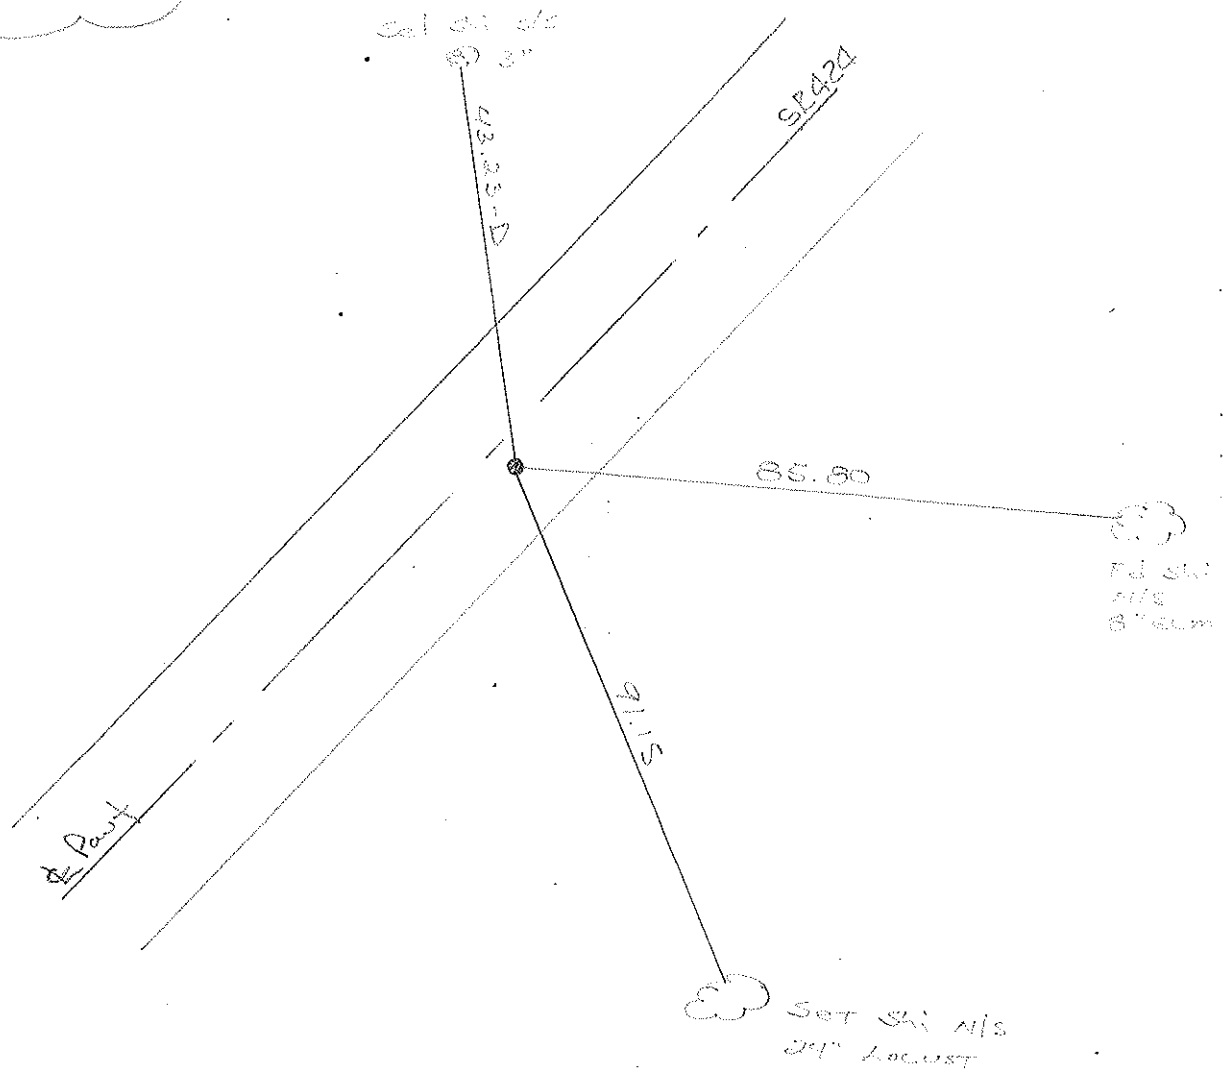

County Henry S.R. 424

Township FLatrock

Section 5

T4N, R6E

Personnel Hoffman

Householder


Date 6-17-81

Weather CLEAR

Temp. +75°

OK
10-19-81
S.W.H.

* 12-B

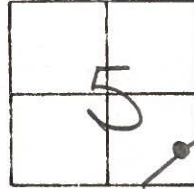


Fd. R.R. SPK @ SURFACE
2.6' RT. of PAUT SR 424
13.7' to N. Edge PAUT
8.6' to S. Edge PAUT

ASK RALPH

PROJECT STA. ± 136 + 26

RE-SET 2" SPK/WASHER

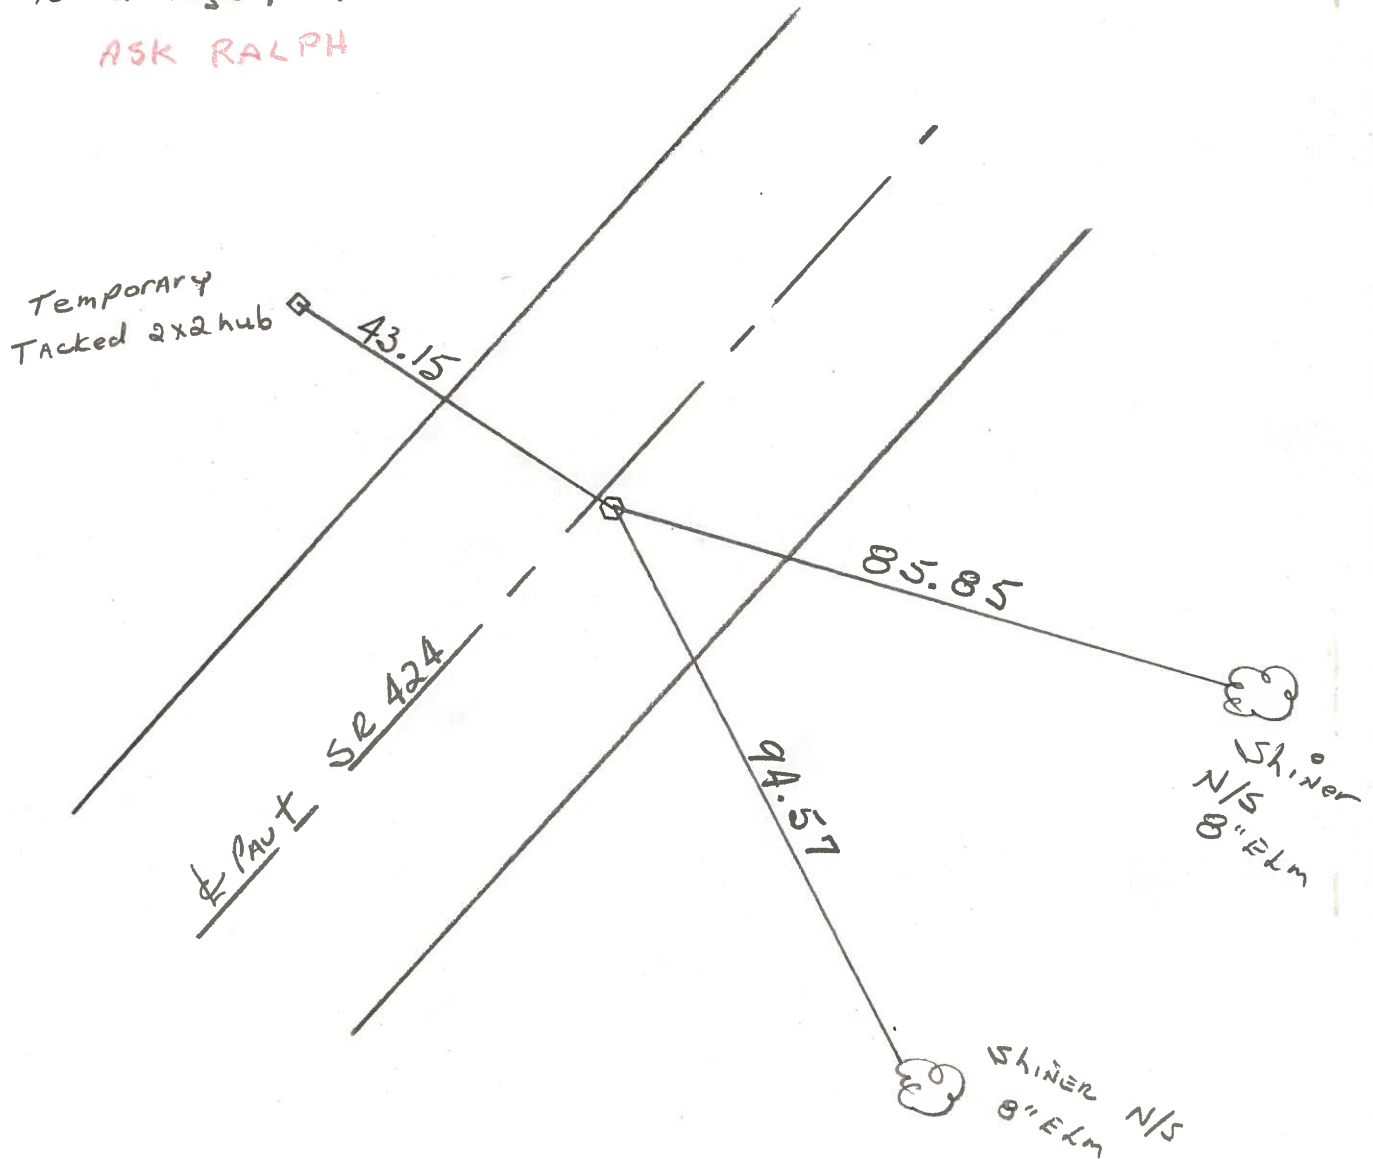

P.C. STA. 136 + 17.21 - REC.

PERSONNEL TITLE PERSONNEL TITLE COUNTY HENRY DATE May 28, 1974
Toinsic _____
Neuser _____
Granata _____
Vanyo _____
 S. R. 424 WEATHER cool
 SEC. _____ TEMP _____

DESCRIPTION LEFT CENTER LINE RIGHT JOB NO. _____

