


O.D.O.T. DISTRICT 2 SURVEY OFFICE (USE ONLY)


PERSONNEL	REFERENCE NO.	12-C	SHEET	15	OF	48
NOTES	HOMAN	DATE	03/07/12	ROUTE	SR 424	
H.C.	HOMAN	WEATHER	CLEAR	COUNTY	HENRY	
R.C.	ROUSOS	TEMP.	40°	TOWNSHIP	FLATROCK	
				SECTION	4	
				T	4	N
				R	6	E

TYPE MONUMENT 5/8" IRON ROD
~~ON SURFACE~~ - BELOW 3"
 LEFT - ~~C PAV'T~~ - RIGHT 15.5'
3.8 TO LT EDGE PAVEMENT
 S.L.M. 142+67

Grid: Northing: 610186.470 Easting: 1504181.127

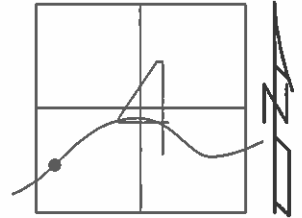

RECORD:
 P.I. STA. 142+62.89
 OK FD
 12/29/08
 #113
 REF16
 FD IRON ROD
 02/21/12, DCH

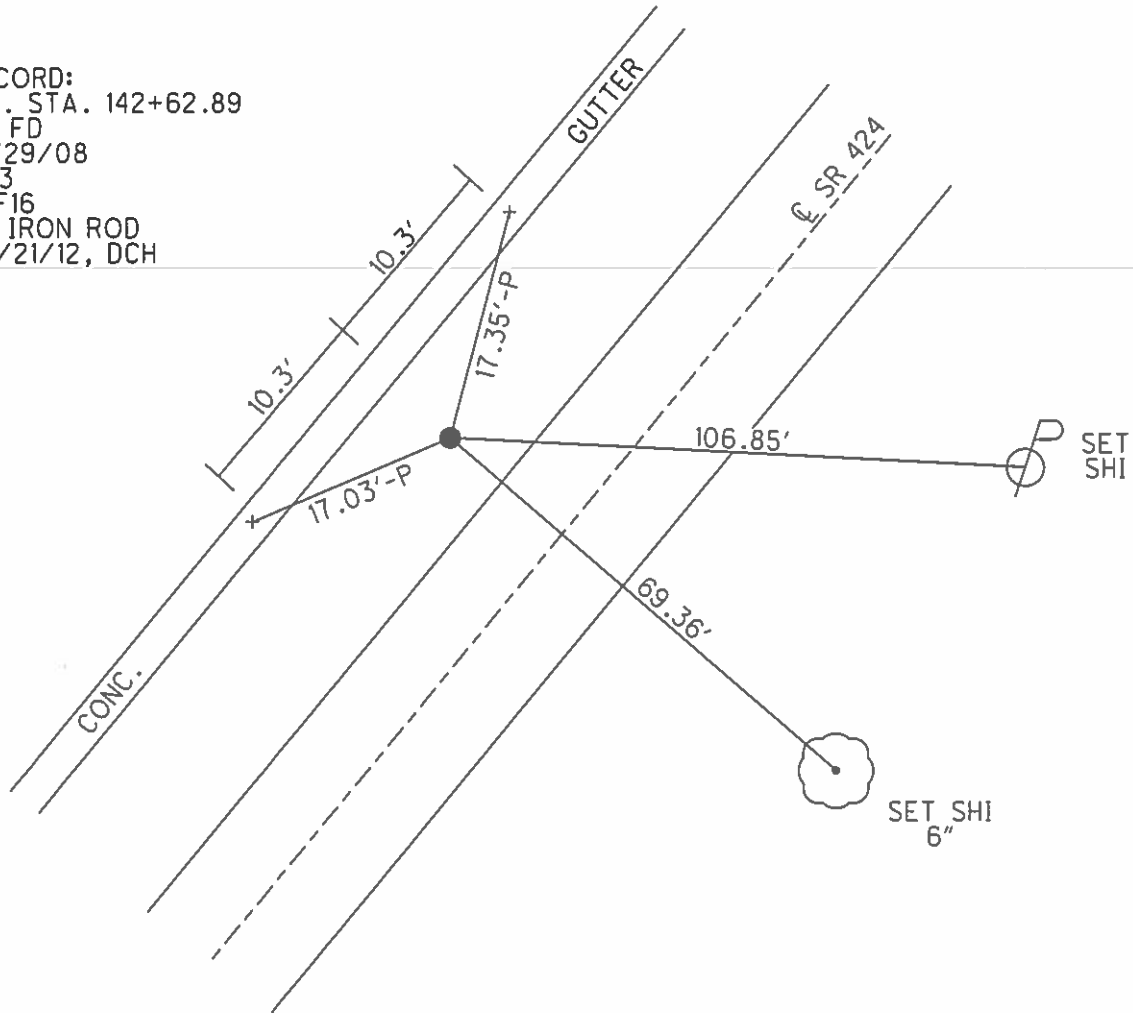

O.D.O.T. DISTRICT 2 SURVEY OFFICE

PERSONNEL

REFERENCE NO. 12-C

SHEET 15 OF 43

NOTES Hoffman

H.C. Loucks

R.C. Braunigel

DATE 4-3-91

WEATHER CLEAR

TEMP. 40°

ROUTE SR 424

COUNTY HENRY

TOWNSHIP FLATROCK

SECTION 4

T4 N R 6 E

TYPE MONUMENT 1/2" Iron Rod


ON SURFACE - BELOW 1"

LEFT- ϕ PAV'T. - RIGHT 15.5'


3.8 TO LT. EDGE PAVEMENT

S.L.M. 142+67

Painted \uparrow
5-23-91

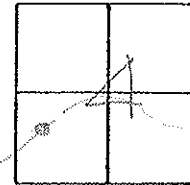

Records:
P.I. sta. 142+62.89

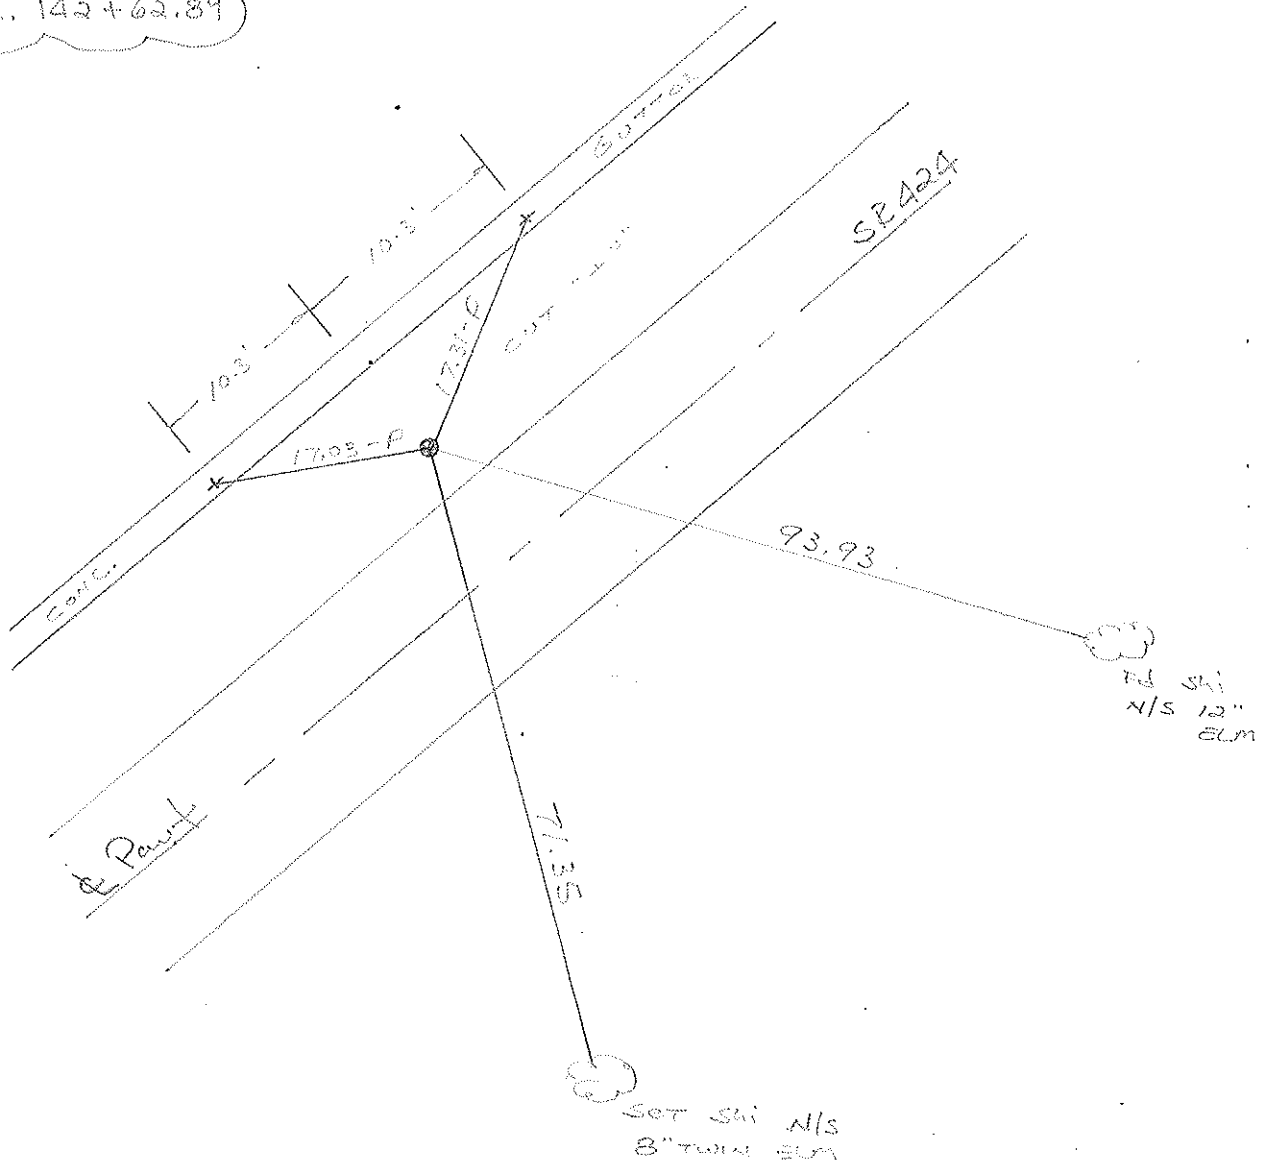

OK
10-19-81
S.W.H.

County HENRY S.R. 424

Date 6-17-81

Township FLAT ROCK

Weather Clear

Section 4


Temp. +80°

T4N, R4E

Personnel Hoffman


Householder

#12-C

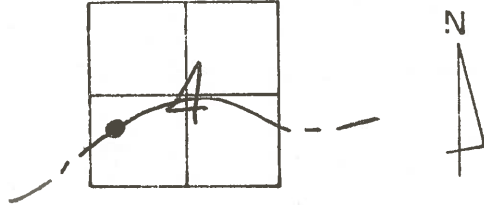

Fd. 1/2" IRON ROD 1" Below Surface
15.2' N. of & PAUT, SE 424

Project STA 142+72

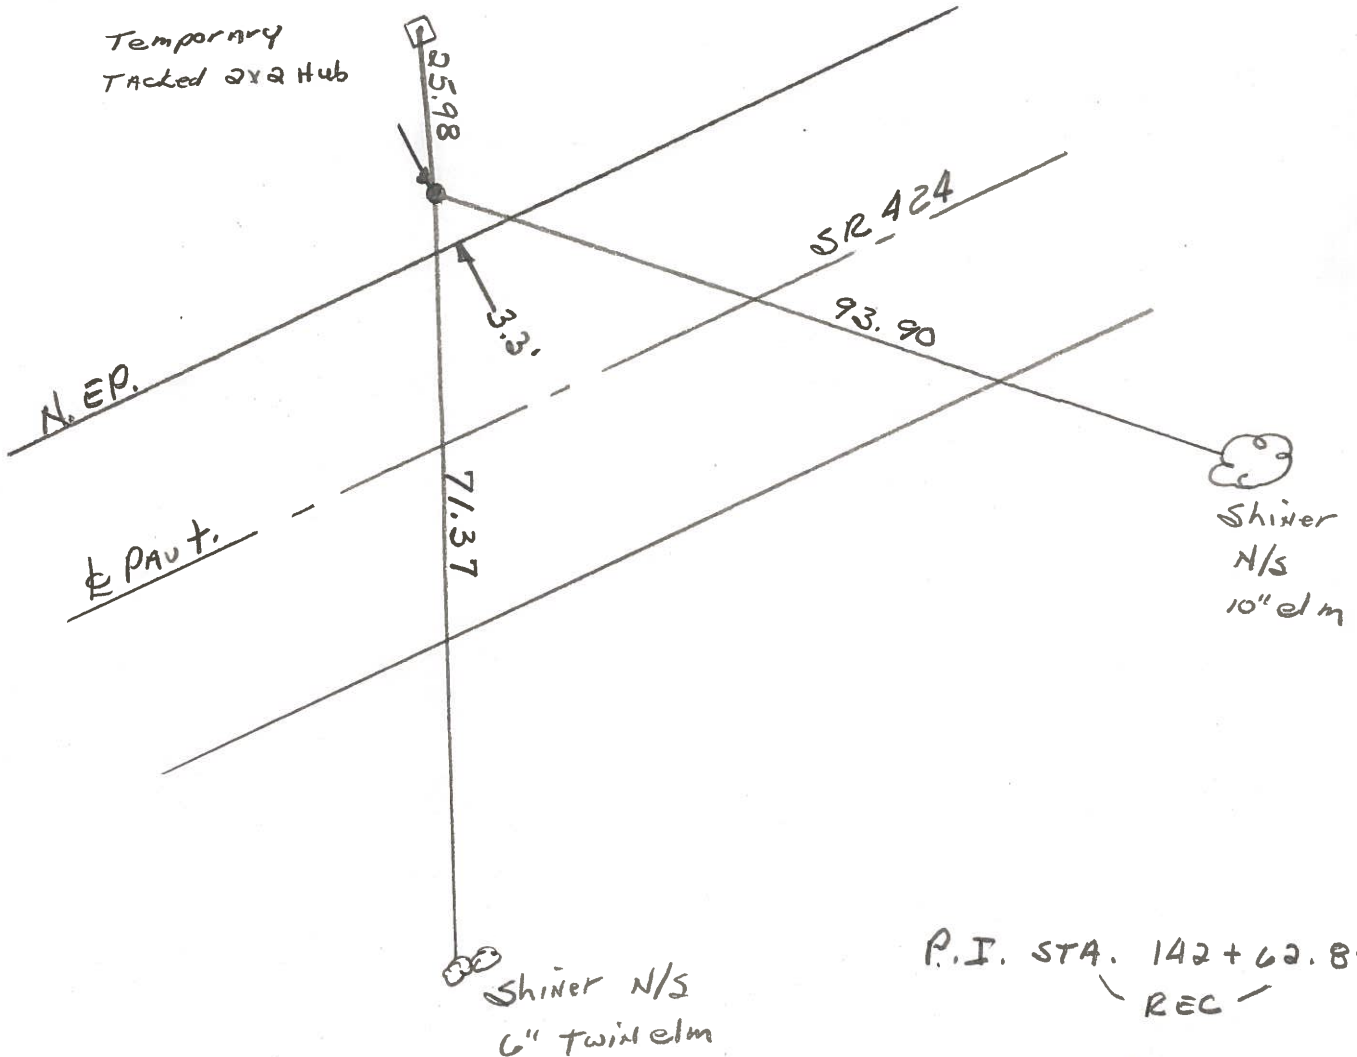

P.I. STA. 142+62.89
REC

PERSONNEL	TITLE	PERSONNEL	TITLE
<u>Tomic</u>			
<u>Wesser</u>			
<u>Janyo</u>			
<u>Granata</u>			

COUNTY HEARST DATE JUNE 12, 1974
 S. R. 424 WEATHER _____
 SEC. _____ TEMP. _____

DESCRIPTION _____ LEFT _____ CENTER LINE _____ RIGHT _____ JOB NO. _____

