



O.D.O.T. DISTRICT 2 SURVEY OFFICE (USE ONLY)

PERSONNEL _____ REFERENCE NO. 12-G SHEET 19 OF 48
 NOTES HOMAN DATE 03/07/12 ROUTE SR 424
 H.C. HOMAN WEATHER CLEAR COUNTY HENRY
 R.C. ROUSOS TEMP. 40° TOWNSHIP FLATROCK
 _____ SECTION 3
 _____ T 4 N R 6 E

TYPE MONUMENT 1/2" IRON ROD
~~ON SURFACE~~ - BELOW 3"
~~LEFT - C PAV'T~~ - RIGHT 19.8'
7.3 TO RT EDGE PAVEMENT
 S.L.M. 211+23
 Grid: Northing: 610930.152 Easting: 1510605.723

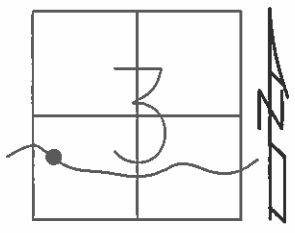

RECORD:
 P.I. STA. 211+51.85
 OK FD
 12/29/08
 #117
 REF20
 FD 5/8" IPIN
 02/21/12, DCH

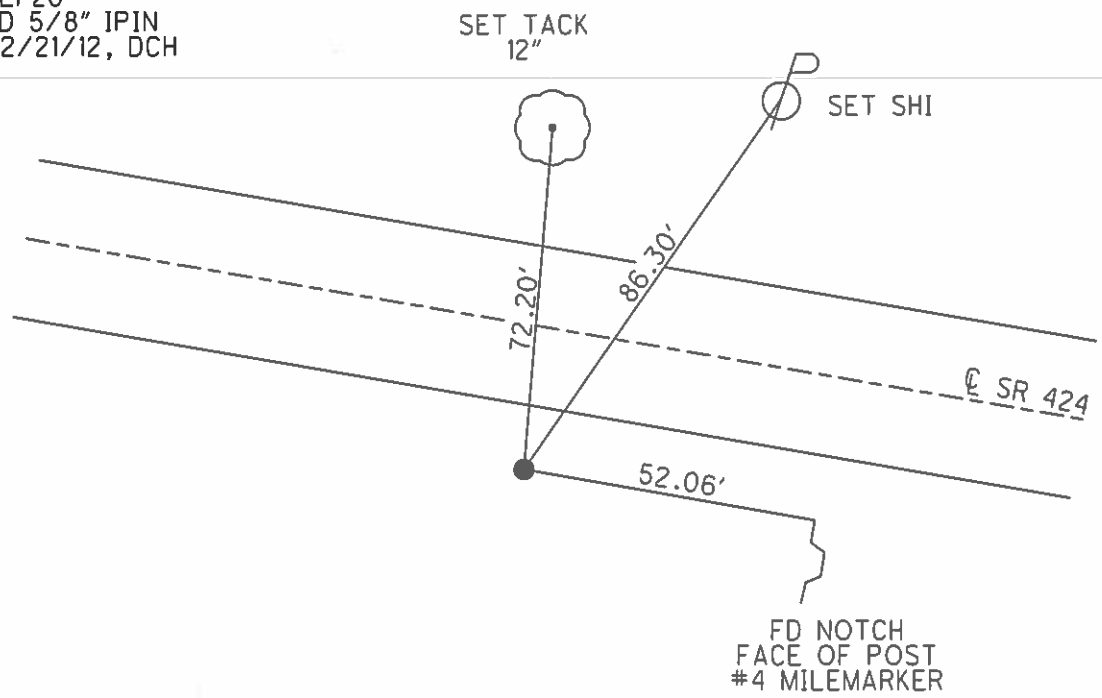

O.D.O.T. DISTRICT 2 SURVEY OFFICE

PERSONNEL

REFERENCE NO. 12-G

SHEET 19 OF 43

NOTES HOFFMAN

H.C. LOENNER

DATE 4-3-91

ROUTE SR 424

R.C. RAKINISAL

WEATHER CLEAR

COUNTY HENRY

TEMP. 40°

TOWNSHIP FLATROCK

SECTION 3

T4 N R 6 E

TYPE MONUMENT 1/8" IRON ROD


PAINTED ↑
5-23-91

ON SURFACE - BELOW 3"

LEFT - CL PAV'T. - RIGHT 19.8'


7.3 TO RT EDGE PAVEMENT

S.L.M. 211+23

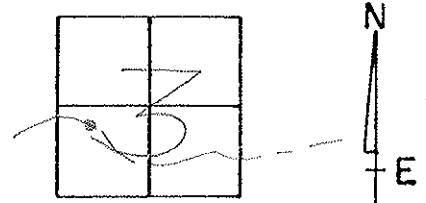

RECORD:

P.I. sta. 211+51.85

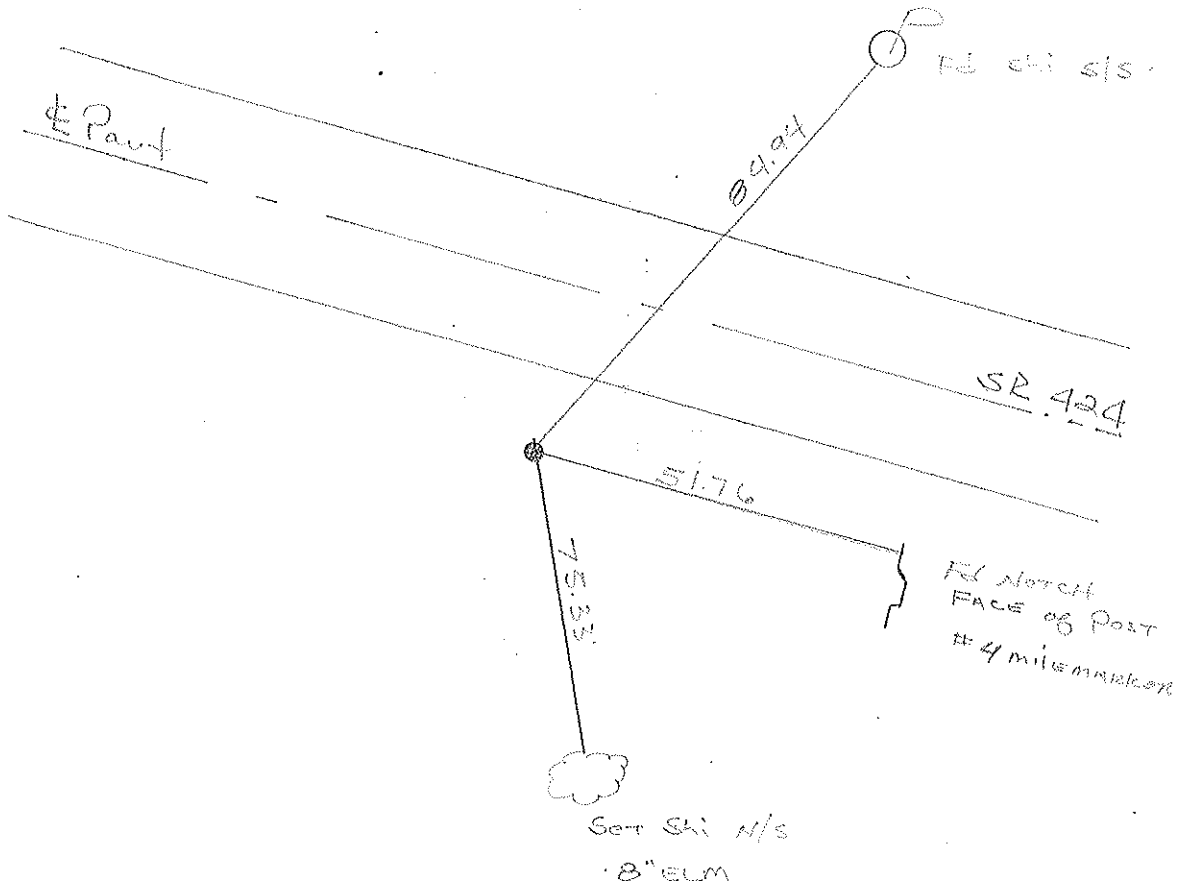

County HENRY S.R. 424

Township FLATROCK

Section 3


T4N, R6E

Personnel Hoffman
Householder

Date 6-17-81

Weather clear

Temp. +80°

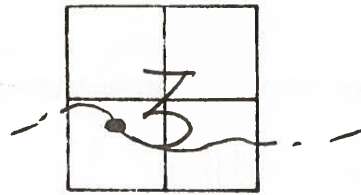

3-29-83
+300


12-6

Fd. 1/2" Iron Rod 3" below Surface

SLM 211+65 ✓


P.I. STA. 211+51.85 - REC

19.2' Rt of & PAUT.

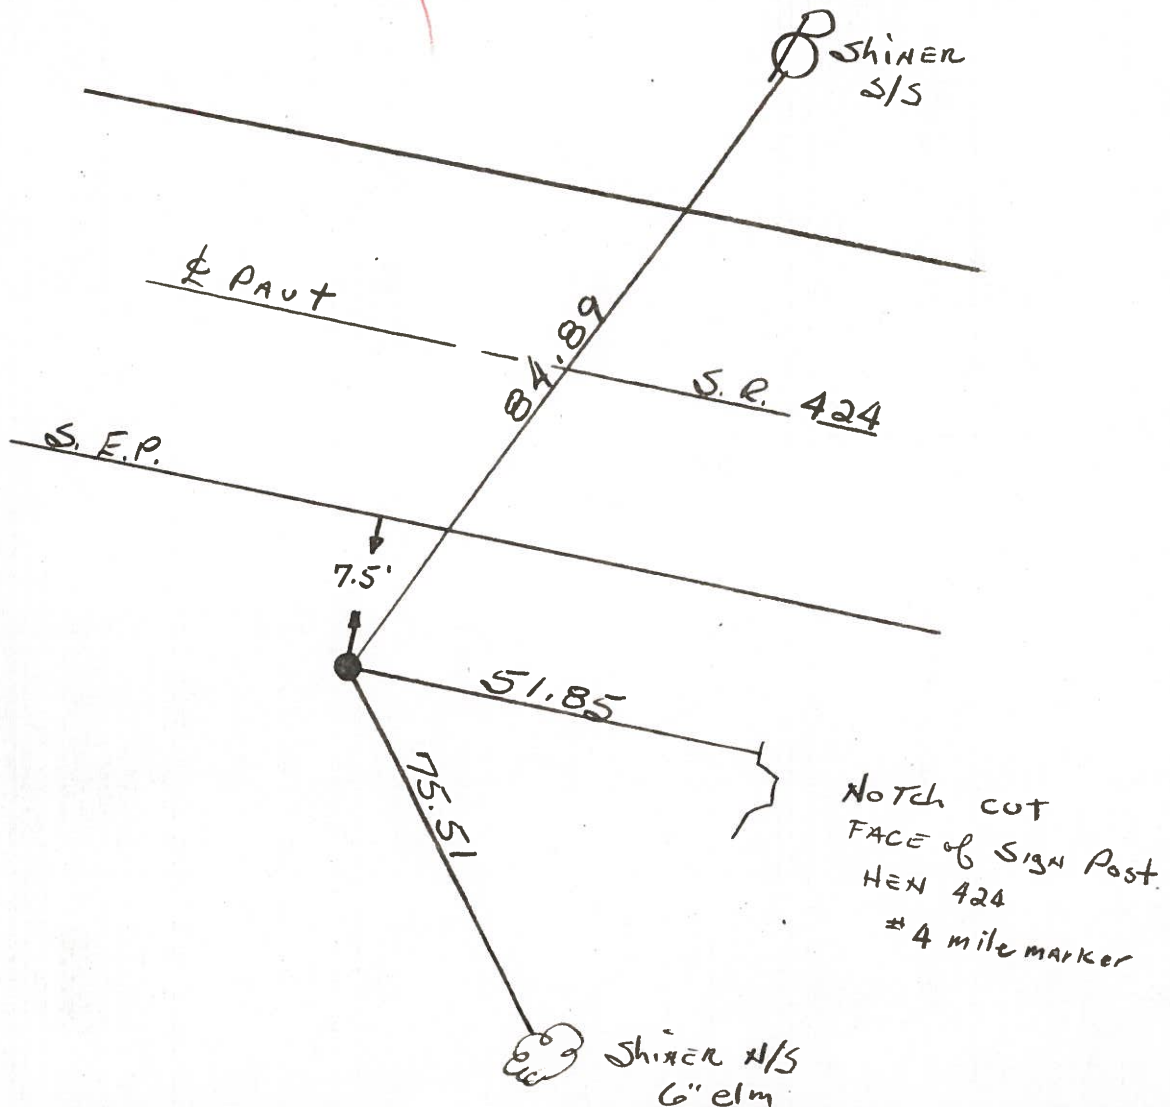

PERSONNEL	TITLE	PERSONNEL	TITLE	COUNTY	DATE
Tomasic				HELDY	JUNE 12, 1974
Weiser				S. R. 424	WEATHER _____
Vandy				SEC. _____	TEMP. _____
Grants					

DESCRIPTION _____ LEFT _____ CENTER LINE _____ RIGHT _____ JOB NO. _____

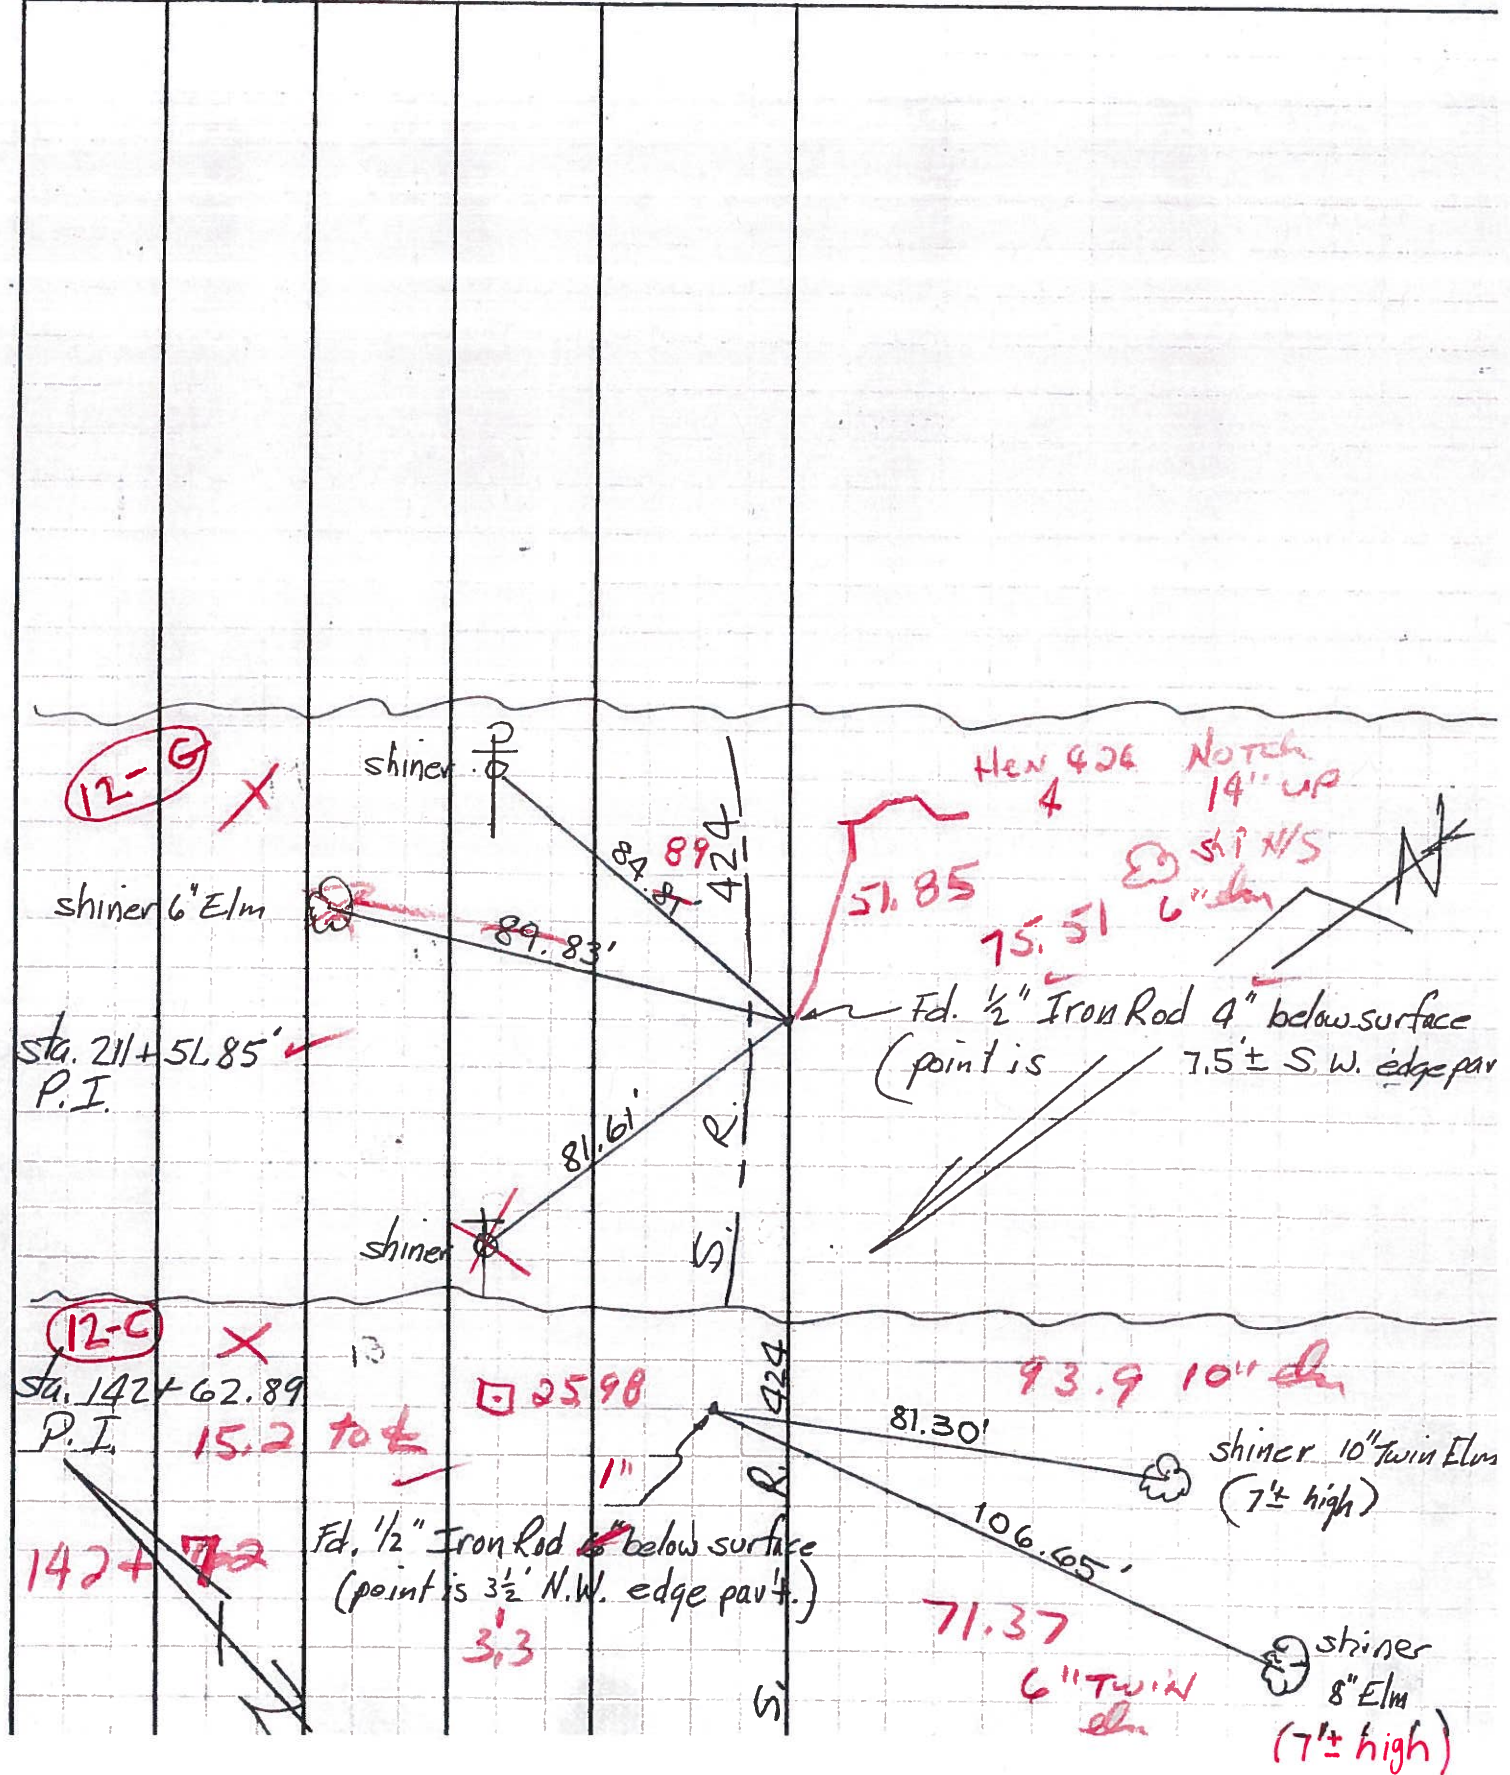

PERSONNEL TITLE PERSONNEL TITLE COUNTY Henry DATE 4- -6
 Hoover _____ Hoff _____ S. R. U.S. R. 24 WEATHER Clear
 Delventhal _____ SEC. _____ TEMP. _____
 DESCRIPTION Witnesses to Control Points (P.I. &) JOB NO. _____

