



O.D.O.T. DISTRICT 2 SURVEY OFFICE (USE ONLY)

PERSONNEL _____ REFERENCE NO. 12-H SHEET 21 OF 48
 NOTES HOMAN DATE 03/07/12 ROUTE SR 424
 H.C. HOMAN WEATHER CLEAR COUNTY HENRY
 R.C. ROUSOS TEMP. 45° TOWNSHIP FLATROCK
 _____ SECTION 3
 _____ T 4 N R 6 E

TYPE MONUMENT _____ PK _____
 ON SURFACE - ~~BELOW~~ _____ ON _____
~~LEFT~~ - ~~C PAV'T~~ - RIGHT _____ 3.4 _____
9.1 TO RT EDGE PAVEMENT
 S.L.M. _____ 229+39 _____
 Grid: Northing: 610708.612 Easting: 1512403.912

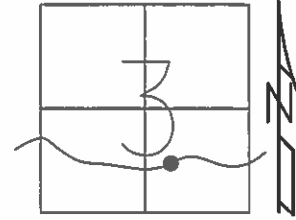

RECORD:
 P.I. STA. 229+70.50
 OK FD
 12/29/08
 #119
 REF 22
 FD PK
 02/21/12, DCH

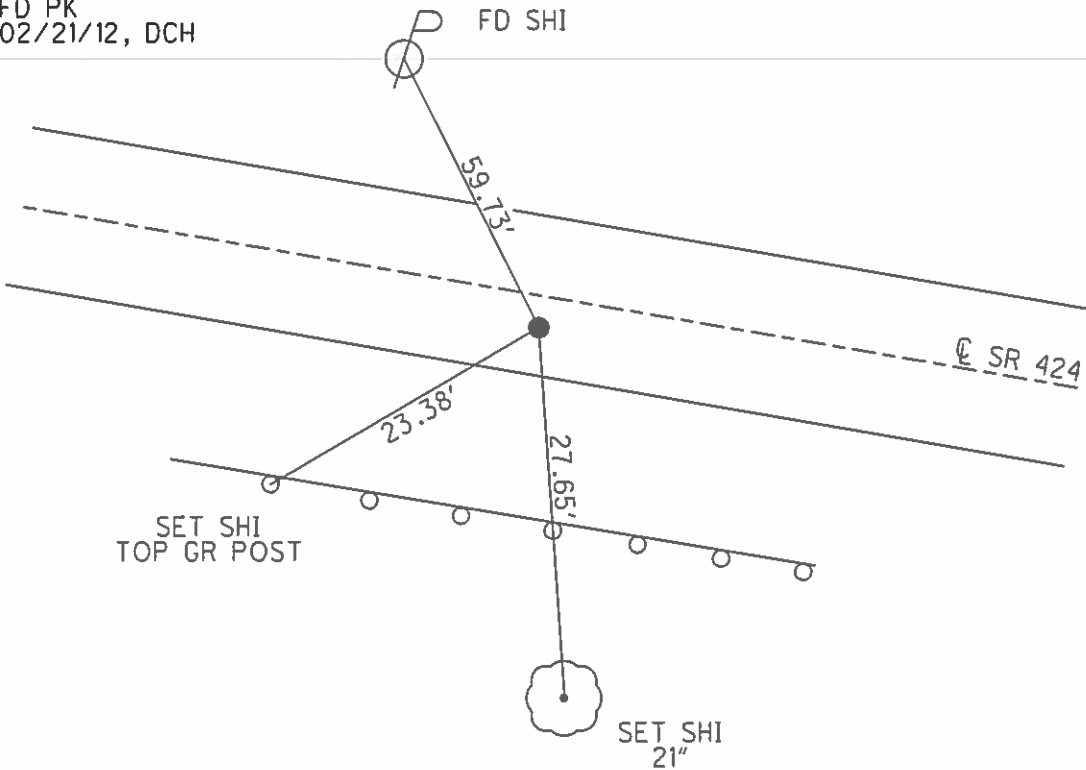

O.D.O.T. DISTRICT 2 SURVEY OFFICE

PERSONNEL

REFERENCE NO. 12-H

SHEET 21 OF 43

NOTES Hoffman

H.C. LOURCO

R.C. BARONCEL

DATE 4-3-91

WEATHER CLEAR

TEMP. 40°

ROUTE SR 424

COUNTY HENRY

TOWNSHIP FLATROCK

SECTION 3

T4 N R 6 E

Set P.K./WASHER

5-23-91

C.L.



TYPE MONUMENT SHANK of P.K.

ON SURFACE - BELOW YES

LEFT- C PAV'T. - RIGHT 3.4'


91 TO RT EDGE PAVEMENT

S.L.M. 229+39

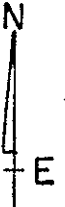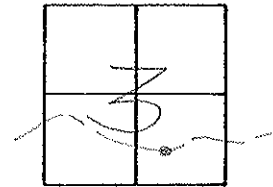

RECORD:

P.I. Sta, 229+70.50

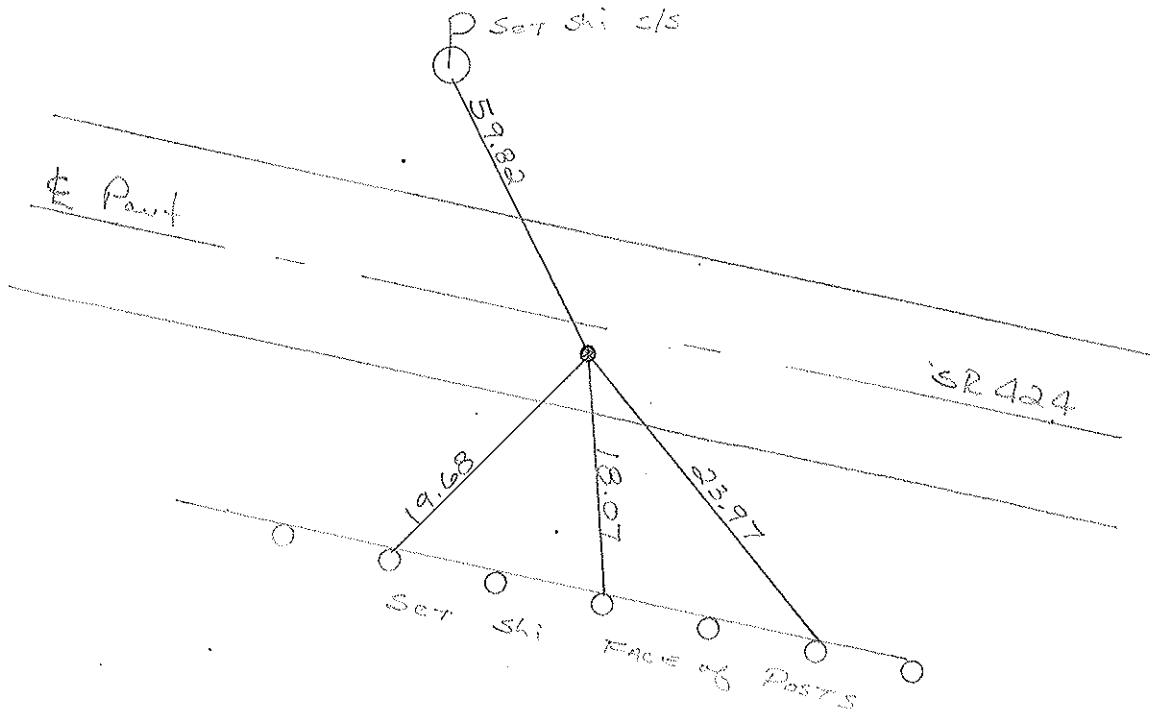

County HENRY S.R. 424

Township FLAT ROCK

Section 3


T4N, R6E

Personnel Hoffman
Householder

Date 6-18-81

Weather Clear

Temp. +80°

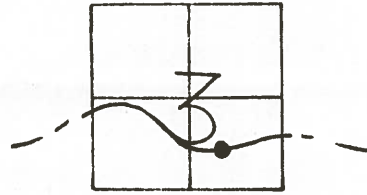

3-29-83


+30°

12-H

Fd. R.R. SPK. @ SURFACE
3.0' Rt. of & PAUT. SR424
8.5' to S. Edge PAUT.
15.5' to N. Edge PAUT.

SLM 229+82

SET PK/WASHER
5-25-83
SWH

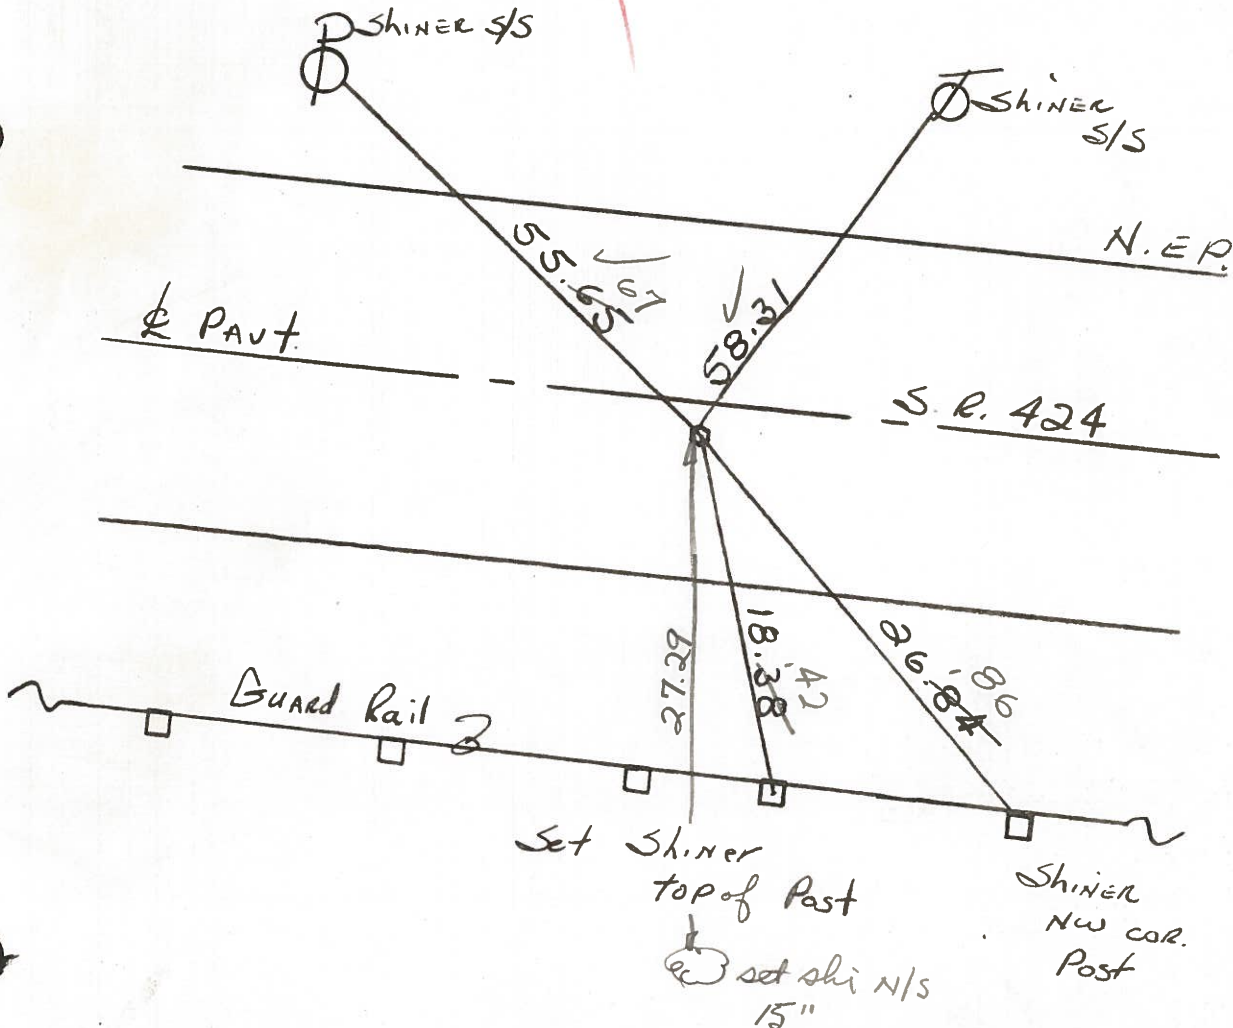


P.I. STA. 229+70.50-REC.

PERSONNEL	TITLE	PERSONNEL	TITLE
Tomasic			
Granata			
Vanyo			

COUNTY HENRY DATE MAY 29, 1974
 S. R. 424 WEATHER _____
 SEC. _____ TEMP. _____

DESCRIPTION _____ LEFT _____ CENTER LINE _____ RIGHT _____ JOB NO. _____

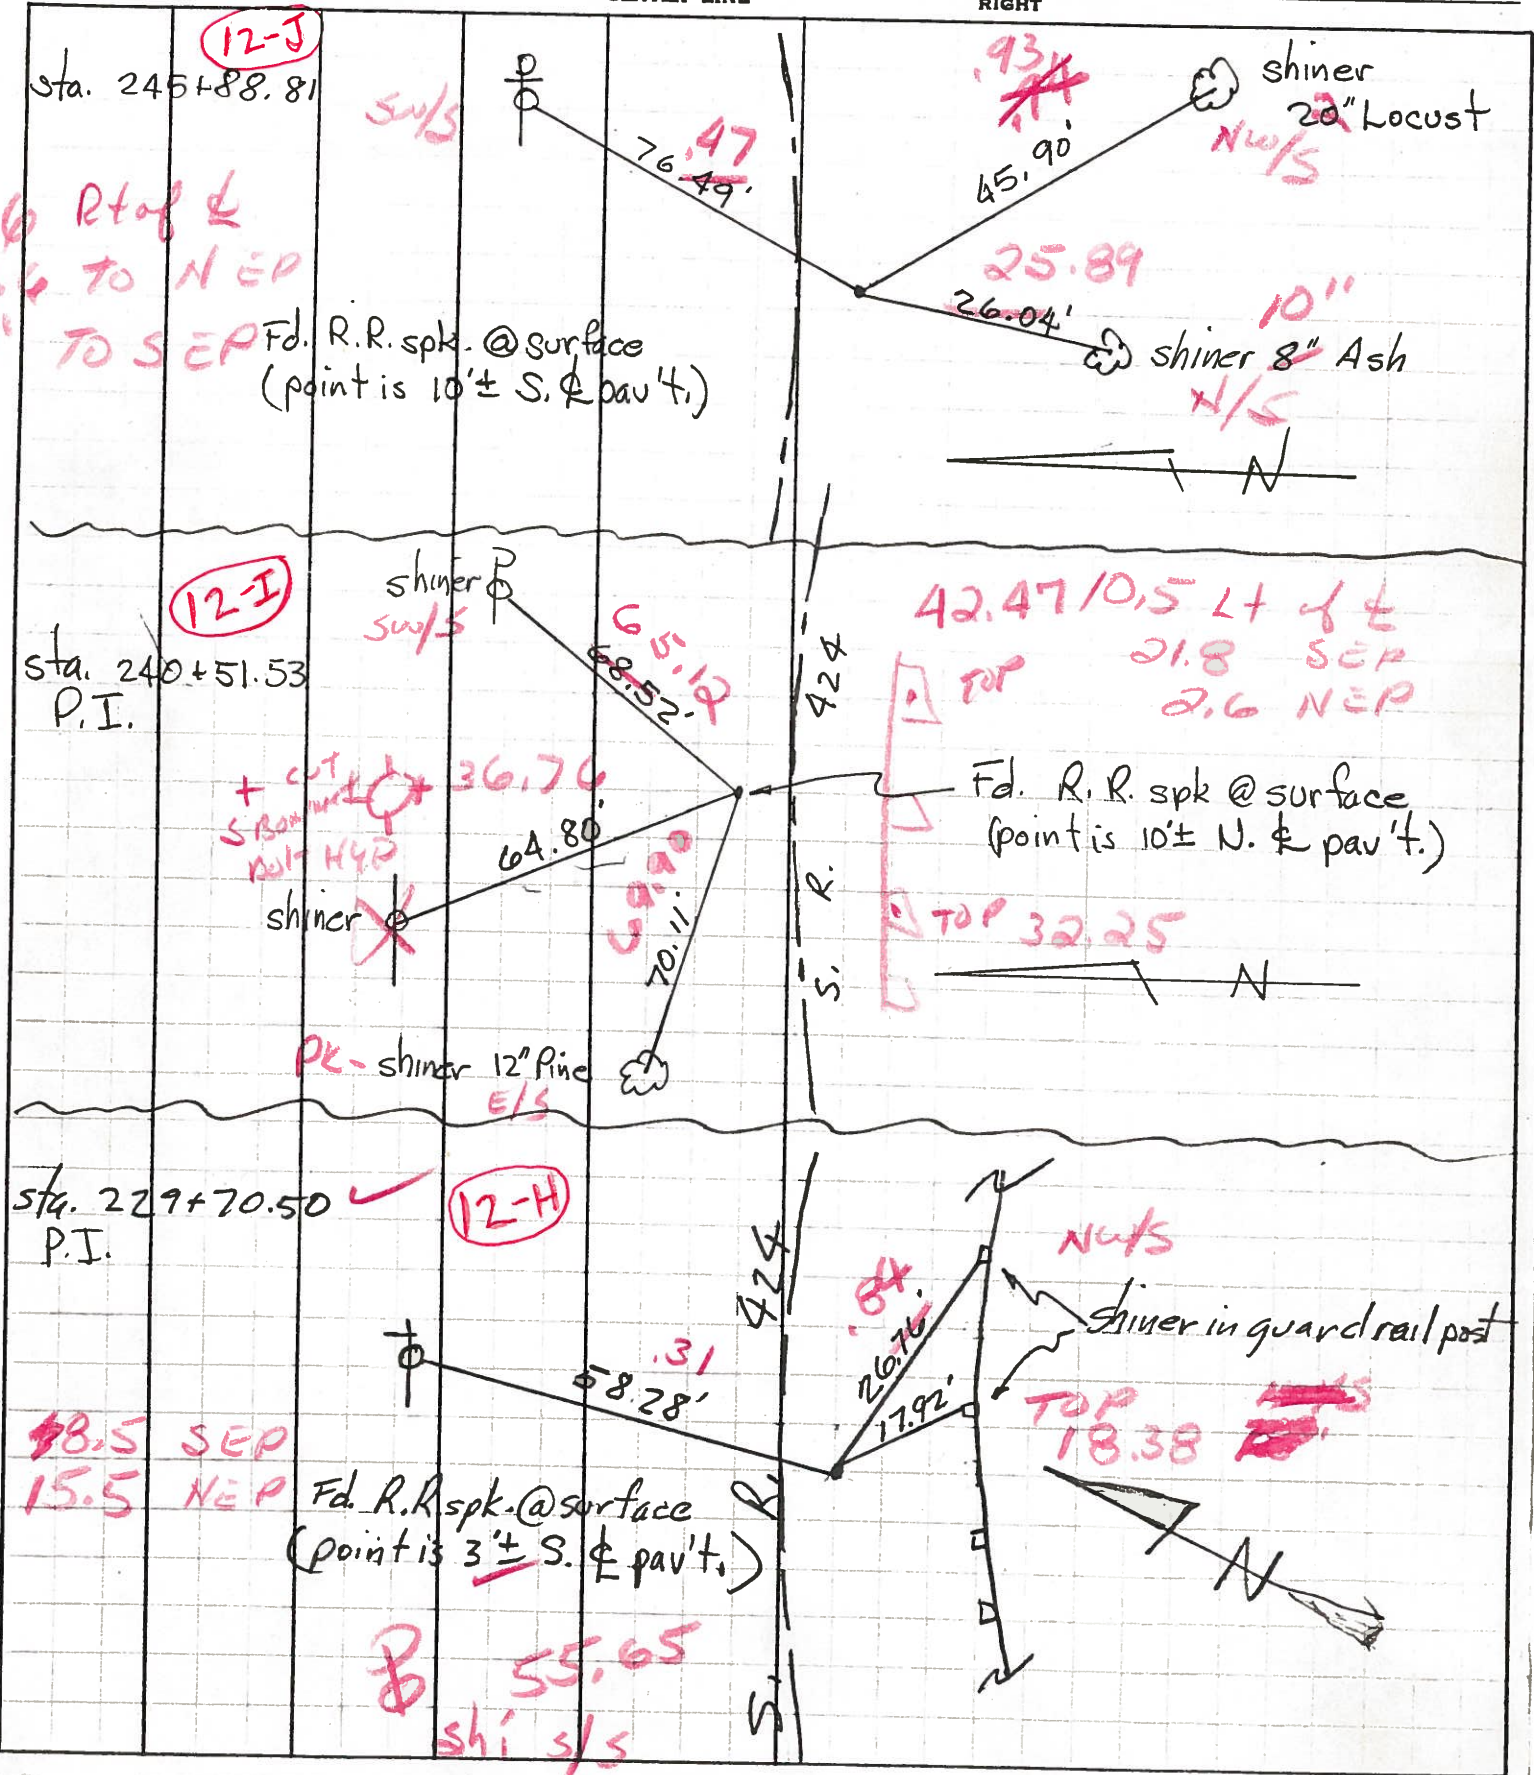

PERSONNEL TITLE PERSONNEL TITLE COUNTY Henry DATE 4- -6
Hoover _____ Hoff _____ S. R. U.S. R. 24 WEATHER Clear
Delventhal _____ SEC. _____ TEMP. _____
 DESCRIPTION Witnesses to Control Points (P.I. &) JOB NO. _____

