



O.D.O.T. DISTRICT 2 SURVEY OFFICE (USE ONLY)

PERSONNEL _____ REFERENCE NO. 12-1 SHEET 22 OF 48
 NOTES HOMAN DATE 03/07/12 ROUTE SR 424
 H.C. HOMAN WEATHER CLEAR COUNTY HENRY
 R.C. ROUSOS TEMP. 45° TOWNSHIP FLATROCK
 _____ SECTION 3
 _____ T 4 N R 6 E

TYPE MONUMENT _____ PK/WASHER _____
 ON SURFACE - ~~BELOW~~ _____ ON _____
 LEFT - ~~C PAV'T~~ - RIGHT _____ 11.0' _____
0.7 TO LT. EDGE PAVEMENT
 S.L.M. _____ 240+18
 Grid: Northing: 610810.190 Easting: 1513460.916

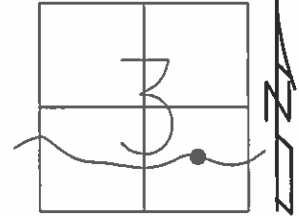

RECORD:
 P.I. STA. 240+51.33
 OK FD
 12/29/08
 #120
 REF23
 FD PK
 02/21/12 DCH

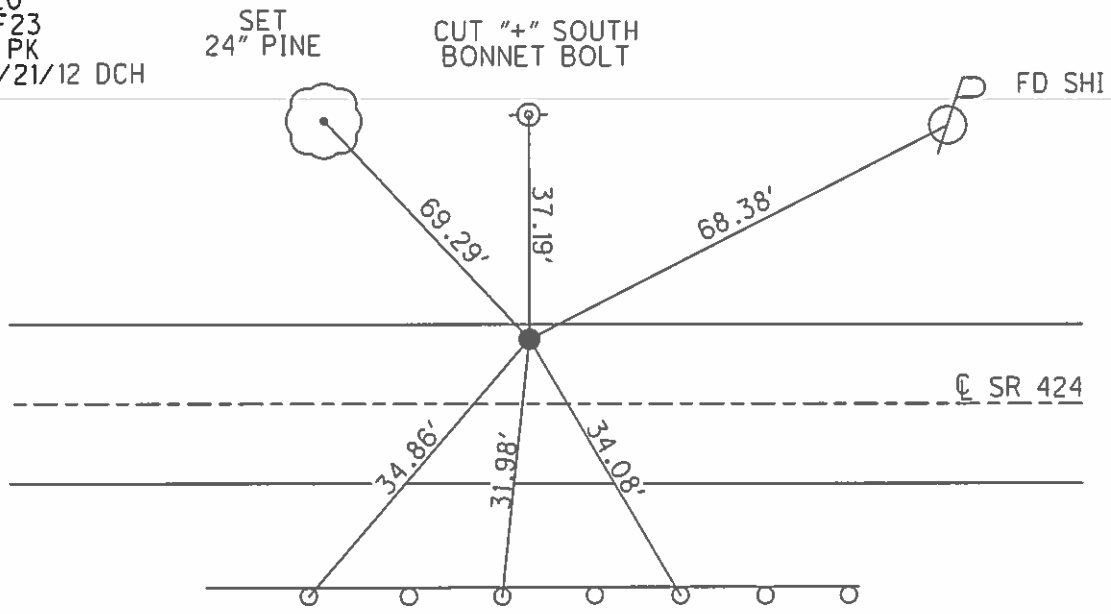

O.D.O.T. DISTRICT 2 SURVEY OFFICE

PERSONNEL

REFERENCE NO. 12-I

SHEET 22 OF 43

NOTES HOFFMAN

H.C. LOEHLKE

R.C. BARNHISEL

DATE 4-3-91

WEATHER CLEAR

TEMP. 40°

ROUTE SR 424

COUNTY HENRY

TOWNSHIP FLATROCK

SECTION 3

Set P.K./WASHER
6-23-91
C.L.

T4 N R 6 E


TYPE MONUMENT P.K./WASHER

ON SURFACE - BELOW YES


LEFT - ☉ PAV'T. - RIGHT 11.0'

0.7 TO LT. EDGE PAVEMENT

S.L.M. 240+18

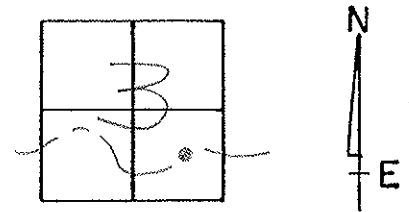

RECORD!
P.I. sta. 240+51.33

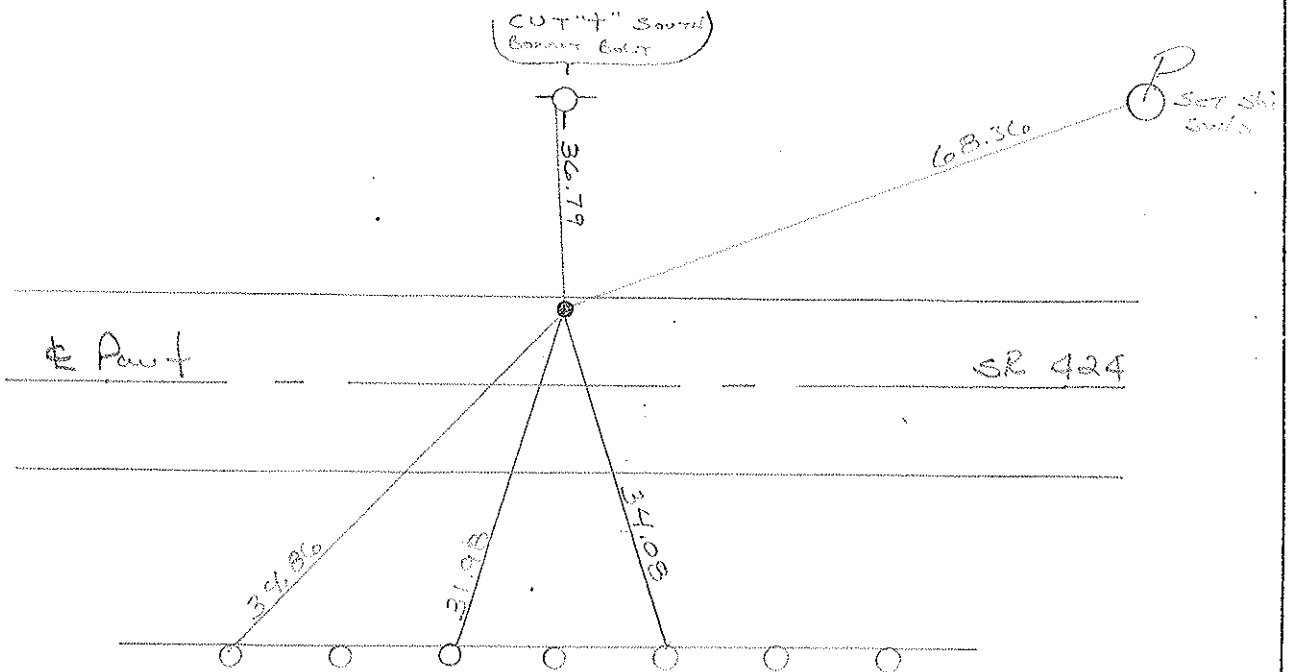

County HENRY S.R. 424

Date 6-18-81

Township FLAT ROCK

Weather Clear

Section 3


Temp. + 80°

T4N, R6E

Personnel Hoffman

Householder

12-1

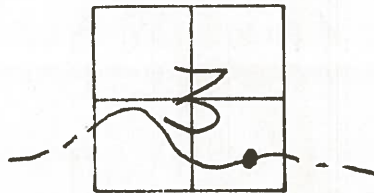

3-29-83

+30°

Fd. R. E. SPK @ SURFACE

SLM 240+60


10.5' Lt. of ♀ PAUT. S.R. 424

Set PK./WASHER

2.6' to N. Edge PAUT.

5-25-83 SWN

21.8' to S. Edge PAUT.

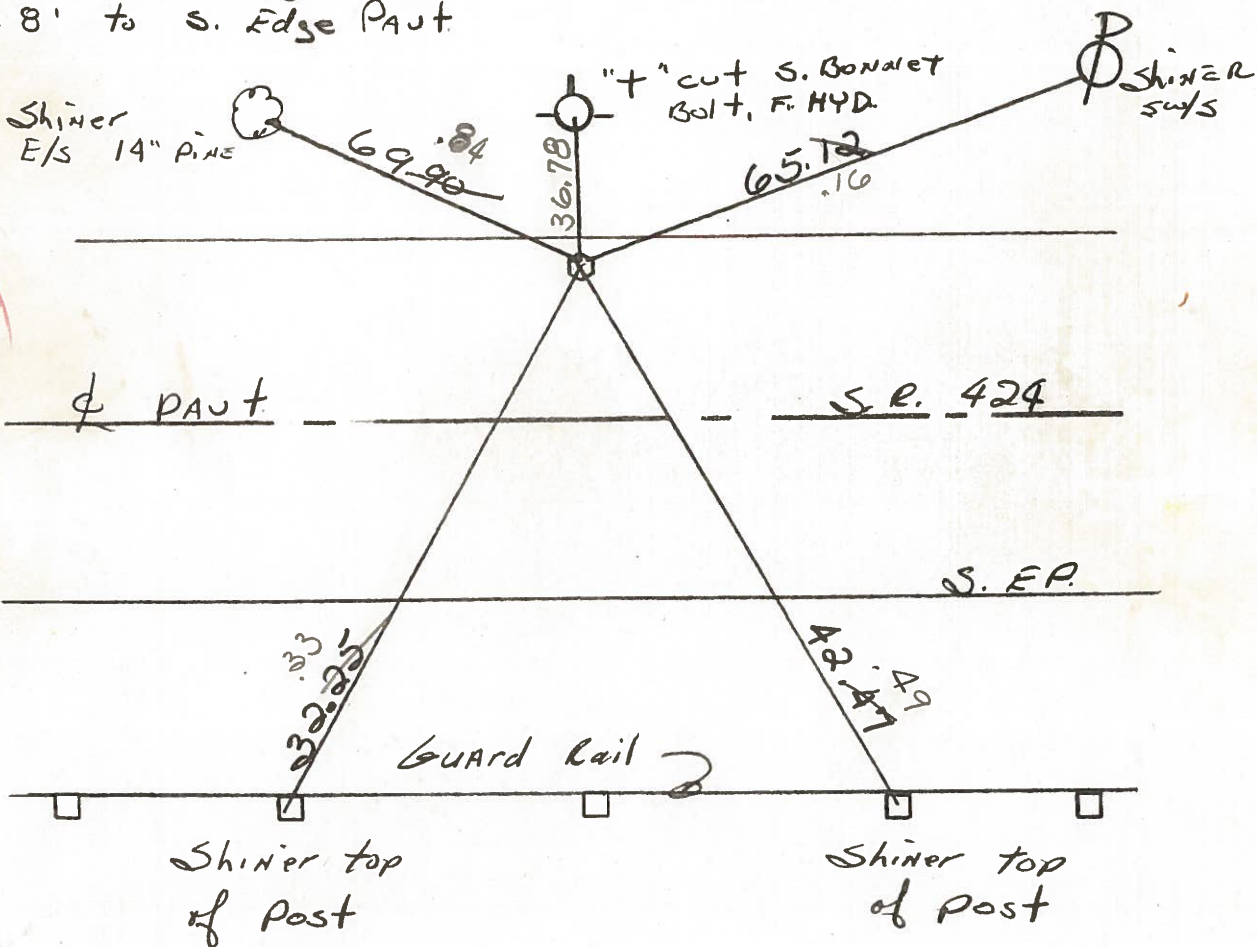

P.I. STA. 240+51.33 - REC.

PERSONNEL TITLE PERSONNEL TITLE

SHEET NO. 1

Terrisic
Granata
Vanyo

COUNTY HENRY DATE MAY 29, 1974

S. R. 424 WEATHER

SEC. TEMP.

DESCRIPTION LEFT CENTER LINE RIGHT JOB NO.

