



O.D.O.T. DISTRICT 2 SURVEY OFFICE (USE ONLY)

PERSONNEL _____ REFERENCE NO. 15 SHEET 26 OF 48
 NOTES HOMAN DATE 03/07/12 ROUTE SR 424
 H.C. HOMAN WEATHER CLEAR COUNTY HENRY
 R.C. ROUSOS TEMP. 55° TOWNSHIP FLATROCK
 _____ SECTION 11
 _____ T 4 N R 6 E

TYPE MONUMENT _____ PK/WASHER _____
 ON SURFACE - ~~BELOW~~ _____ ON _____
~~LEFT - C-PAVT~~ - RIGHT 14.0
2.2' TO RT. EDGE PAVEMENT
 S.L.M. 279+36
 Grid: Northing: 613057.743 Easting: 1516228.332

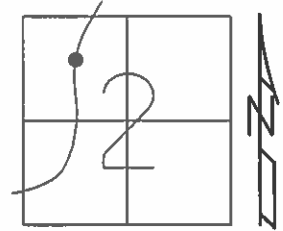

RECORD:
 P.I. STA. 279+66.32
 FD "+" CUT IN OLD CONC. PAVT.
 8" BELOW BERM. PLACED LARGE
 FLAT WASHER OVER "+".
 3-29-83
 OK FD
 12/29/08
 #124
 REF27
 FD PK
 02/21/12

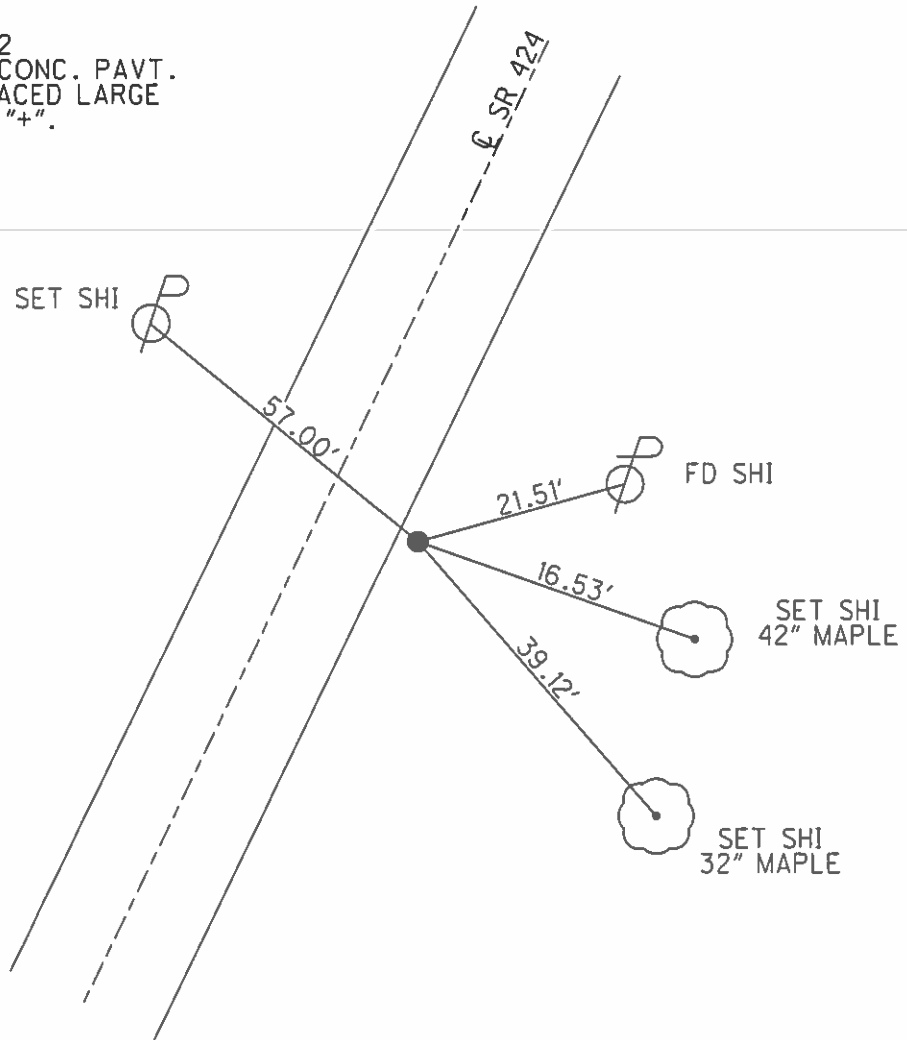

O.D.O.T. DISTRICT 2 SURVEY OFFICE

PERSONNEL _____

REFERENCE NO. 15

SHEET 26 OF 43

NOTES HOFFMAN

M.C. LOUNGER

R.C. BARONICAL

DATE 4.3-91

WEATHER CCLEAR

TEMP. 40°

ROUTE SR 424

COUNTY HENRY

TOWNSHIP FLATROCK

SECTION 2

T4 N R 6 E

Set P.K. / WASHER
in PAVED BERM
5-23-91
C.L.


TYPE MONUMENT P.K. / WASHER

ON SURFACE - BELOW YES

LEFT - C PAV'T. - RIGHT 14.0

2.2' TO RT EDGE PAVEMENT

S.L.M. 279+36

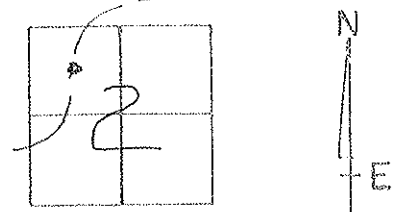


Record:

P.I. sta. 279+66.32

Fd. "4" CUT IN OLD CONCR. PAVT.
8" BELOW BERM, PLACED LARGE
FLAT WASHER OVER "4"
3-27-83

Set ski
sets

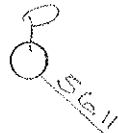

SR 424

21.59



Set ski
sets

15.37



Set ski w/s
36" maple

26.89




Set ski w/s
24" maple

32.53



Set ski w/s
36" tulip maple

C Pavt

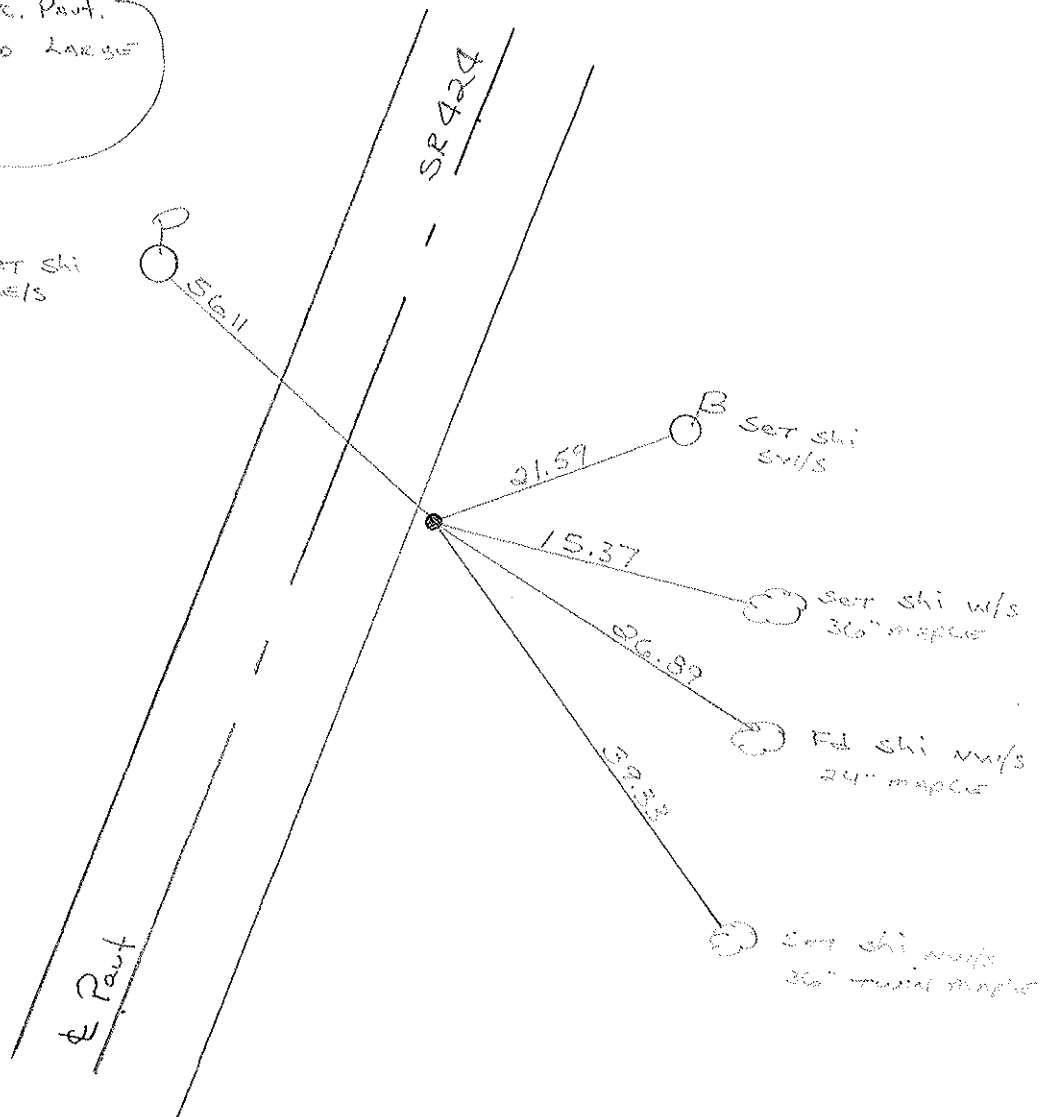

OD.O.T. DISTRICT 2 SURVEY OFFICE

SHEET _____ OF _____

County HENRY S.R. 424

Date MARCH 29, 83

Township FLAT ROCK

Weather P. CLEAR

Section 2

Temp. +30°


T4N, R6E

Personnel HOFFMAN

+

CREW

(15)

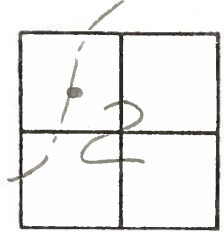

Fd "+" cut in OLD CONC. ROAD SURFACE

8" below BERM SURFACE

13.2' RT of & Paut

1.5' RT of RT Edge Paut

PLACED LARGE FLAT WASHER
OVER "+"; PAINTED yellow, COVERED
WITH BERM CHIP STONE & THEN COVERED
WITH DIRT.


S.L.M. 279+79

Record:

P.I. 279+66.32


Set P.K./washer
5-31-83 SW

Set New
Shi 2 1/2' up
E/S

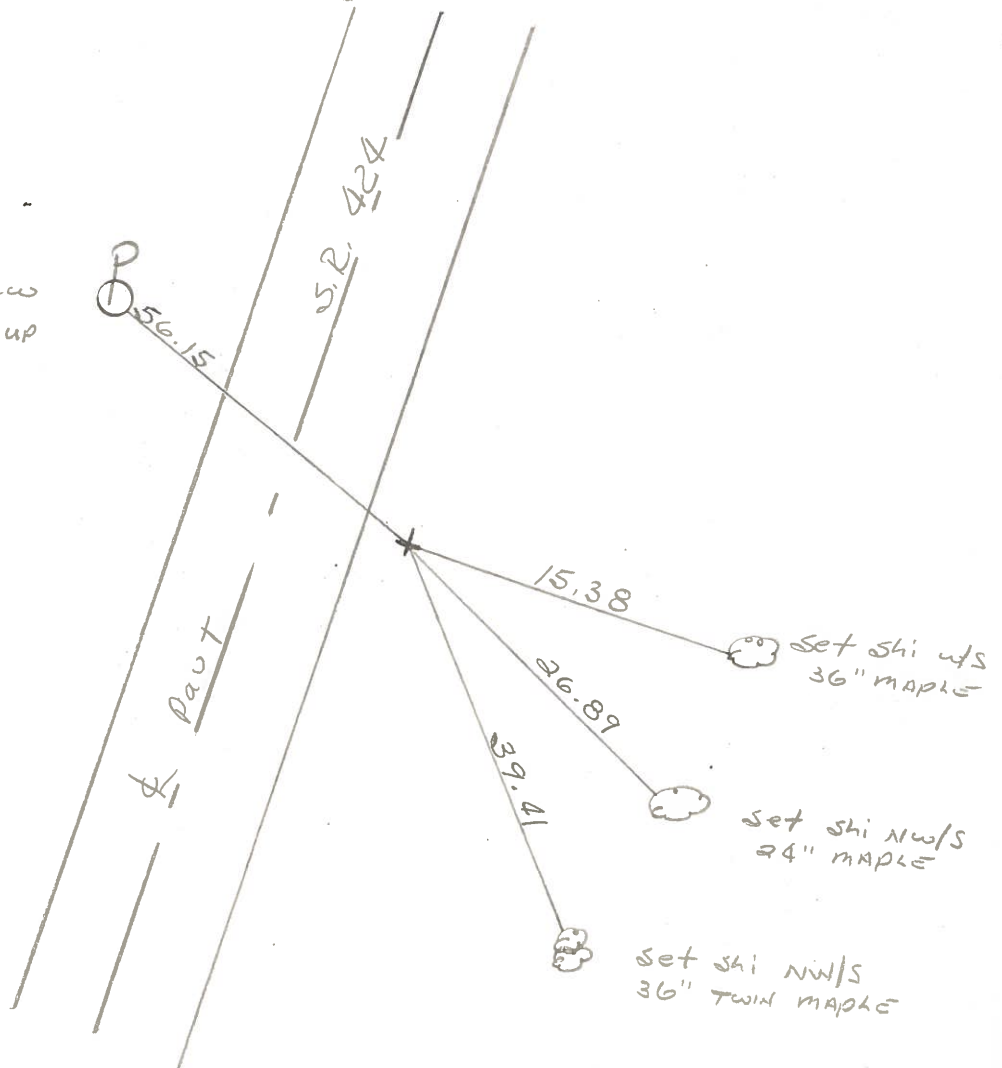

PERSONNEL - TITLE PERSONNEL TITLE COUNTY HENRY DATE JUNE 24, 1977
 Tomsic _____
 Vuyo _____ S. R. 424 WEATHER _____
 Grusta _____ SEC. _____ TEMP. _____

DESCRIPTION LEFT CENTER LINE RIGHT JOB NO.

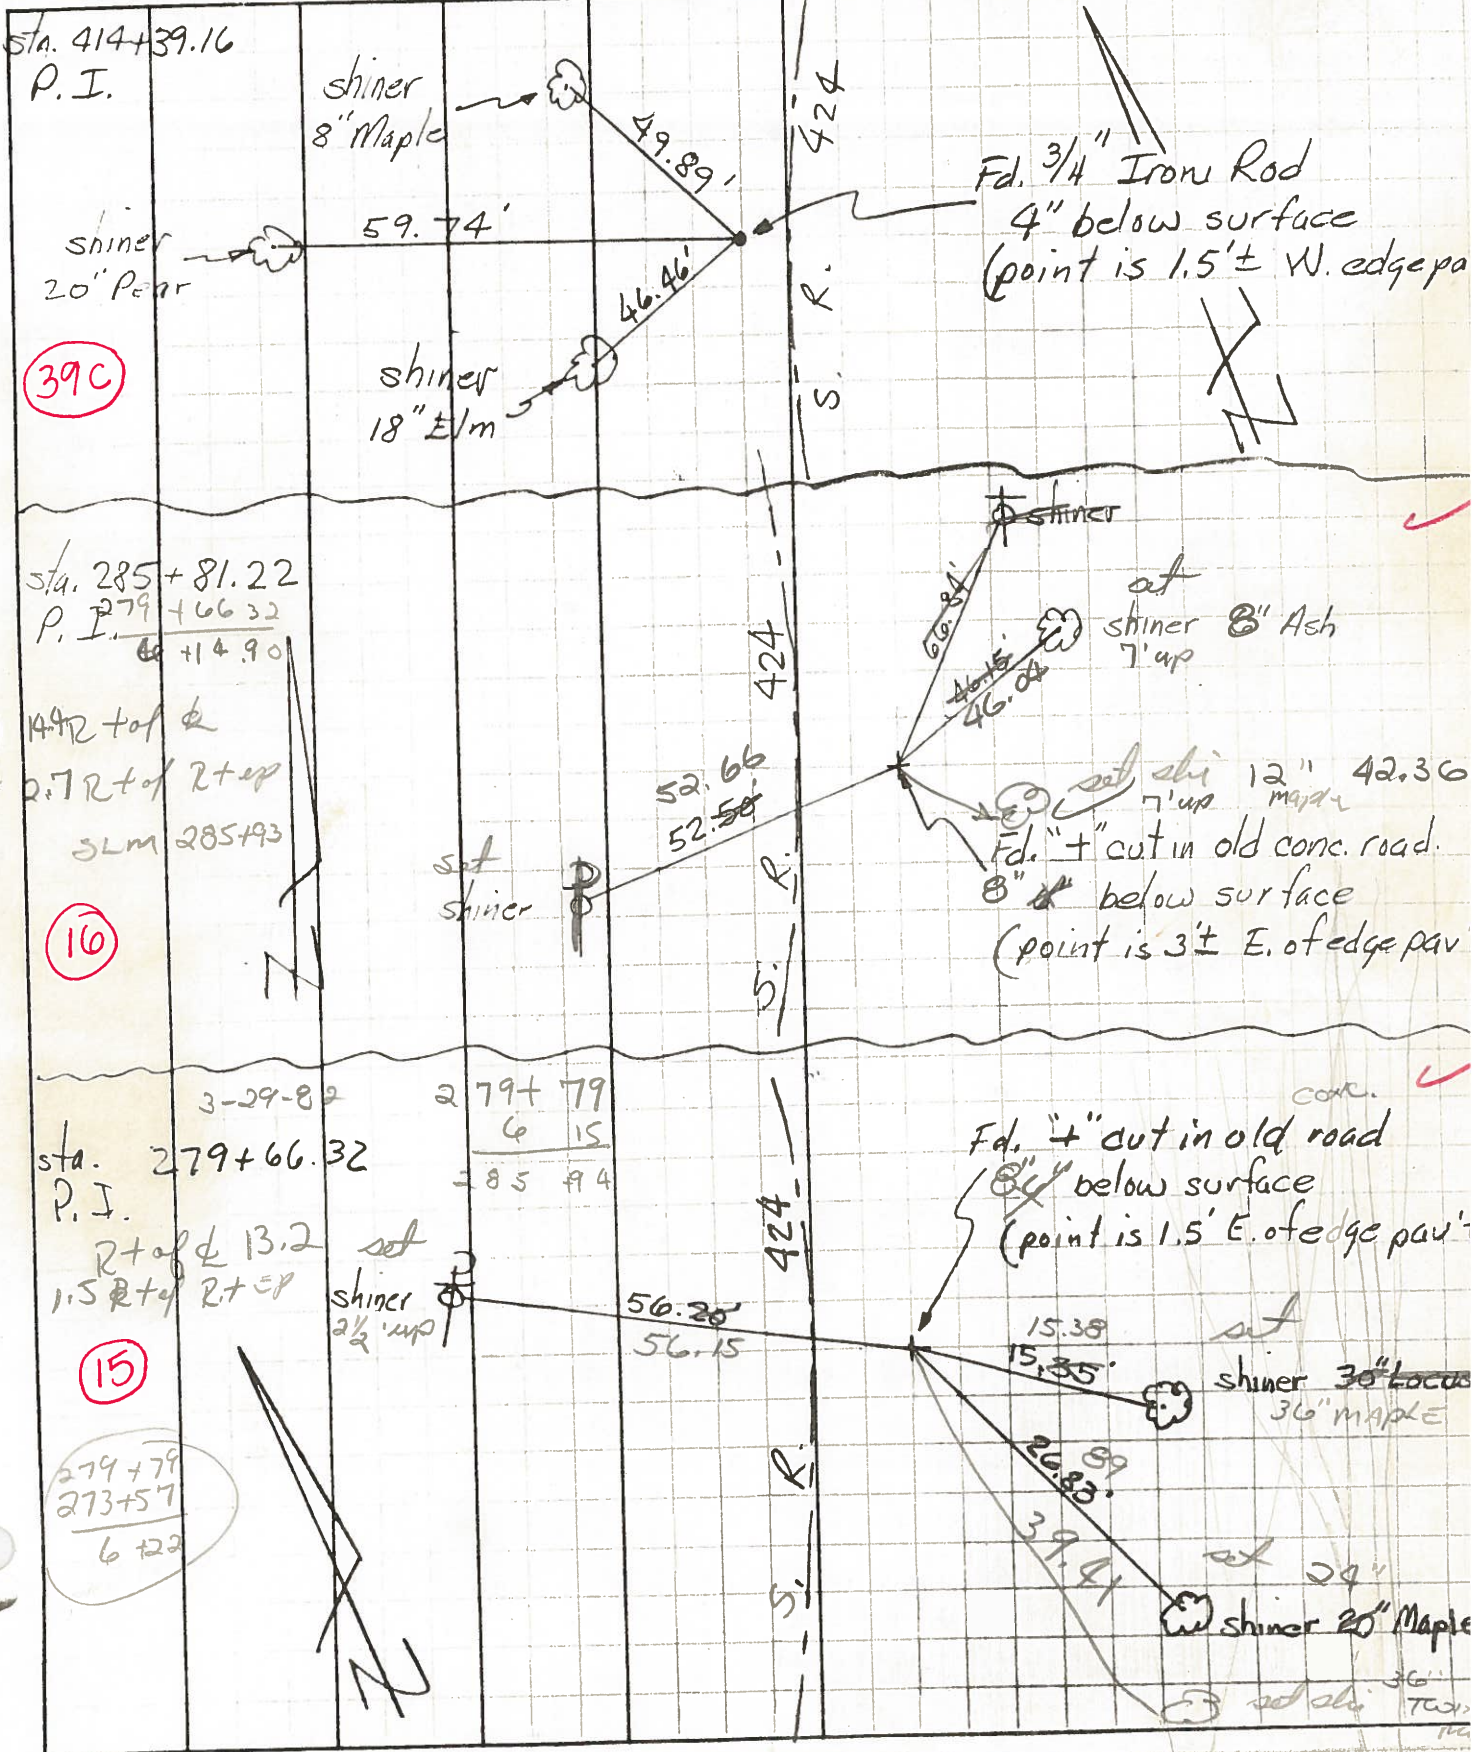

39C

16

15

279+79
273+57
6+22

Fd. 3/4" Iron Rod
4" below surface
(point is 1.5' ± W. edge pav)

at shiner 8" Ash
7' up

set shi 12" 42.36
7' up maple
Fd. " cut in old conc. road.
8" below surface
(point is 3' ± E. of edge pav)

Fd. " cut in old road
8" below surface
(point is 1.5' E. of edge pav)

shiner 30" LOCUS
36" MAPLE

shiner 20" Maple

set shi 36" LOCUS