


O.D.O.T. DISTRICT 2 SURVEY OFFICE (USE ONLY)


PERSONNEL _____ REFERENCE NO. 16 SHEET 27 OF 48
 NOTES HOMAN DATE 02/21/12 ROUTE SR 424
 H.C. HOMAN WEATHER CLOUDY COUNTY HENRY
 R.C. ROUSOS TEMP. 35° TOWNSHIP FLATROCK
 _____ SECTION 2
 _____ T 4 N R 6 E

TYPE MONUMENT "+" IN CONC. PAVT
~~ON SURFACE~~ - BELOW 10"
~~LEFT - C PAVT~~ - RIGHT 14.8'
3.4 TO RT EDGE PAVEMENT
 S.L.M. 285+49

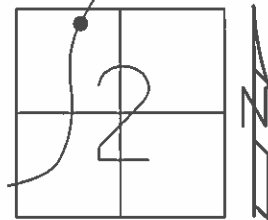

Grid: Northing: 613645.870 Easting: 1516411.887

RECORD:
 P.I. STA. 285+81.22
 FD "+" CUT IN CONC. PAVT
 7" BELOW SURFACE. PLACED
 3 BENT SMALL R.R. SPIKES
 AROUND "+".
 3-29-83
 FD "+" PAINTED YELLOW, PLACED
 3 BENT SMALL RR SPIKES AROUND "+"
 PLACED ROLDED PIECE OF PAPER
 OVER SPIKES & BACKFILLED
 PLACED TWO LARGE RR SPIKES IN
 BACKFILL BELOW SURFACE TO USE
 FOR LOCATION BY METAL LOCATOR ONLY.
 SPIKES ARE NOT OVER "+".
 04/03/91
 FD
 12/29/08
 #125
 REF28
 FD "X"
 02/21/12 DCH

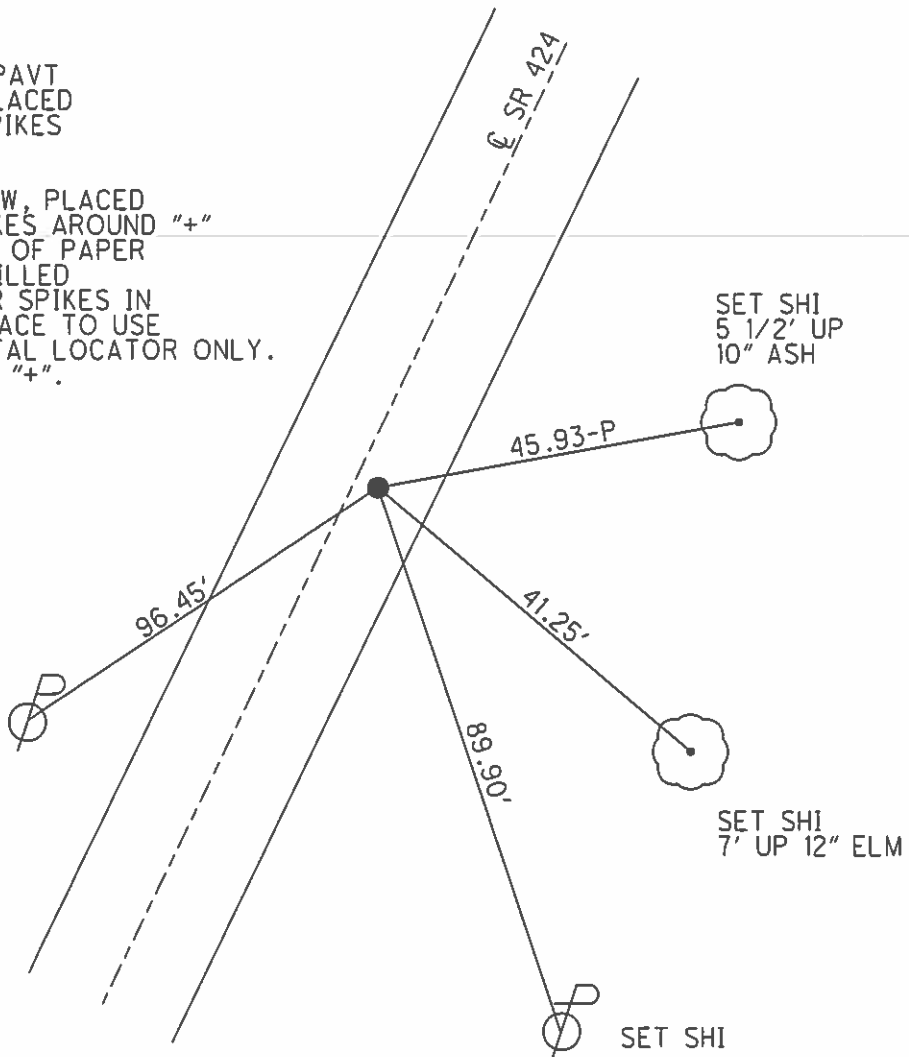

O.D.O.T. DISTRICT 2 SURVEY OFFICE

PERSONNEL _____

REFERENCE NO. 16

SHEET 27 OF 43

NOTES Hoffman

H.C. Loehle

DATE 4-3-91

ROUTE SR 424

R.C. Baranickel

WEATHER CLEAR

COUNTY HENRY

TEMP. 40°

TOWNSHIP FLAT ROCK

SECTION 2

T 4 N R 6 E

TYPE MONUMENT "+" IN CONC. PAVT


ON SURFACE - BELOW 9"

LEFT- & PAV'T. - RIGHT 14.8'

3.4 TO RT EDGE PAVEMENT


S.L.M. 285 + 49

PAINTED ↑
5-23-91
C.L.

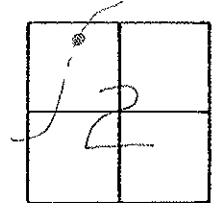

RECORD:
P.I. Sta. 285+81.22
Fol. "+" CUT IN CONC. PAVT
7" Below Surface. PLACED
3 bent small R.R. SPIRES
AROUND "+", 3-22-88

4-3-91
5:14
Painted yellow, placed 3 bent
small R.R. SPIRES AROUND "+"
Placed folded piece of paper
over SPIRES & BACKFILL.
Placed two large R.R. SPIRES
IN BACKFILL BELOW SURFACE
TO USE FOR LOCATION BY
METAL LOCATOR ONLY.
SPIRES ARE NOT OVER "+"

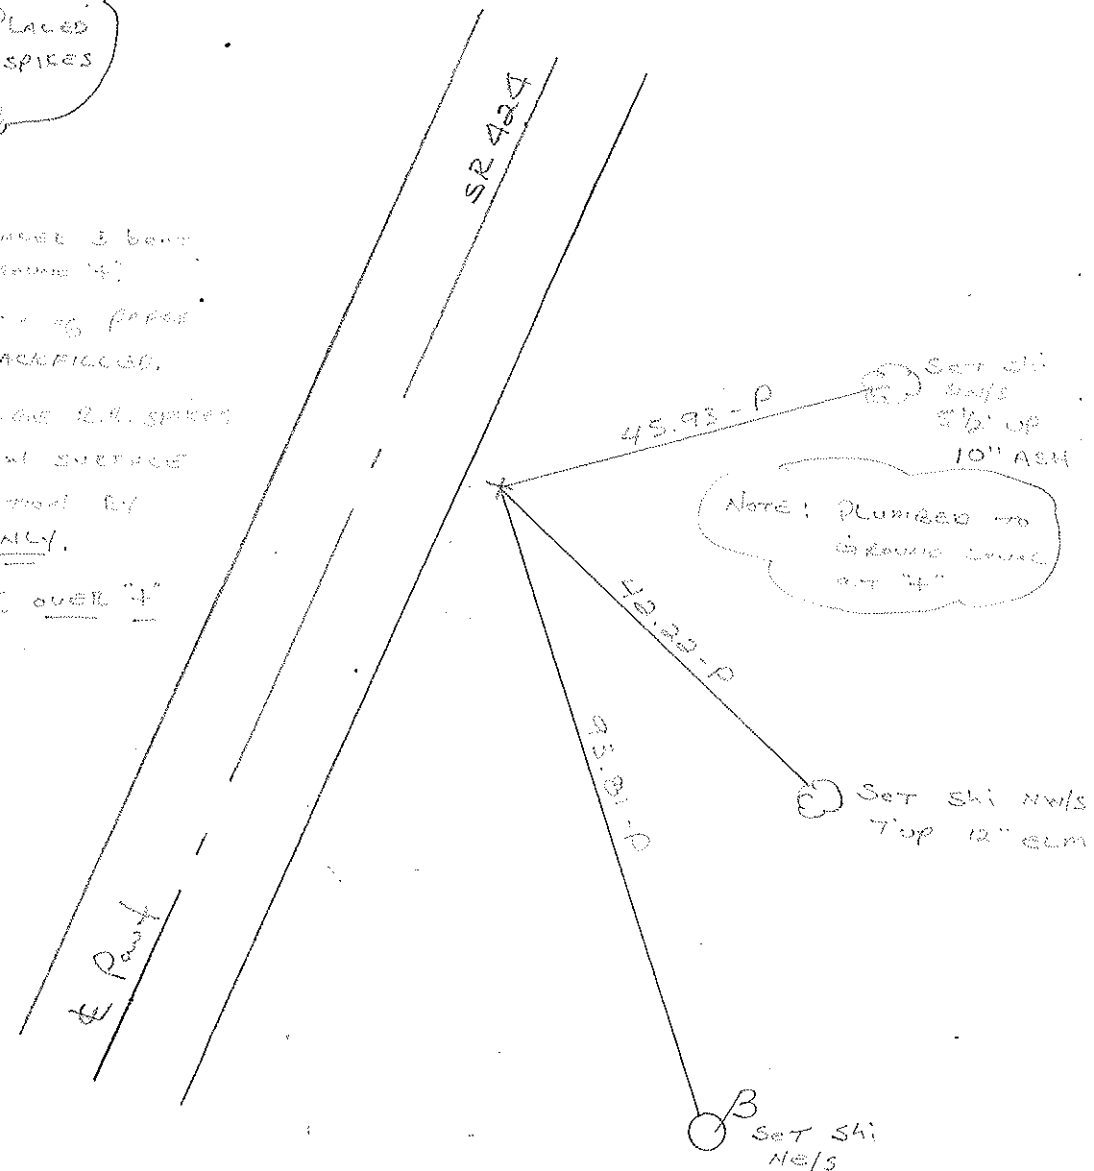

Q.D.O.T. DISTRICT 2 SURVEY OFFICE

SHEET _____ OF _____

County HENRY S.R. 424

Date MARCH 29, 83

Township FLATROCK

Weather P. CLEAR

Section 2

Temp. +30°


T4N, R6E

Personnel HOFFMAN

&

CREW

(16)

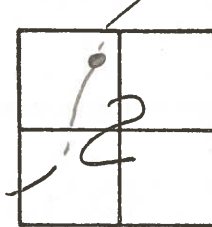

Fd. "+" CUT IN old conc. ROAD SURFACE,

7" Below surface

14.4' RT. of & Pavt


2.7' RT of RT. EP.

PLACED 3 Bent small 2.R. SPKS AROUND "+",
PAINTED yellow, put Berm chip STONE
OVER SPKS, THEN covered WITH DIRT.

LOCATED & PAINTED → ON PAVED BERM
5-31-83 SWH

SLM 285+93

Record:
P.I. 285+81.22

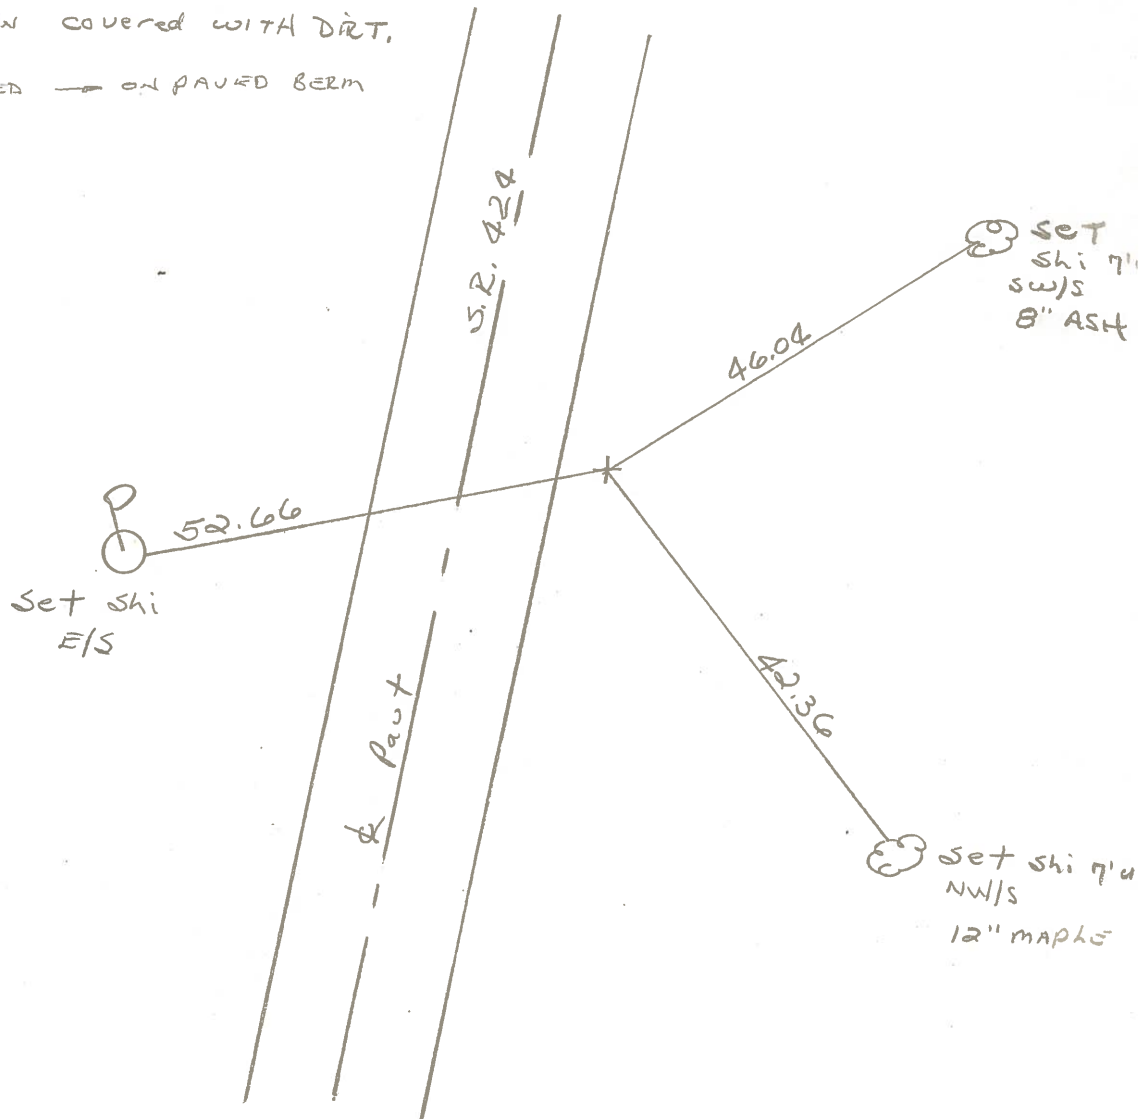

PERSONNEL	TITLE	PERSONNEL	TITLE	COUNTY	DATE	WEATHER	TEMP.
Tomsic				HENRY	JUNE 24, 1977		
Vanyo				S. R. 424			
Grinstad				SEC.			

DESCRIPTION _____ LEFT _____ CENTER LINE _____ RIGHT _____ JOB NO. _____

