



O.D.O.T. DISTRICT 2 SURVEY OFFICE (USE ONLY)

PERSONNEL \_\_\_\_\_ REFERENCE NO. 30 SHEET 29 OF 48  
 NOTES HOMAN DATE 02/22/12 ROUTE SR 424  
 H.C. HOMAN WEATHER CLOUDY COUNTY HENRY  
 R.C. ROUSOS TEMP. 35° TOWNSHIP NAPOLEON  
 \_\_\_\_\_ SECTION 2  
 \_\_\_\_\_ T 5 N R 6 E

TYPE MONUMENT \_\_\_\_\_ RR SPIKES  
 ON SURFACE - ~~BELOW~~ \_\_\_\_\_ 3"  
~~LEFT - C PAV'T~~ - RIGHT \_\_\_\_\_ 3.1'  
9.4 TO RT EDGE PAVEMENT  
 S.L.M. \_\_\_\_\_  
 Grid: Northing: 614335.077 Easting: 1516464.173

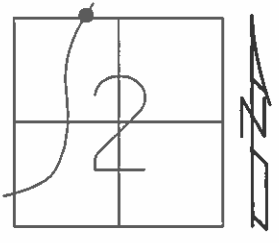

RECORD:  
 STA. 292+70.99  
 OK FD  
 12/29/08  
 4.12' BETWEEN A & B  
 #126

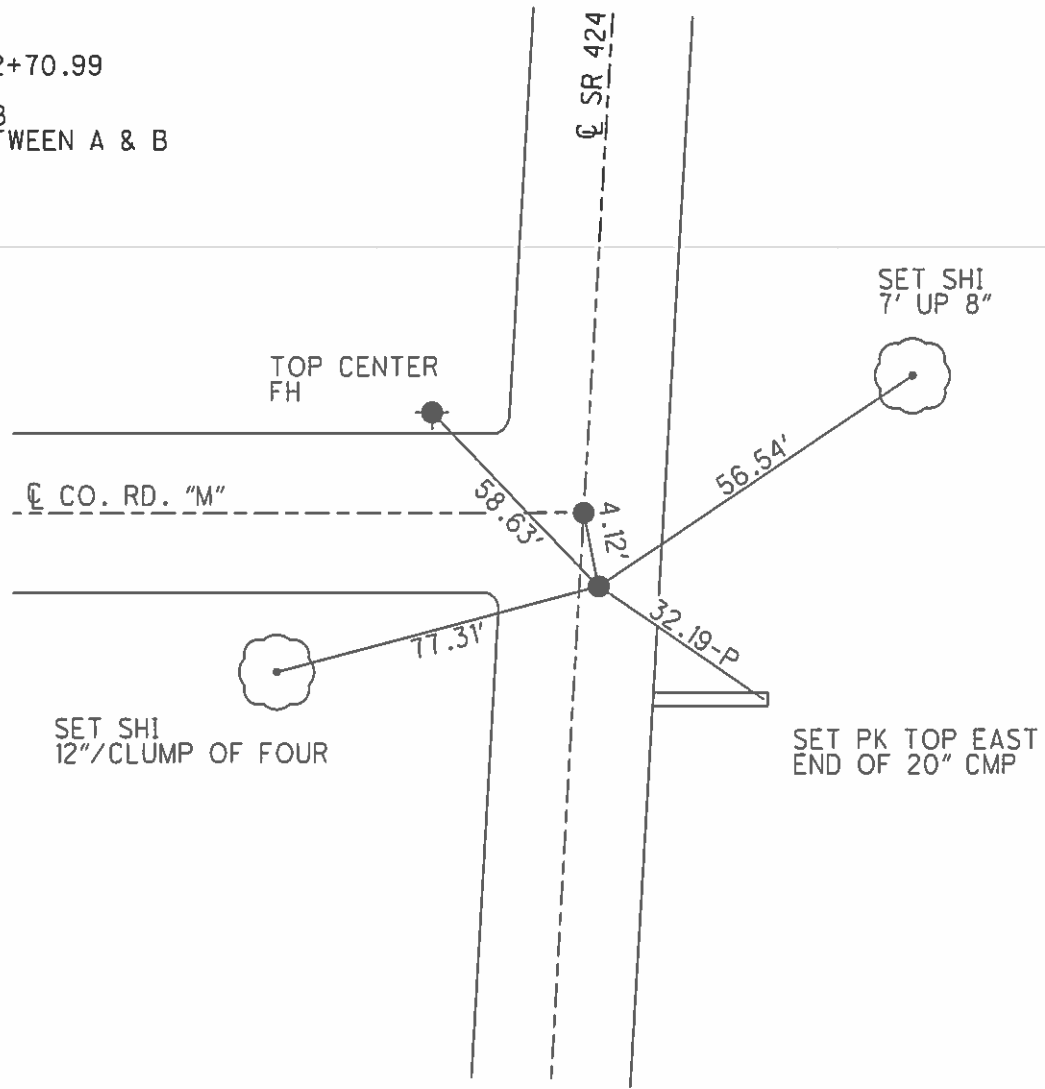

# O.D.O.T. DISTRICT 2 SURVEY OFFICE

PERSONNEL

REFERENCE NO. 30

SHEET 28 OF 43

NOTES HOFFMAN

H.C. LOSHRKS

DATE 4-4-91

ROUTE SR 424

R.C. BARNHISEL

WEATHER CLEAR

COUNTY HENRY

TEMP. 45°

TOWNSHIP FLATROCK

SECTION 2

T 4 N R 6 E

TYPE MONUMENT P.K. Nail SHANK-BOTH POINTS


ON SURFACE - ~~BELOW~~ YES

LEFT-☉ PAV'T. - RIGHT ☉ 3.1' RT

12.2/9.4 TO RT EDGE PAVEMENT


S.L.M. P.T. "A" = 292+40

SET P.K./w/ washer  
BOTH POINTS  
5-23-91  
CL

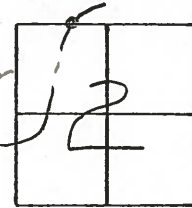

RECORD!  
Sta. 292+70.99

4.06' Between A & B

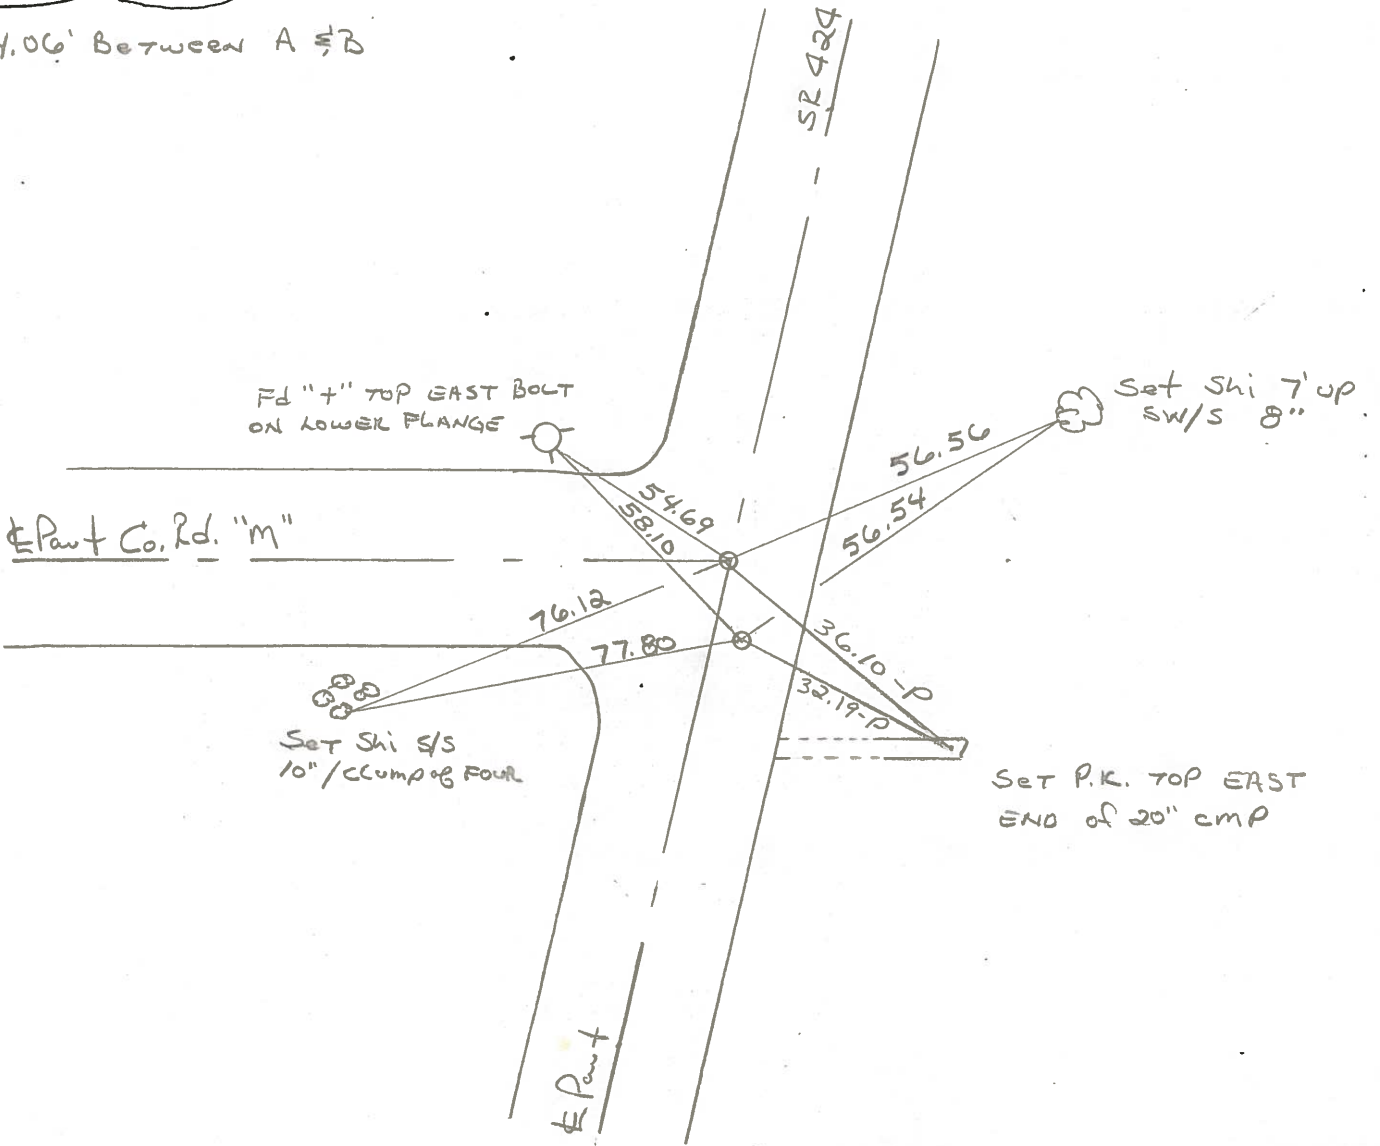

OD.O.T. DISTRICT 2 SURVEY OFFICE

SHEET \_\_\_\_\_ OF \_\_\_\_\_

County HENRY S.R. 424

Date MARCH 29, 83

Township FLATROCK

Weather P CLEAR

Section 2

Temp. +38°

T4N, R6E

Personnel HOFFMAN


E

CREW

\_\_\_\_\_

\_\_\_\_\_

#30

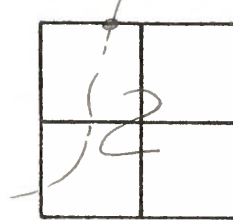


PT. "A" Fd R.R. SPK @ SURFACE  
ON & PAUT SR 424  
10.6' TO E. EP.  
ON & PAUT Co. Rd. "M"

SLM 292+84

Record;  
292+70.99

SET P.K./washer  
@ BOTH POINTS  
5-31-83  
SWH


PT. "B" Fd R.R. SPK @ SURFACE  
3.4' RT & PAUT SR 424  
7.7' TO E. EP.

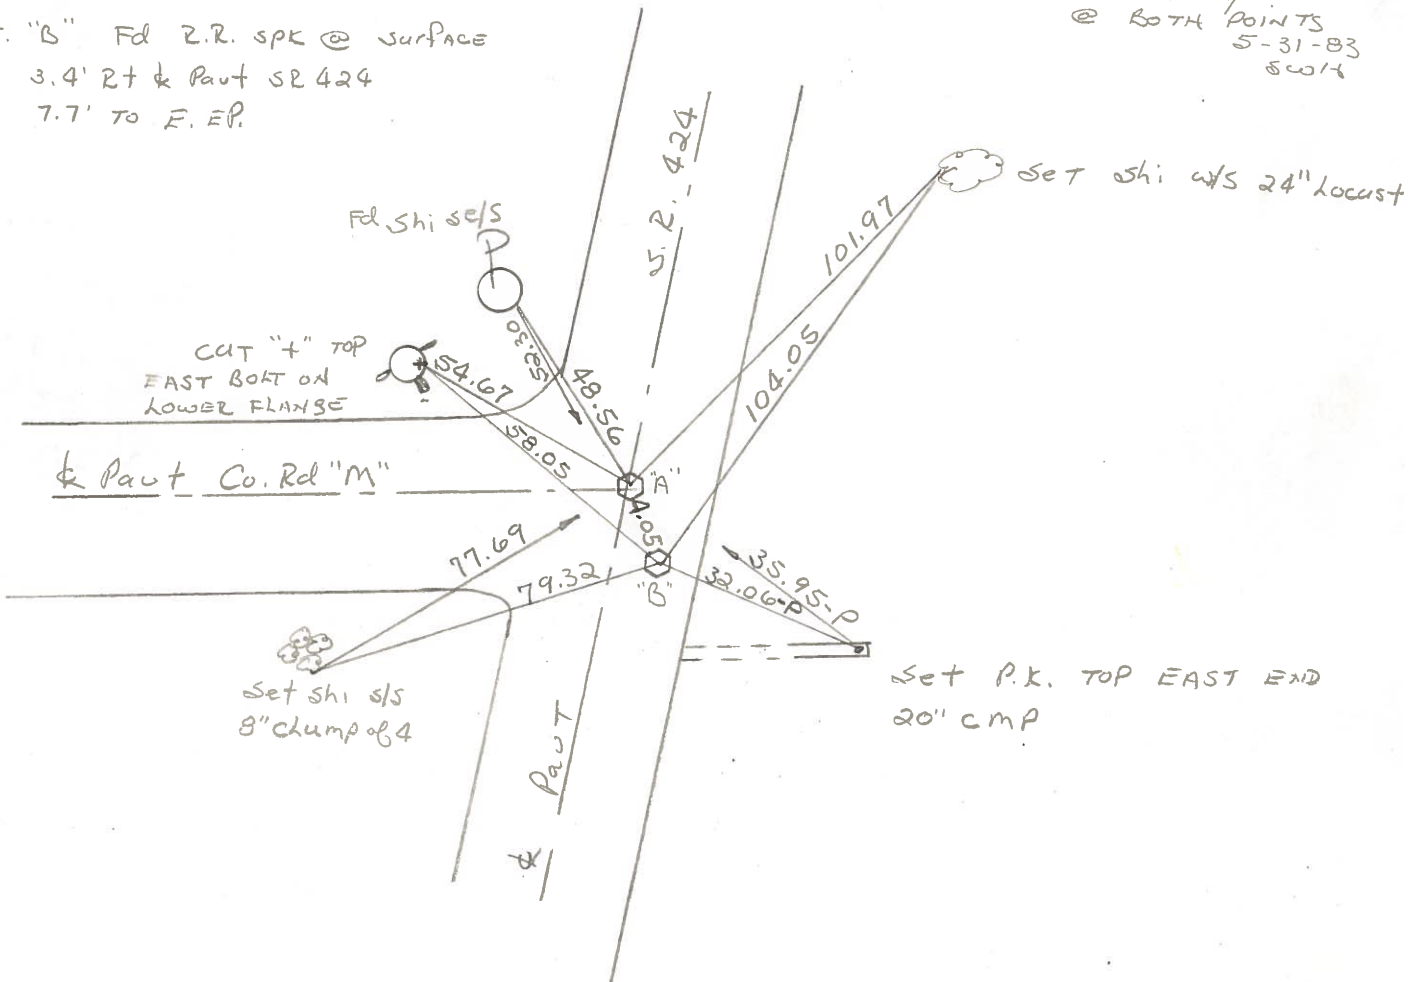



PERSONNEL	TITLE	PERSONNEL	TITLE	COUNTY	DATE
Tomsic				HENRY	MAY 30, 1974
Leuser				S. R. 424	WEATHER
van				SEC.	TEMP.
vanata					

DESCRIPTION \_\_\_\_\_ LEFT \_\_\_\_\_ CENTER LINE \_\_\_\_\_ RIGHT \_\_\_\_\_ JOB NO. \_\_\_\_\_

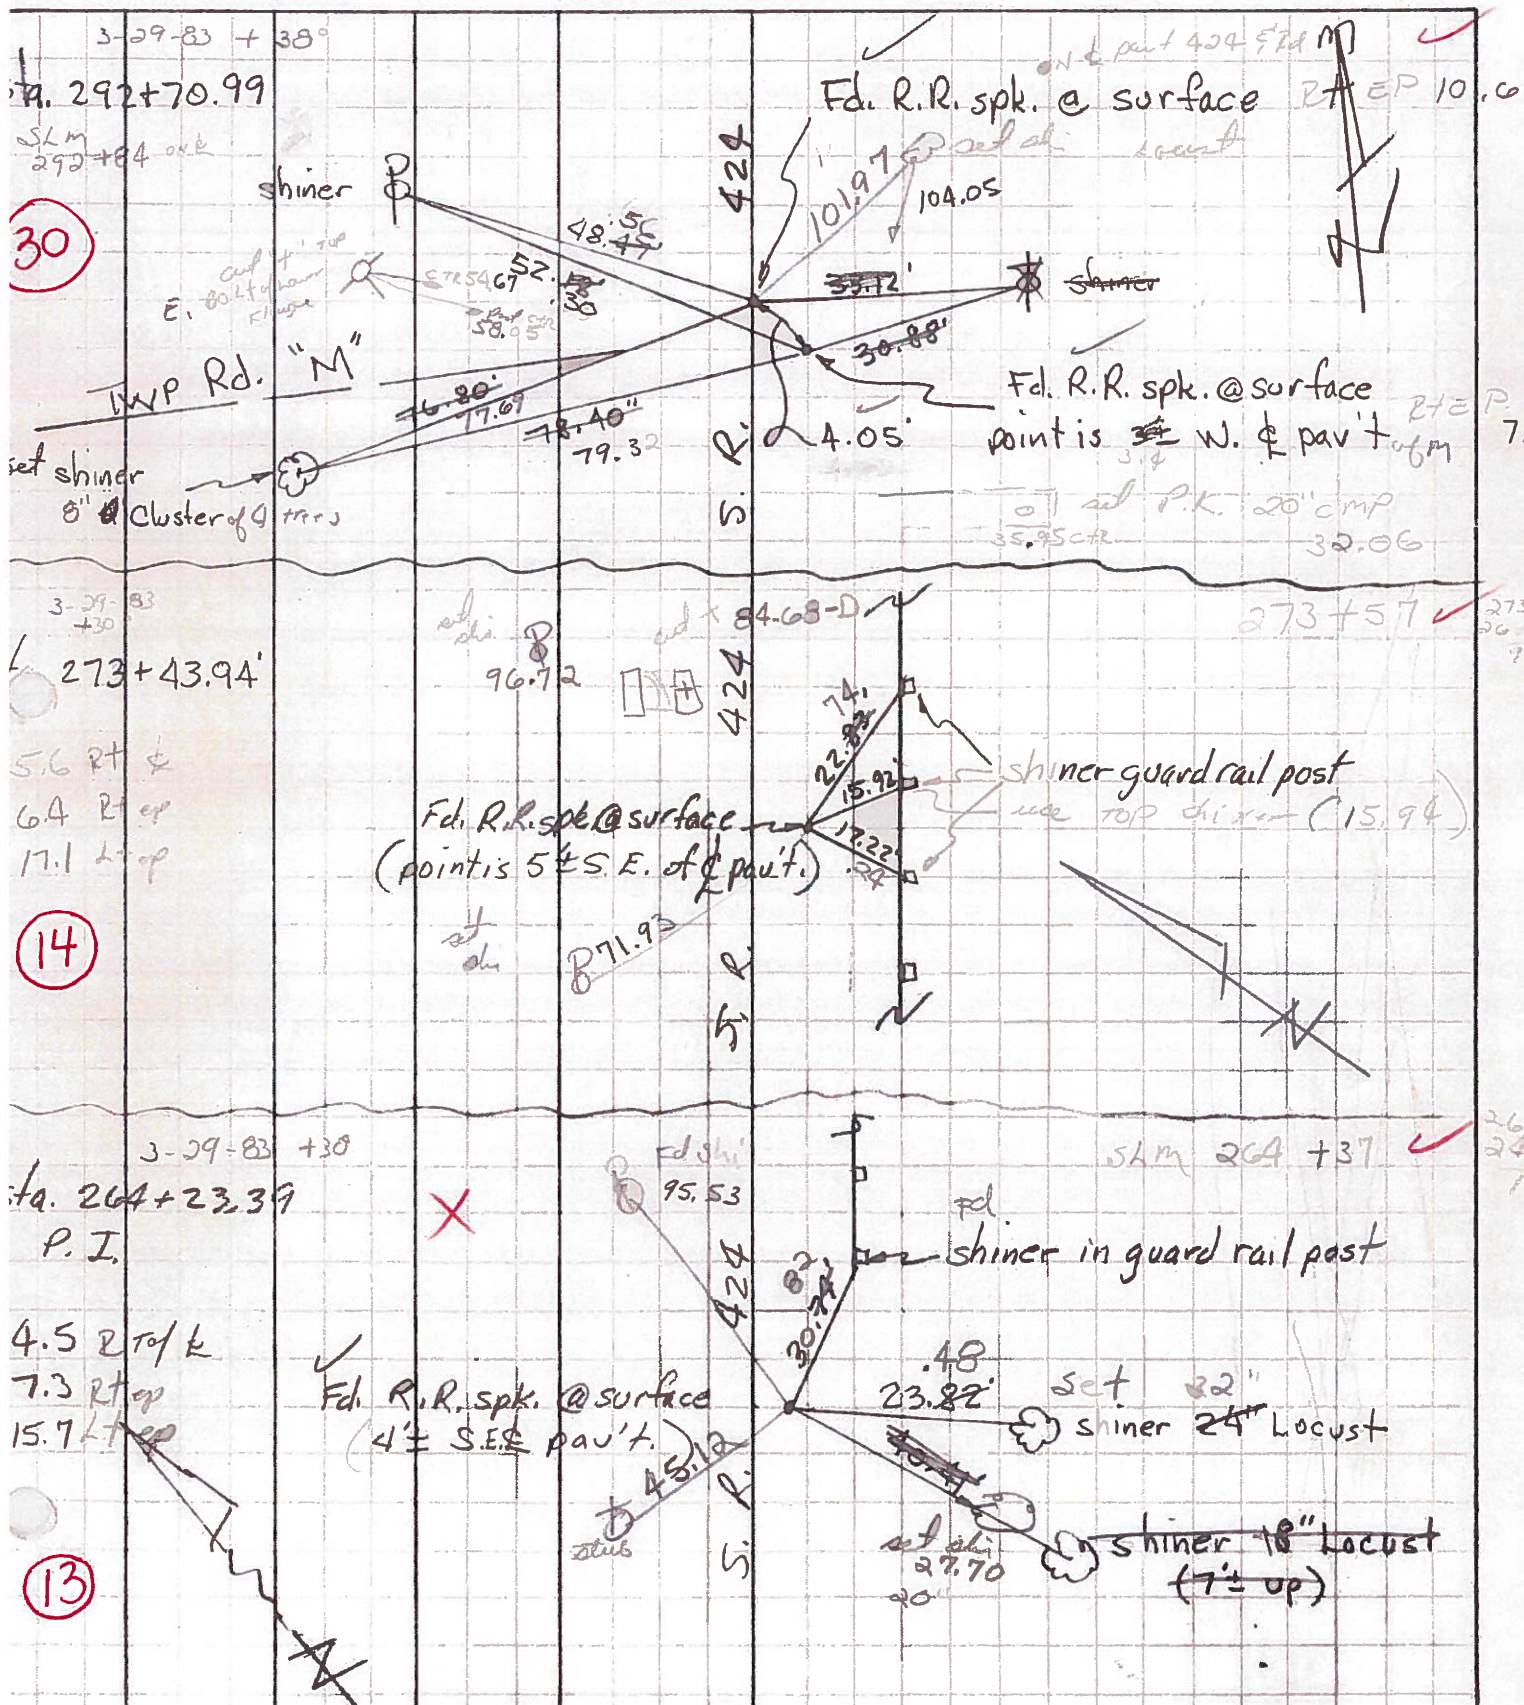



PERSONNEL	TITLE	PERSONNEL	TITLE	COUNTY	DATE	WEATHER	TEMP.
Hoover				Henry	4-		
Hoff				U.S.R. 24			
Delventhal							
DESCRIPTION				SEC.	JOB NO.		

Witnesses to Control Points (P.I.'s)


LEFT CENTER LINE RIGHT

Forward Tangent

✓ P.I. - 264 + 23.39

(13)

(Iron Pin)  
RR Spk.  
3' E. of P.O.

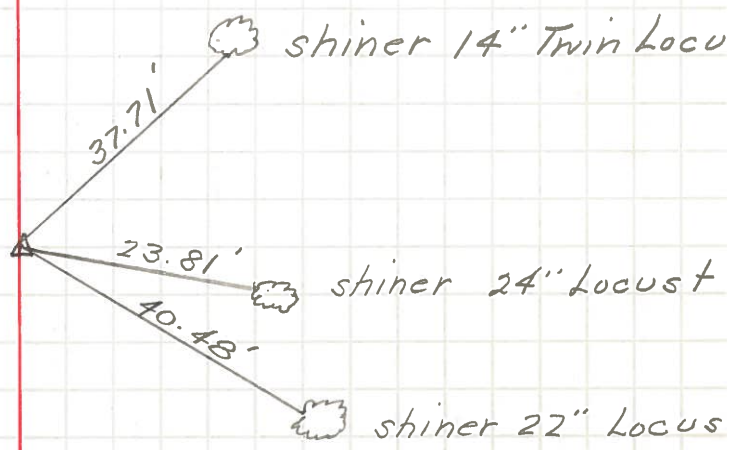


✓ P.I. - 273 + 43.94

@ Embers Rest.

shiner.  
Near side  
steel Sign Post

shiner P.P.

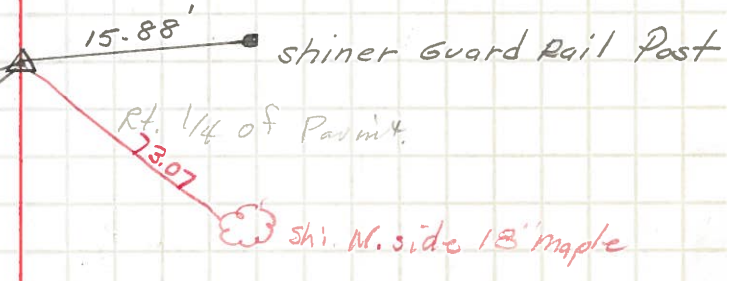


✓ P.I. - 292 + 70.99

Twp. Line { Flatrock  
Napoleon }  
Inter. Twp. Rd # M

P.R. spk. N  
& Permit.

spk. P.P.

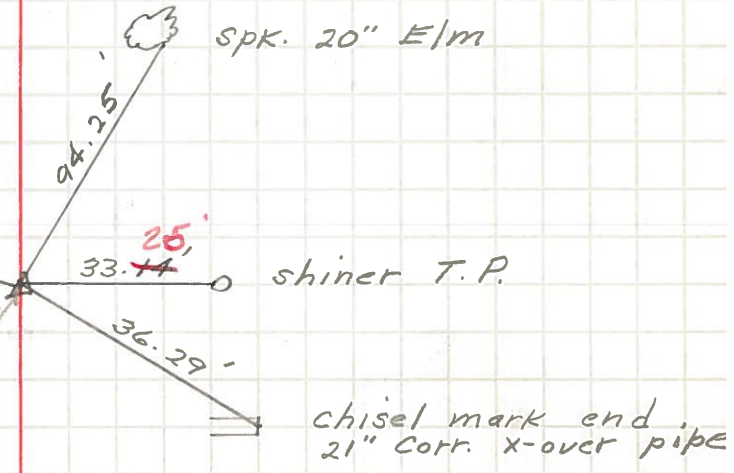

(30)