


O.D.O.T. DISTRICT 2 SURVEY OFFICE (USE ONLY)


PERSONNEL \_\_\_\_\_ REFERENCE NO. 30 SHEET 28 OF 48  
 NOTES HOMAN DATE 02/22/12 ROUTE SR 424  
 H.C. HOMAN WEATHER CLOUDY COUNTY HENRY  
 R.C. ROUSOS TEMP. 35° TOWNSHIP FLATROCK  
 \_\_\_\_\_ SECTION 2  
 \_\_\_\_\_ T 4 N R 6 E

TYPE MONUMENT RR SPIKES BOTH  
 ON SURFACE - ~~BELOW~~ 3"  
~~LEFT - C~~ PAV'T - ~~RIGHT~~ ON  
12.2 TO RT EDGE PAVEMENT  
 S.L.M. \_\_\_\_\_ PT. "A" = 292+40

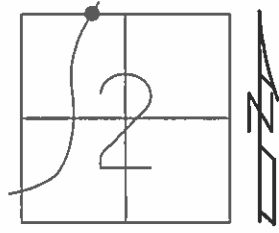

Grid: Northing: 614335.077 Easting: 1516464.173

RECORD:  
 STA. 292+70.99  
 OK FD  
 12/29/08  
 4.12' BETWEEN A & B  
 #126

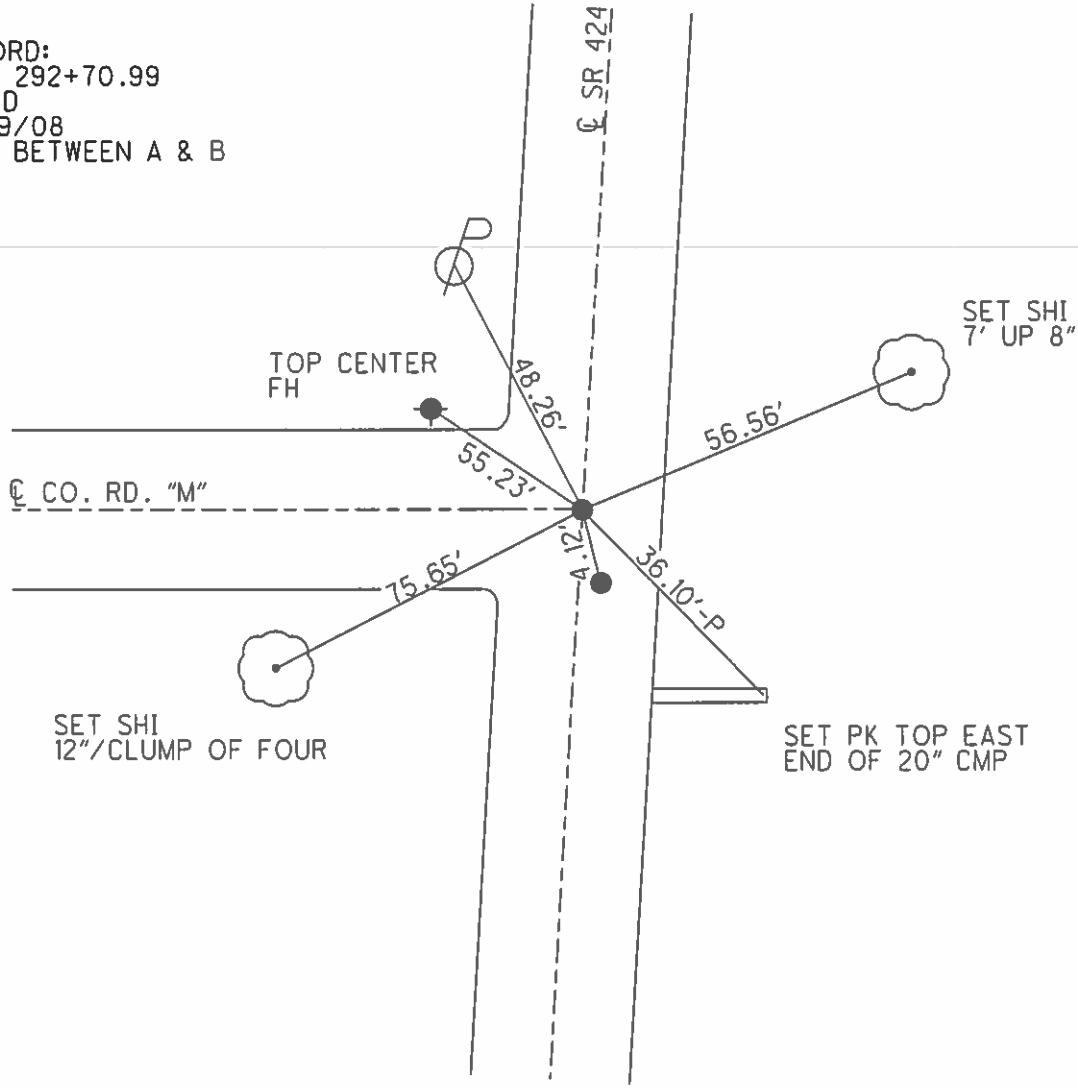

# O.D.O.T. DISTRICT 2 SURVEY OFFICE

PERSONNEL

REFERENCE NO. 30

SHEET 28 OF 43

NOTES HOFFMAN

H.C. LOSHRKS

DATE 4-4-91

ROUTE SR 424

R.C. BARNHISEL

WEATHER CLEAR

COUNTY HENRY

TEMP. 45°

TOWNSHIP FLATROCK

SECTION 2

T 4 N R 6 E

TYPE MONUMENT P.K. Nail SHANK-BOTH POINTS


ON SURFACE - BELOW YES

LEFT-☉ PAV'T. - RIGHT ☉ 3.1' RT

12.2/9.4 TO RT EDGE PAVEMENT

S.L.M. Pt. "A" = 292 + 40


SET P.K. / washer  
BOTH POINTS  
5-23-91  
CL

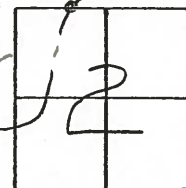

RECORD!

Sta. 292 + 70.99

4.06' Between A & B

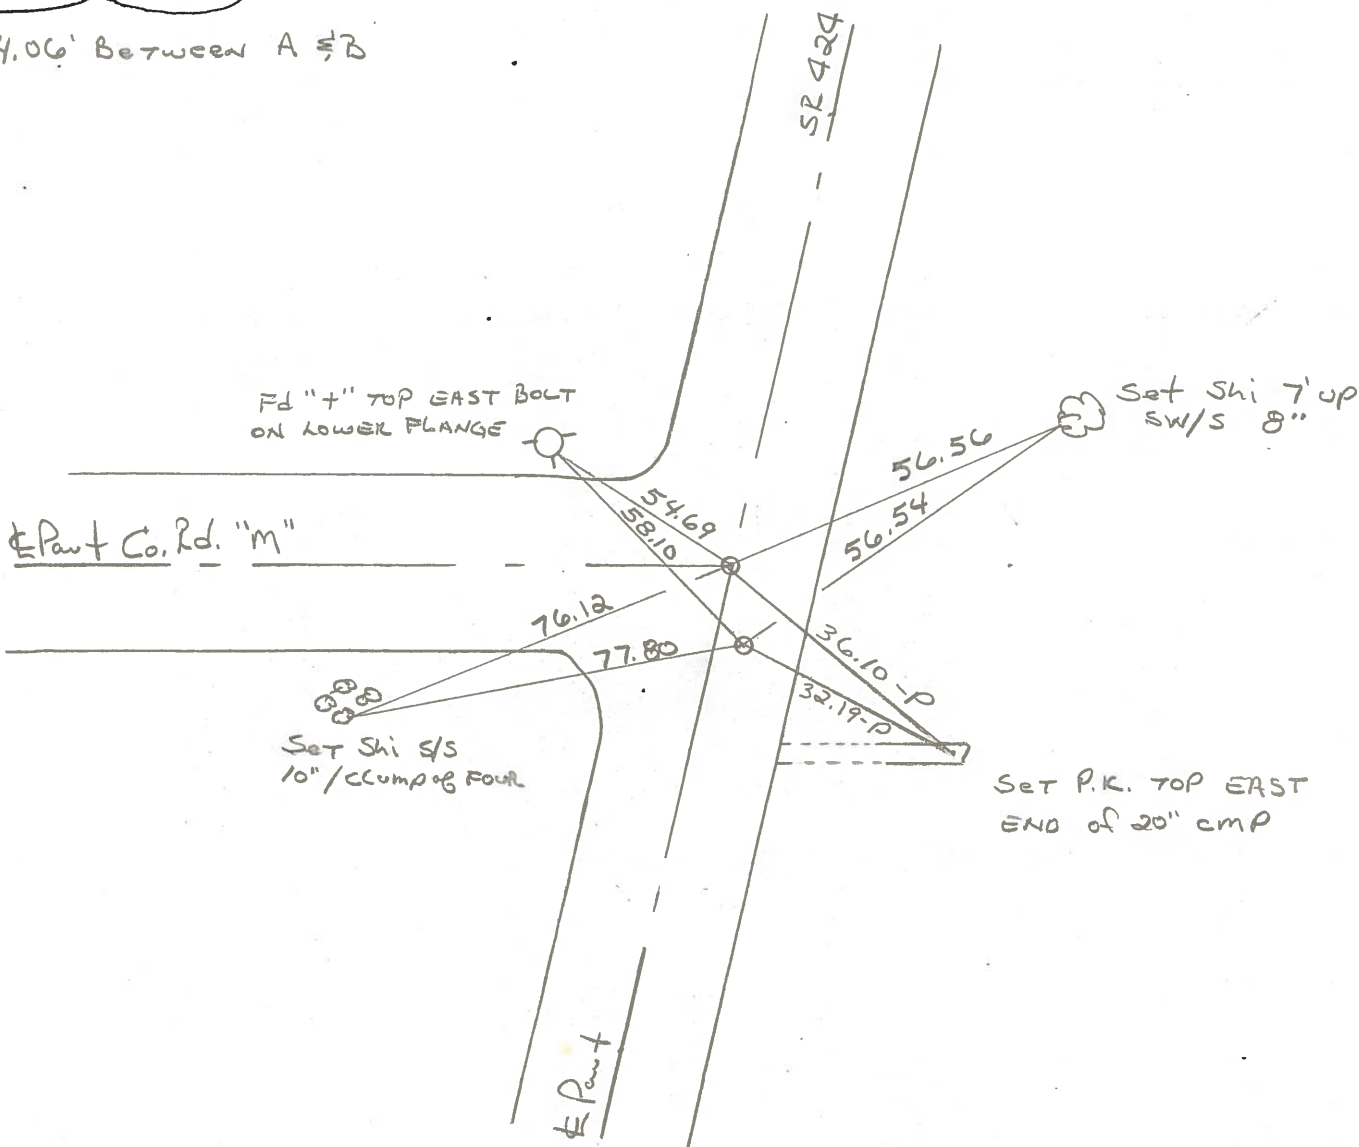

OD.O.T. DISTRICT 2 SURVEY OFFICE

SHEET \_\_\_\_\_ OF \_\_\_\_\_

County HENRY S.R. 424

Date MARCH 29, 83

Township FLATROCK

Weather P CLEAR

Section 2

Temp. +38°


T4N, R6E

Personnel HOFFMAN

E

CREW

# 30

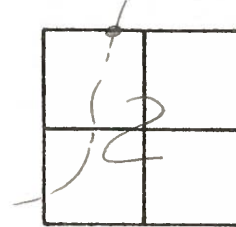


PT. "A" Fd R.R. SPK @ SURFACE  
 ON & PAUT SR 424  
 10.6' TO E. EP.  
 & ON & PAUT Co. Rd. "M"

SLM 292+84

Record;  
 292+70.99

SET P.K./washer  
 @ BOTH POINTS  
 5-31-83  
 SWH

PT. "B" Fd R.R. SPK @ SURFACE  
 3.4' RT & PAUT SR 424  
 7.7' TO E. EP.

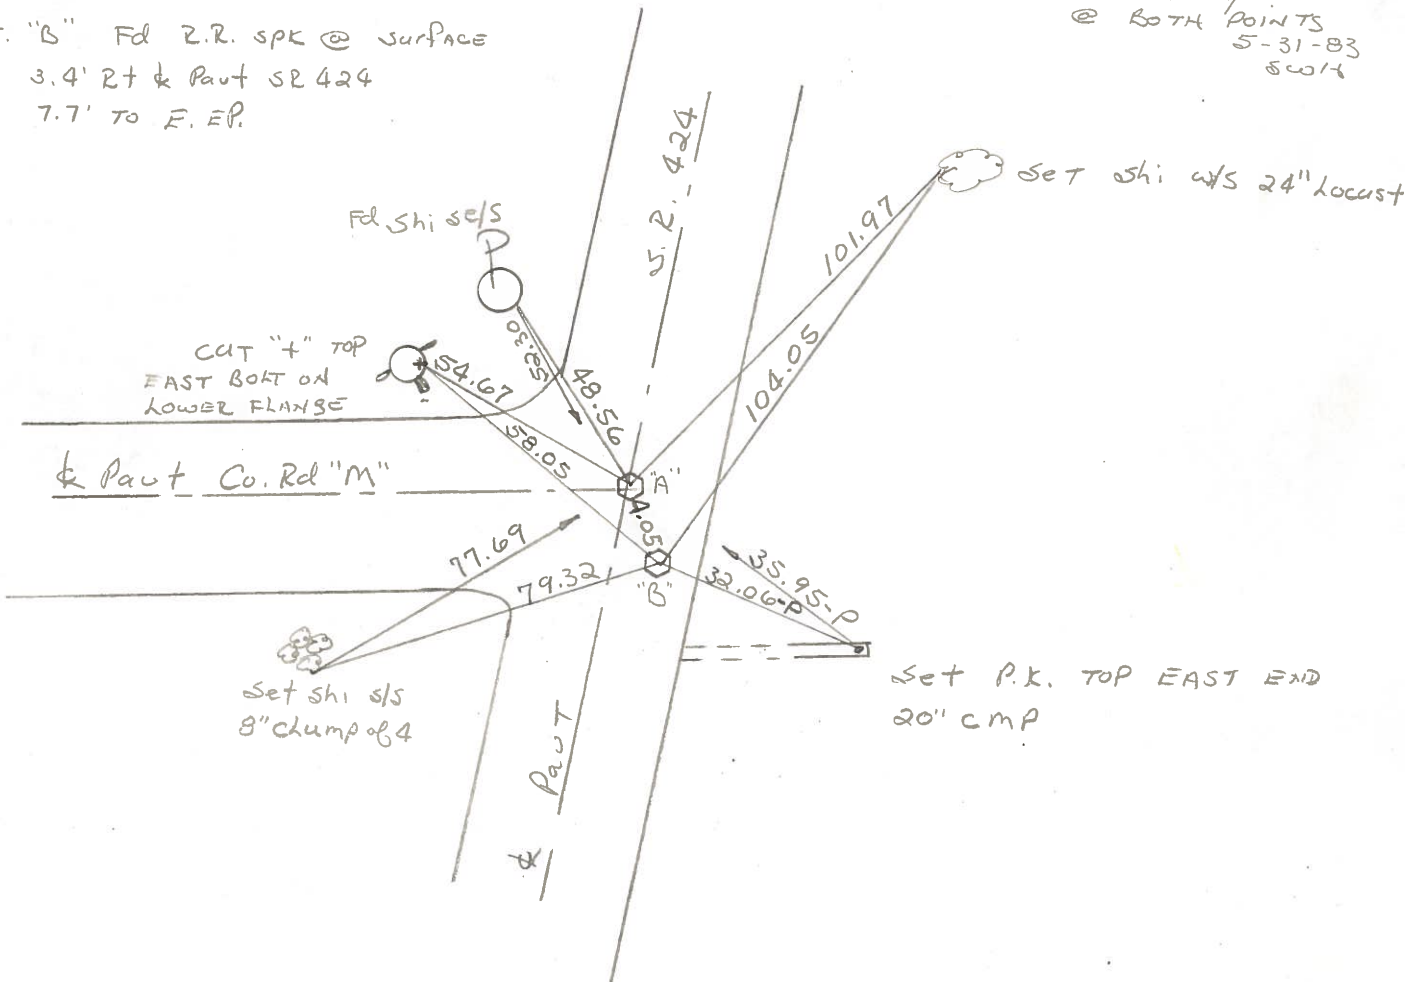

PERSONNEL	TITLE	PERSONNEL	TITLE	COUNTY	DATE	WEATHER	TEMP.
Tomsic				HENRY	MAY 30, 1974		
Leuser				424			
ranata							

DESCRIPTION \_\_\_\_\_ LEFT \_\_\_\_\_ CENTER LINE \_\_\_\_\_ RIGHT \_\_\_\_\_ JOB NO. \_\_\_\_\_

