


O.D.O.T. DISTRICT 2 SURVEY OFFICE (USE ONLY)


PERSONNEL _____ REFERENCE NO. 31 SHEET 30 OF 48
 NOTES HOMAN DATE 03/09/12 ROUTE SR 424
 H.C. HOMAN WEATHER CLEAR COUNTY HENRY
 R.C. ROUSOS TEMP. 30° TOWNSHIP NAPOLEON
 _____ SECTION 11
 _____ T 5 N R 6 E

TYPE MONUMENT _____ P.K./WASHER _____
 ON SURFACE - ~~BELOW~~ _____ ON _____
~~LEFT - C PAV'T - RIGHT~~ _____ 0.8 _____
11.1 TO RT EDGE PAVEMENT _____
 S.L.M. _____ 299+00 _____

Grid: Northing: 614985.589 Easting: 1516572.329

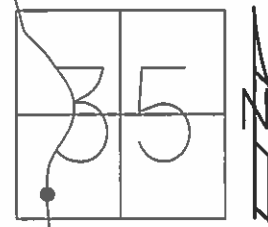

RECORD:
 P.I. STA. 299+30.35
 OK FD
 12/30/08
 #127
 REF31
 FD PK
 02/22/12 DCH

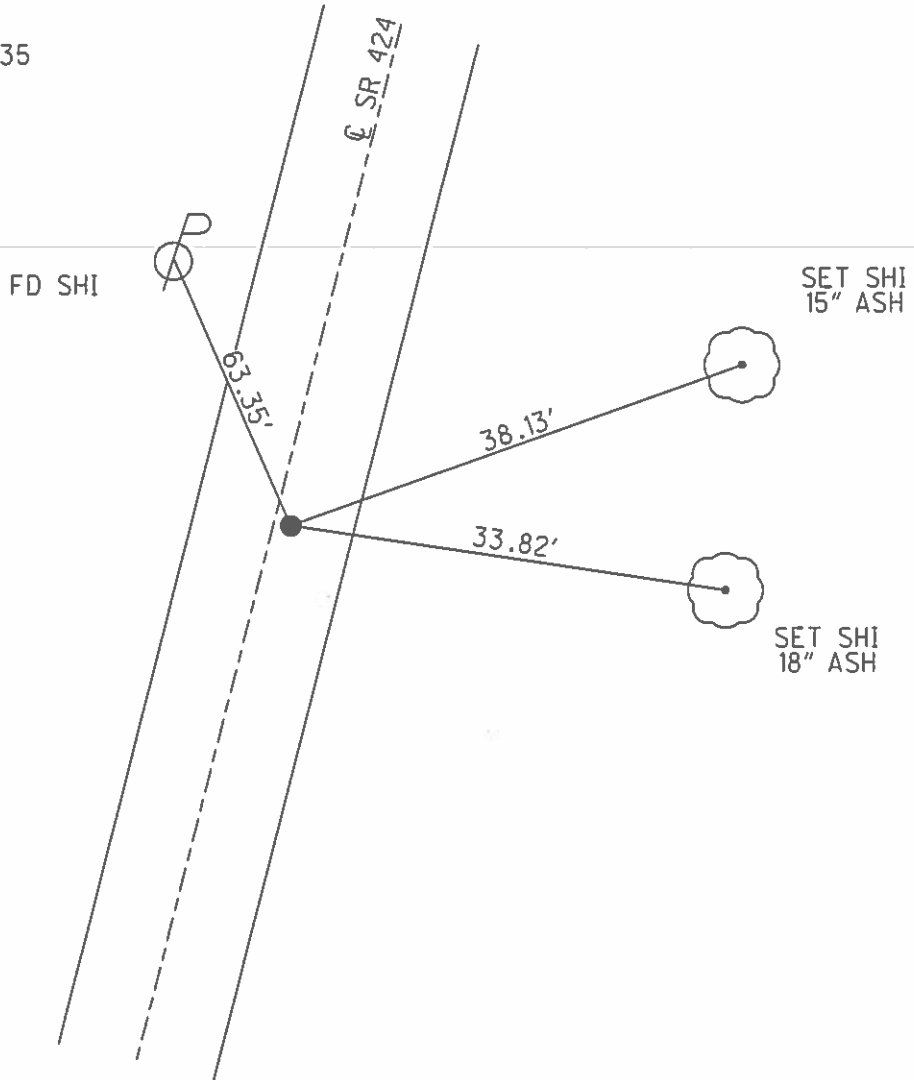

O.D.O.T. DISTRICT 2 SURVEY OFFICE

PERSONNEL

REFERENCE NO. 31

SHEET 29 OF 43

NOTES HOFFMAN

H.C. LOEHRKE

R.C. BARNHISEL

DATE 4-4-91

WEATHER CLEAR

TEMP. 50°

ROUTE SR 424

COUNTY HENRY

TOWNSHIP NAPOLEON

SECTION 35

T5 N R 6 E

TYPE MONUMENT P.K./WASHER


ON SURFACE - BELOW YES

~~LEFT -~~ PAV'T. - RIGHT 0.8


||| TO RT. EDGE PAVEMENT

S.L.M. 299+00

Set P.K. / washer
5-13-91
C.L.

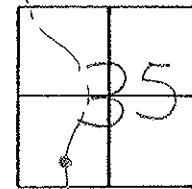

Records:
P.I. sta. 299+30.35

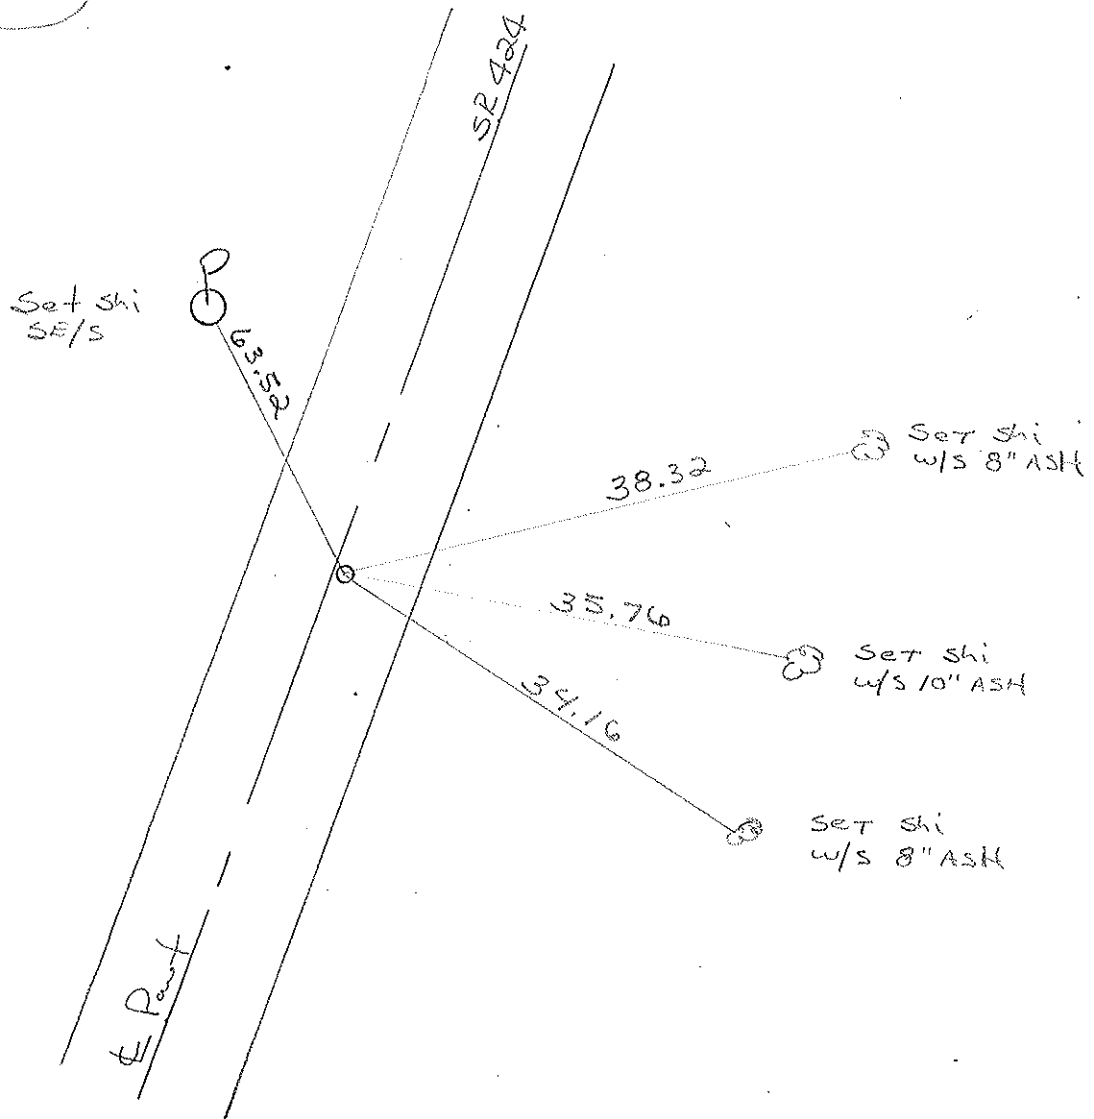

O.D.O.T. DISTRICT 2 SURVEY OFFICE

SHEET _____ OF _____

County HENRY S.R. 424

Township NAPOLEON

Section 35

TSN, R6E

Personnel HOFFMAN


+
CREW

(31)

Date MARCH 29, 83

Weather P. CLEAR

Temp. +38°

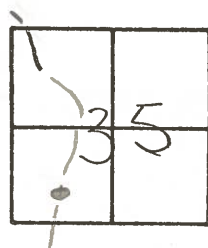

Fd Bexit R.R. SPK SHANK @ SURFACE

10' Rt of & Part

12.0 to W.E.P.

10.2 to E.E.P.


Ref tie to & Fit SHANK of SPK.

PULLED SPK & CHECKED WITH LOCATOR - NO READING; Reset point with @ SMALL R.R. SPK.

S.L.M. 299+43

Record;
P.I. 299+30.35


SET PK & WASHER
M.B. 6-17-83

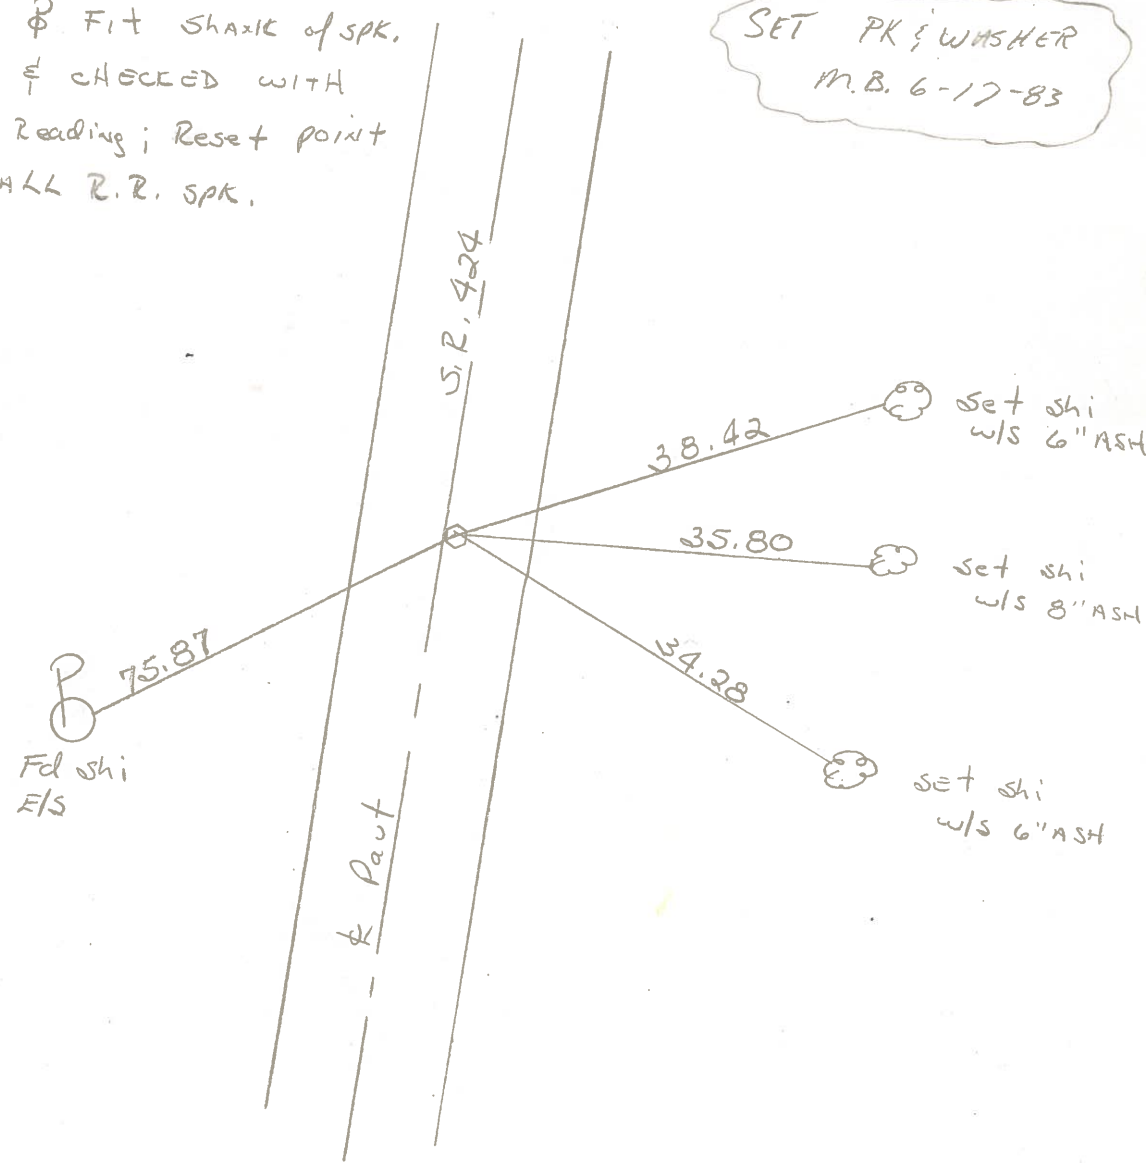

PERSONNEL TITLE PERSONNEL TITLE
 Tomasic _____

COUNTY HENRY DATE MAY 31, 1972
 S. R. 424 WEATHER _____
 SEC. _____ TEMP. _____

DESCRIPTION LEFT CENTER LINE RIGHT JOB NO. _____

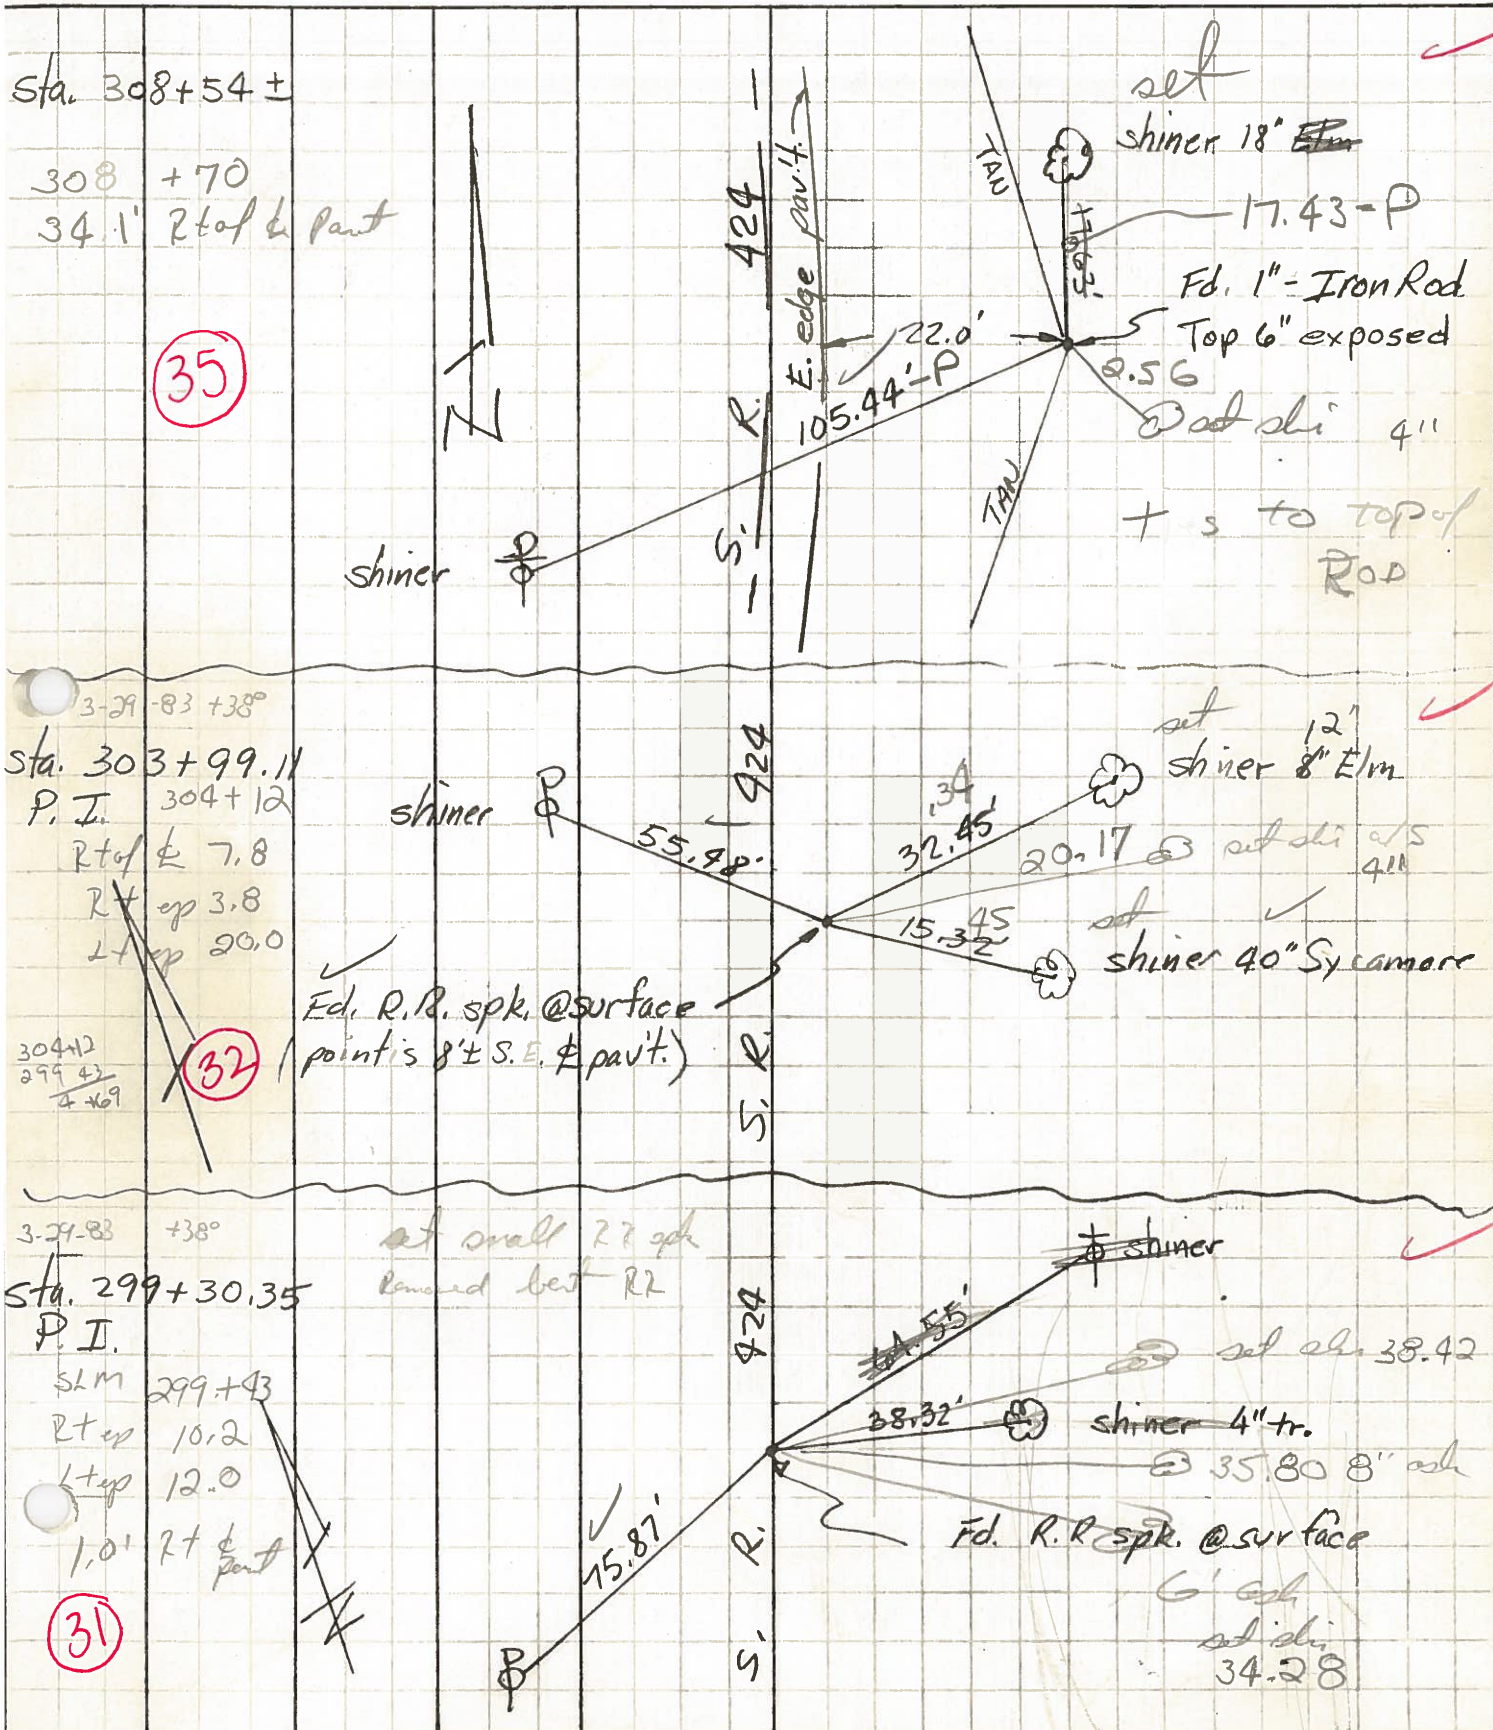

PERSONNEL TITLE PERSONNEL TITLE COUNTY Henry DATE 4- - 6:
Hoover _____ Hoff _____
Delventhal _____
 S. R. U.S.R. 24 WEATHER _____
 SEC. _____ TEMP. _____

DESCRIPTION Witnesses to Control Points (P.I. 3) JOB NO. _____

