


O.D.O.T. DISTRICT 2 SURVEY OFFICE (USE ONLY)


PERSONNEL _____ REFERENCE NO. 32 SHEET 31 OF 48
 NOTES HOMAN DATE 03/09/12 ROUTE SR 424
 H.C. HOMAN WEATHER CLEAR COUNTY HENRY
 R.C. ROUSOS TEMP. 30° TOWNSHIP NAPOLEON
 _____ SECTION 35
 _____ T 5 N R 6 E

TYPE MONUMENT _____ PK/WASHER _____
 ON SURFACE - ~~BELOW~~ _____ 1/2"
~~LEFT~~ - ~~C~~ PAV'T - RIGHT _____ 8.3
 _____ 3.8' TO RT EDGE PAVEMENT
 S.L.M. _____ 303+69

Grid: Northing: 615442.152 Easting: 1516678.785

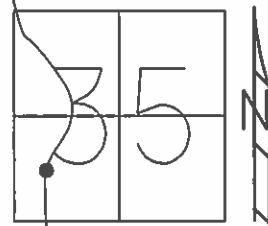

RECORD:
 P.I. STA. 303+99.11
 OK FD
 12/30/08
 #128
 REF32
 FD PK 1' 1/2" DOWN
 02/22/12 DCH

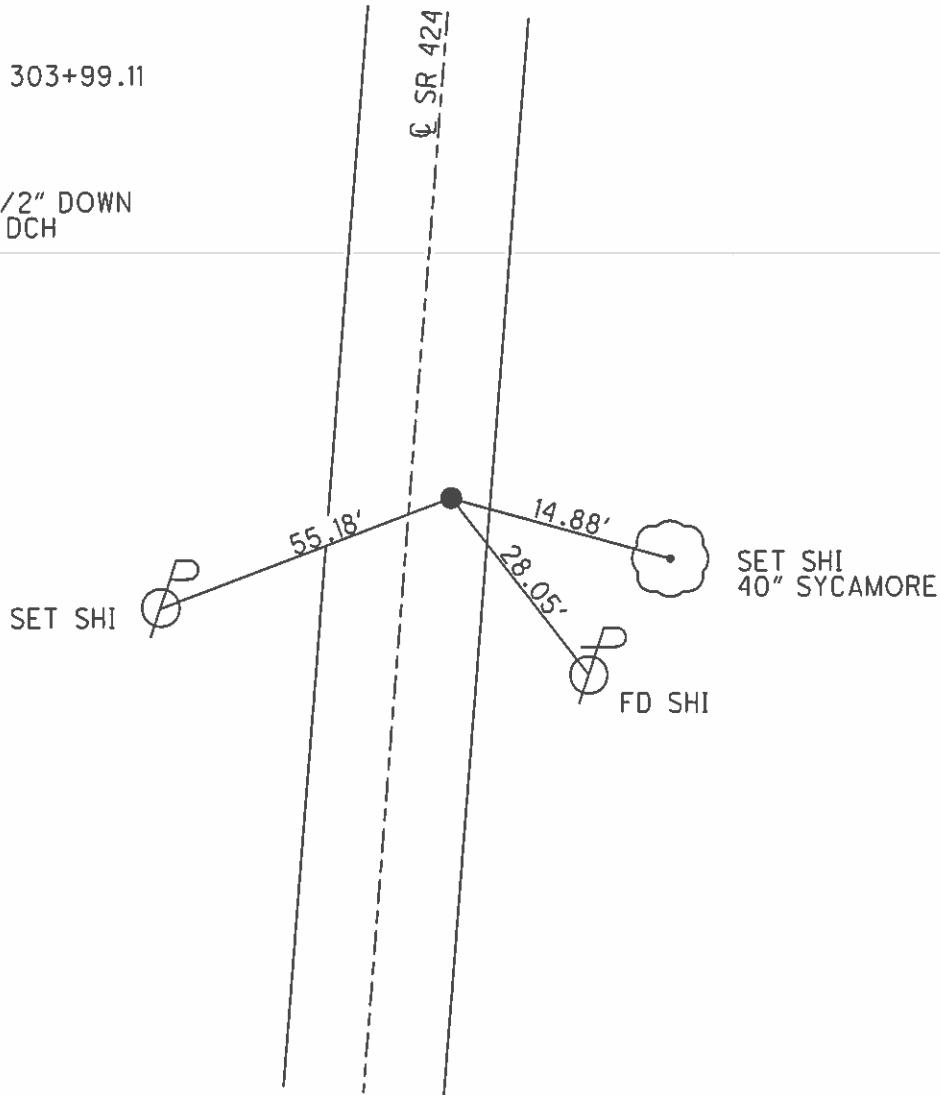

O.D.O.T. DISTRICT 2 SURVEY OFFICE

PERSONNEL

REFERENCE NO. 32

SHEET 30 OF 43

NOTES HOFFMAN

H.C. LOEHRKE

R.C. BARWITSEL

DATE 4-4-91

WEATHER CLEAR

TEMP. 50°

ROUTE SR 424

COUNTY HENRY

TOWNSHIP Napoleon

SECTION 35

T S N R 6 E

TYPE MONUMENT P.K. / WASHER



ON SURFACE - BELOW YES

LEFT - ~~C~~ PAV'T. - RIGHT 8.3


3.8' TO RT. EDGE PAVEMENT

S.L.M. 303+69

Set P.K. WASHER
5-23-91
E.H.

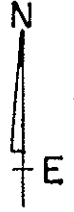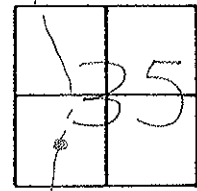

Record:
P.I. Sta. 303+99.11

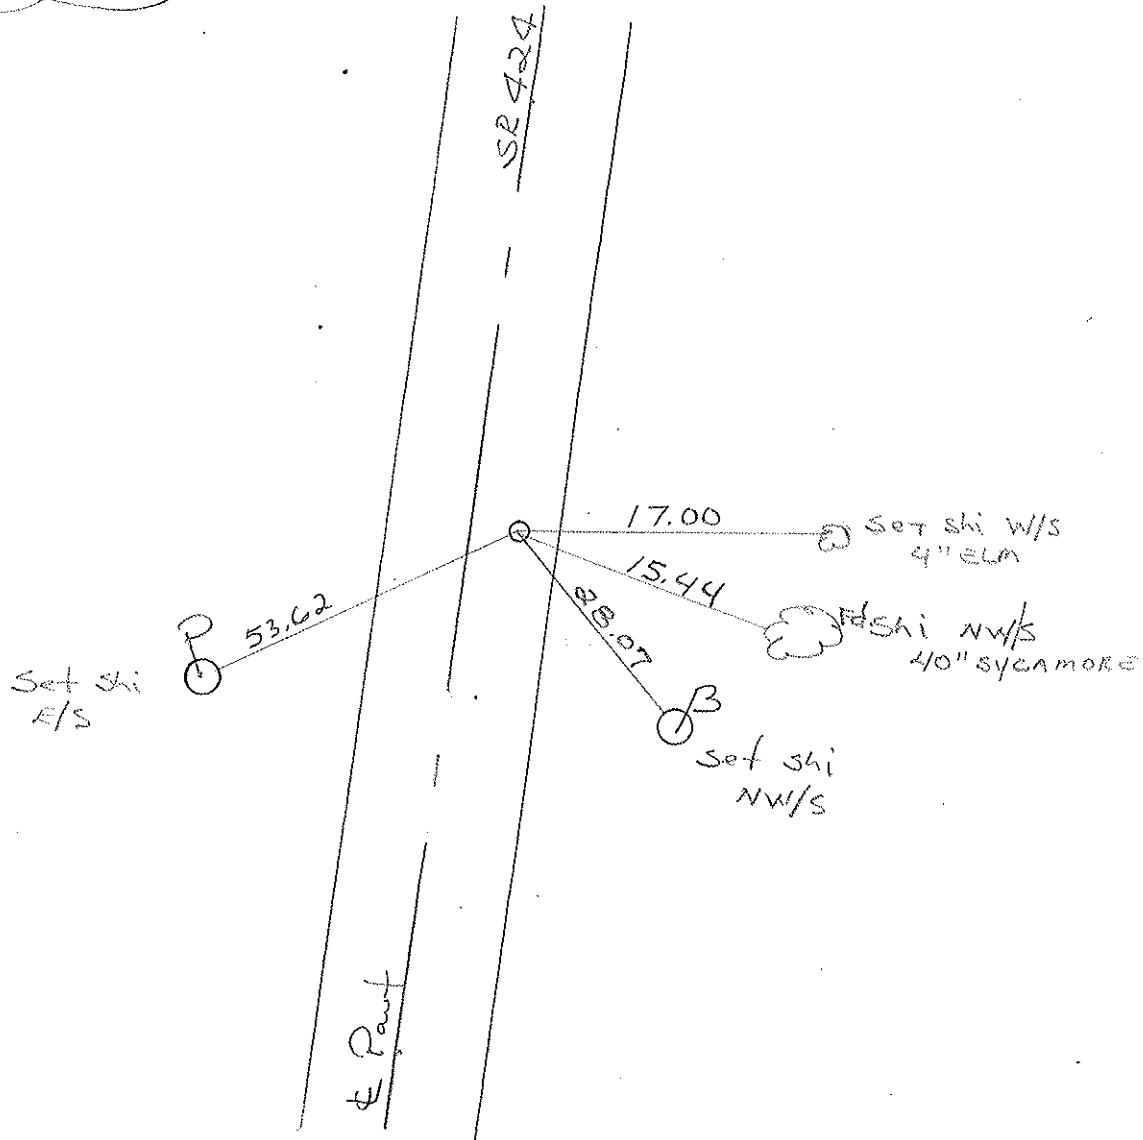

OD.O.T. DISTRICT 2 SURVEY OFFICE

SHEET _____ OF _____

County HENRY S.R. 424

Date MARCH 29, 83

Township NAPOLÉON


Weather P. CLEAR

Section 35

Temp. +38°

T5N, R6E

Personnel Hoffman

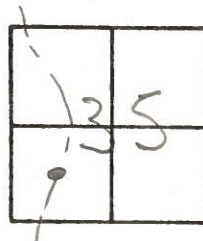

CREW

32

Fd R.R. SPK @ surface

7.8' RT. of & Pavt


3.8' TO E. EP.

20.0' TO W. EP.

SLM, 304+12

Record:
P.I. 303+99.11

SET PK & WASHER
M.B. 6-1783

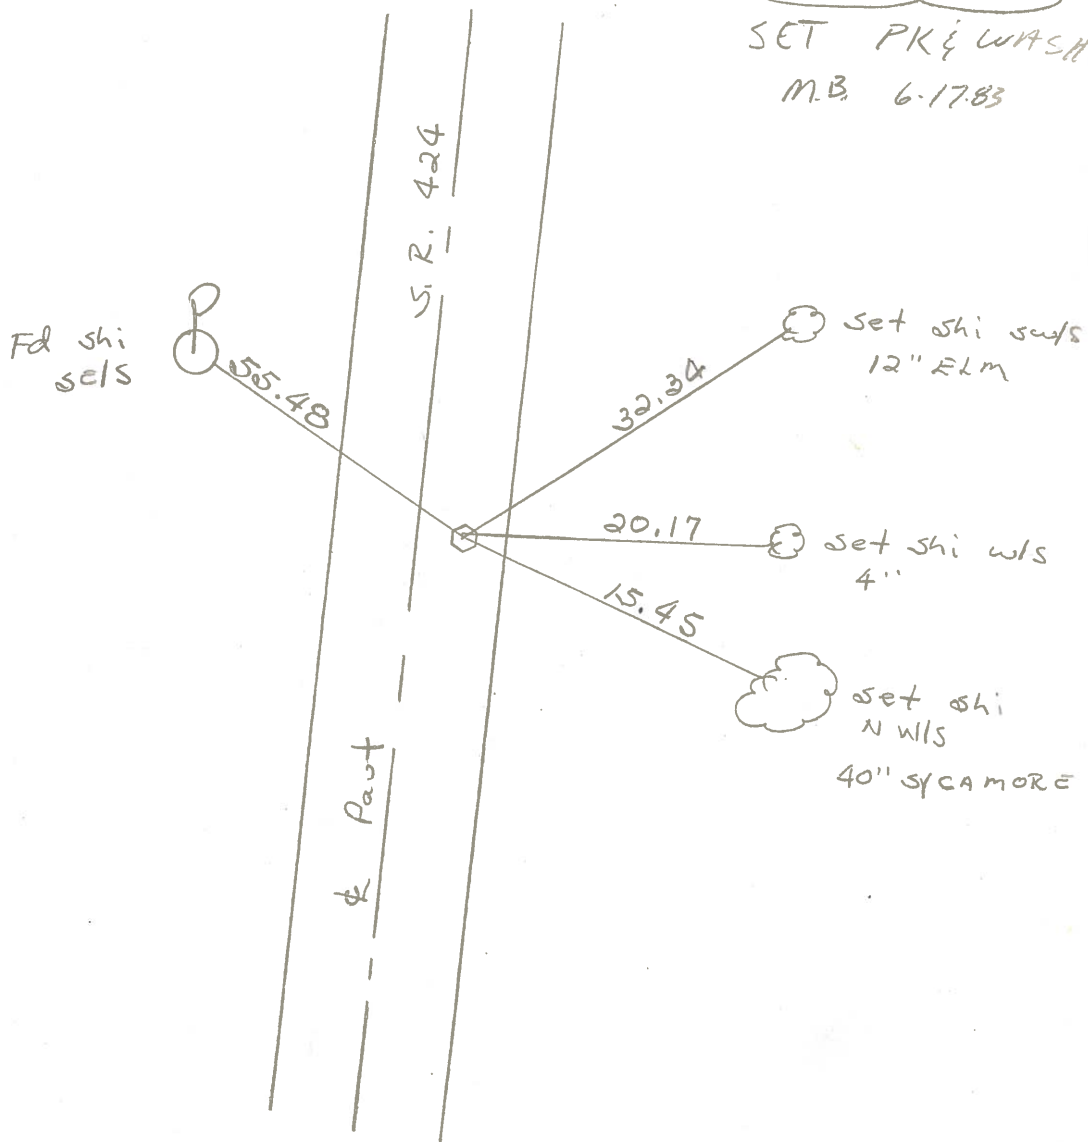

PERSONNEL	TITLE	PERSONNEL	TITLE
2msic			
laser			
yo			
angta			

COUNTY HENRY DATE MAY 31, 1972


S. R. 424 WEATHER

SEC. TEMP.

DESCRIPTION LEFT CENTER LINE RIGHT JOB NO.


Sta. 308+54 ±
308 + 70
34.1' Rt of & part

(35)

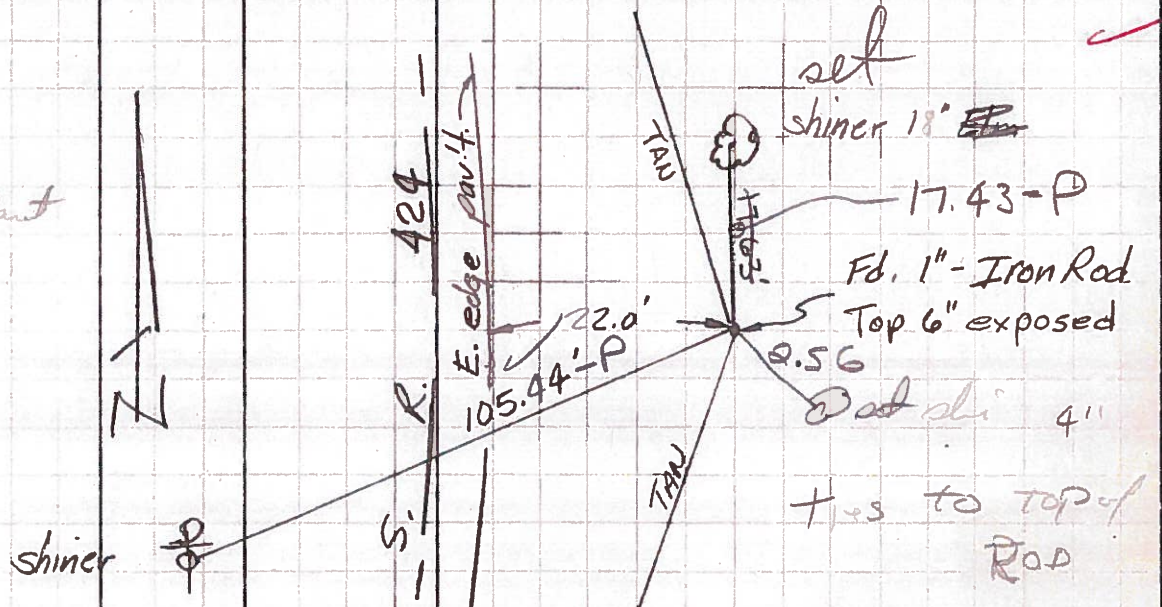


3-29-83 +38°
Sta. 303+99.11
P. I. 304+12
Rt of & 7.8
Rt up 3.8
Lt up 20.0

(32)

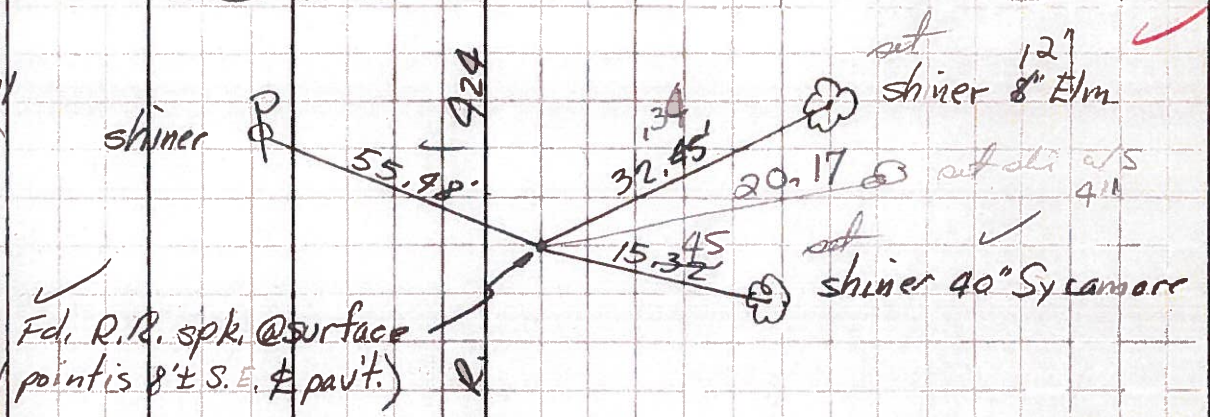

3-29-83 +38°
Sta. 299+30.35
P. I.
SLM 299+43
Rt up 10.2
Lt up 12.0
1.0' Rt of & part

(31)

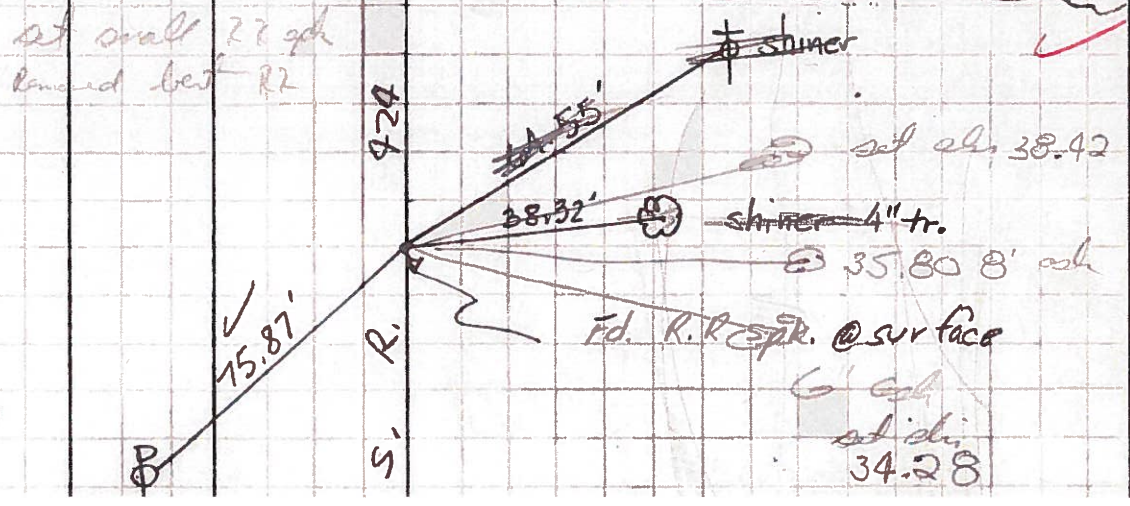


PERSONNEL TITLE PERSONNEL TITLE COUNTY Henry DATE 4- - 6:
Hoover _____
Hoff _____
Delventhal _____
 S. R. U.S.R. 24 WEATHER _____
 SEC. _____ TEMP. _____

DESCRIPTION Witnesses to Control Points (P.I. 3) JOB NO. _____
 LEFT CENTER LINE RIGHT

Forward Tangent


✓ P.I. - 299 + 30.35

(31)

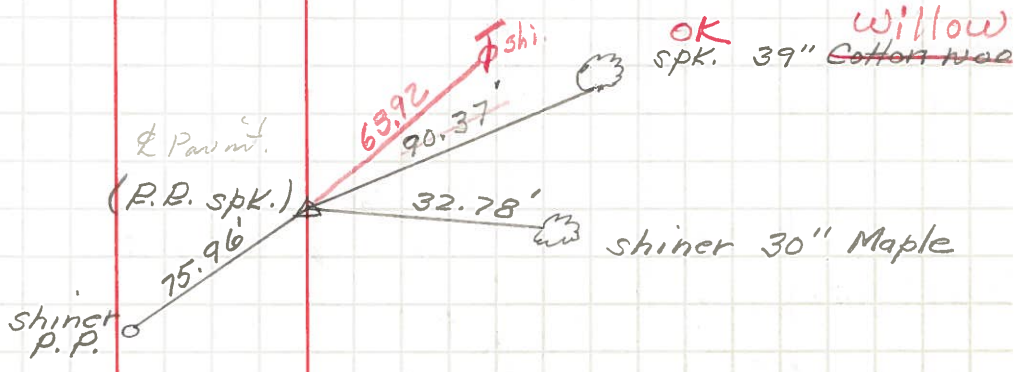

✓ P.I. - 303 + 99.11

(32)

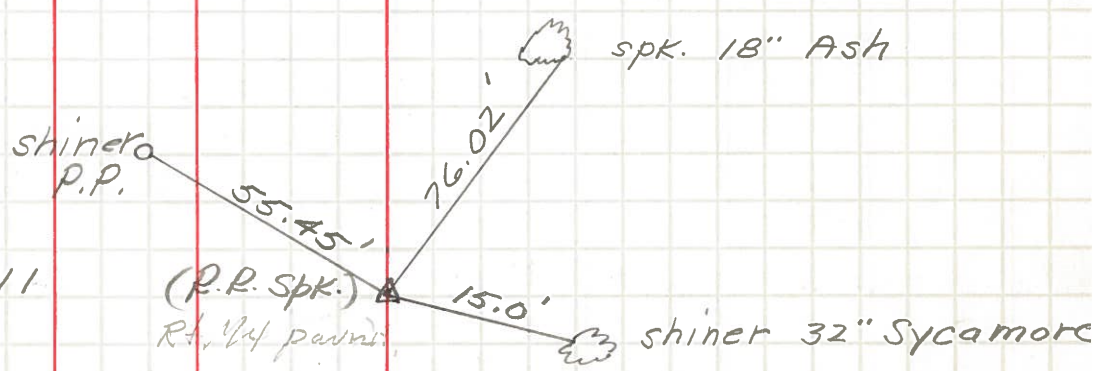

✓ P.I. - 310 + 57.79

(35-A)

