


O.D.O.T. DISTRICT 2 SURVEY OFFICE (USE ONLY)


PERSONNEL _____ REFERENCE NO. 35 A SHEET 33 OF 48
 NOTES HOMAN DATE 03/09/12 ROUTE SR 424
 H.C. HOMAN WEATHER CLEAR COUNTY HENRY
 R.C. ROUSOS TEMP. 30° TOWNSHIP NAPOLEON
 _____ SECTION 35
 _____ T 5 N R 6 E

TYPE MONUMENT P.K./WASHER
 ON SURFACE - ~~BELOW~~ ON
~~LEFT - C PAV'T - RIGHT~~ 12.4'
1.2' TO RT EDGE PAVEMENT
 S.L.M. 310+12.74

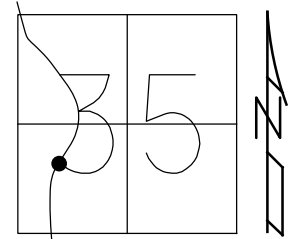

Grid: Northing: 616095.039 Easting: 1516767.672

RECORD: P.I.
 STA. 310+57.79
 $\Delta = 10^\circ 23' 46''$ LT
 SET PK/WASHER
 5/23/91, CL
 FD P.K./WASHER
 12/30/08
 A103
 REF35
 FD P.K.NAIL
 2/22/12, DCH

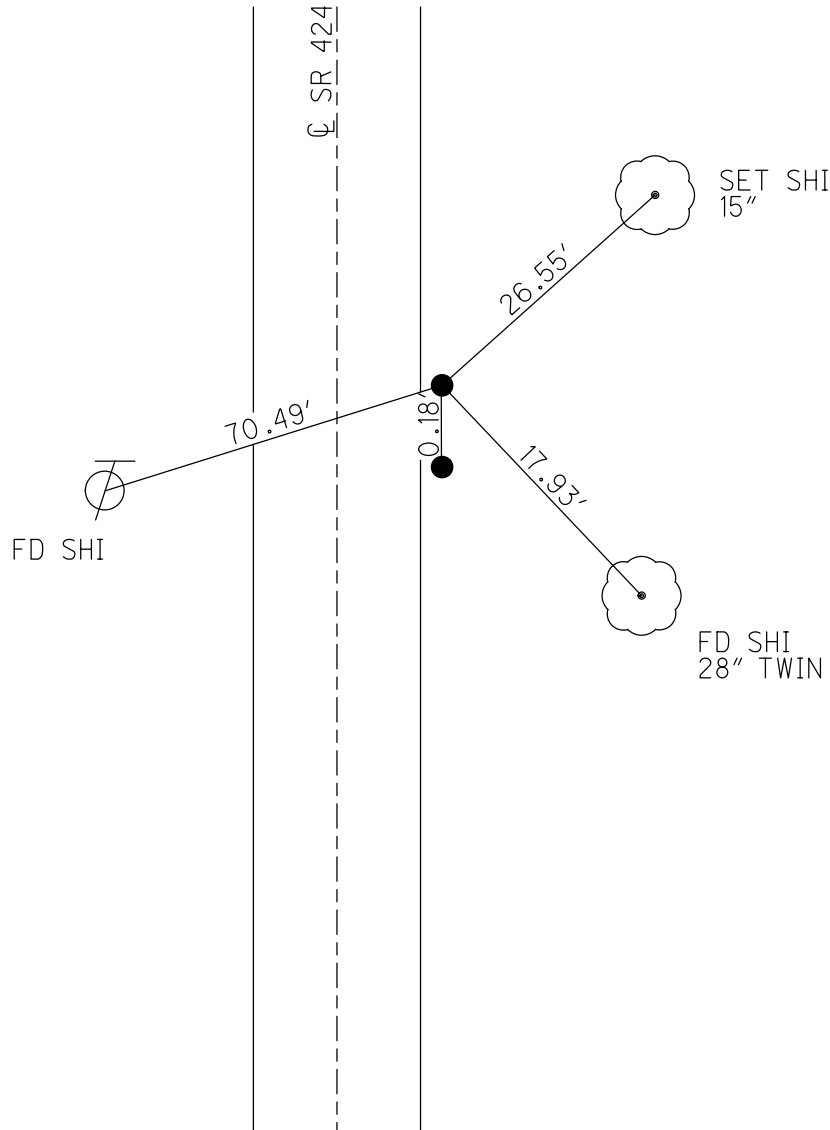

O.D.O.T. DISTRICT 2 SURVEY OFFICE

PERSONNEL

REFERENCE NO. 35A

SHEET 32 OF 43

NOTES HOFFMAN

H.C. LOHRKE

R.C. BARWISER

DATE 4-4-91

WEATHER CLEAR

TEMP. 50°

ROUTE SR 424

COUNTY HENRY

TOWNSHIP NAPOLEON

SECTION 35

T 5 N R 6 E


"A"	"B"
TYPE MONUMENT <u>P.K./WASHER</u>	<u>P.K./WASHER</u>

ON SURFACE - BELOW <u>YES</u>	<u>YES</u>	SET P.K./WASHER
-------------------------------	------------	-----------------


LEFT - <u>C</u> PAVT. - RIGHT <u>12.4'</u>	<u>12.4'</u>	BOTH POINTS
--	--------------	-------------

<u>12'</u> TO RT EDGE PAVEMENT	<u>5.23-91</u>	CL
--------------------------------	----------------	----

S.L.M. PT. A = 310+27

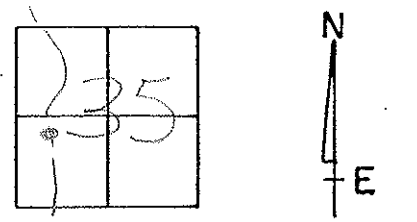

RECORD:
Sta. 310 + 57.79

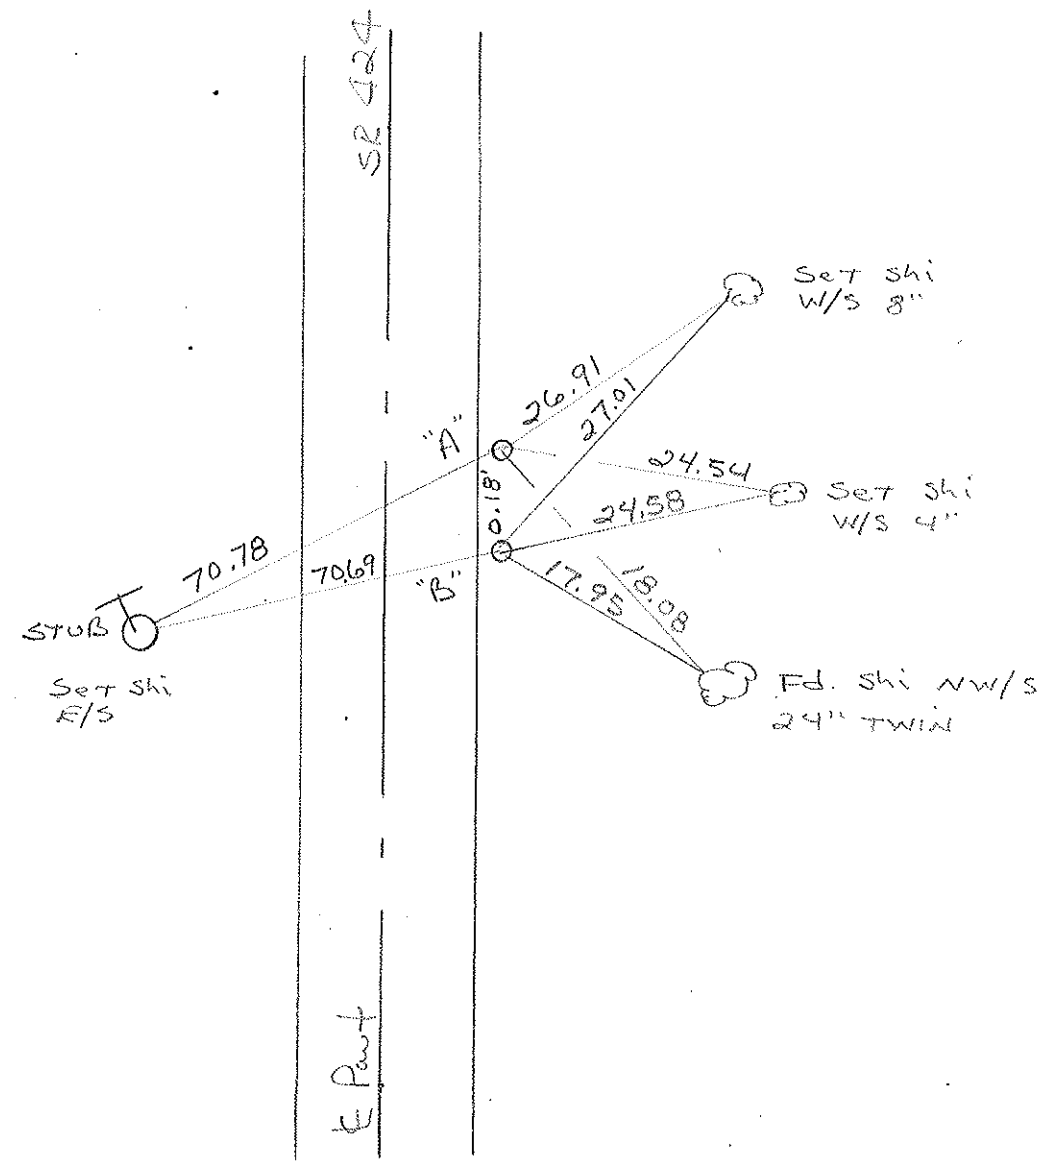

O.D.O.T. DISTRICT 2 SURVEY OFFICE

SHEET _____ OF _____

County HENRY S.R. 424

Date MARCH 29, 83

Township NAPOLEON


Weather P. CLEAR

Section 35

Temp. +38°

T5N, R6E

Personnel HOFFMAN

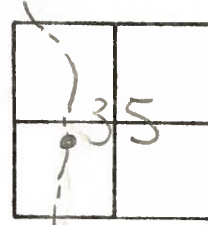

35A


+
CREW

Pt "A" Fd 1" IRON ROD @ SURFACE
12.3' Rt of & Paut
1.2' Rt of E.F.P.

S.L.M. 310+70


Pt "B" Fd 1/2" IRON ROD @ SURFACE
12.3' Rt. of & Paut
1.2' Rt. of E.F.P.

Record:
Sta. 310+57.79
SET PK'S & WASHER
MB. 6-17-83

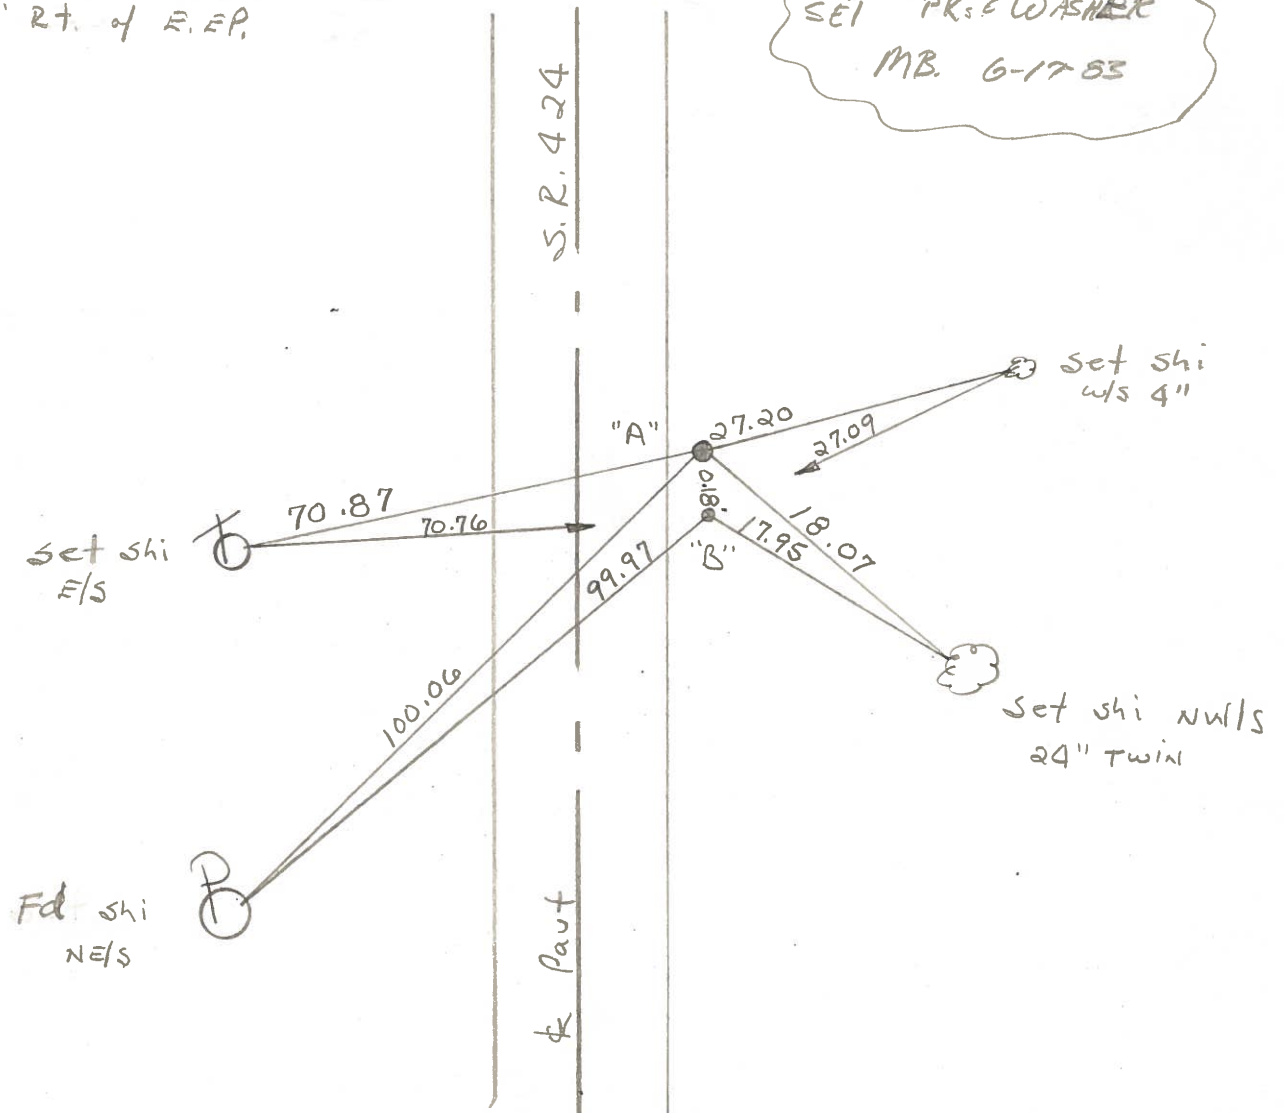

PERSONNEL	TITLE	PERSONNEL	TITLE	COUNTY	HENRY	DATE	May 31, 1977
Tansic				S. R.	424	WEATHER	
Weuser				SEC.		TEMP.	
Granata							

DESCRIPTION LEFT CENTER LINE RIGHT JOB NO.

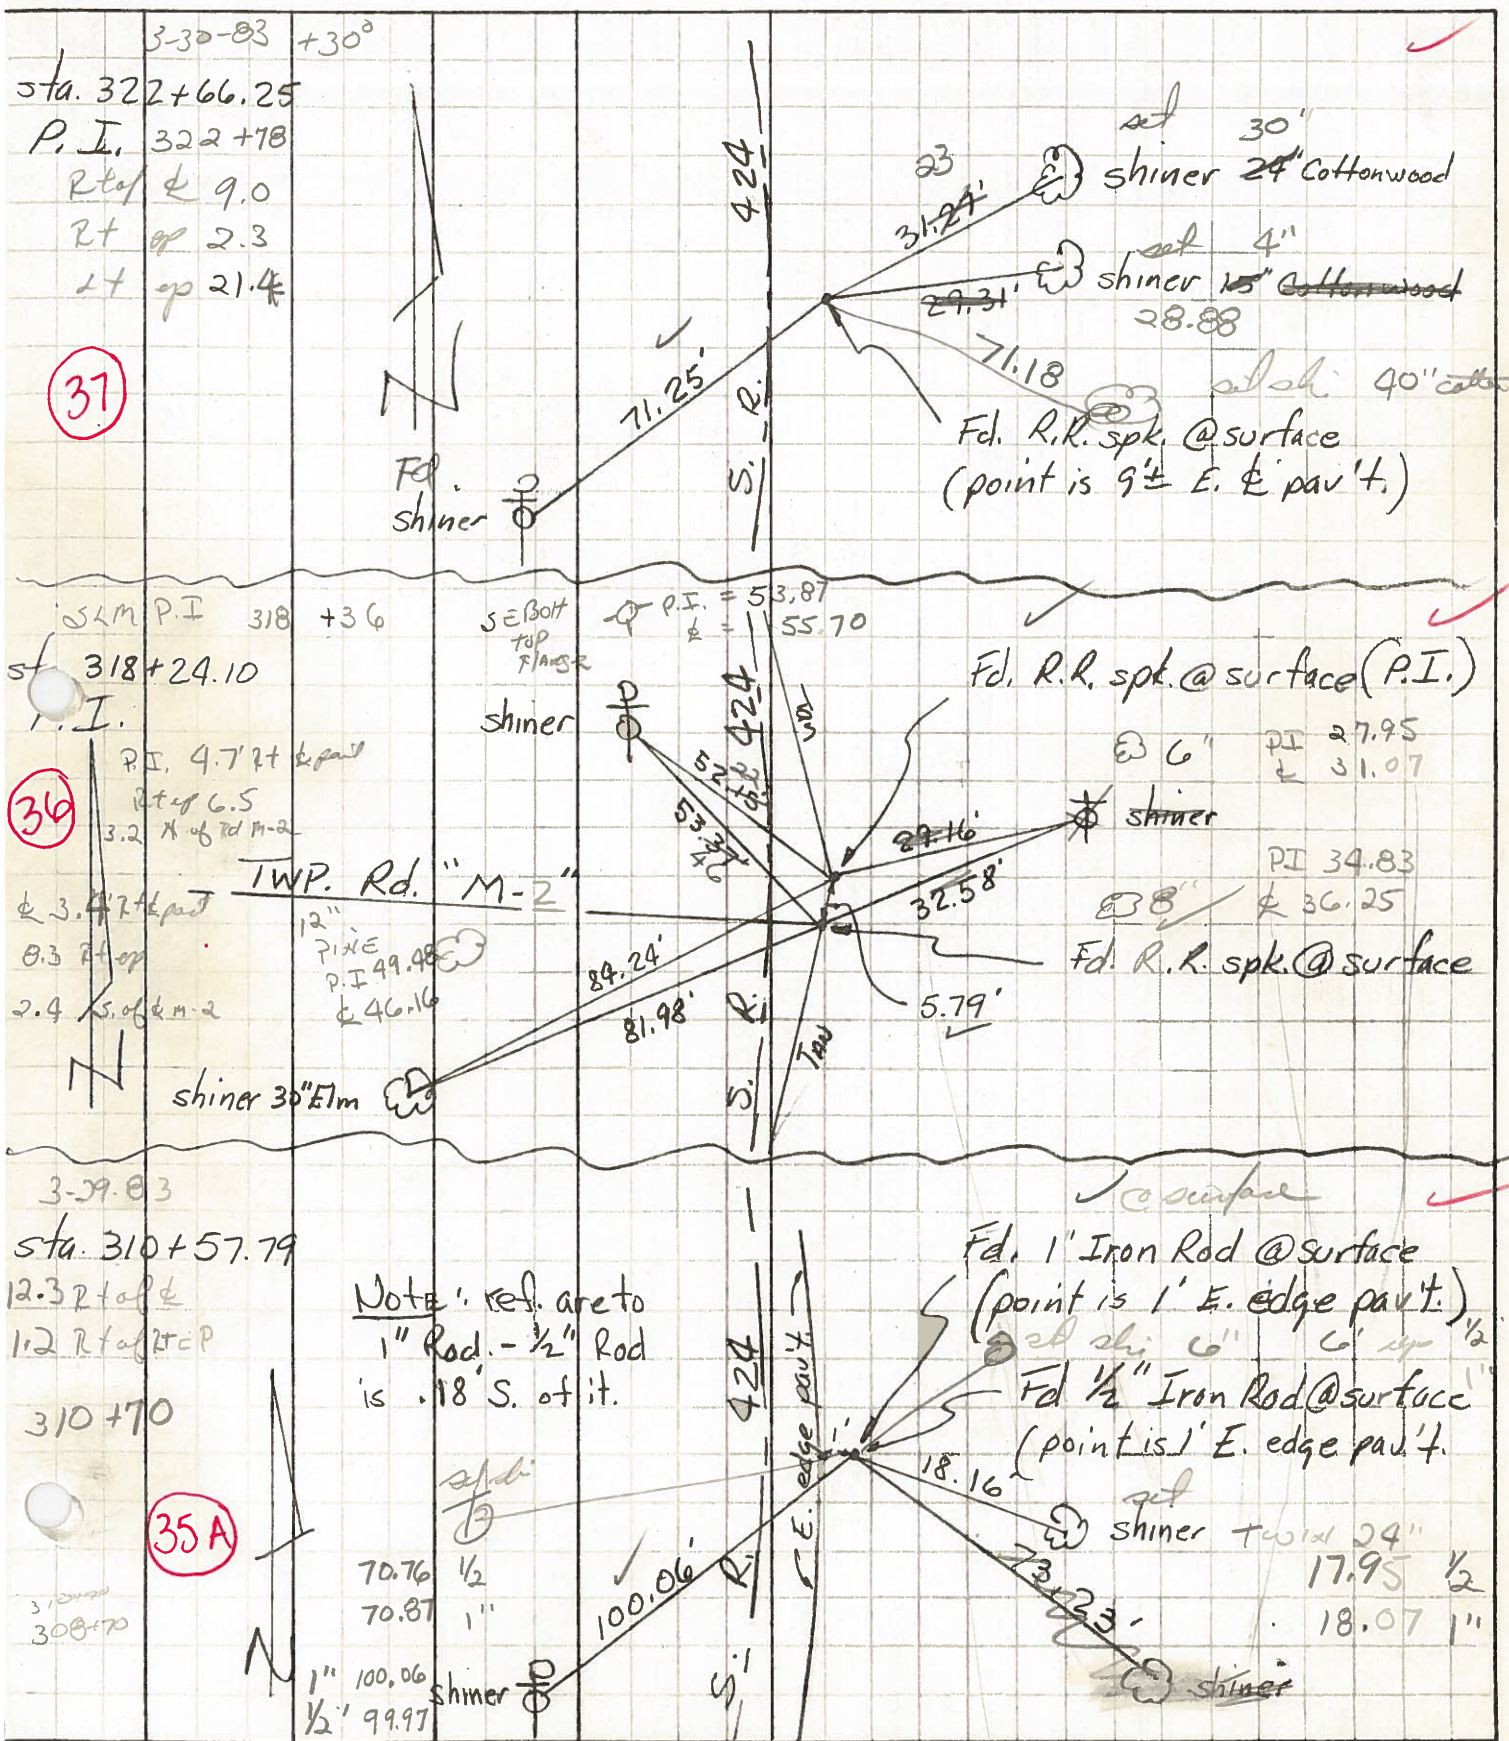


PERSONNEL TITLE PERSONNEL TITLE COUNTY Henry DATE 4- - 6:
Hoover _____
Hoff _____
Delventhal _____
 S. R. U.S.R. 24 WEATHER _____
 SEC. _____ TEMP. _____

DESCRIPTION Witnesses to Control Points (P.I. 3) JOB NO. _____
 LEFT CENTER LINE RIGHT

Forward Tangent


✓ P.I. - 299 + 30.35

(31)

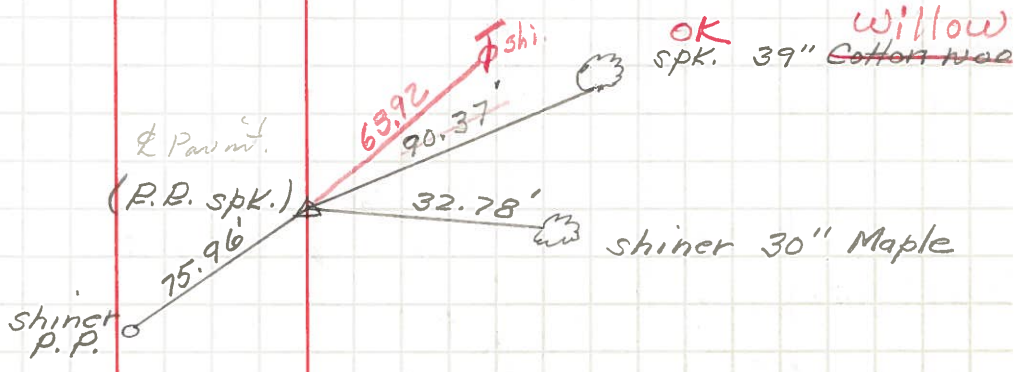

✓ P.I. - 303 + 99.11

(32)

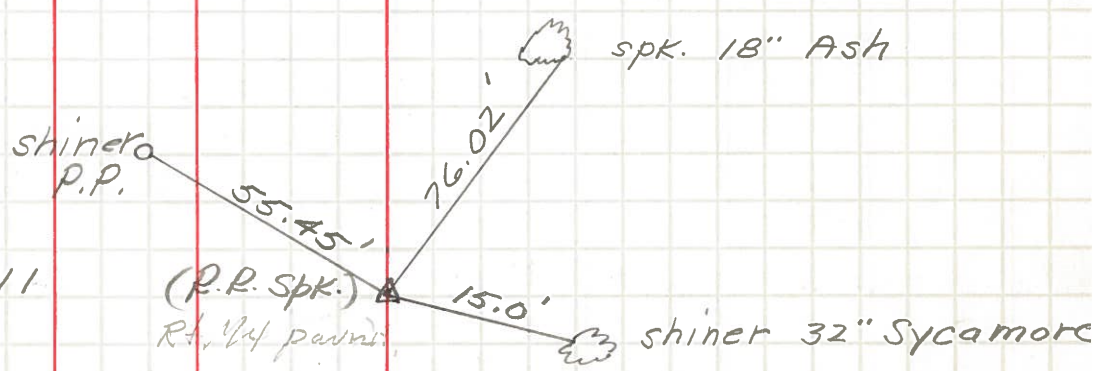

✓ P.I. - 310 + 57.79

(35-A)

