


O.D.O.T. DISTRICT 2 SURVEY OFFICE (USE ONLY)


PERSONNEL _____ REFERENCE NO. 36-A SHEET 36 OF 48

NOTES HOMAN DATE 02/22/12 ROUTE SR 424
 H.C. HOMAN WEATHER CLOUDY COUNTY HENRY
 R.C. ROUSOS TEMP. 40° TOWNSHIP NAPOLEON
 SECTION 35
 T 5 N R 6 E

TYPE MONUMENT _____ PK/WASHER _____
 ON SURFACE - ~~BELOW~~ _____ ON _____
~~LEFT~~ - ~~C~~ PAV'T - RIGHT _____ 3.9' _____
8.3 TO RT EDGE PAVEMENT
 S.L.M. _____
 Grid: Northing: _____ Easting: _____

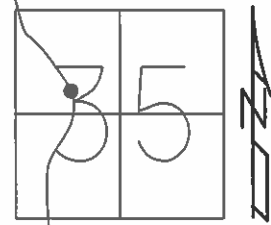

RECORD:
 POINT "A"
 P.I. STA. 318+29.10
 OK FD
 12/30/08
 #131
 REF37
 FD PK 2" DOWN
 02/22/12 DCH

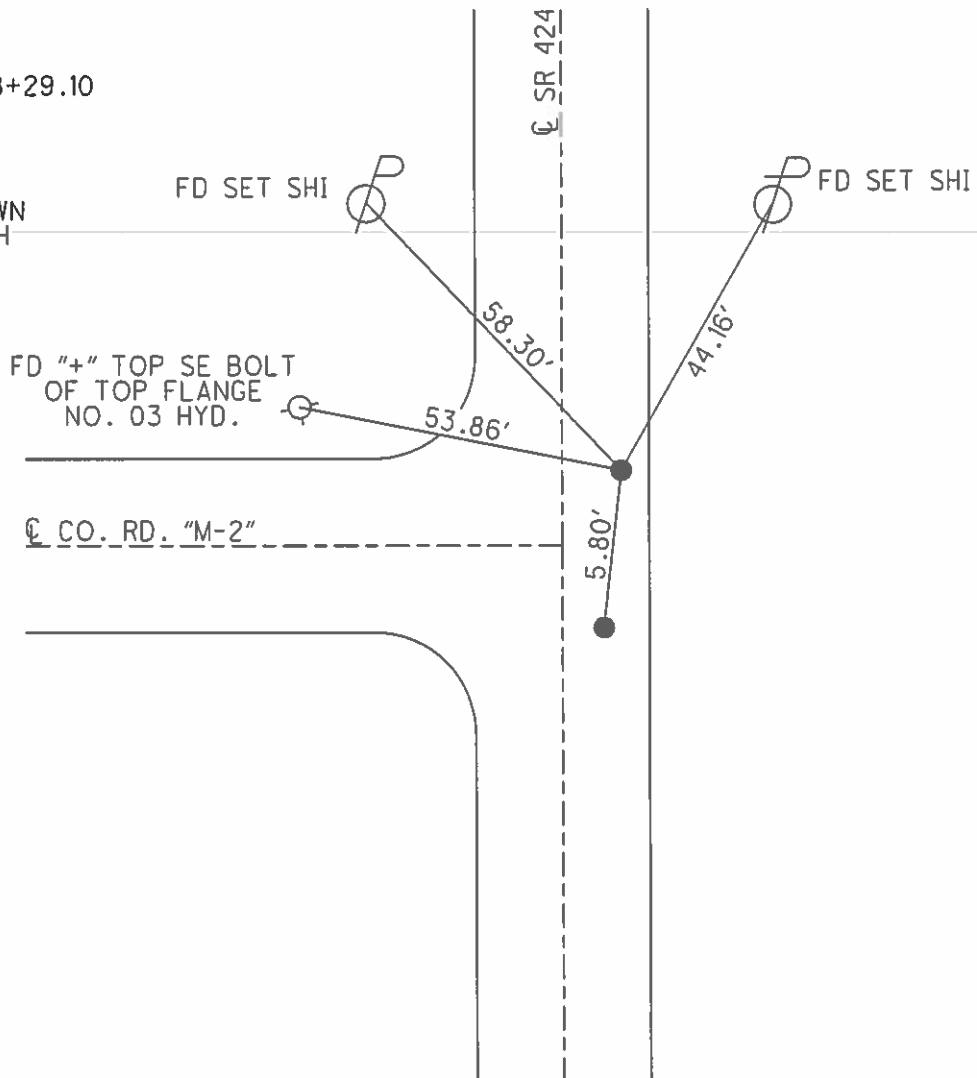

O.D.O.T. DISTRICT 2 SURVEY OFFICE

SHEET _____ OF _____

County HENRY S.R. 424

Township NAPOLEON

Section 35

T5N, R6E

Personnel HOFFMAN

+


CREW

36

Date MARCH 29, 83

Weather P. CLEAR

Temp. +40°

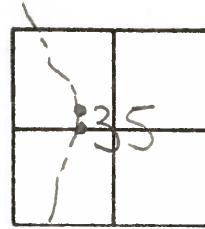


Pt. "A" Fd R.R. SPK @ SURFACE
 4.7' RT of & PAUT SR 424
 6.5' TO E.P. SR 424
 3.2' NORTH of & PAUT Co. Rd "M-2"

SLM 318+36

Record:
 P.I. 318+24.10


SET PK'S & WASACR
 MB 6-17-83

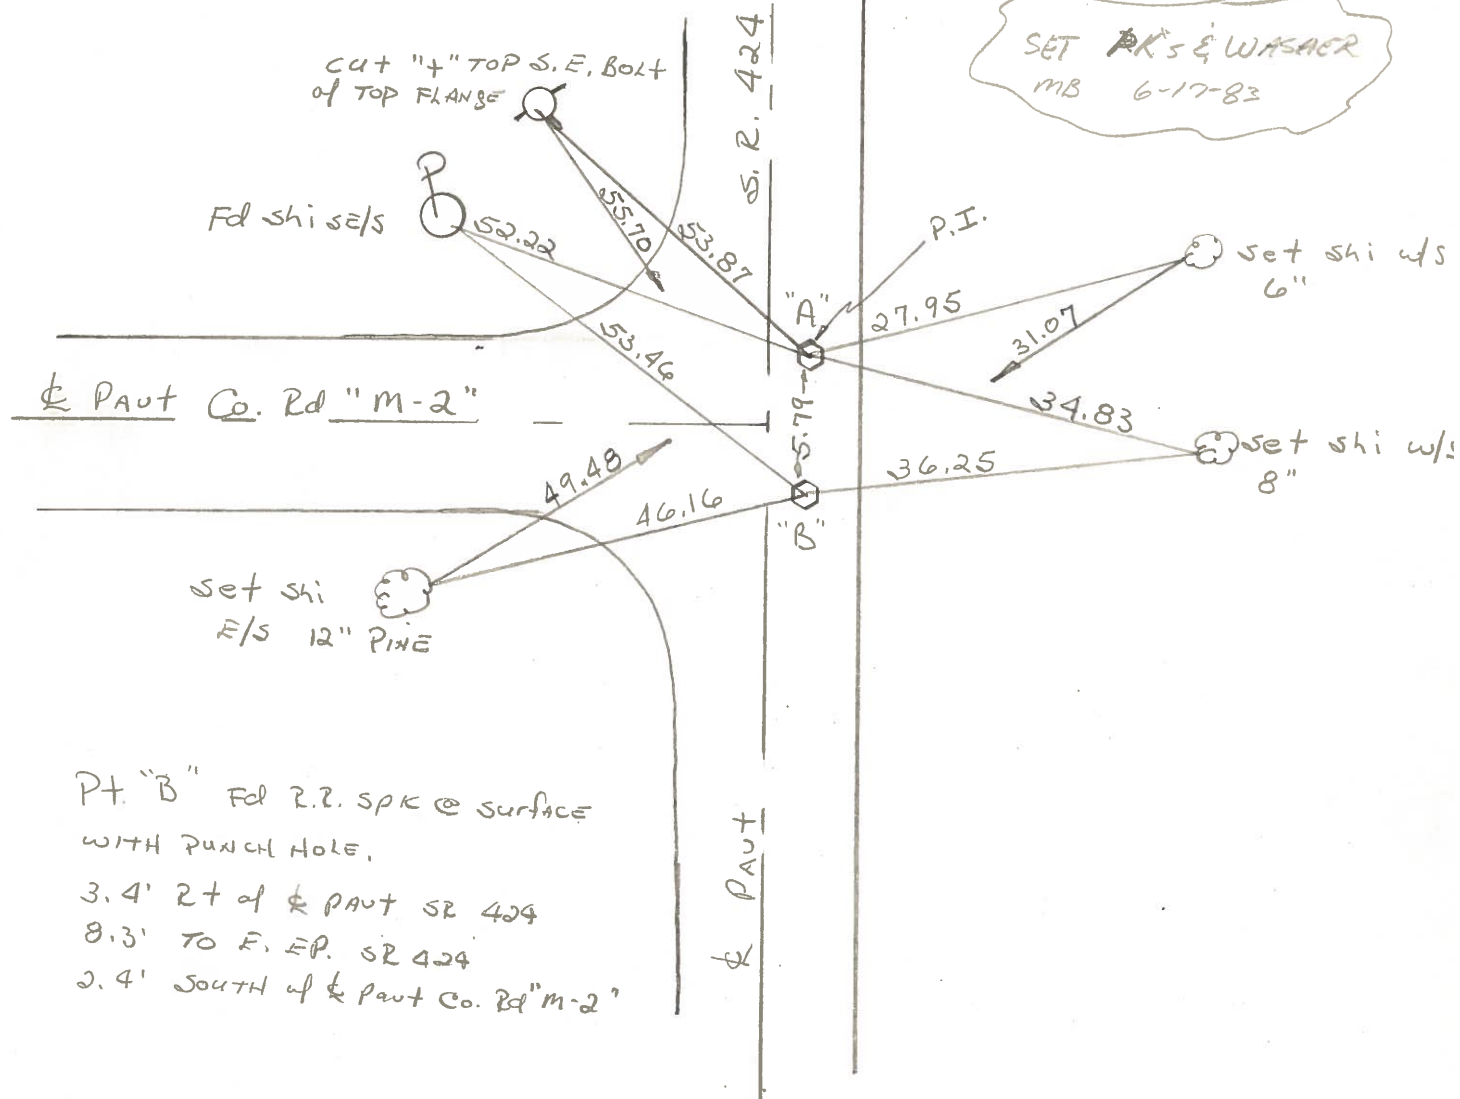

Pt. "B" Fd R.R. SPK @ SURFACE
 WITH PUNCH HOLE.
 3.4' RT of & PAUT SR 424
 8.3' TO E.P. SR 424
 2.4' SOUTH of & PAUT Co. Rd "M-2"

PERSONNEL	TITLE	PERSONNEL	TITLE	COUNTY	DATE
Tomsic				HENRY	May 31, 1977
Jaiser				S. R.	424
				WEATHER	
				SEC.	
				TEMP.	

DESCRIPTION	LEFT	CENTER LINE	RIGHT	JOB NO.
-------------	------	-------------	-------	---------

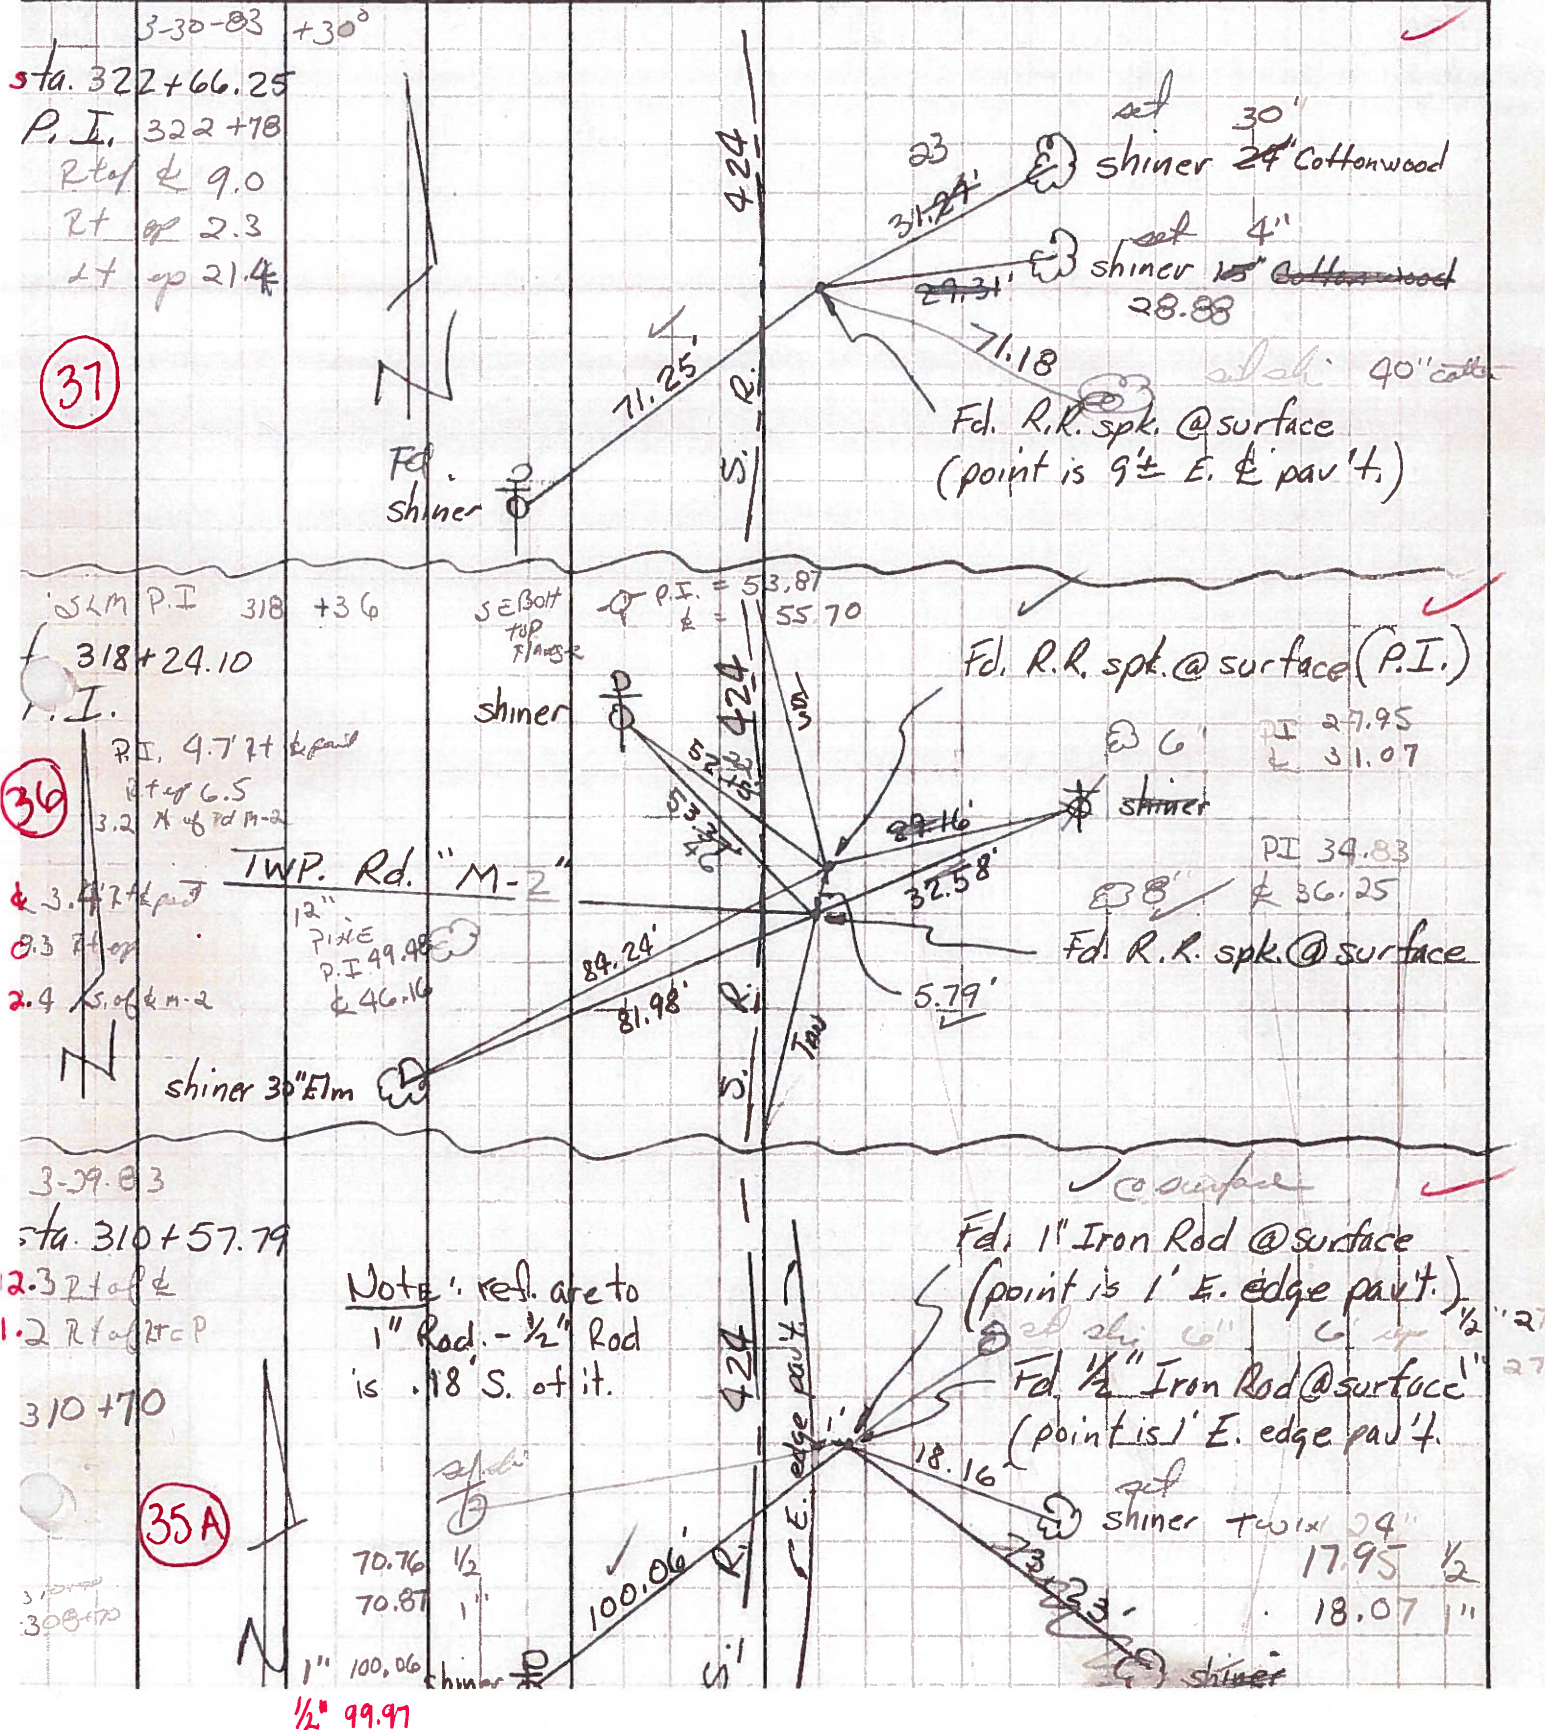

1/2" 99.97

PERSONNEL TITLE PERSONNEL TITLE

Hoover
Hoff
Delventhal

COUNTY Henry DATE 4- -62

S. R. U.S.R. 24 WEATHER


SEC. TEMP.

DESCRIPTION Witnesses to Control Points (P.I.) JOB NO.

LEFT CENTER LINE RIGHT



Forward Tangent

✓ P.I. - 318 + 24.10
Inter. Twp. Rd M.2

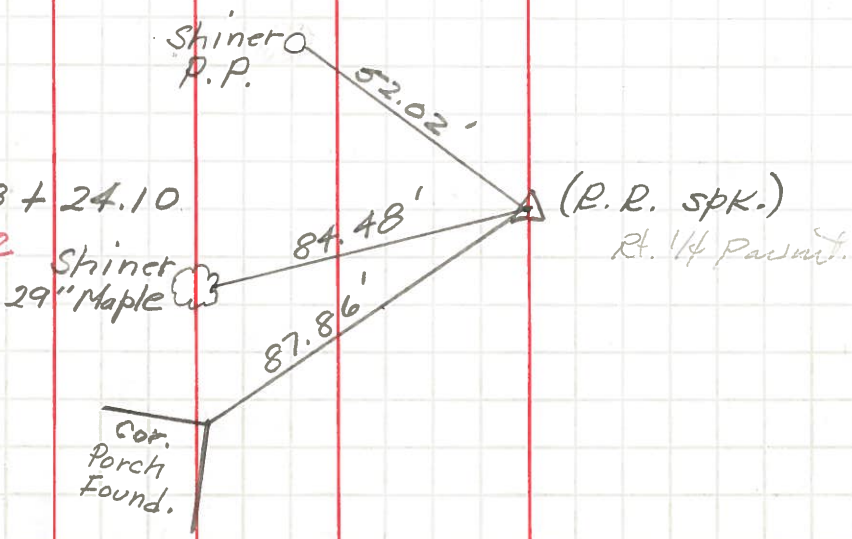

✓ P.I. - 322 + 66.25

(37)

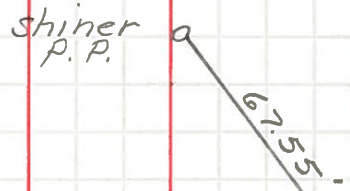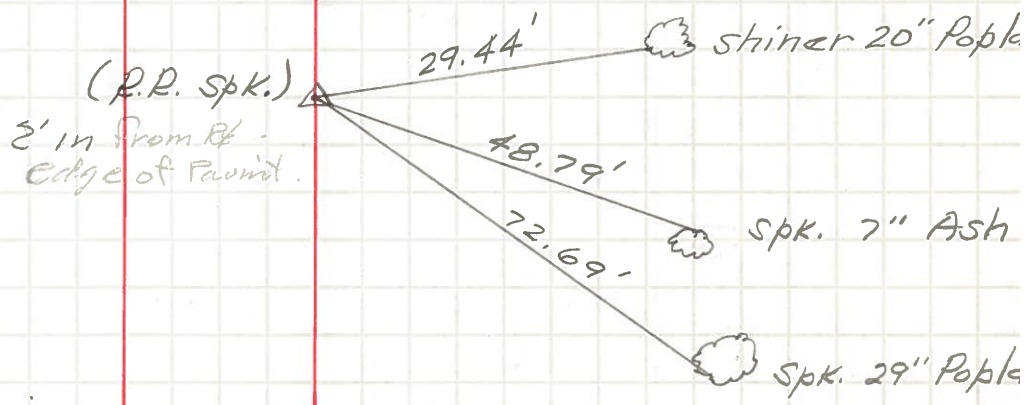

✓ P.I. - 327 + 06.63

(37-A)

