



O.D.O.T. DISTRICT 2 SURVEY OFFICE (USE ONLY)

PERSONNEL _____ REFERENCE NO. 37 SHEET 37 OF 48
 NOTES HOMAN DATE 03/09/12 ROUTE SR 424
 H.C. HOMAN WEATHER CLEAR COUNTY HENRY
 R.C. ROUSOS TEMP. 30° TOWNSHIP NAPOLEON
 _____ SECTION 35
 _____ T 5 N R 6 E

TYPE MONUMENT PK/WASHER
 ON SURFACE - ~~BELOW~~ ON
~~LEFT~~ - ~~C PAV'T~~ - RIGHT 9.7
2.5 TO RT EDGE PAVEMENT
 S.L.M. 322+36
 Grid: Northing: 617300.957 Easting: 1516684.865

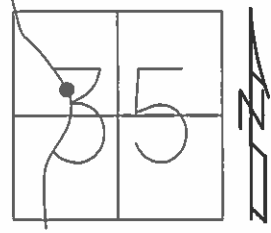

Record:
 P.I. STA. 322+66.25
 SET PK/WASHER
 05/24/91 CL
 OK FD
 12/30/08
 #132
 REF38
 FD PK
 02/22/12 DCH

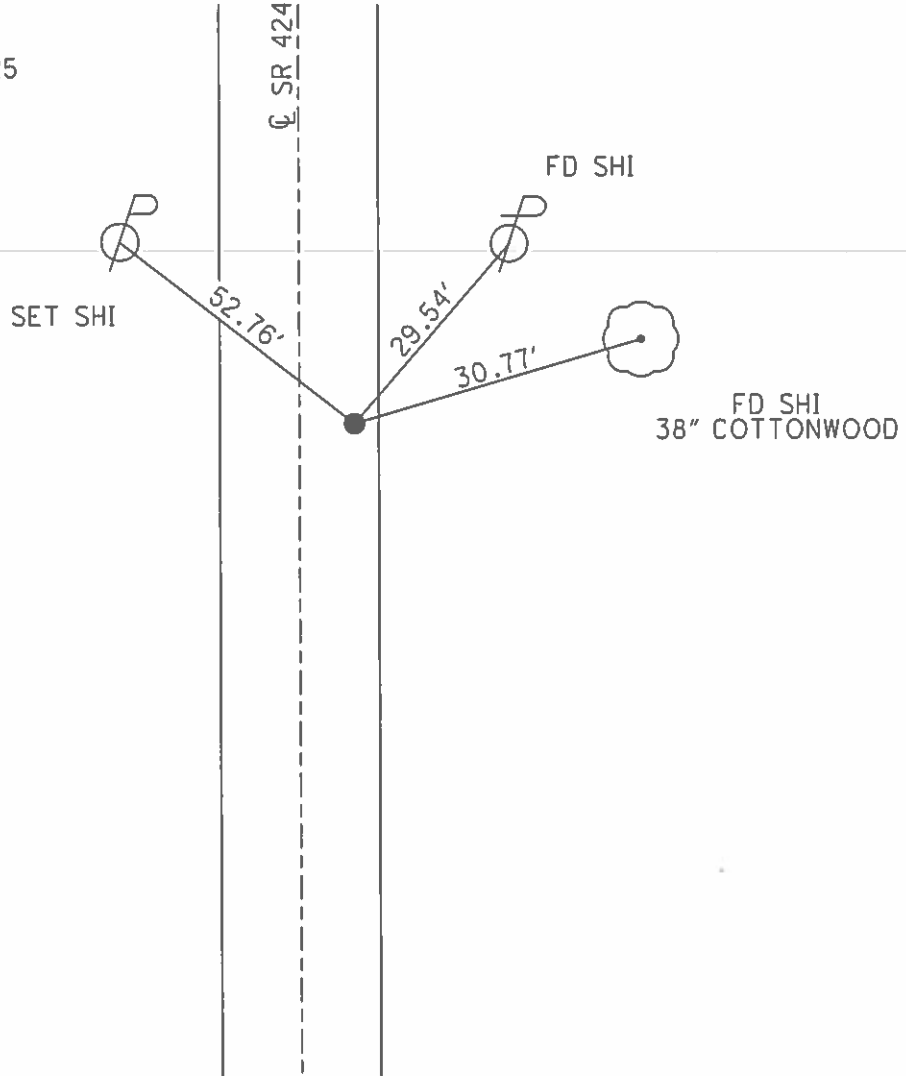

O.D.O.T. DISTRICT 2 SURVEY OFFICE

PERSONNEL _____

REFERENCE NO. 37

SHEET 34 OF 43

NOTES Hoffman

H.C. LOGHRS

R.C. BARWISSL

DATE 4-4-91

WEATHER CLEAR

TEMP. 50°

ROUTE SR 424

COUNTY HENRY

TOWNSHIP NAPOLEON

SECTION 35

T 5 N R 6 E

TYPE MONUMENT P.K./WASHER


ON SURFACE - BELOW YES

~~LEFT~~ PAV'T. - RIGHT 9.7


2.5 TO RT EDGE PAVEMENT

S.L.M. 322 + 36

Set P.K./washer
5-24-91
C.L.

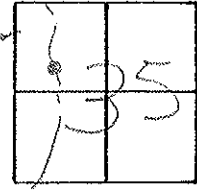

RECORD!
P.I. sta. 322 + 66.25

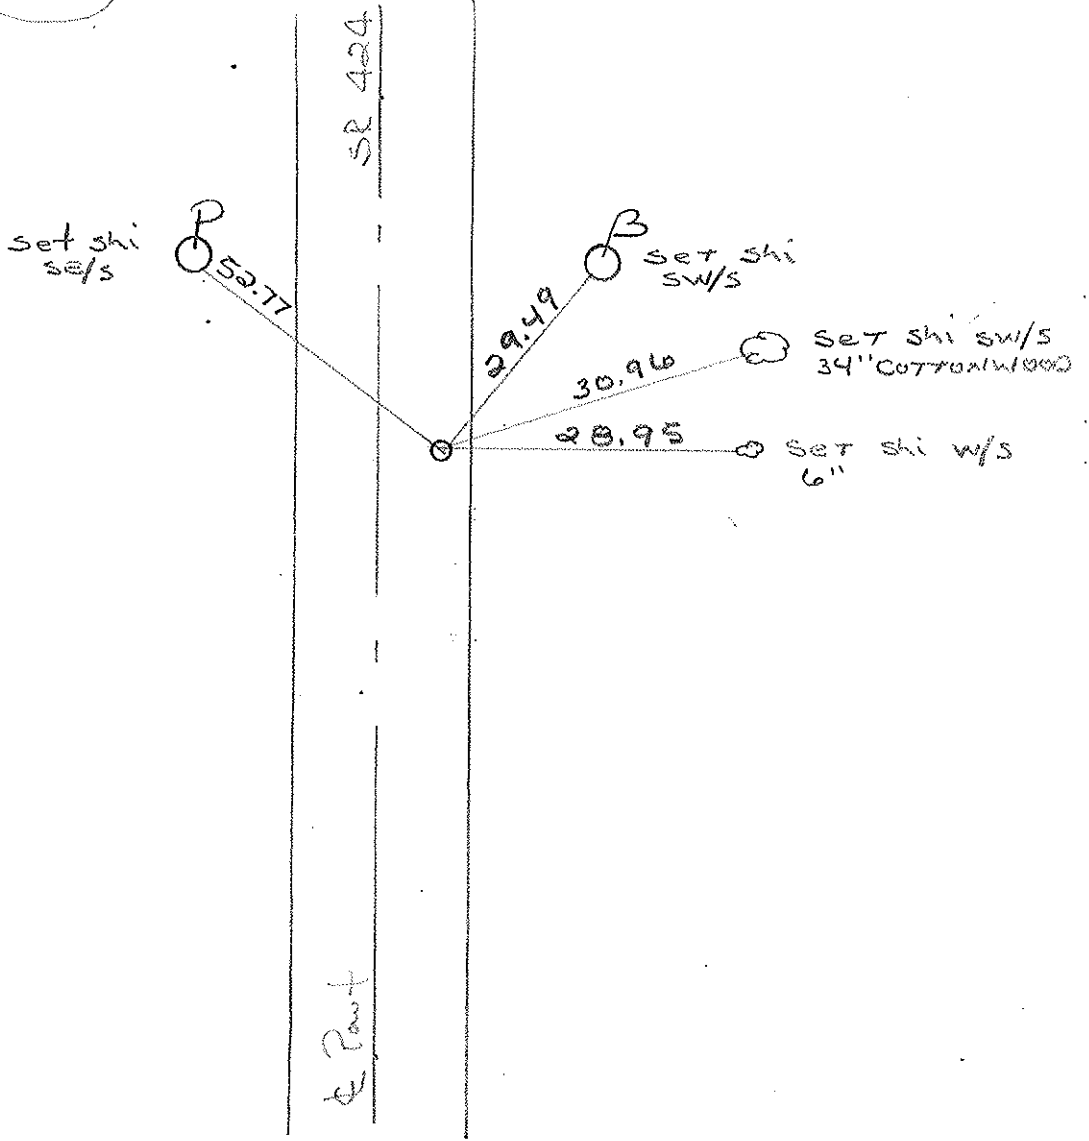

ODOT. DISTRICT 2 SURVEY OFFICE

SHEET _____ OF _____

County HENRY S.R. 424

Township NAPOLEON

Section 35

T5N, R6E

Personnel HOFFMAN

HOUSEHOLDER

LOENRKE ○


BARWHISGL ○

37

Date MARCH 30, 83

Weather P. CLEAR

Temp. +30°

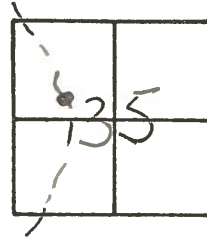

Fd P.R. SPK @ SURFACE

9.0' RT of & Pavt

2.3 TO F.E.P.

21.4 TO W.E.P.


S.L.M. 322 + 78

Record:

P.I. 322 + 66.25

SET PK & WASHER


MB - 6-17-83

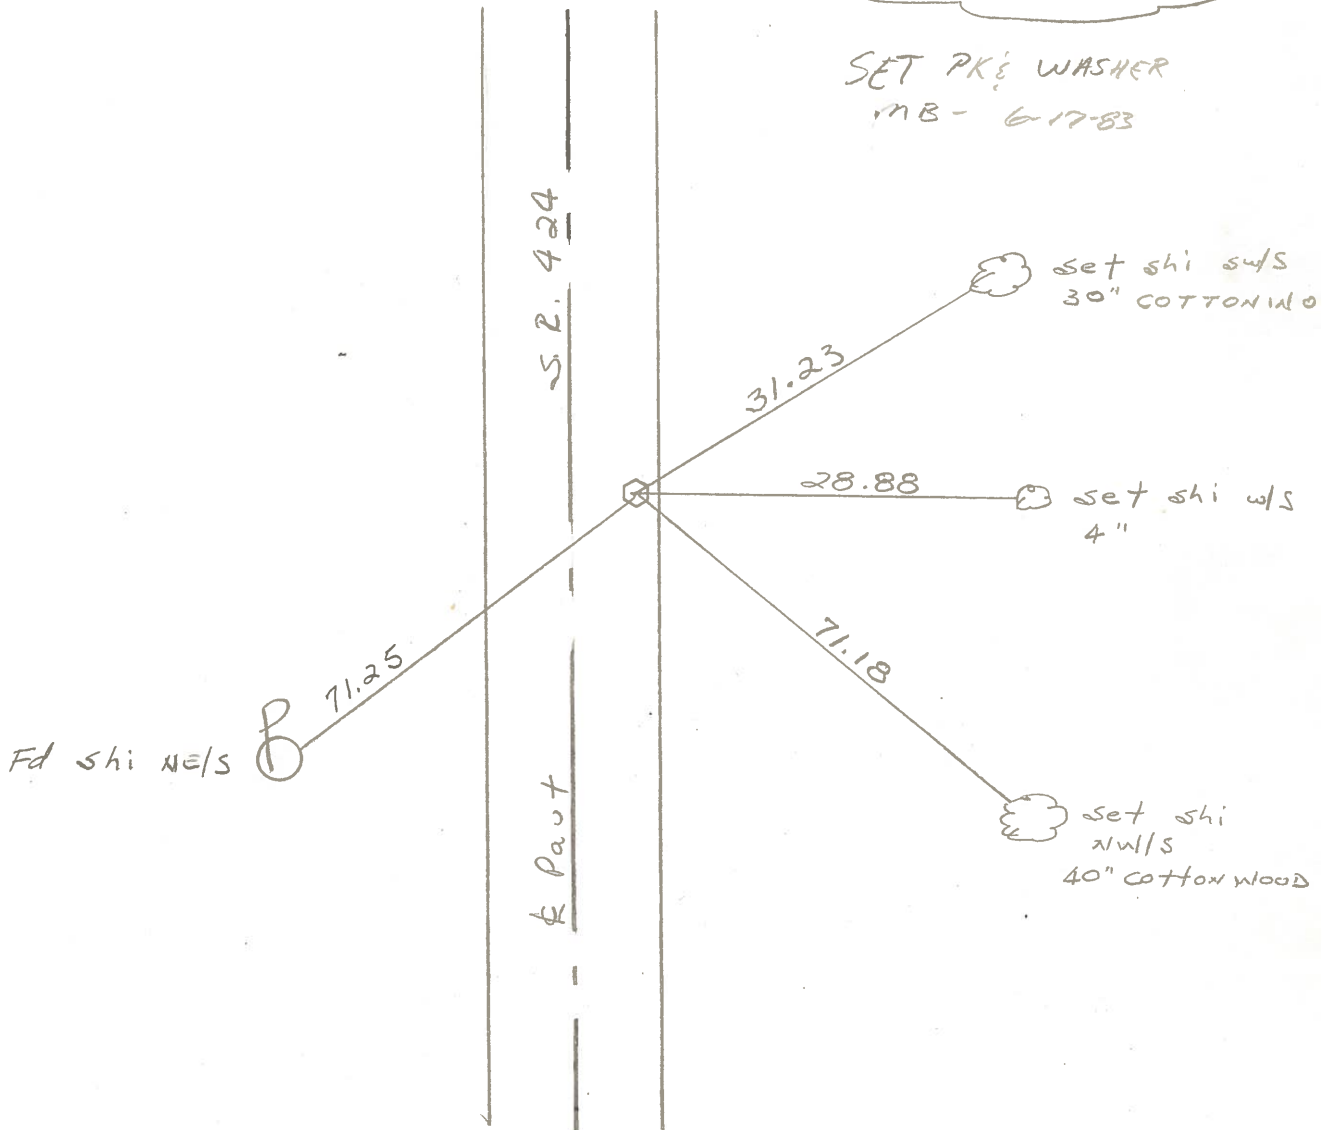

PERSONNEL	TITLE	PERSONNEL	TITLE
Tomsic			
Jusser			
...			
...			

COUNTY HENRY DATE May 31, 1977
 S. R. 424 WEATHER _____
 SEC. _____ TEMP. _____

DESCRIPTION LEFT CENTER LINE RIGHT JOB NO. _____

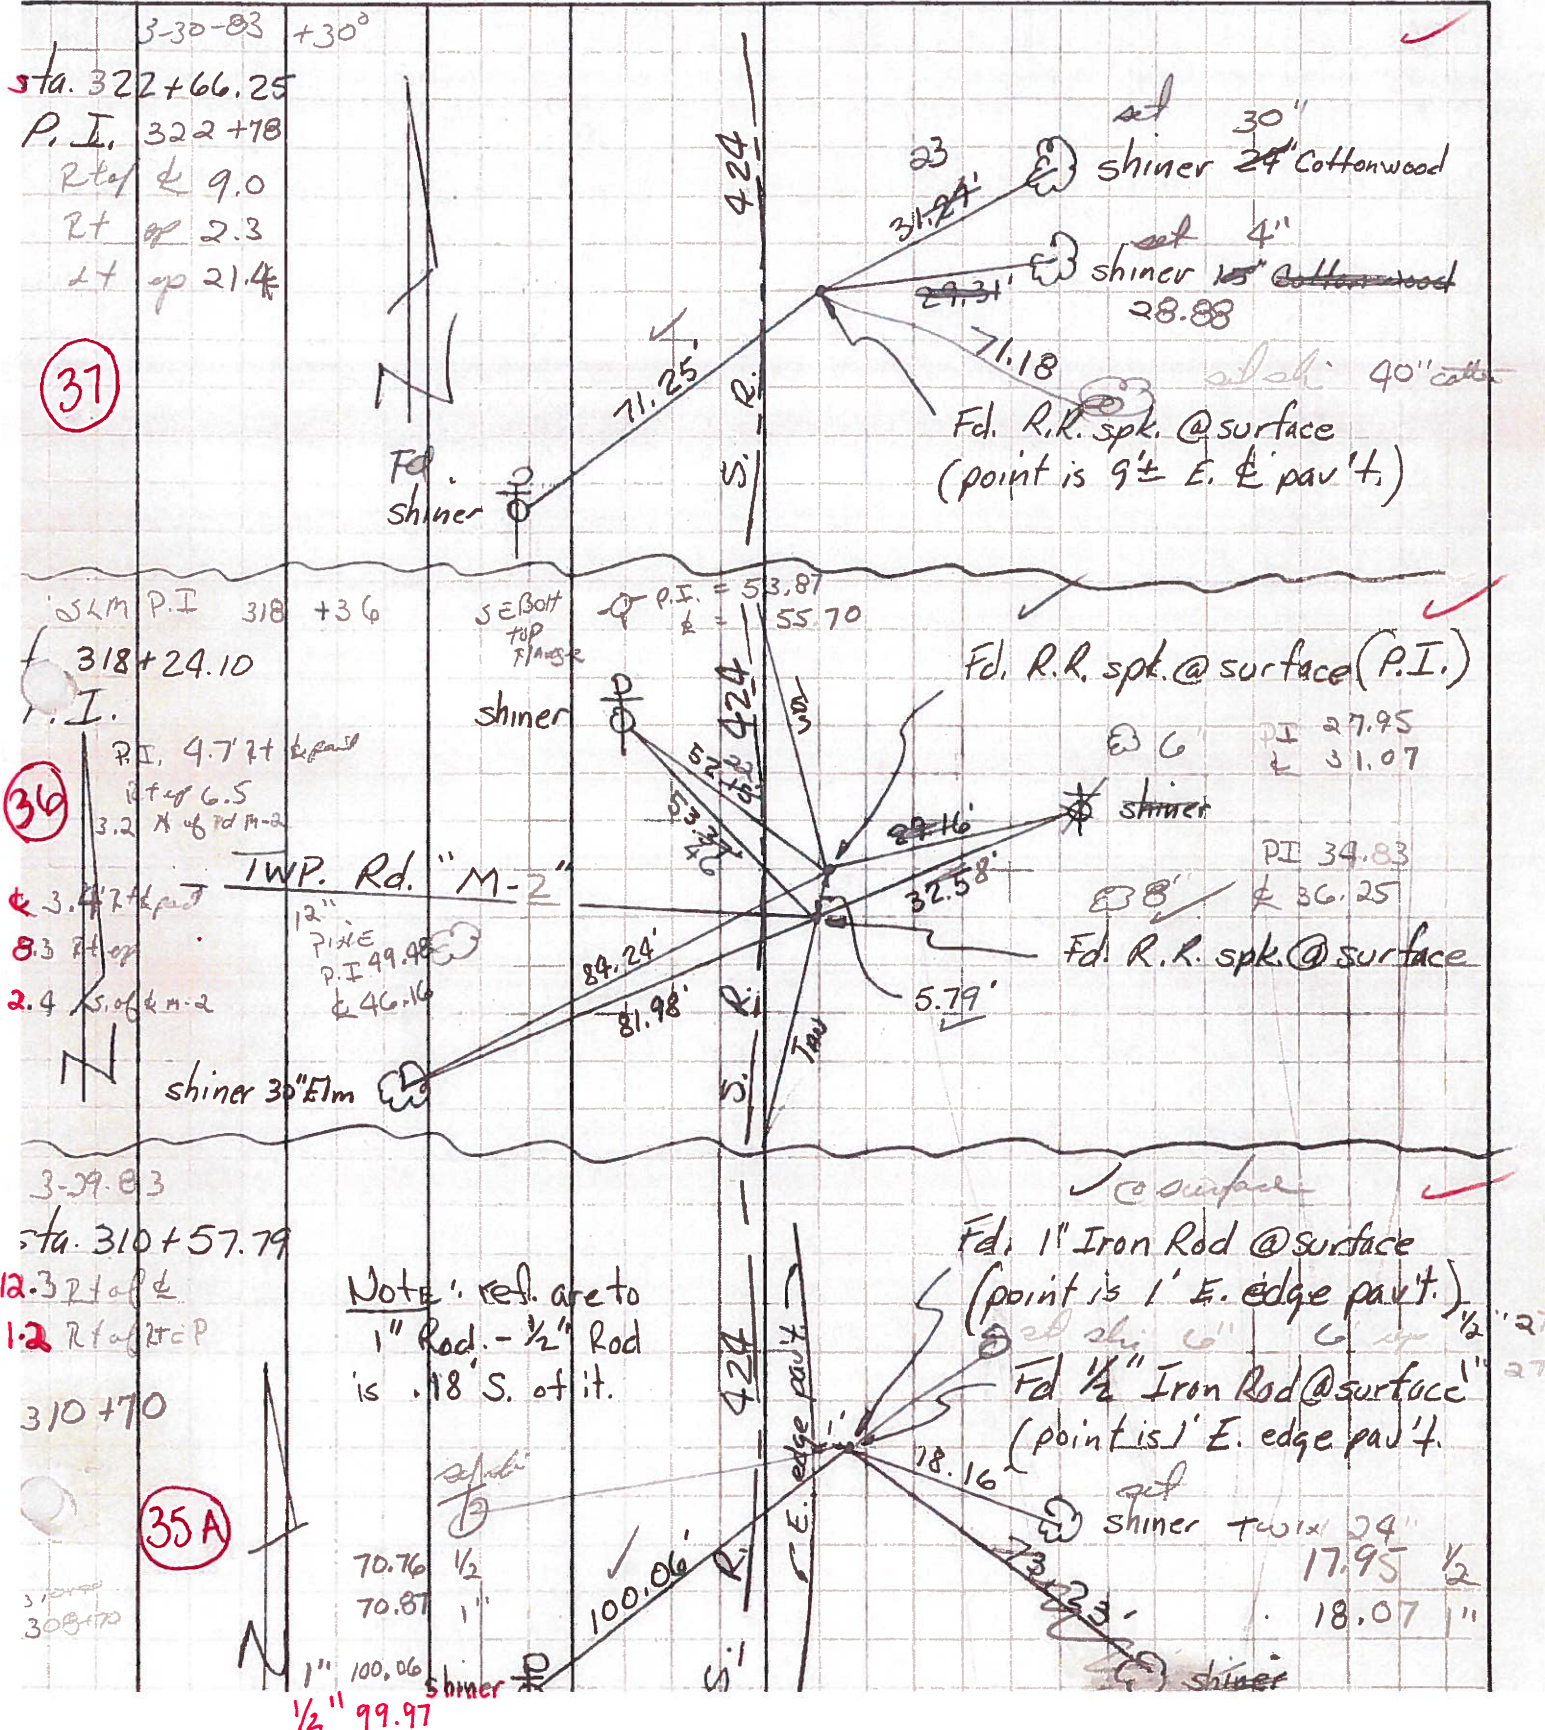

37

36

35A

Note: ref. are to
 1" Rod. - 1/2" Rod
 is .18' S. of it.

sta. 322+66.25
 P.I. 322+78
 Rtof 9.0
 Rt of 2.3
 Lt of 21.4

SLM P.I. 318+36
 318+24.10
 P.I. 4.777
 Rtof 6.5
 3.2 X of rd m-2

3.477
 8.3 Rtof
 2.4 X of rd m-2

sta. 310+57.79
 12.321 of
 1.2 Rtof
 310+70

70.76 1/2
 70.87 1"

1" 100.06
 1/2" 99.97

F.d. R.R. spk. @ surface (P.I.)

F.d. R.R. spk. @ surface

F.d. 1" Iron Rod @ surface
 (point is 1' E. edge pav't.)

F.d. 1/2" Iron Rod @ surface
 (point is 1' E. edge pav't.)

shiner twice 24"
 17.95 1/2
 18.07 1"

PERSONNEL TITLE PERSONNEL TITLE

Hoover
Hoff
Delventhal

COUNTY Henry DATE 4- -62

S. R. U.S.R. 24 WEATHER


SEC. TEMP.

DESCRIPTION Witnesses to Control Points (P.I.) JOB NO.

LEFT CENTER LINE RIGHT



Forward Tangent

✓ P.I. - 318 + 24.10
Inter. Twp. Rd M.2

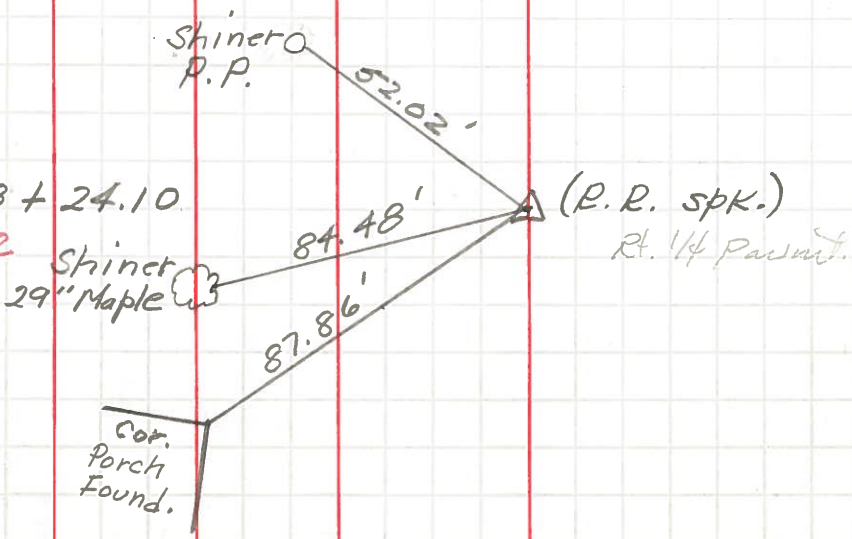

✓ P.I. - 322 + 66.25

(37)

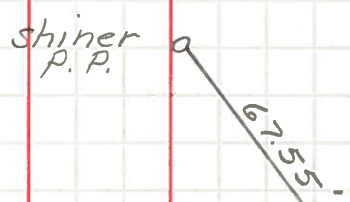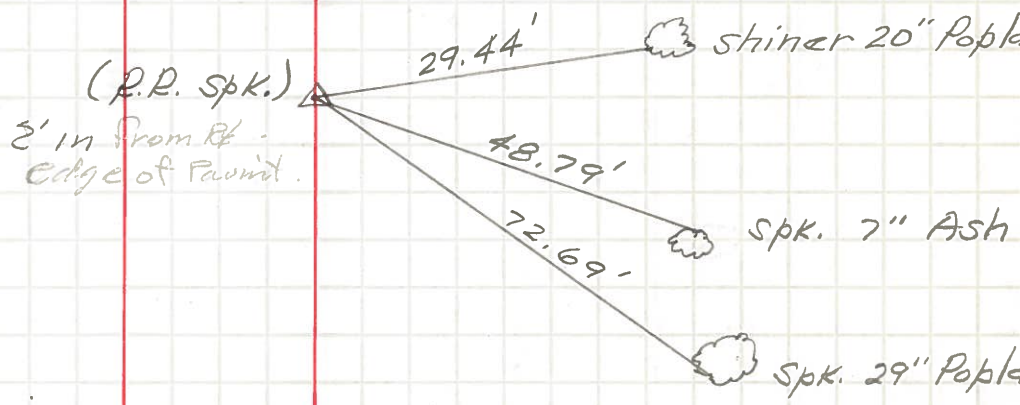

✓ P.I. - 327 + 06.63

(37-A)

