



O.D.O.T. DISTRICT 2 SURVEY OFFICE (USE ONLY)

PERSONNEL _____ REFERENCE NO. 37-A SHEET 38 OF 48
 NOTES HOMAN DATE 03/09/12 ROUTE SR 424
 H.C. HOMAN WEATHER CLEAR COUNTY HENRY
 R.C. ROUSOS TEMP. 30° TOWNSHIP NAPOLEON
 _____ SECTION 35
 _____ T 5 N R 6 E

TYPE MONUMENT _____ PK/WASHER _____
 ON SURFACE - ~~BELOW~~ _____ ON _____
~~LEFT - C PAV'T~~ - RIGHT _____ 7.9 _____
4.4 TO RT EDGE PAVEMENT
 S.L.M. _____ 326+77
 Grid: Northing: 617728.2952 Easting: 1516576.691

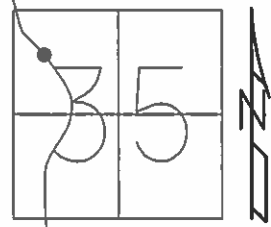

RECORD:
 P.I. STA. 327+06.63
 SET PK/WASHER
 05/24/91 MB
 OK FD
 12/30/08
 #133
 REF39
 FD PK 1" DOWN
 02/22/12 DCH

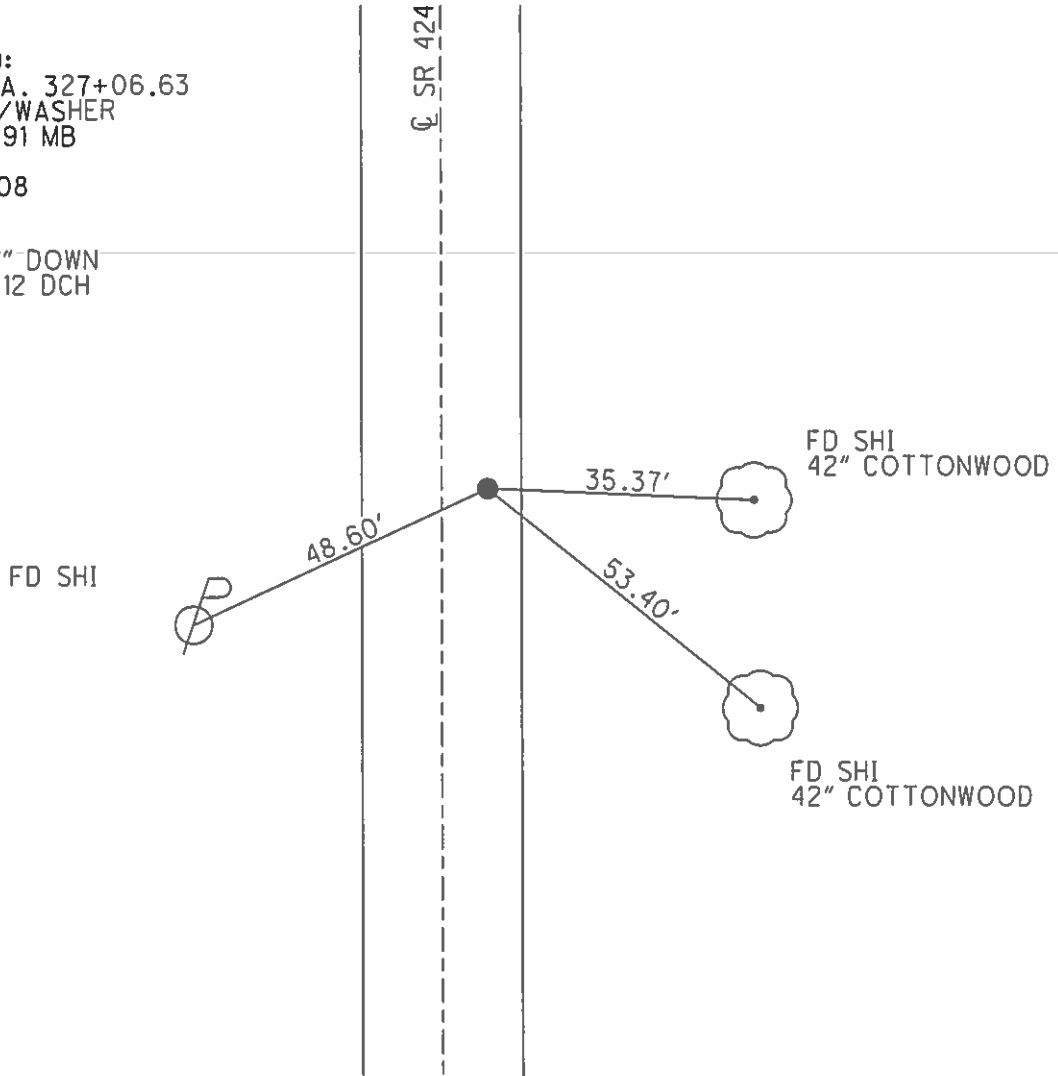

O.D.O.T. DISTRICT 2 SURVEY OFFICE

PERSONNEL

REFERENCE NO. 37A SHEET 35 OF 43

NOTES HOFFMAN

H.C. LOENRKE

DATE 4-4-91

ROUTE SR 424

R.C. BARWISSEL

WEATHER CLEAR

COUNTY HENRY

TEMP. 50°

TOWNSHIP NAPOLEON

SECTION 35

T 5 N R 6 W

TYPE MONUMENT P.K./WASHER


ON SURFACE - BELOW YES

SET P.K./WASHER
5-24-91
MB.

LEFT- & PAV'T. - RIGHT 7.9


4.4 TO RT. EDGE PAVEMENT

S.L.M. 326+77

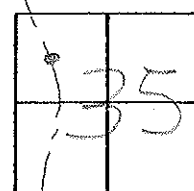

RECORD:

P.I. sta. 327+06.63

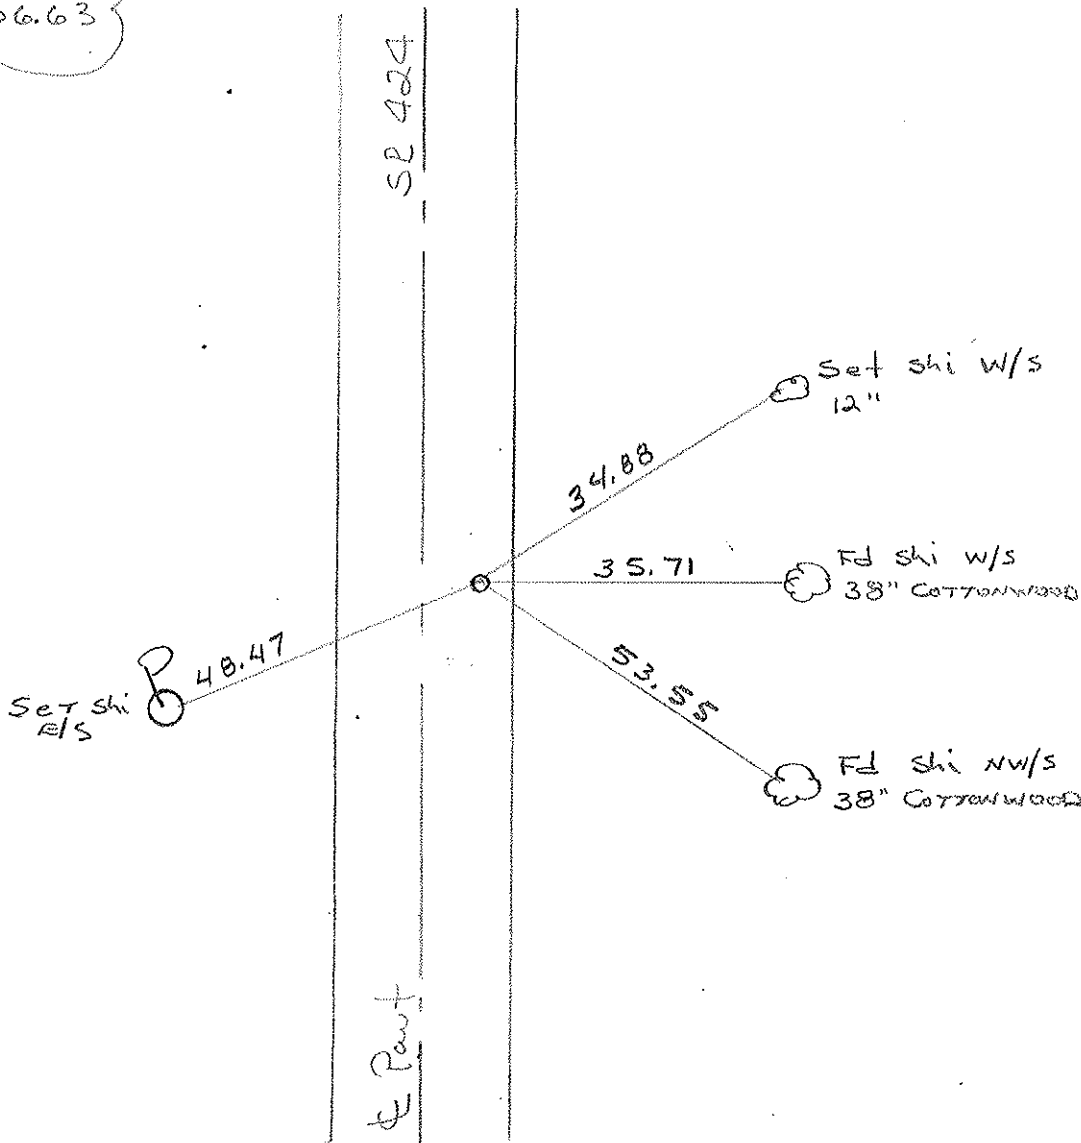

Q.D.O.T. DISTRICT 2 SURVEY OFFICE

SHEET _____ OF _____

County HENRY S.R. 424

Township NAPOLEON

Section 35

T5N, R6E

Personnel HOFFMAN

+


CREW

37A

Date MARCH 30, 83

Weather P. CLEAR

Temp. +30°

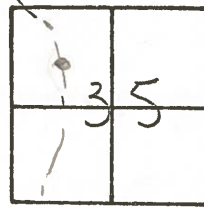

Fd R.R. SPK @ SURFACE
6.7' RT of & Pavt
4.5 to E, EP.
19.3 to W, EP.

S.L.M. 327+19

Record:
P.I. 327+06.63

SET, PK WASHER
MB, 6-17-83

Fd Shi
SE/S

P
68.78

S.R. 424

& Pavt

46.52

set shi w/s
10" ELM 7' up

35.79

set shi w/s
36" Cottonwood


53.62

set shi w/s
36" Cottonwood

PERSONNEL	TITLE	PERSONNEL	TITLE
Tomsic			
Neuser			
W. P.			
Carinata			

COUNTY HENRY DATE JUNE 4, 1979
 S. R. 424 WEATHER _____
 SEC. _____ TEMP. _____

DESCRIPTION _____ LEFT _____ CENTER LINE _____ RIGHT _____ JOB NO. _____

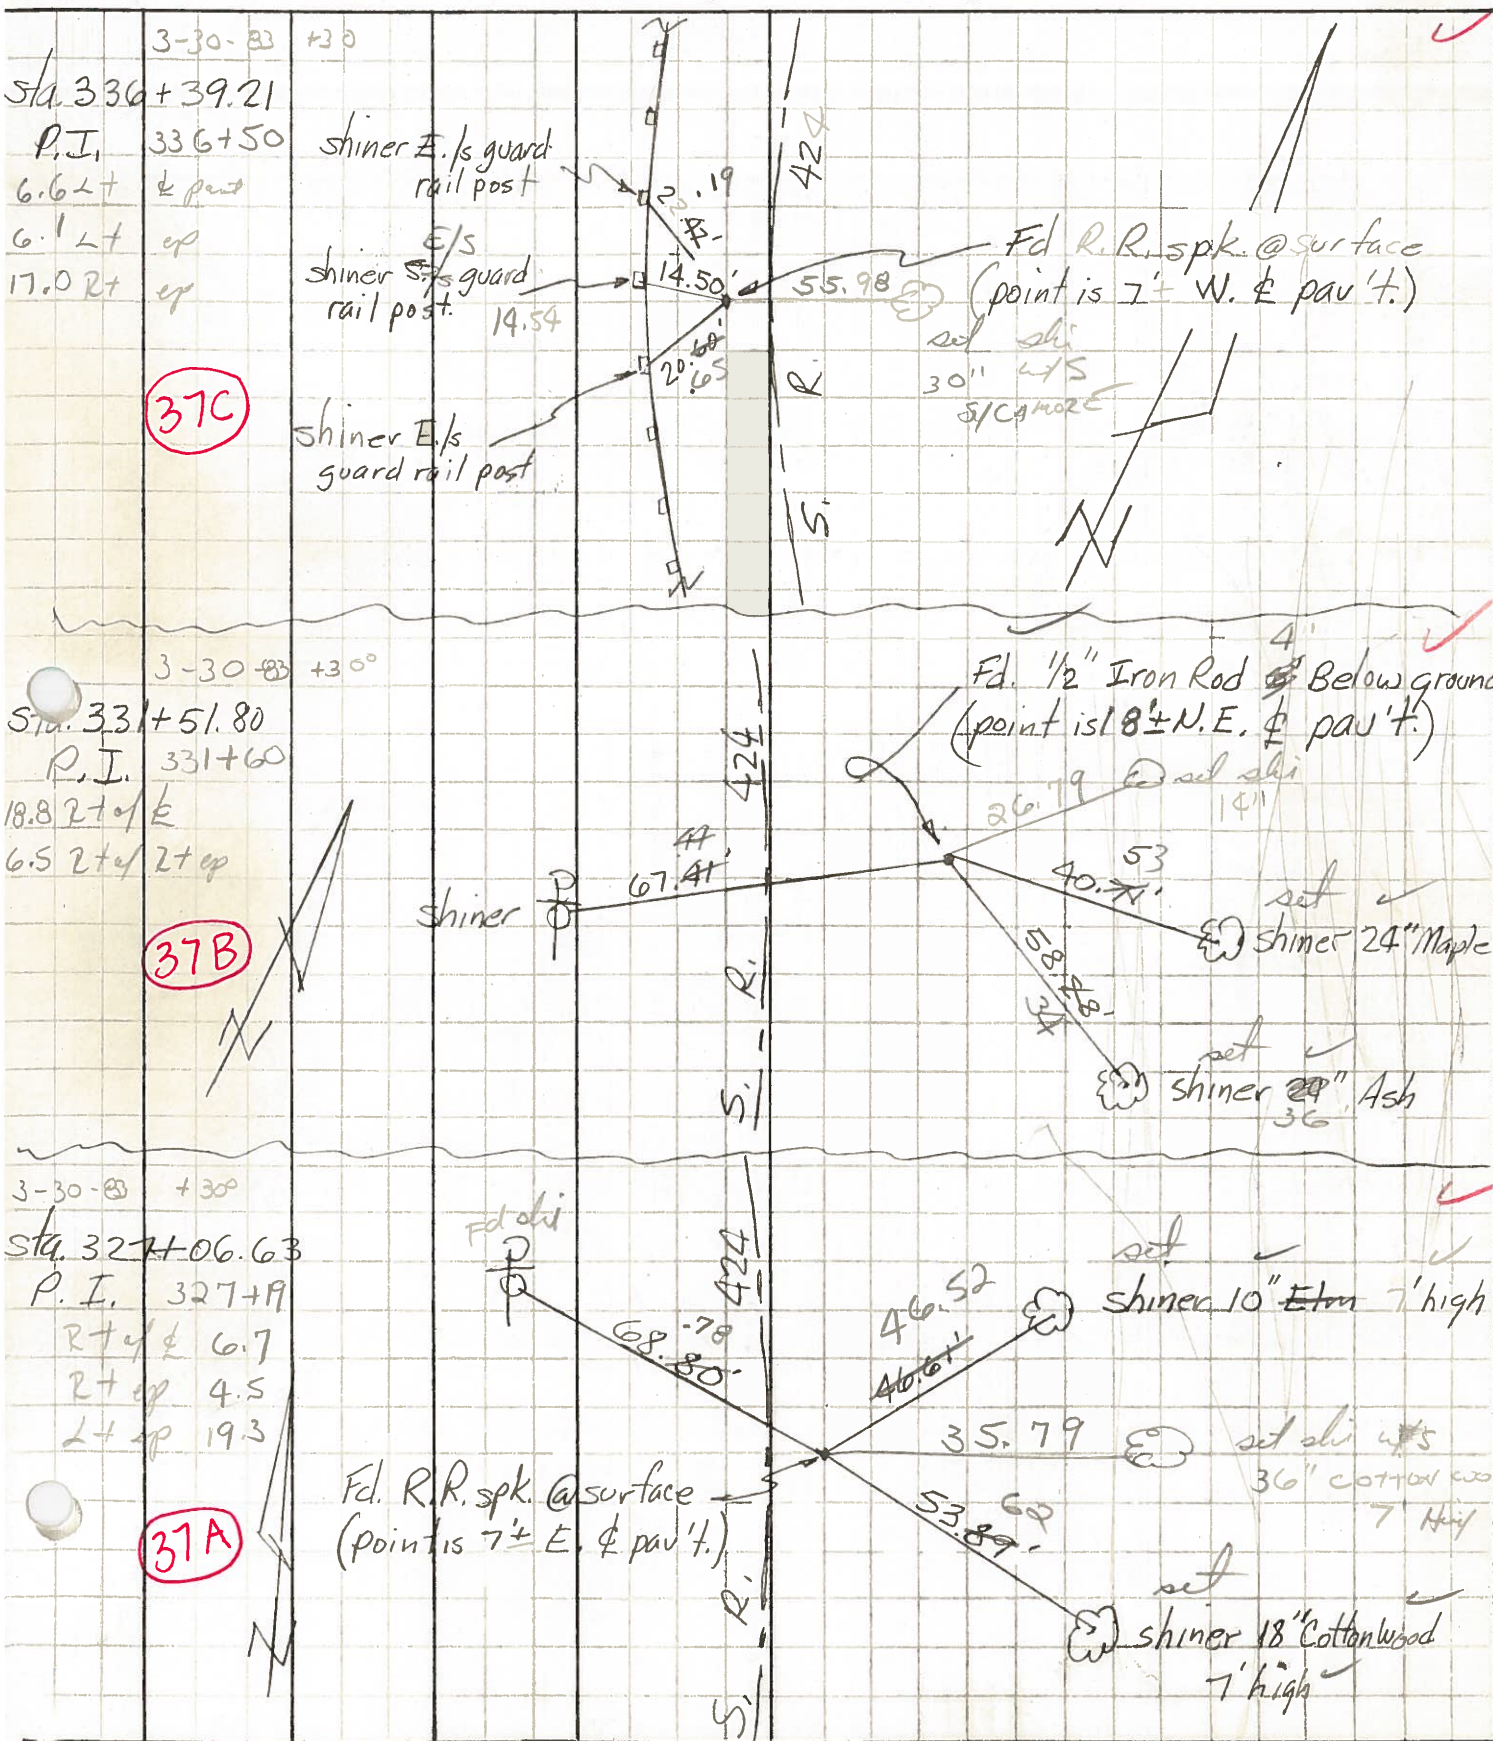

PERSONNEL TITLE PERSONNEL TITLE

Hoover
Hoff
Delventhal

COUNTY Henry DATE 4- -62

S. R. U.S.R. 24 WEATHER


SEC. TEMP.

DESCRIPTION Witnesses to Control Points (P.I.) JOB NO.

LEFT CENTER LINE RIGHT



Forward Tangent

✓ P.I. - 318 + 24.10
Inter. Twp. Rd M.2

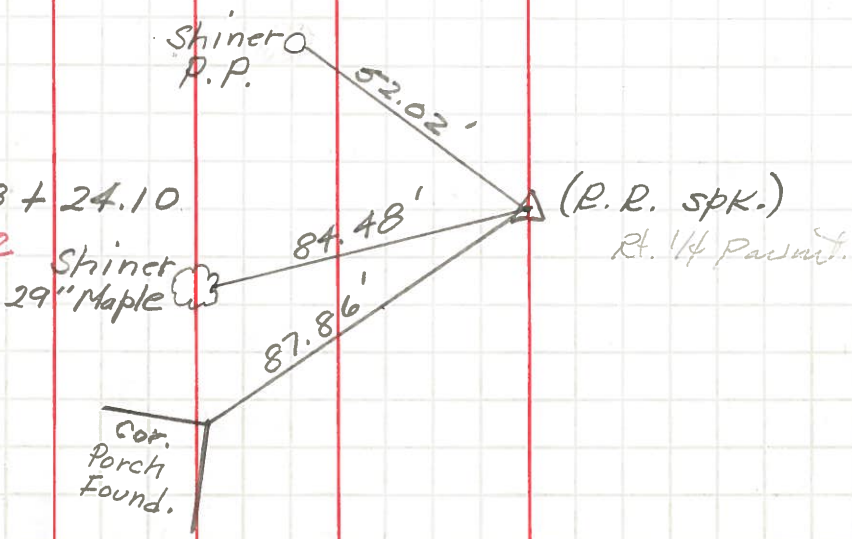

✓ P.I. - 322 + 66.25

(37)

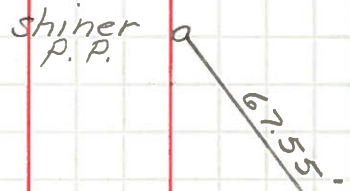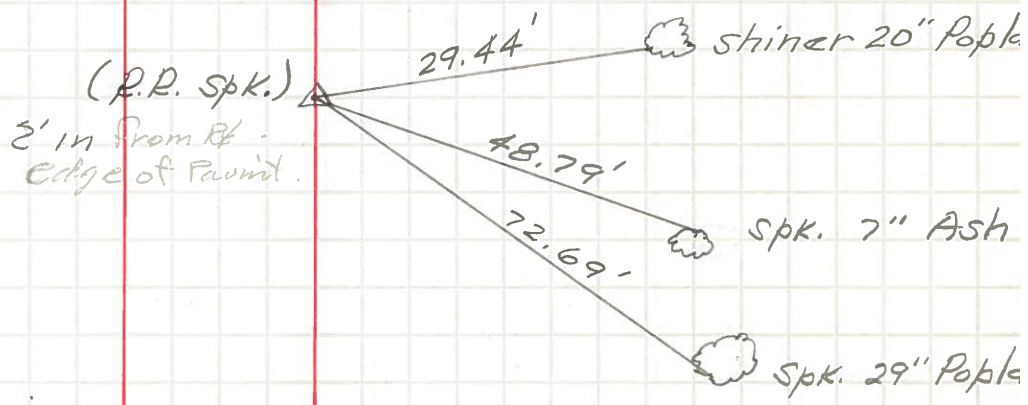

✓ P.I. - 327 + 06.63

(37-A)

