



O.D.O.T. DISTRICT 2 SURVEY OFFICE (USE ONLY)

PERSONNEL _____ REFERENCE NO. 38 SHEET 43 OF 48
 NOTES HOMAN DATE 03/09/12 ROUTE SR 424
 H.C. HOMAN WEATHER CLEAR COUNTY HENRY
 R.C. ROUSOS TEMP. 35° TOWNSHIP NAPOLEON
 _____ SECTION 35
 _____ T 5 N R 6 E

TYPE MONUMENT _____ PK/WASHER _____
 ON SURFACE - ~~BELOW~~ _____ ON _____
~~LEFT - C PAV'T~~ - RIGHT _____ 1.3' _____
11.3 TO RT EDGE PAVEMENT
 S.L.M. _____ 347+49 AT "B"
 Grid: Northing: 619563.737 Easting: 1515638.835

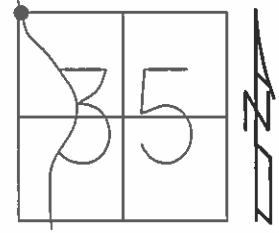

RECORD:
 POINTS A & B
 FD NAIL AT SURFACE
 ORIGIN UNKNOWN
 SET PK/WASHER
 AT BOTH
 05/24/91 MB
 FD A
 12/30/08
 #137
 REF44
 FD PK 1" DOWN

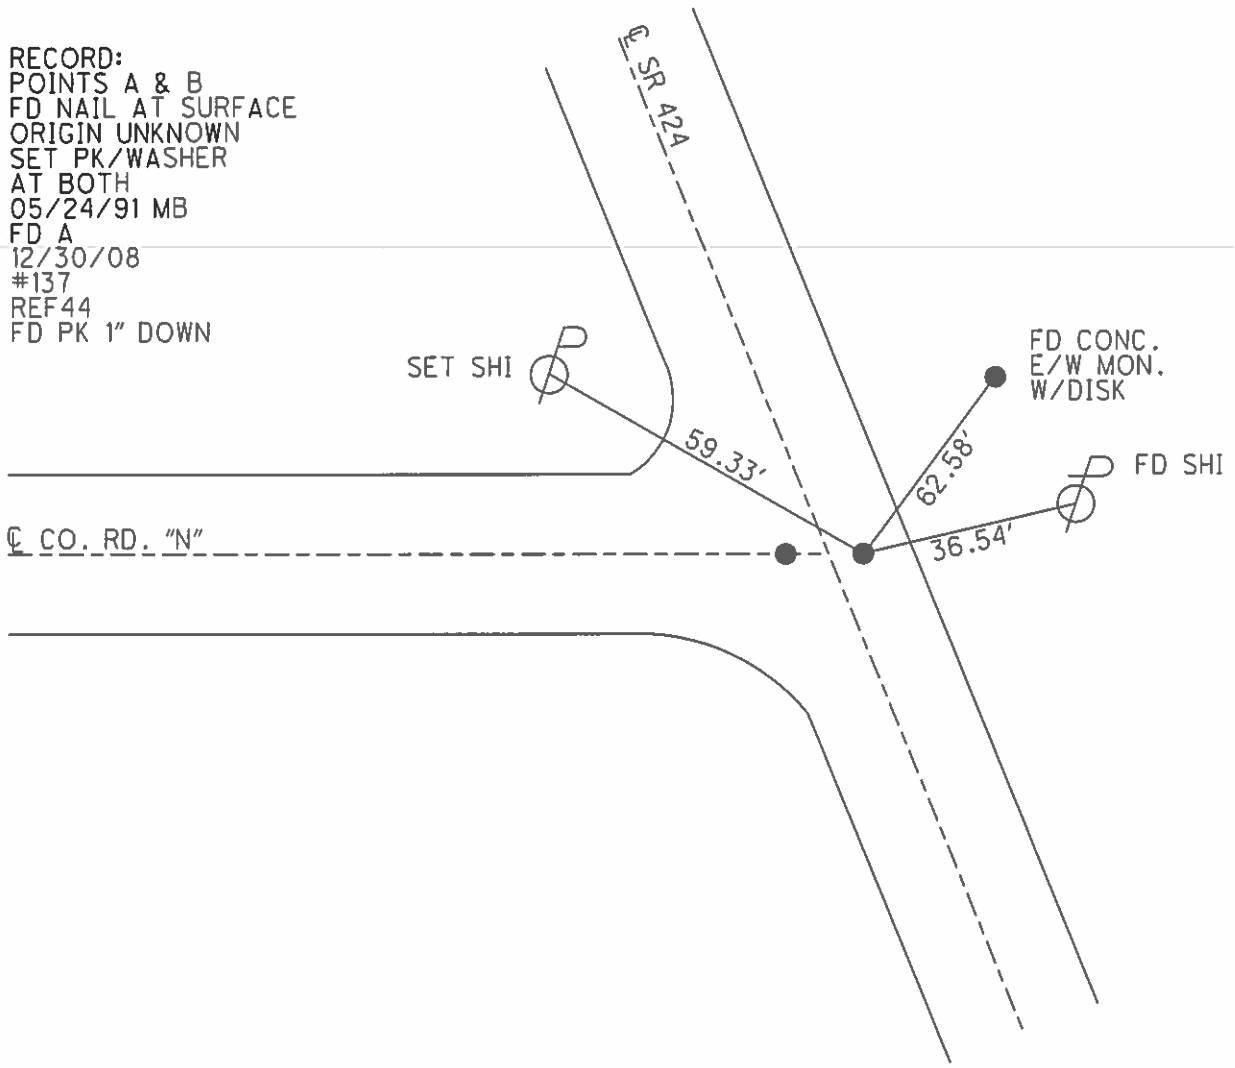

O.D.O.T. DISTRICT 2 SURVEY OFFICE

PERSONNEL

REFERENCE NO. 38 SHEET 39 OF 43

NOTES HOFFMAN

H.C. LOSHRKE

R.C. BARNHISEL

DATE 4-4-91

WEATHER CLEAR

TEMP. 50°

ROUTE SR 424

COUNTY HENRY

TOWNSHIP NAPOLEON

SECTION 35

T. S N. R 6 E

"A"

"B"

TYPE MONUMENT P.I.C. - P.I.C./WASHER


ON SURFACE - BELOW YES - YES

LEFT- & PAV'T. - RIGHT 1.14t. - 1.3' RT. at BOTH A & B


B = 11.3 TO RT. EDGE PAVEMENT

S.L.M. 347+49 at "B"

Set P.I.C./washer
at BOTH A & B
5-24-91
MB

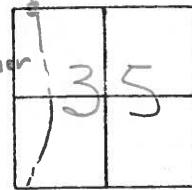

RECORD:
POINTS A & B
FD. NAIL AT SURFACE
ORIGIN UNKNOWN

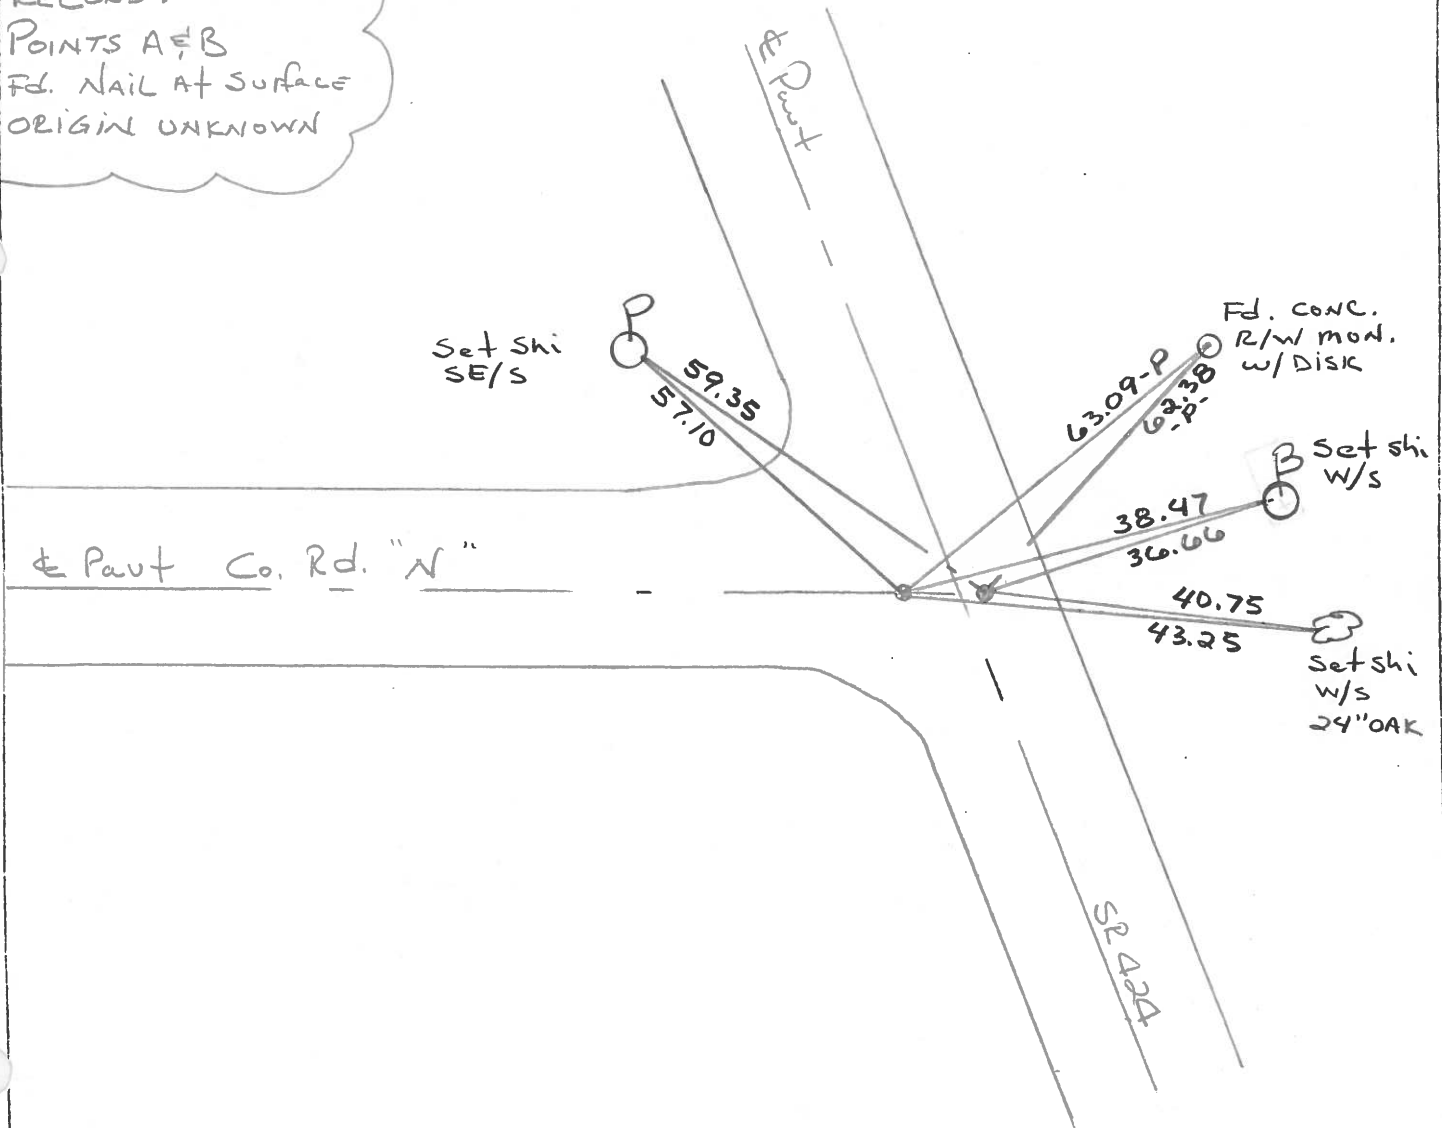

O.D.O.T. DISTRICT 2 SURVEY OFFICE

SHEET _____ OF _____

County HENRY S.R. 424

Date MARCH 30, 83

Township NAPOLEON

Weather P. CLEAR

Section 35


Temp. +30°

TN, R6E

Personnel HOFFMAN

CREW


#38

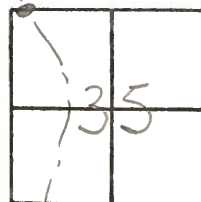

Pt. "A" Fd Nail @ surface; ORIGIN UNKNOWN
1.3' Lt of & Paut SR 424
ON & Paut Co. Rd. "N"

SLM 348+92

SET PK'S & WASHER
MB 6-17-83

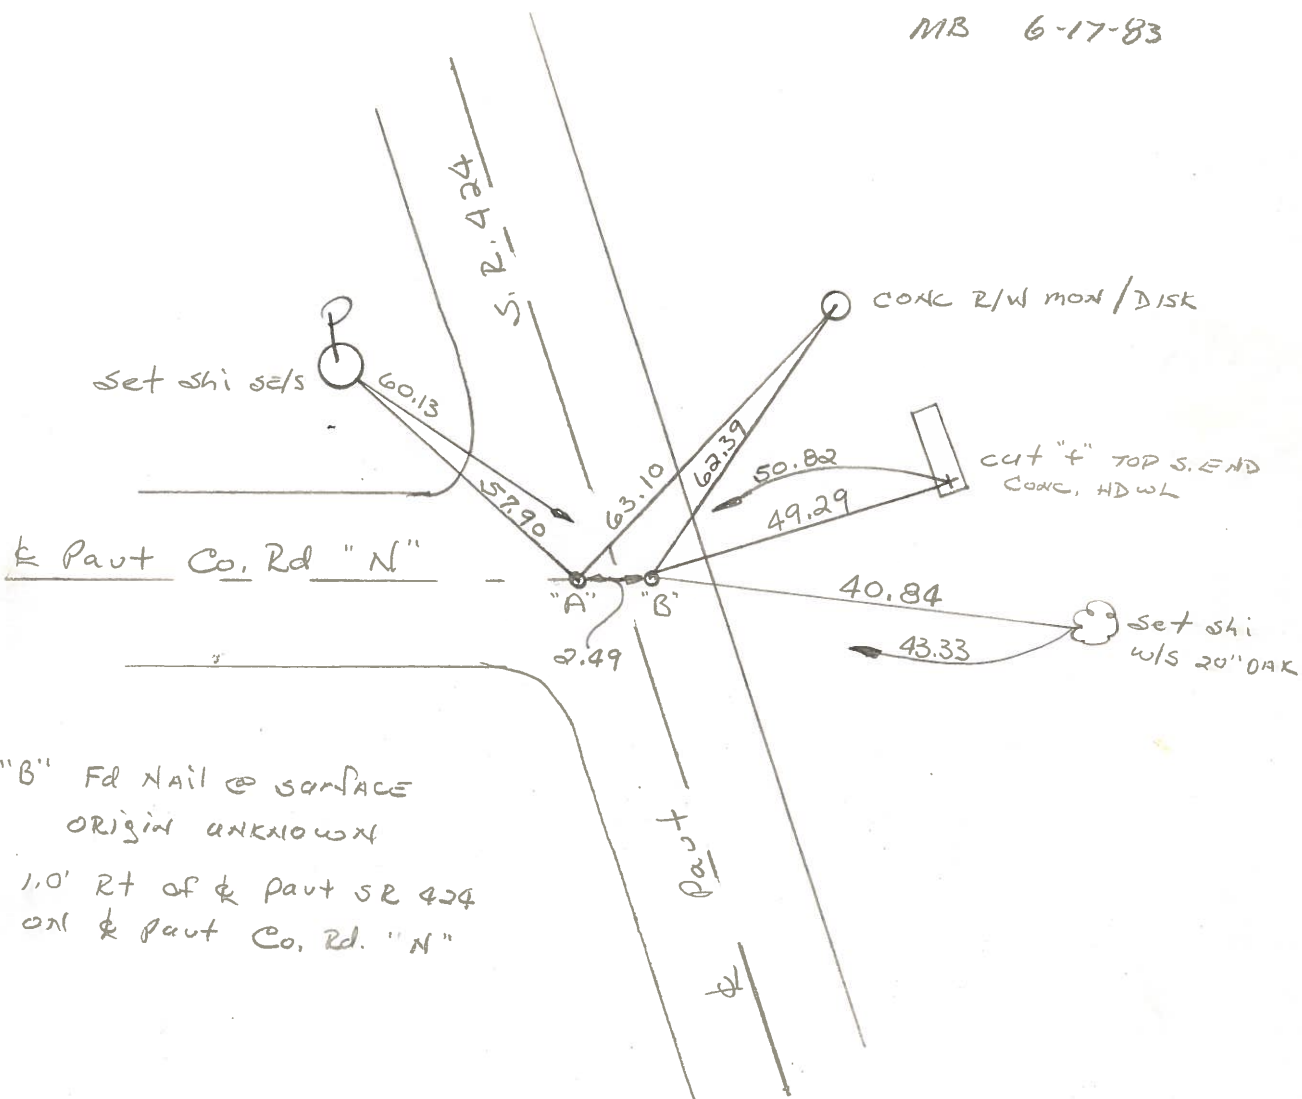

Pt. "B" Fd Nail @ surface
ORIGIN UNKNOWN
1.0' Rt of & Paut SR 424
ON & Paut Co. Rd. "N"