


O.D.O.T. DISTRICT 2 SURVEY OFFICE (USE ONLY)


PERSONNEL	REFERENCE NO.	<u>38</u>	SHEET	<u>42</u>	OF	<u>48</u>
NOTES	<u>HOMAN</u>	DATE	<u>03/09/12</u>	ROUTE	<u>SR 424</u>	
H.C.	<u>HOMAN</u>	WEATHER	<u>CLEAR</u>	COUNTY	<u>HENRY</u>	
R.C.	<u>ROUSOS</u>	TEMP.	<u>35°</u>	TOWNSHIP	<u>NAPOLEON</u>	
				SECTION	<u>35</u>	
				T	<u>5</u>	R
					<u>N</u>	<u>6</u>
					<u>E</u>	

TYPE MONUMENT _____ PK _____
 ON SURFACE - ~~BELOW~~ _____ 3"
~~LEFT~~ - ~~C~~ PAV'T - RIGHT _____ 1.1 _____
 _____ TO _____ EDGE PAVEMENT
 S.L.M. _____ 347+49 AT "B"

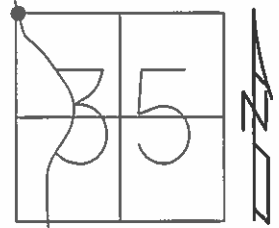

Grid: Northing: 619563.737 Easting: 1515638.835

RECORD:
 POINTS A & B
 FD NAIL AT SURFACE
 ORIGIN UNKNOWN
 SET PK/WASHER
 AT BOTH
 05/24/91 MB
 FD A
 12/30/08
 #137
 REF44
 FD PK 1" DOWN

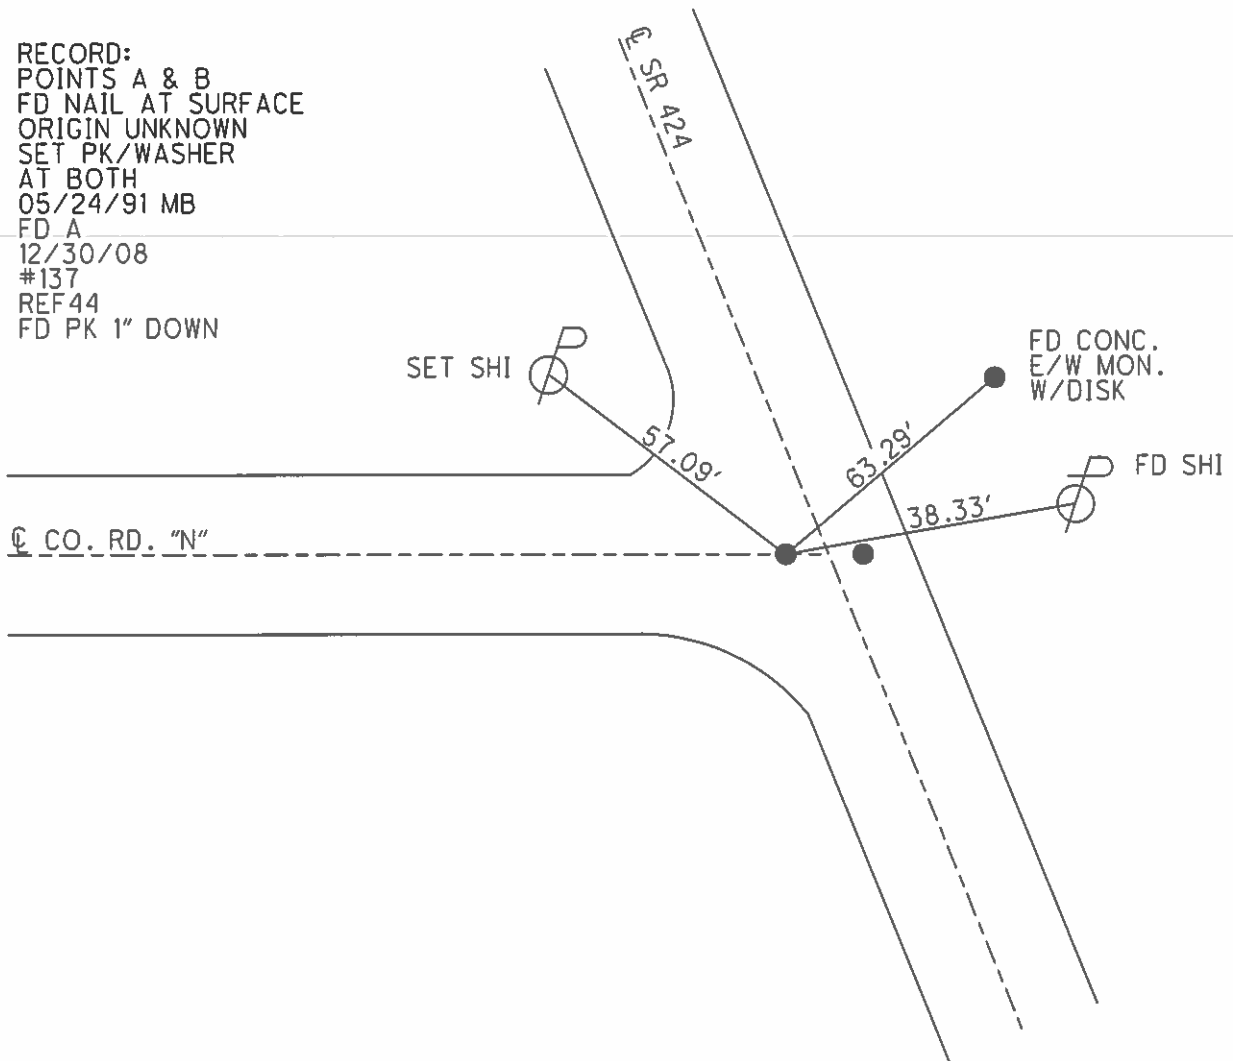

O.D.O.T. DISTRICT 2 SURVEY OFFICE

PERSONNEL

REFERENCE NO. 38 SHEET 39 OF 43

NOTES HOFFMAN

H.C. LOSHRKE

R.C. BARNHISEL

DATE 4-4-91

WEATHER CLEAR

TEMP. 50°

ROUTE SR 424

COUNTY HENRY

TOWNSHIP NAPOLEON

SECTION 35

T5 N R 6 E

"A"

"B"

TYPE MONUMENT P.I.C. - P.I.C./WASHER


ON SURFACE - ~~BELOW~~ YES - YES

LEFT- & PAV'T. - RIGHT 1.14t. - 1.3' RT. at BOTH A & B

B = 11.3 TO RT. EDGE PAVEMENT


S.L.M. 347+49 at "B"

Set P.I.C./washer
at BOTH A & B
5-24-91
MB

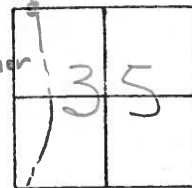

RECORD:

POINTS A & B
FD. NAIL AT SURFACE
ORIGIN UNKNOWN

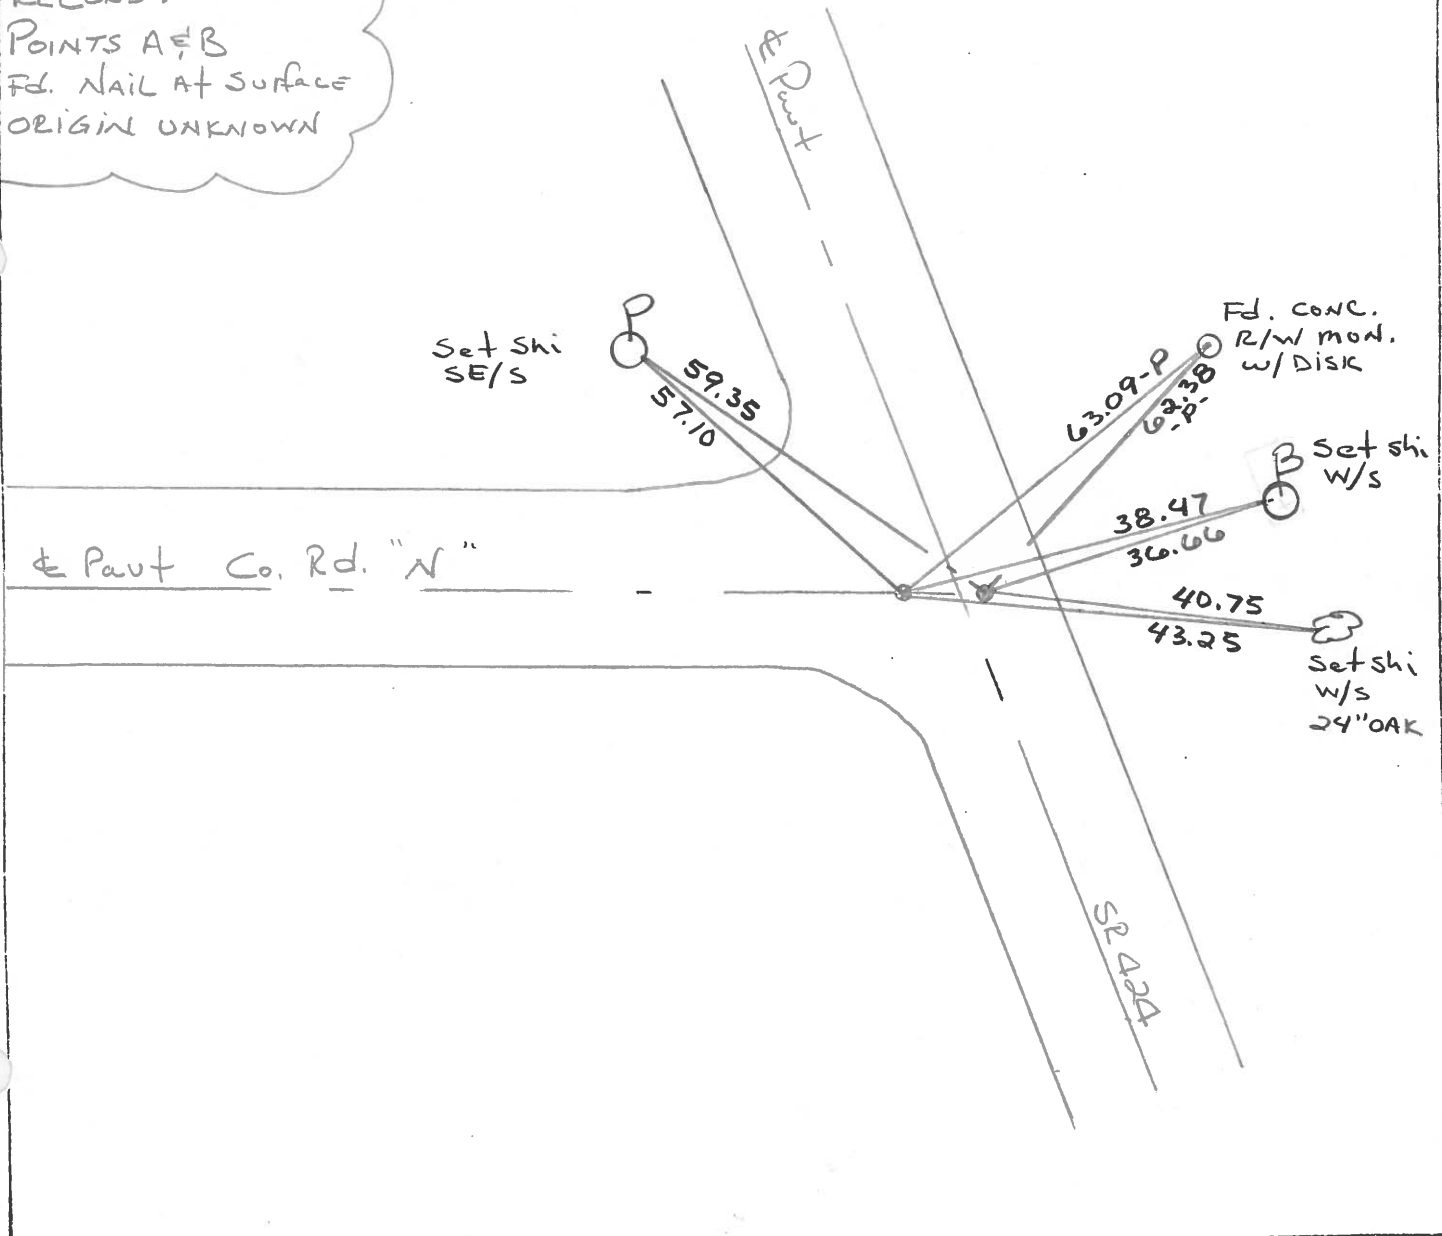

O.D.O.T. DISTRICT 2 SURVEY OFFICE

SHEET _____ OF _____

County HENRY S.R. 424

Date MARCH 30, 83

Township NAPOLEON


Weather P. CLEAR

Section 35

Temp. +30°

TN, R6E

Personnel HOFFMAN

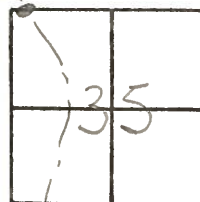


#38

CREW

Pt. "A" Fd Nail @ surface; ORIGIN UNKNOWN
1.3' Lt of & Paut SR 424
ON & Paut Co. Rd. "N"

SLM 348+92

SET PK'S & WASHER
MB 6-17-83

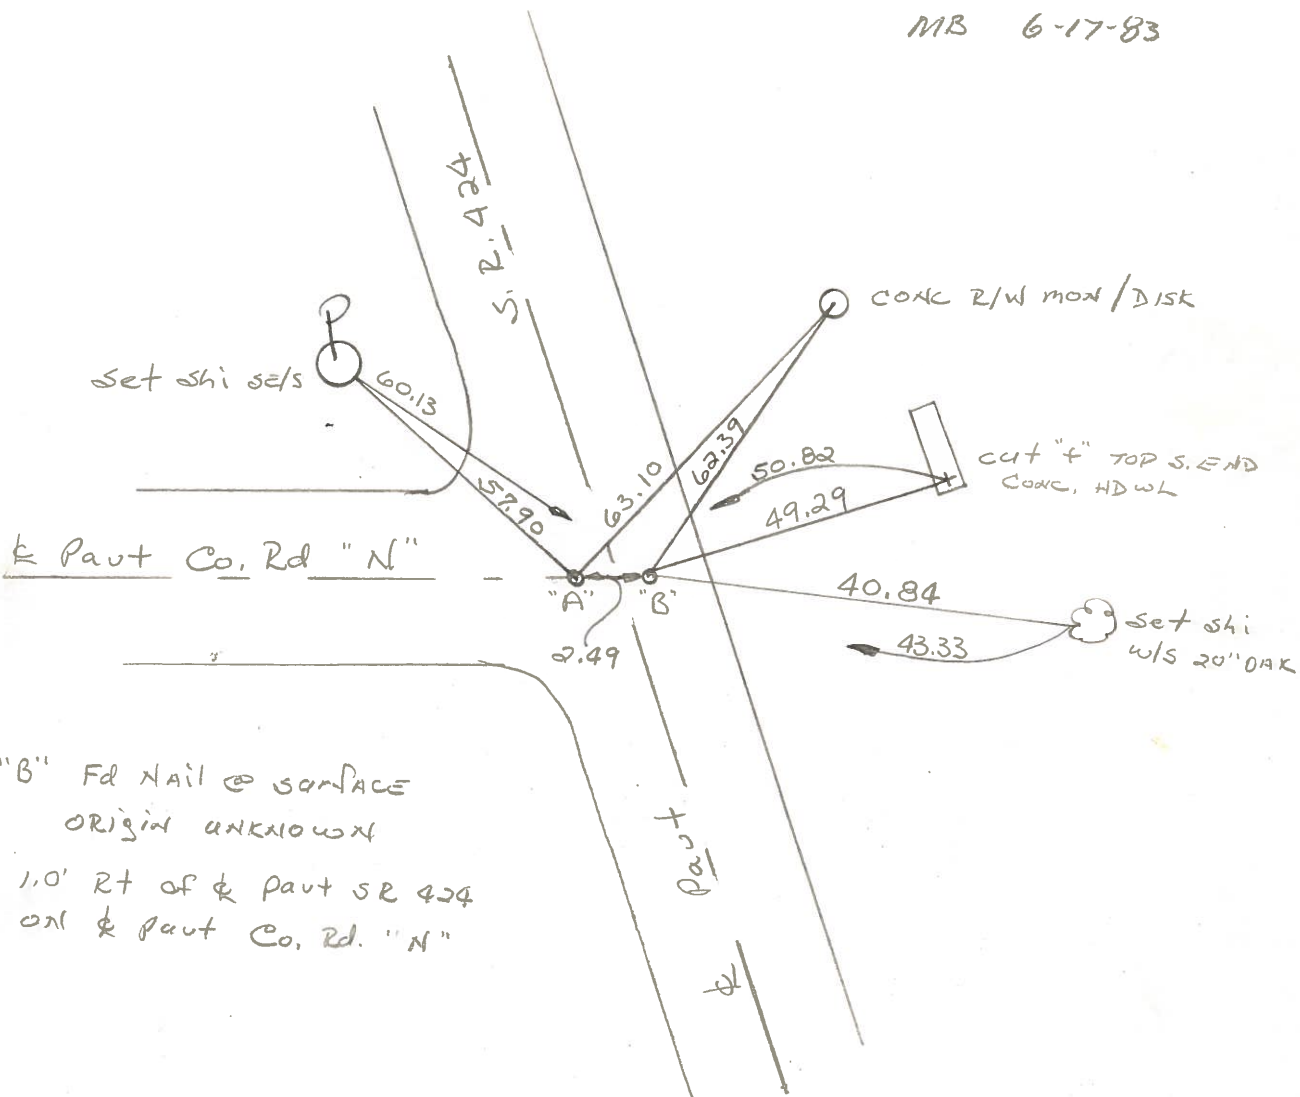

Pt. "B" Fd Nail @ surface
ORIGIN UNKNOWN
1.0' Rt of & Paut SR 424
ON & Paut Co. Rd. "N"

38

sln
on & N

348+92

cut shi

0

60.13

57.90

1.3

1.0

63.10

62.39

50.82

49.29

40.84

43.33

R/w Max

cut + ditch

2.49

cut shi

20' oak



387

388

7