



O.D.O.T. DISTRICT 2 SURVEY OFFICE (USE ONLY)

PERSONNEL _____ REFERENCE NO. 38-A SHEET 44 OF 48
NOTES HOMAN DATE 05/08/12 ROUTE SR 424
H.C. ROUSOS WEATHER CLOUDY COUNTY HENRY
R.C. HARBAUGH TEMP. 50° TOWNSHIP NAPOLEON
SECTION 26
T 5 N R 6 E

TYPE MONUMENT 1/2" IRON ROD
~~ON SURFACE~~ - BELOW 2"
~~LEFT - C PAV'T~~ - RIGHT 21.0
9.7 TO RT EDGE PAVEMENT
S.L.M. 353+93
Grid: Northing: 620192.235 Easting: 1515490.624

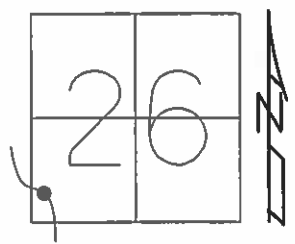

RECORD:
P.I. STA. 354+26.04
OK FD
12/30/08
#138
REF45
FD 1" IPIN
02/22/12 DCH

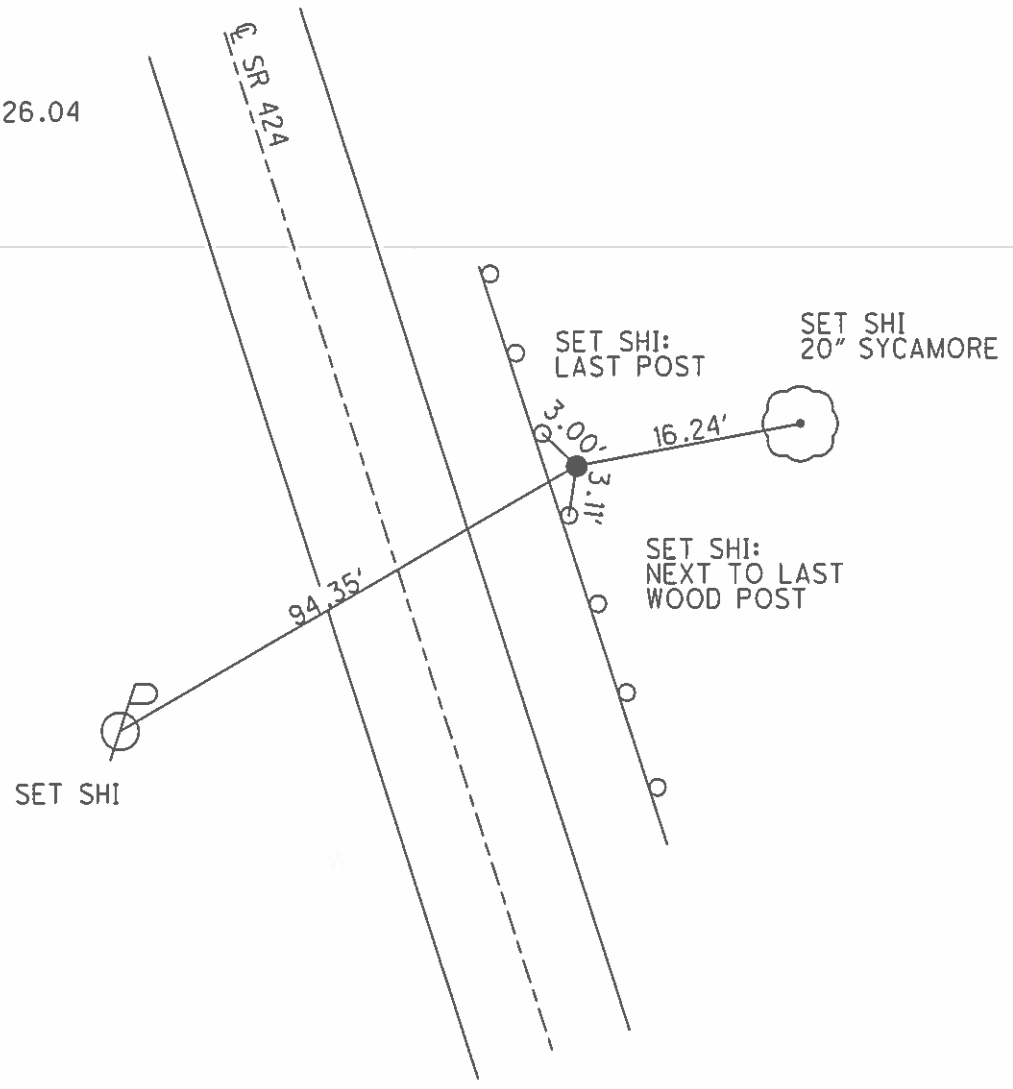

O.D.O.T. DISTRICT 2 SURVEY OFFICE

SHEET _____ OF _____

County HENRY S.R. 424

Date MARCH 30, 83

Township NAPOLEON

Weather P. CLEAR

Section 26


Temp. +35°

T5N, R6E

Personnel HOFFMAN

+

CREW

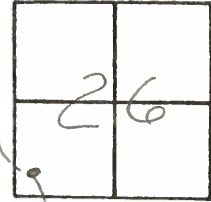

38A


Fd 1/2" IRON ROD 2" Below SURFACE
20.7' RT of & Pavt
9.3' RT of F. E.P.

SLM 354+36

Record:
P.I. 354+26.04

Fd. 6-17-83


MB & CREW

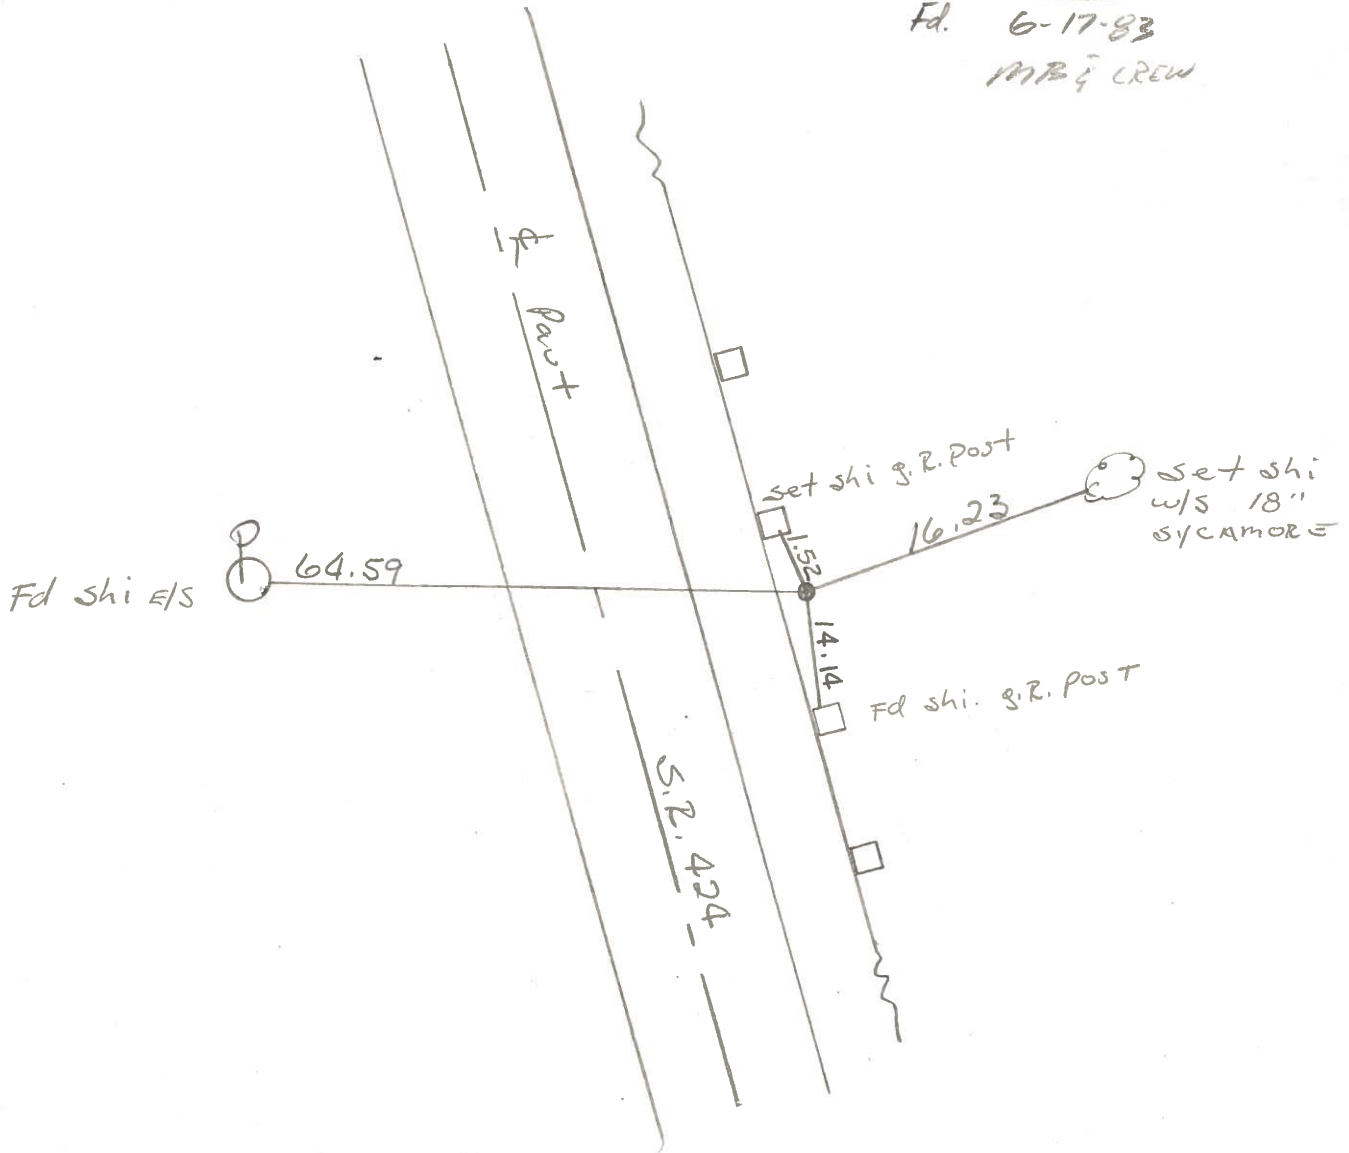

PERSONNEL	TITLE	PERSONNEL	TITLE
Sm SIC			
leuser			
o			
ranata			

COUNTY HENRY DATE JUNE 4, 1974
 S. R. 424 WEATHER _____
 SEC. _____ TEMP. _____

DESCRIPTION _____ JOB NO. _____

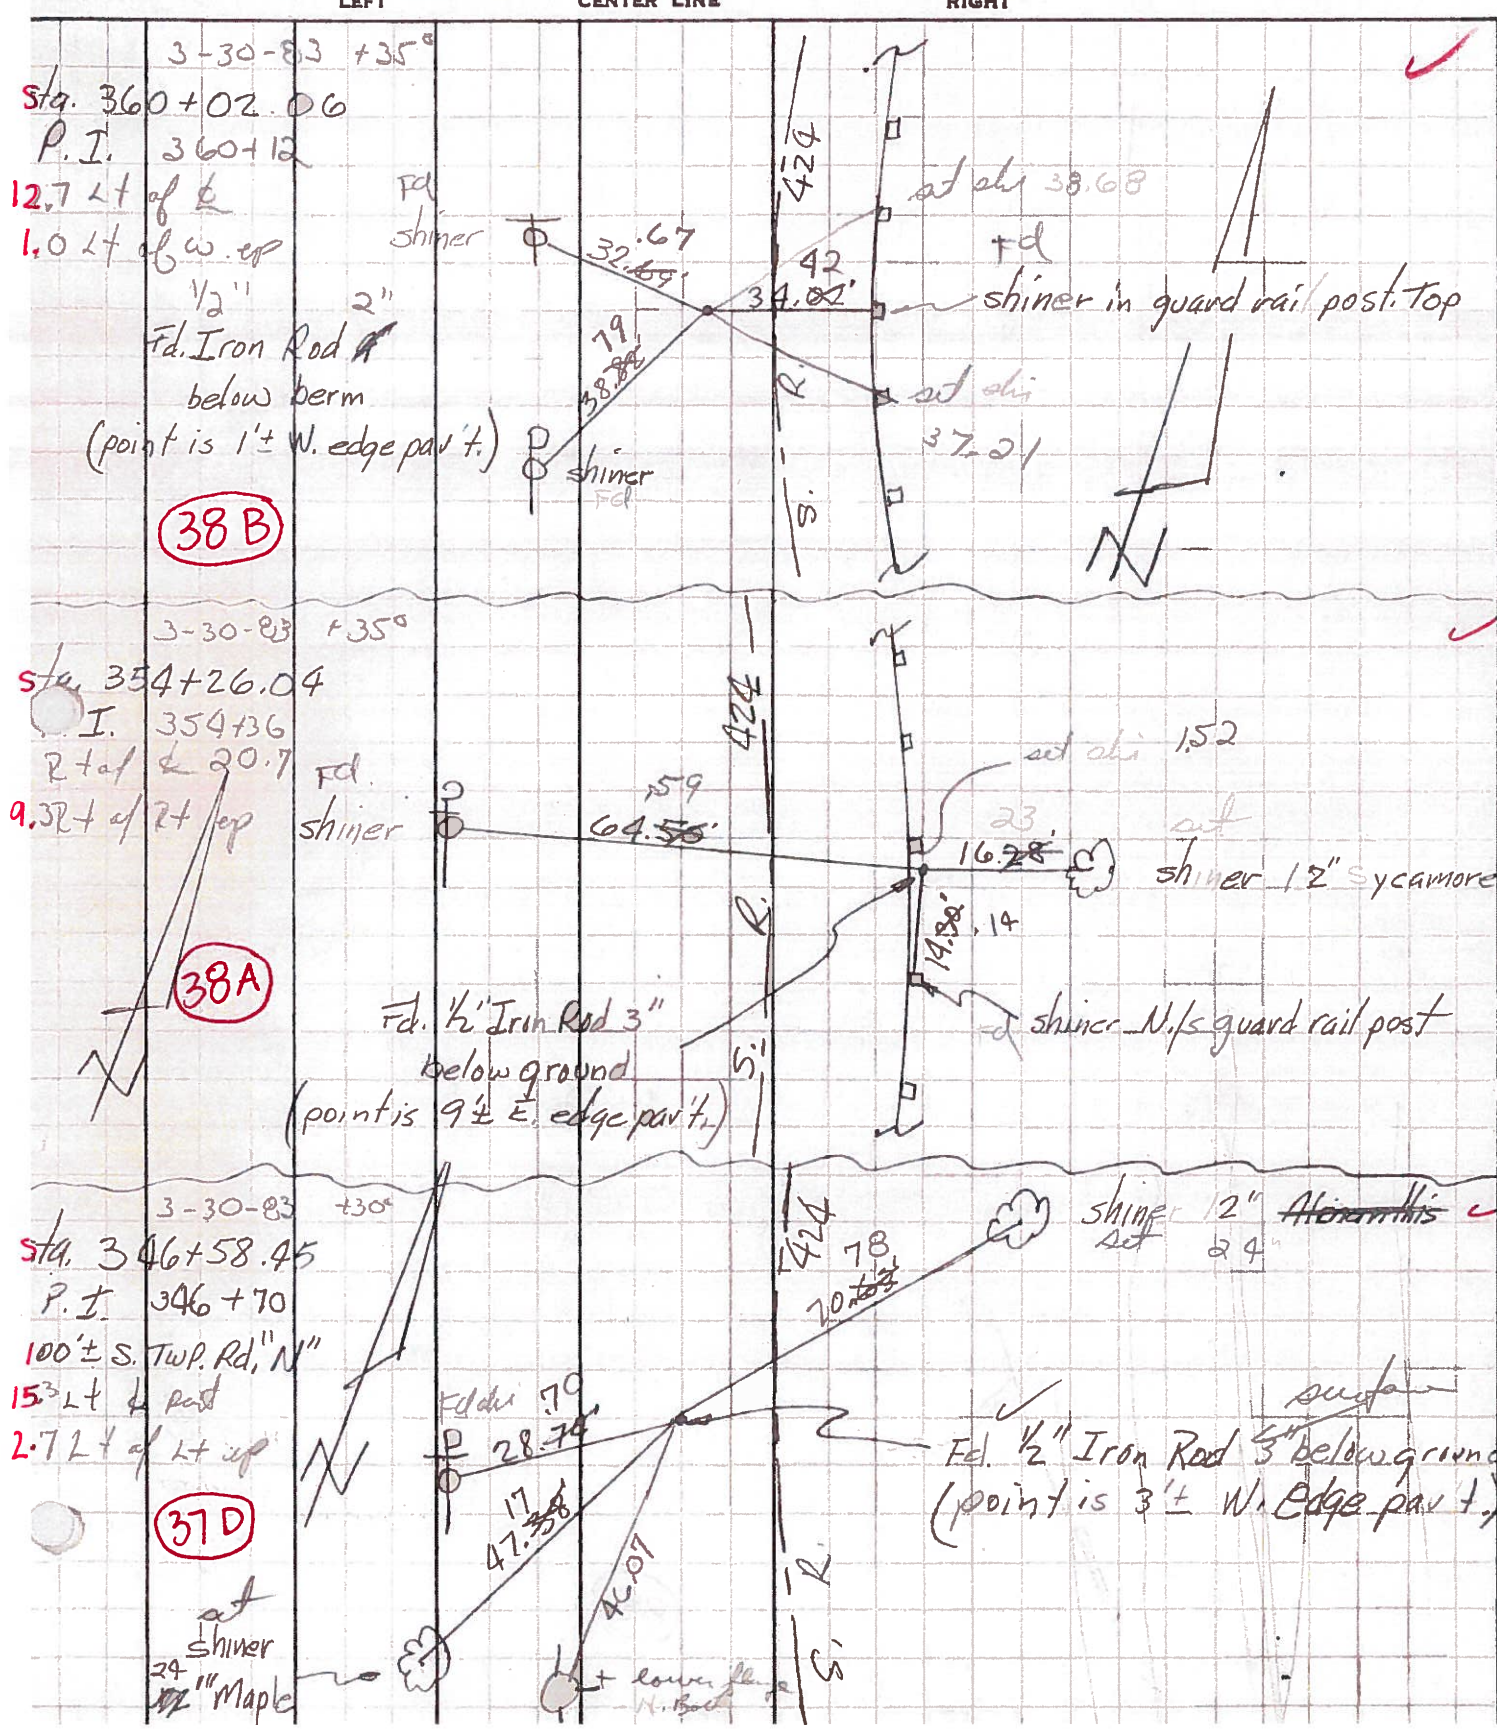

PERSONNEL TITLE PERSONNEL TITLE

Hoover _____
Hoff _____
Delventhal _____

COUNTY Henry DATE 4- -62

S. R. U.S.R. 24 WEATHER _____

SEC. _____ TEMP. _____

DESCRIPTION Witnesses to Control Points (P.I. S) JOB NO. _____

LEFT


CENTER LINE

RIGHT

Forward tangent


✓ P.I. - 354+26.04

38-A

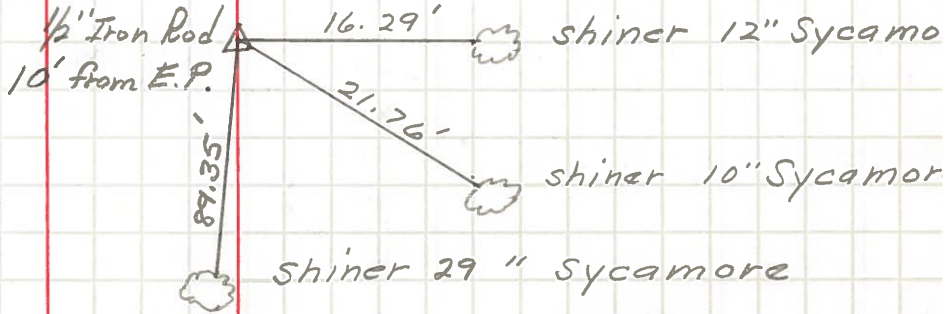

✓ P.I. - 360+02.06

38-B

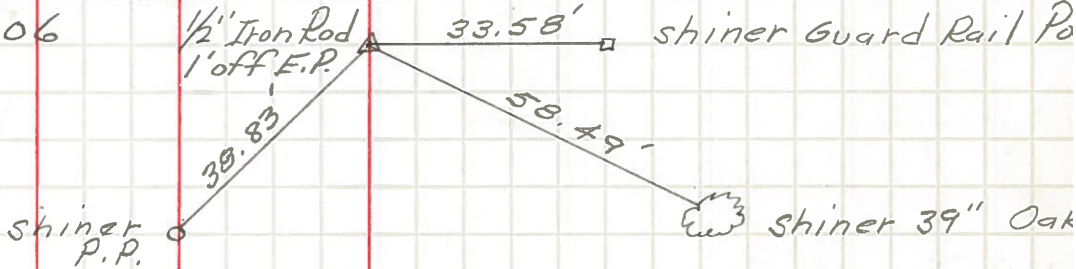

✓ P.I. - 365+20.45

39

