


O.D.O.T. DISTRICT 2 SURVEY OFFICE (USE ONLY)


PERSONNEL _____ REFERENCE NO. 38-B SHEET 45 OF 48
 NOTES HOMAN DATE 05/08/12 ROUTE SR 424
 H.C. ROUSOS WEATHER CLOUDY COUNTY HENRY
 R.C. HARBAUGH TEMP. 50° TOWNSHIP NAPOLEON
 _____ SECTION 27
 _____ T 4 N R 6 E

TYPE MONUMENT _____ PK/WASHER _____
 ON SURFACE - ~~BELOW~~ _____ ON _____
 LEFT - ~~C PAV'T~~ - RIGHT _____ 13.0 _____
 _____ 1.0 TO LT EDGE PAVEMENT _____
 S.L.M. _____ 359+69 _____

Grid: Northing: 620672.914 Easting: 1515165.377

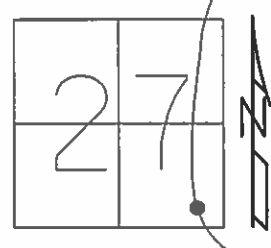

RECORD:
 P.I. STA. 360+02.06
 SET PK/WASHER
 05/24/91 MB
 OK FD
 12/30/08
 #139
 REF46
 FD PK
 02/22/12 DCH

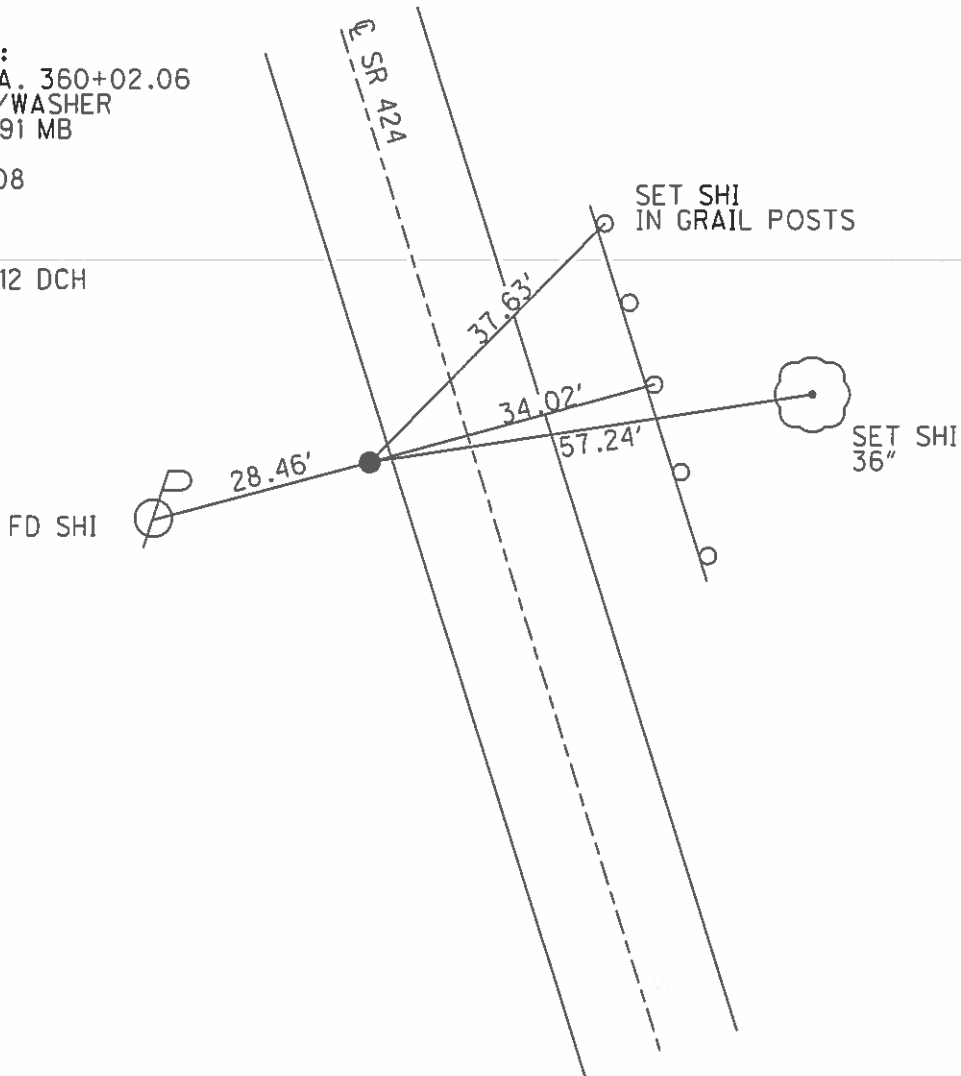

O.D.O.T. DISTRICT 2 SURVEY OFFICE

PERSONNEL

REFERENCE NO. 388

SHEET 41 OF 43

NOTES HOFFMAN

H.C. LOHRKE

R.C. BARNHISEL

DATE 4-4-91

WEATHER CLEAR

TEMP. 50°

ROUTE SR 424

COUNTY HENRY

TOWNSHIP NAPOLEON

SECTION 27

T5 N R 6 E

TYPE MONUMENT P.K./WASHER


ON SURFACE - BELOW YES

LEFT - C PAV'T. - RIGHT 13.0

I.O TO LT. EDGE PAVEMENT


S.L.M. 359+69

Set P.K./washer
5-24-91
MB

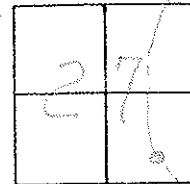

RECORD:

P.I. Sta. 360+02.06

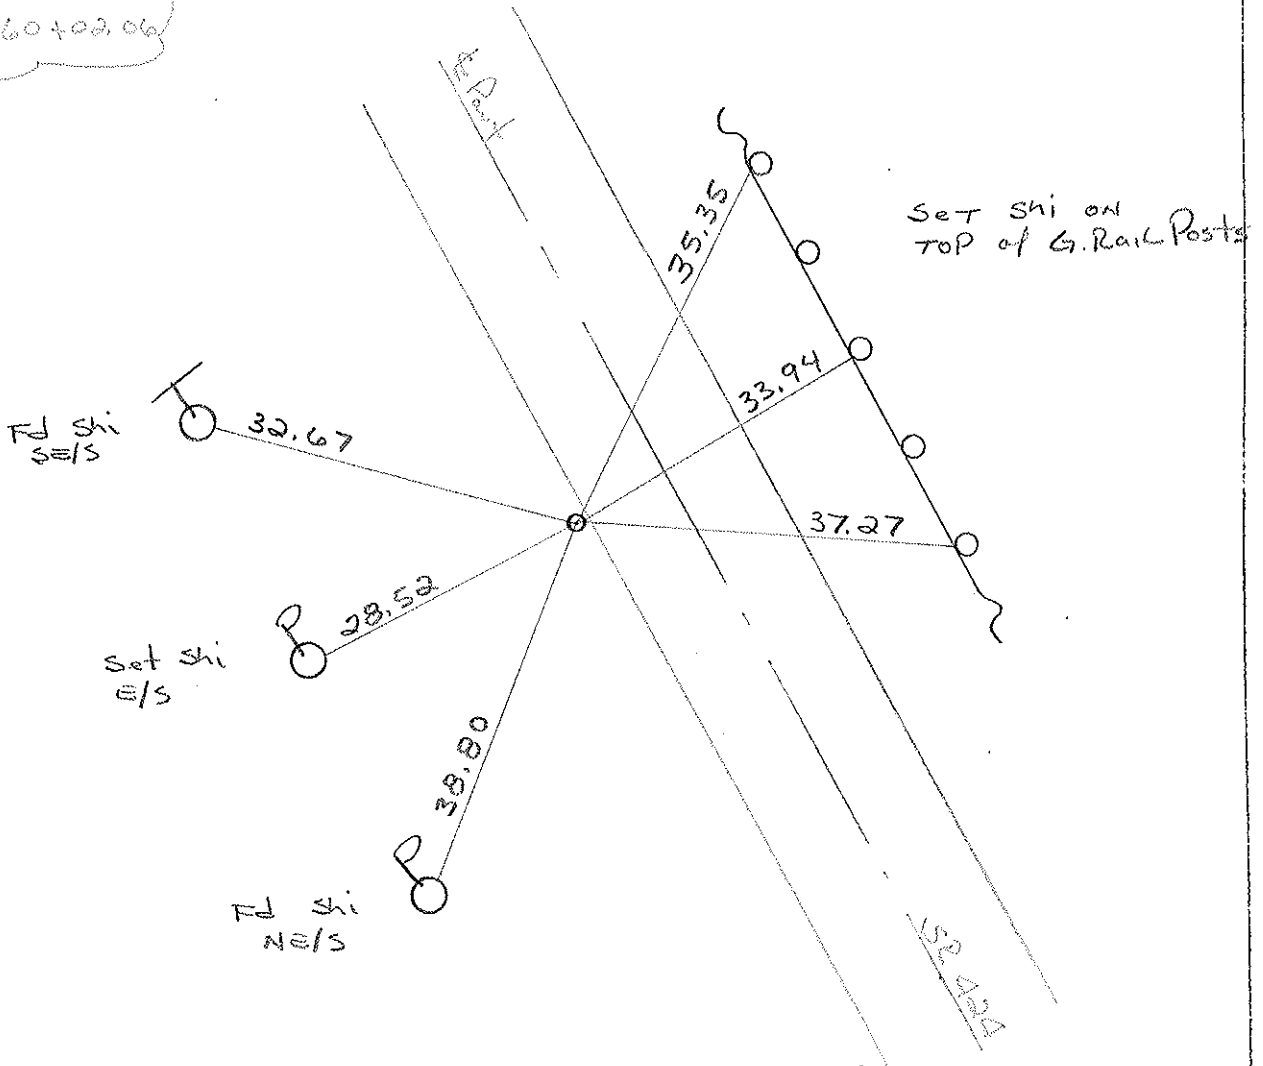

O.D.O.T. DISTRICT 2 SURVEY OFFICE

SHEET _____ OF _____

County HENRY S.R. 424

Date MARCH 30, 83

Township NAPOLEON

Weather P. CLEAR

Section 27

Temp. +30°


T5N, R6E

Personnel HOFFMAN

&

CREW


38B

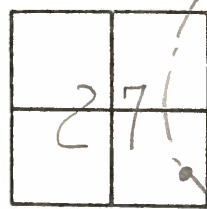

Fd 1/2" IRON ROD 3" Below surface
12.7' Lt & PAUT
1.0' Lt. of W.E.P.




SLM 360+12

Record:
P.I. 360+02.0
SET PK & WASHER
MB 6-17-83

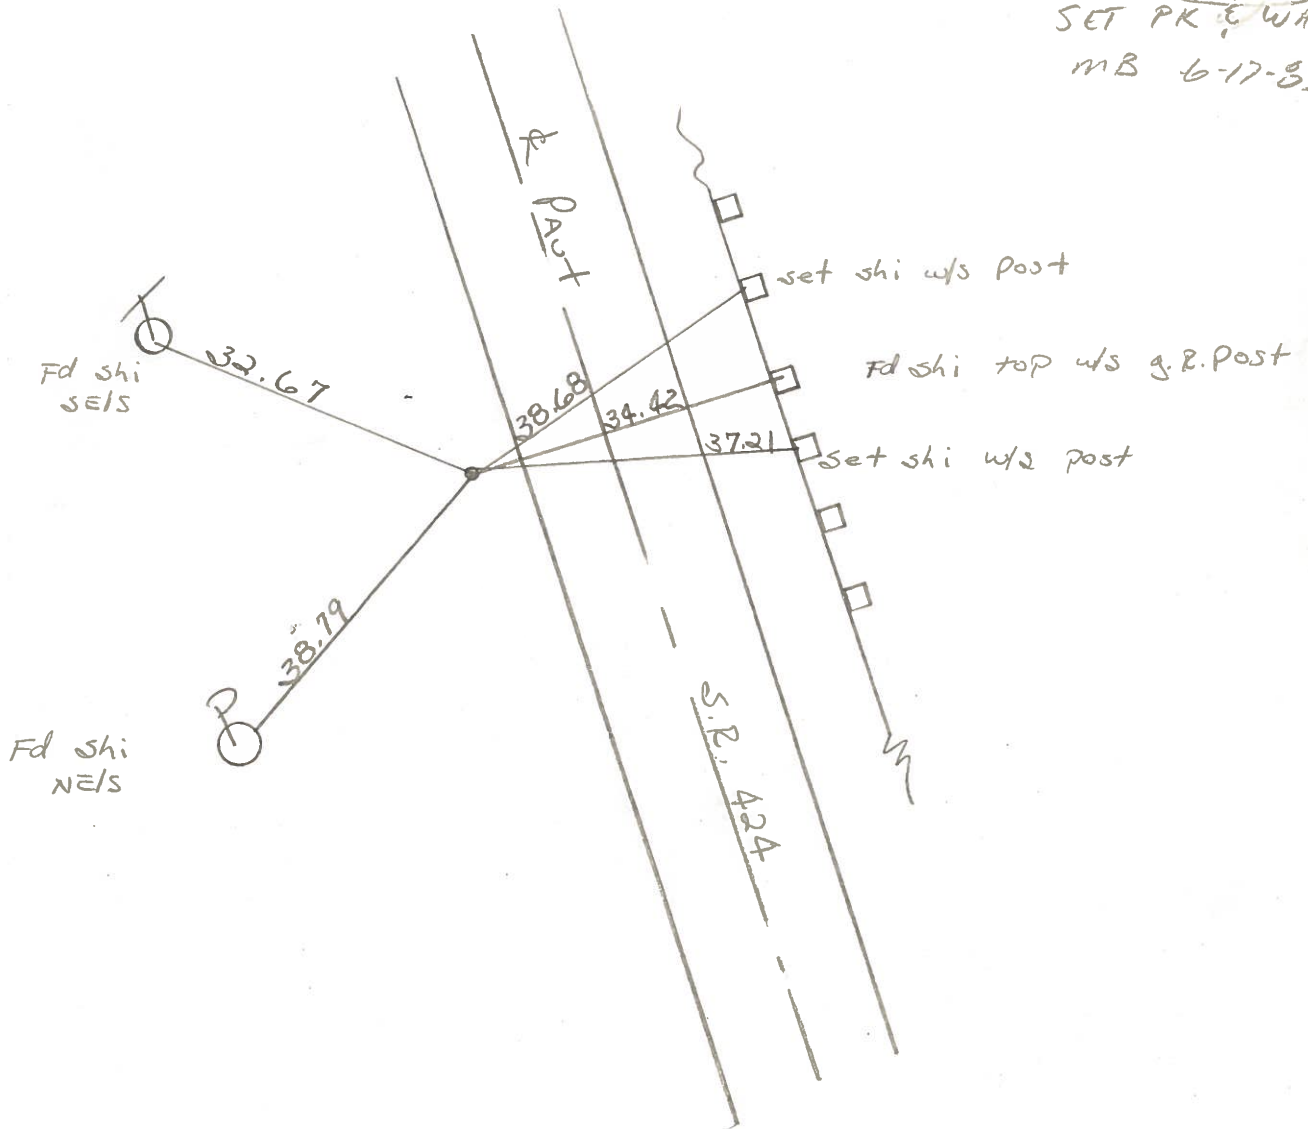

PERSONNEL	TITLE	PERSONNEL	TITLE	COUNTY	DATE
Smic				HENRY	JUNE 4, 1974
Leuser				S. R. 424	WEATHER
vanata				SEC.	TEMP.

DESCRIPTION	LEFT	CENTER LINE	RIGHT	JOB NO.
-------------	------	-------------	-------	---------

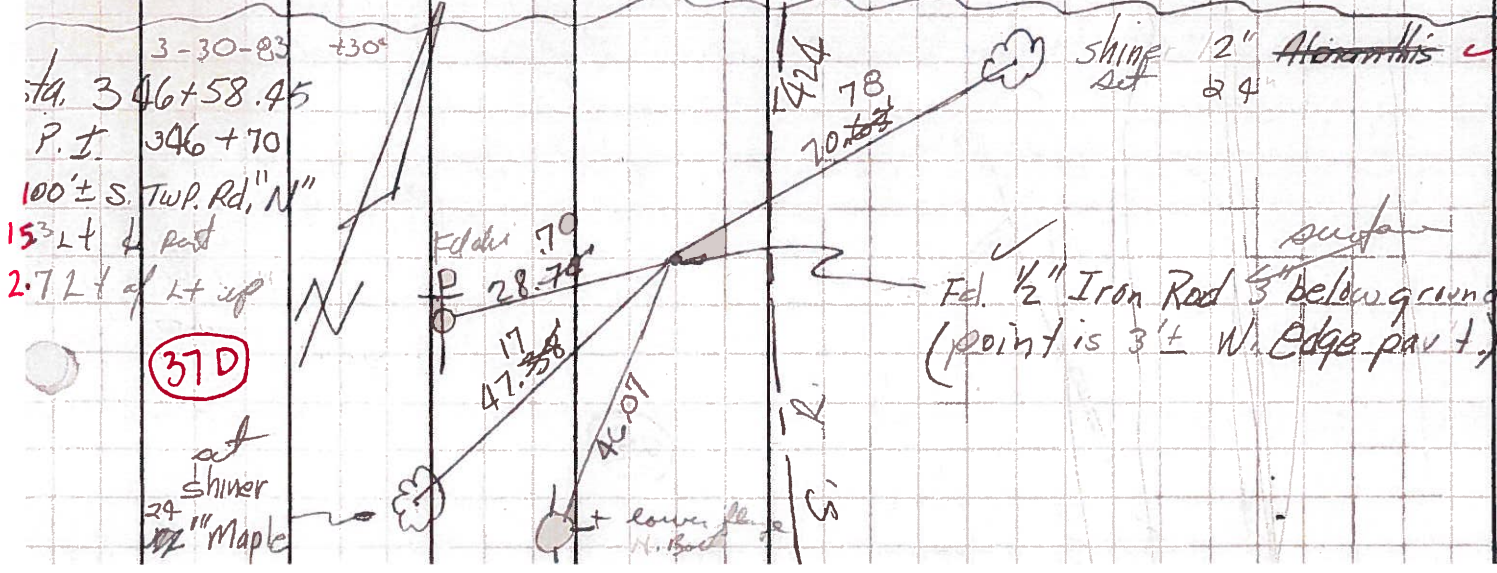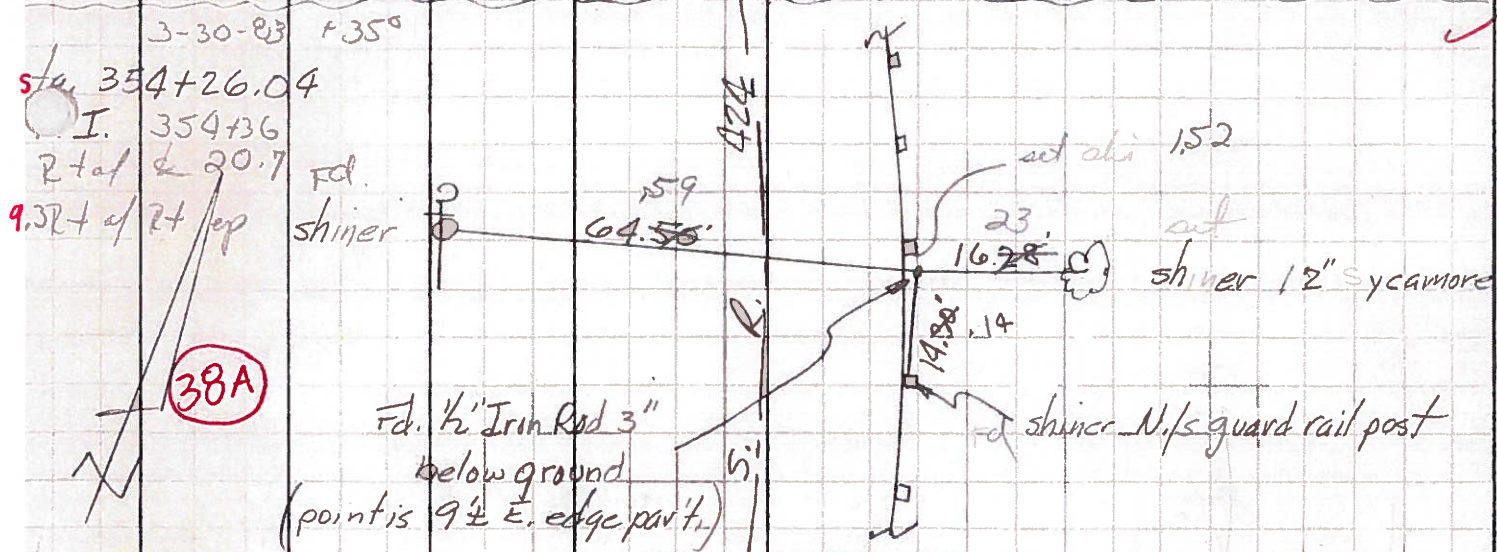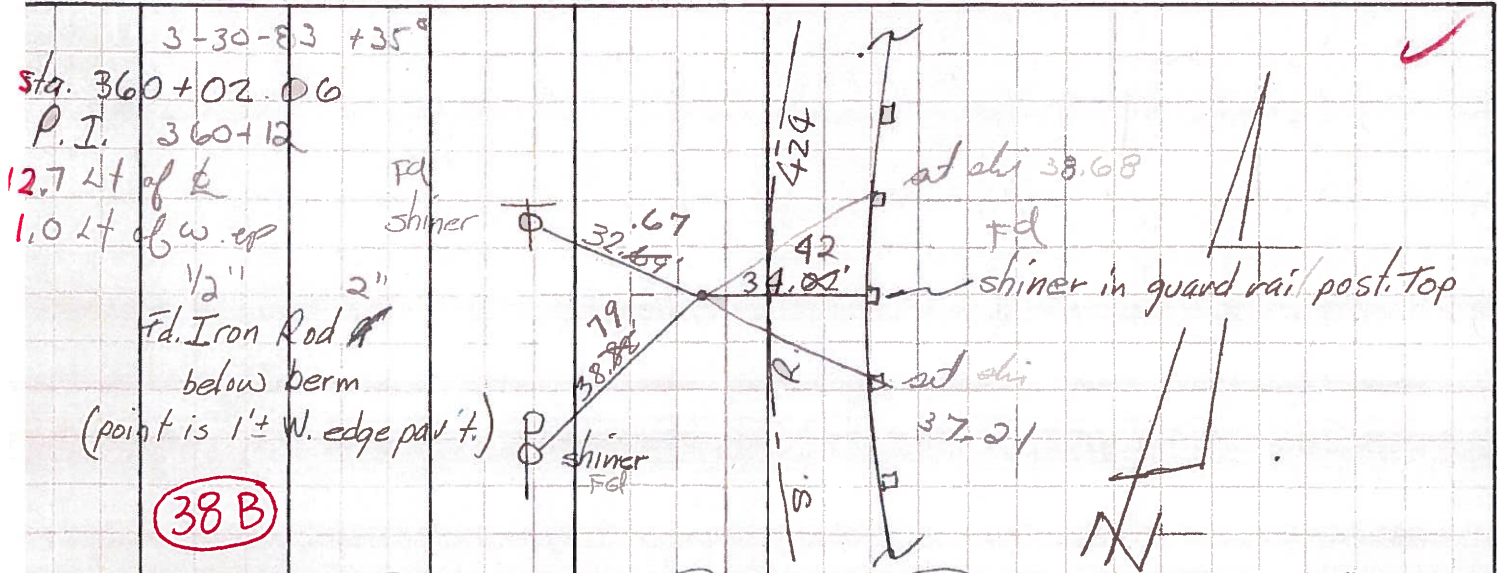

PERSONNEL TITLE PERSONNEL TITLE

Hoover
Hoff
Delventhal

COUNTY Henry DATE 4- -62

S. R. U.S.R. 24 WEATHER

SEC. TEMP.

DESCRIPTION Witnesses to Control Points (P.I. S) JOB NO.

LEFT


CENTER LINE

RIGHT

Forward tangent


✓ P.I. - 354+26.04

38-A

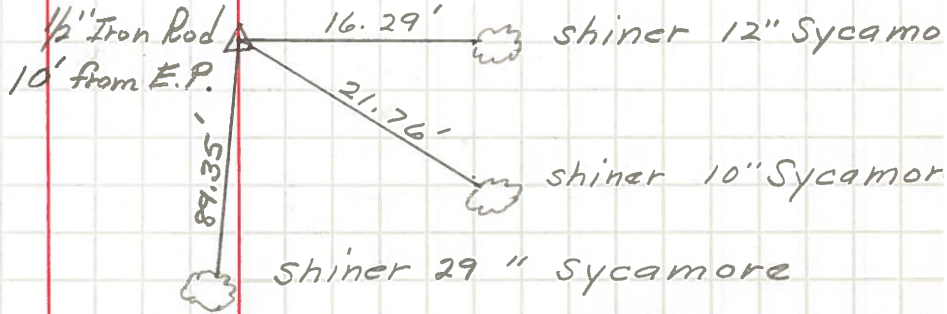

✓ P.I. - 360+02.06

38-B

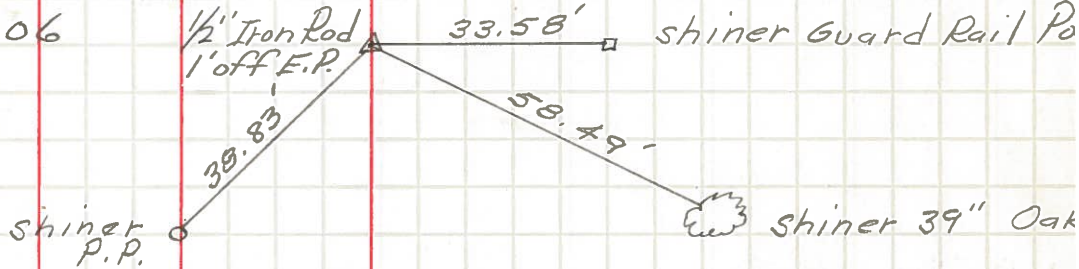

✓ P.I. - 365+20.45

39

