



O.D.O.T. DISTRICT 2 SURVEY OFFICE (USE ONLY)

PERSONNEL _____ REFERENCE NO. 39 A SHEET 1 OF 25
 NOTES LEU DATE 07/07/14 ROUTE SR 424
 H.C. HOMAN WEATHER CLOUDY COUNTY HENRY
 R.C. THOMAS TEMP. 70° TOWNSHIP NAPOLEON
 SECTION 27
 T 4 N R 6 E

TYPE MONUMENT 1" IRON ROD
~~ON SURFACE~~ - BELOW 6"
 LEFT - ☉ PAV'T - RIGHT -
- TO - EDGE PAVEMENT
 S.L.M. 380+84
 Grid: Northing: 622704.508 Easting: 1514430.025

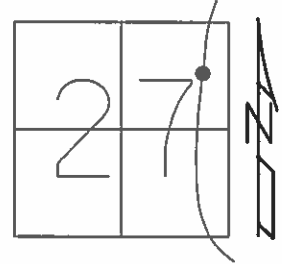

RECORD: PI
 PI STA 381+61.70
 #141
 REF48
 FD 1" IPIN 6" DOWN
 02/22/12 DCH
 REFA39

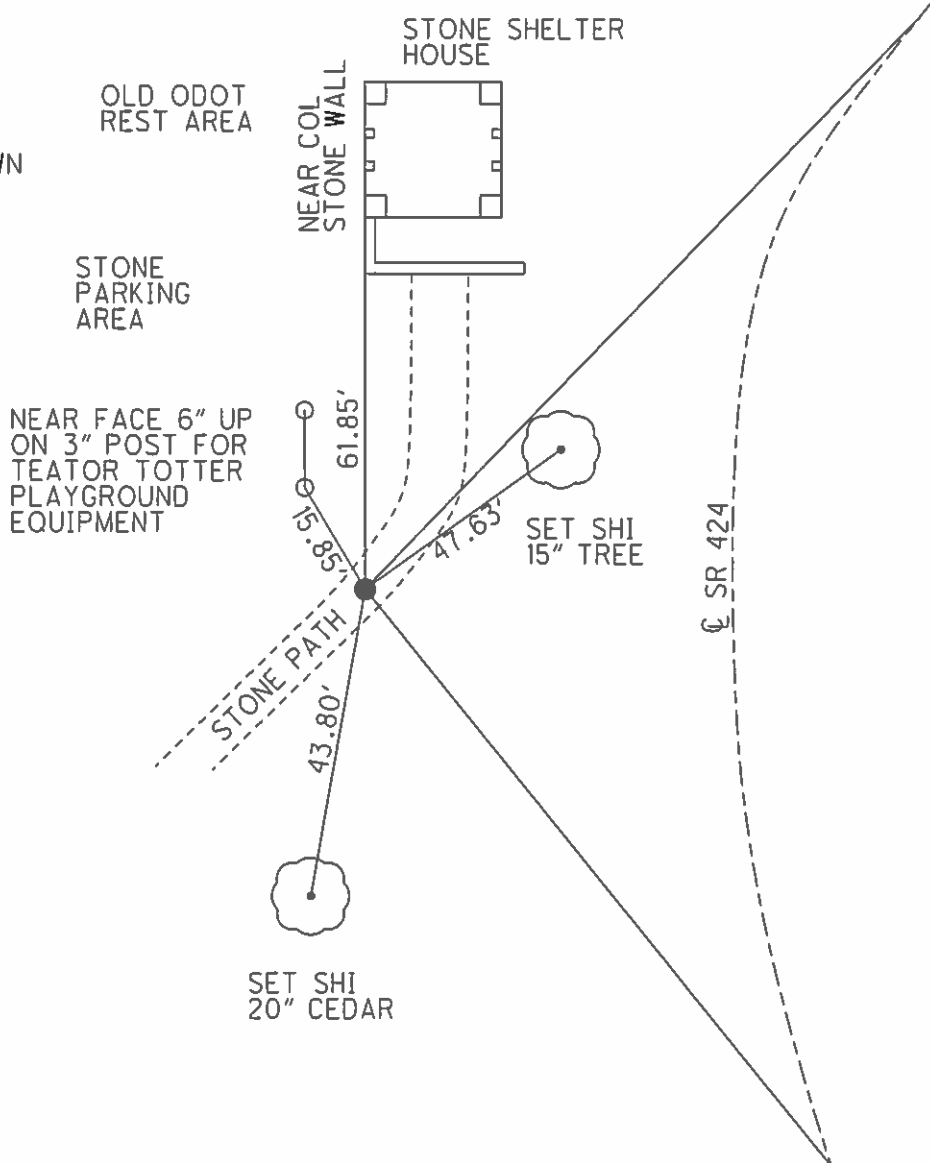

SET SHI
 20" CEDAR

O.D.O.T. DISTRICT 2 SURVEY OFFICE

PERSONNEL

REFERENCE NO. 39A

SHEET 43 OF 43

NOTES HOFFMAN

H.C. LOSHBREE

R.C. BARNWISSEL

DATE 4-4-91

WEATHER CLEAR

TEMP. 50°

ROUTE SR 424


COUNTY HENRY

TOWNSHIP NAPOLEON

SECTION 27

T5 N R 6 E


TYPE MONUMENT 1" IRON ROD
 ON SURFACE - BELOW 8"
 LEFT - C PAV'T. - RIGHT _____
 TO _____ EDGE PAVEMENT
 S.L.M. 381+91

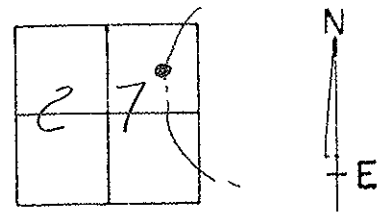

OLD O.D.O.T.
REST AREA


STONE
PARKING
AREA

STONE SHELTER
HOUSE

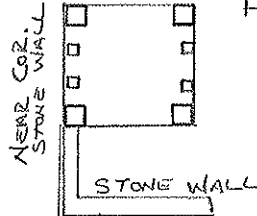

RECORD:
D.I. STA. 381+61.70

STONE PATH

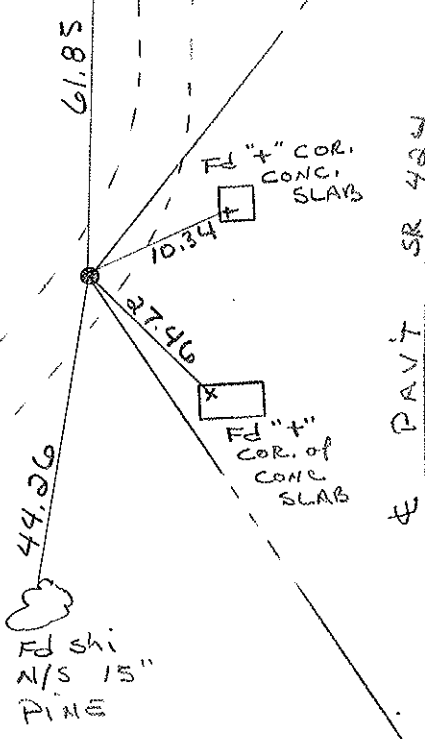

Ed Shi
N/S 15"
PINE

SR 424
PAV'T

PERSONNEL	TITLE	PERSONNEL	TITLE	COUNTY	DATE	WEATHER	TEMP.
Tomsic				HENRY	JUNE 10, 1974		
Neuser				S. R. 424			
Vanyo				SEC.			
Granata							

DESCRIPTION _____ LEFT _____ CENTER LINE _____ RIGHT _____ JOB NO. _____

LANA
 S.R. 424
 P.M. 11-1-74

