

O.D.O.T. DISTRICT 2 SURVEY OFFICE (USE ONLY)

PERSONNEL \_\_\_\_\_ REFERENCE NO. 39 C SHEET 3 OF 25

NOTES HOMAN DATE 07/07/14 ROUTE SR 424

H.C. LEU WEATHER CLOUDY COUNTY HENRY

R.C. THOMAS TEMP. 70° TOWNSHIP NAPOLEAN

SECTION 22

T 5 N R 6 E

TYPE MONUMENT \_\_\_\_\_ MAG/WASHER \_\_\_\_\_


ON SURFACE - ~~BELOW~~ \_\_\_\_\_ ON \_\_\_\_\_

LEFT - ~~C PAV'T~~ - ~~RIGHT~~ \_\_\_\_\_ 13.5'


1.9' TO LT EDGE PAVEMENT

S.L.M. \_\_\_\_\_ 412+62 \_\_\_\_\_

Grid: Northing: 625712.653 Easting: 1515321.810

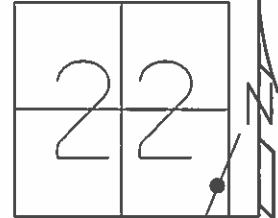

RECORD:  
 SET MAG/WASHER  
 10-29-04  
 DCH  
 SET MAG/W  
 07-29-15  
 DCH, JLL  
 REFC39

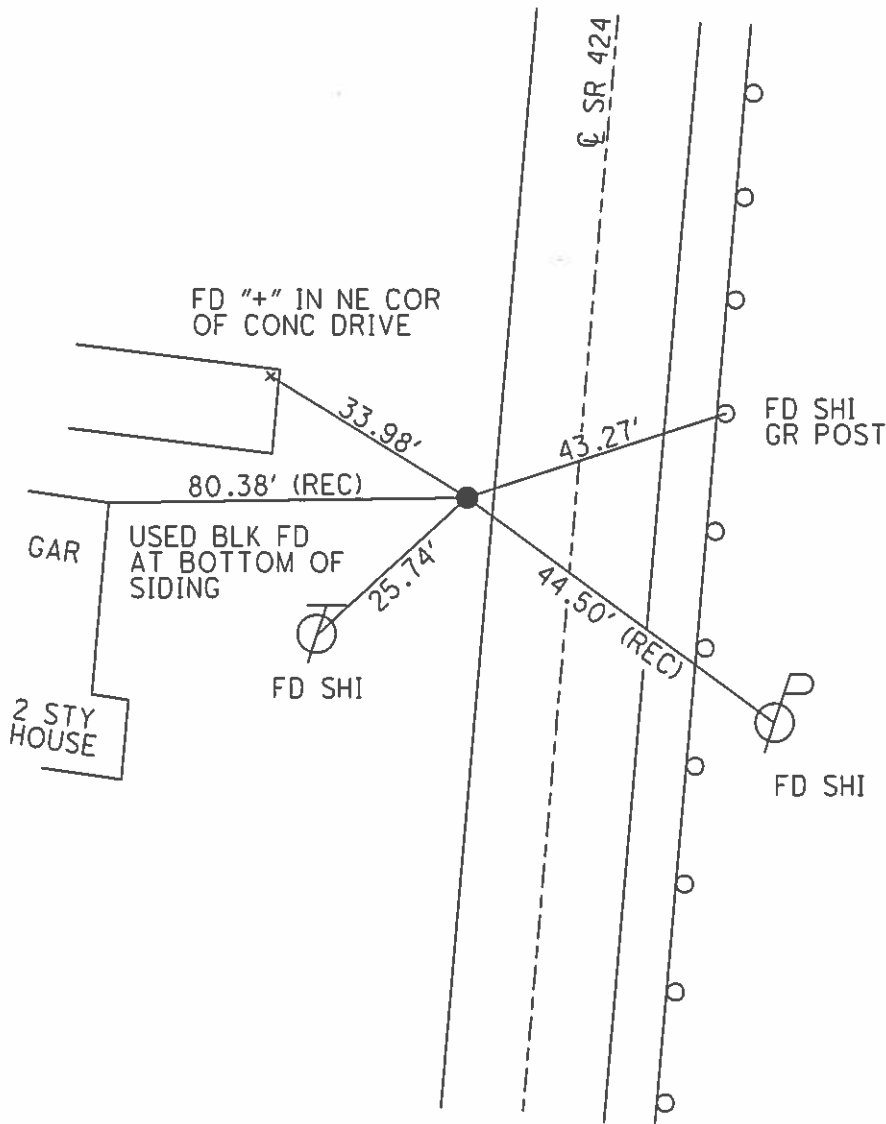

# O.D.O.T. DISTRICT 2 SURVEY OFFICE

PERSONNEL

REFERENCE NO. 89C

SHEET 1 OF 29

NOTES HOMAN

H.C. BARNHISEL

R.C. HOOKER

MC-DRAWING

DATE 9-01-04

WEATHER SUN

TEMP. +70°

ROUTE S.R. 424

COUNTY HENRY

TOWNSHIP NAPOLEON

SECTION 22

T 5 N R 6 E


TYPE MONUMENT R.R. SPK. W/ CNTR. PUNCH

ON SURFACE - BELOW SURFACE

LEFT - CL PAV'T. - RIGHT 13.5' LT.


1.9' LT OF LT. EDGE PAVEMENT

S.L.M. 412 + 62

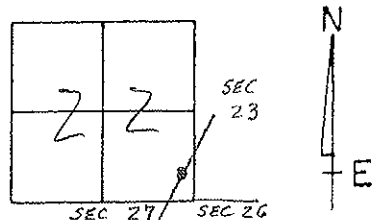

P.I.

RESET MAG/WASHER  
10-29-04  
D.C.H.

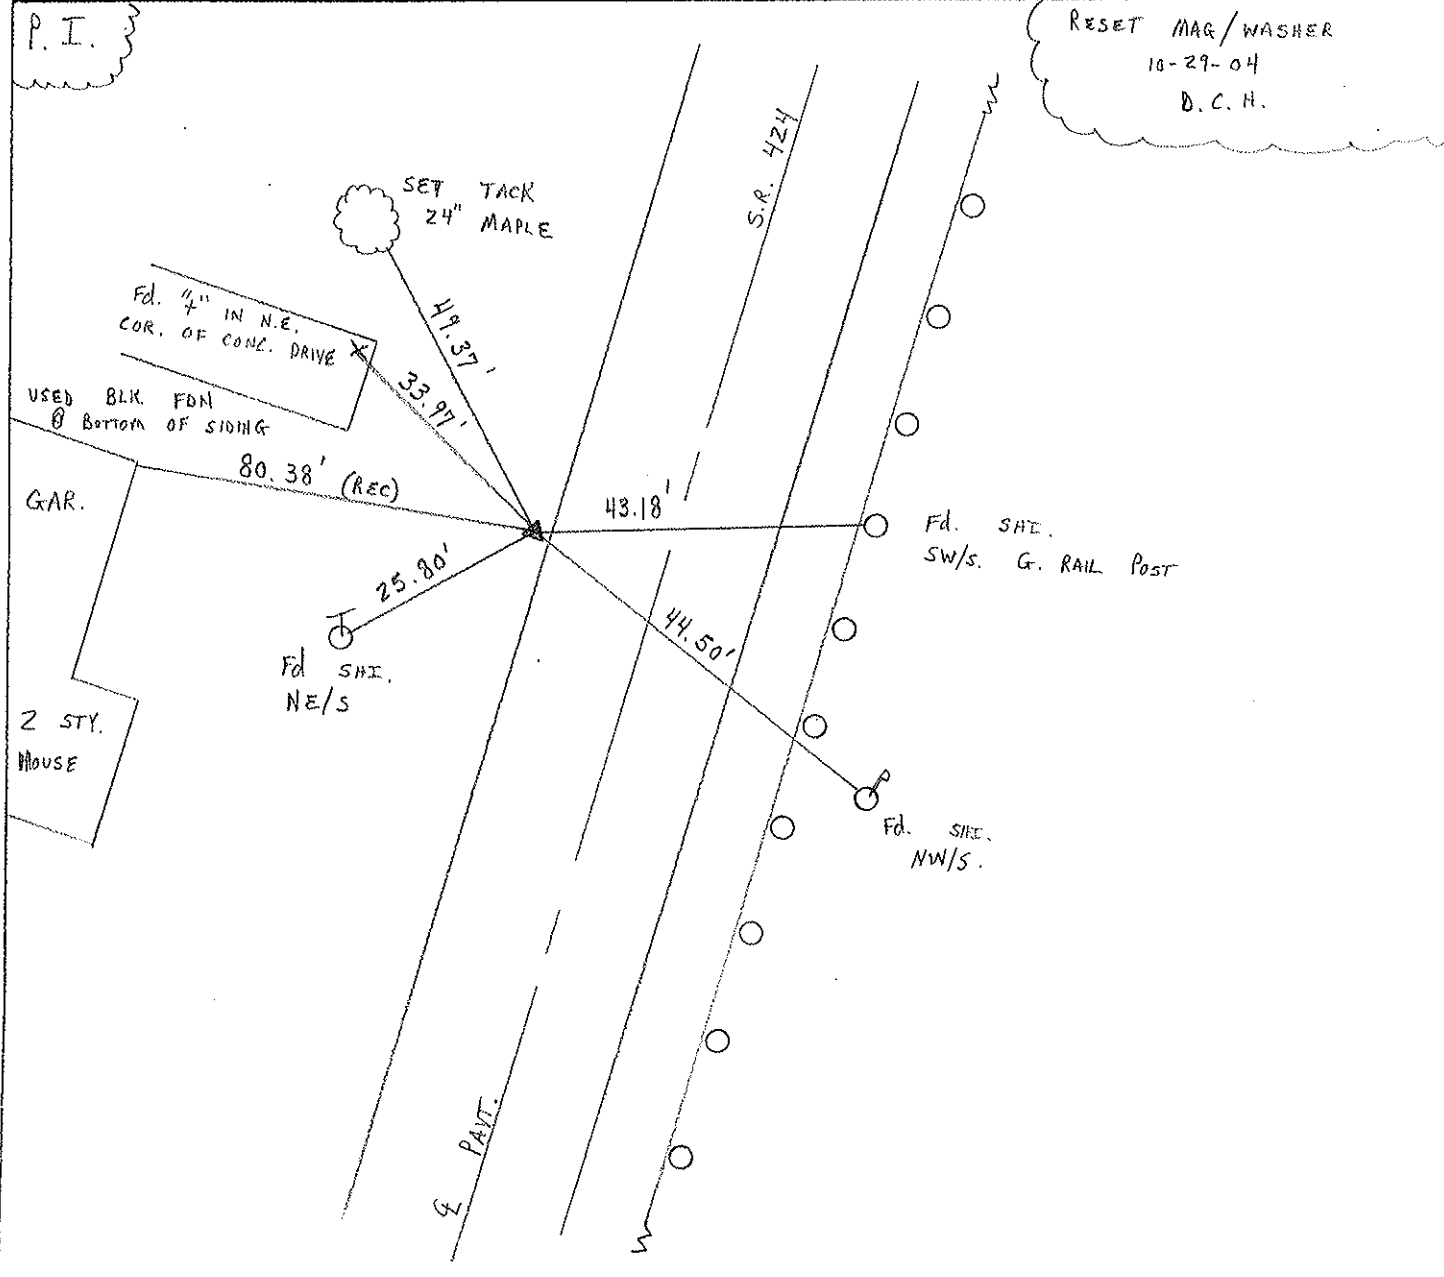

Resurfaced 2004

### O.D.O.T. DISTRICT 2 SURVEY OFFICE

PERSONNEL \_\_\_\_\_

REFERENCE NO. \_\_\_\_\_

SHEET \_\_\_\_\_ OF \_\_\_\_\_

NOTES BAENHISEL

H.C. \_\_\_\_\_

DATE 9-21-90

ROUTE 424

R.C. HOFFMAN

WEATHER Clear

COUNTY HENRY

TEMP. +65°

TOWNSHIP Napoleon

SECTION 22

T 5 N R 6 E

TYPE MONUMENT 3/4" IRON PIN - BEND OVER


ON SURFACE - BELOW 1"

LEFT - 0 PAV'T. - RIGHT 13.6

1.6 <sup>OF</sup> 10 Lt TO Lt EDGE PAVEMENT

S.L.M. 412+62

**39C**

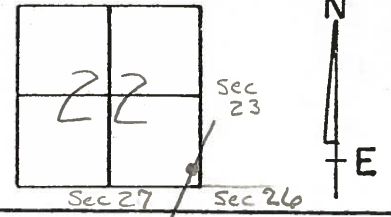

P.I.

Set Small Spk  
w/ CTN Punch  
10-4-90  
MB

Fd "x" IN NE  
COR. OF CONC. DRIVE


USED BIK Fnd AT  
Bottom OF SIDING

Set Shi IN  
NEW G. RAIL POST  
SW/S

Set Shi  
NW/S

Set Shi  
NE/S

Shi  
N/S

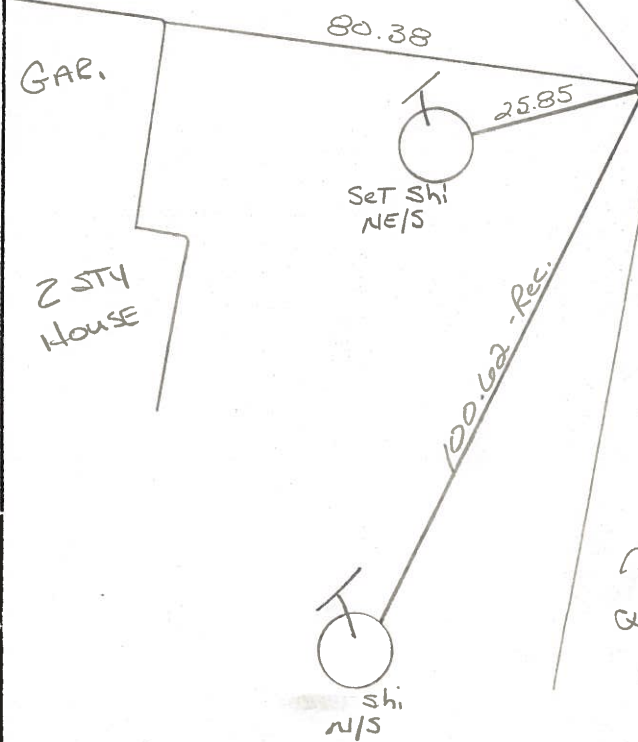

OD.O.T. DISTRICT 2 SURVEY OFFICE

Sht. 1 of 6

County HENRY S.R. 424

Date 7-26-79

Township NAPOLEON


Weather CLOUDY

Section 23

Temp. +72°

T5N, R6E

Personnel BURNSIDE

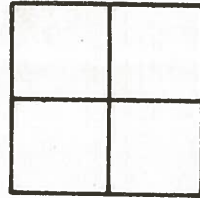

N 3-31-83  
SW4  
Point OK





390

BOWERS  
KNAPE  
MEAD

ORCHARD LANE

BEGIN POINT CHECK

P.I. S.L.M. STA. = 411+85 = ~~TOMSON~~ 414+39.14  
FD. 3/4" IRON PIN  
2" DEEP & 1/2" N.  
OF N. EDGE PAVE.

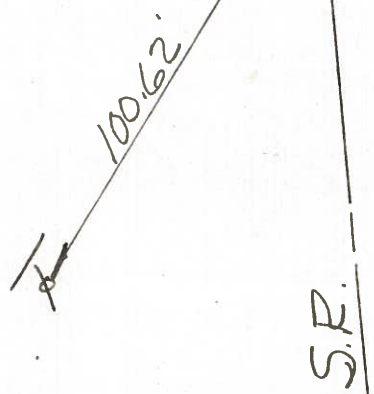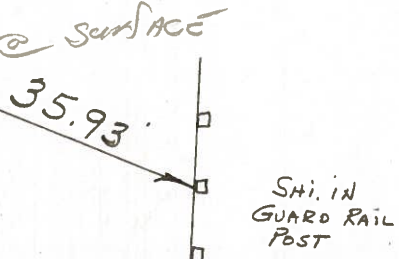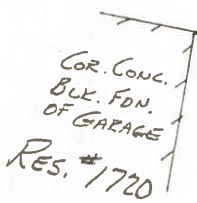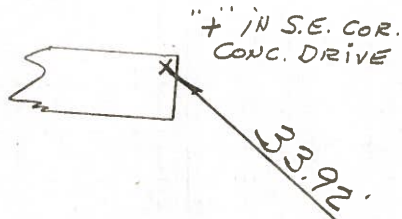

412  
388  
---  
24



PERSONNEL	TITLE	PERSONNEL	TITLE
Tomsic			
Vandy			
Granata			

COUNTY HENRY DATE JUNE 24, 19  
 S. R. 424 WEATHER \_\_\_\_\_  
 SEC. \_\_\_\_\_ TEMP. \_\_\_\_\_

DESCRIPTION \_\_\_\_\_ LEFT \_\_\_\_\_ CENTER LINE \_\_\_\_\_ RIGHT \_\_\_\_\_ JOB NO. \_\_\_\_\_

