


O.D.O.T. DISTRICT 2 SURVEY OFFICE (USE ONLY)


PERSONNEL _____ REFERENCE NO. 40 A SHEET 5 OF 25
 NOTES HOMAN DATE 07/07/14 ROUTE SR 424
 H.C. LEU WEATHER CLOUDY COUNTY HENRY
 R.C. THOMAS TEMP. 75° TOWNSHIP NAPOLEAN
 _____ SECTION 23
 _____ T 5 N R 6 E

TYPE MONUMENT _____ MAG/WASHER _____
 ON SURFACE - ~~BELOW~~ _____ ON _____
 LEFT - ~~C PAV'T~~ - ~~RIGHT~~ _____ 0.5' _____
11.0' TO LT EDGE PAVEMENT
 S.L.M. _____ 419+56 _____

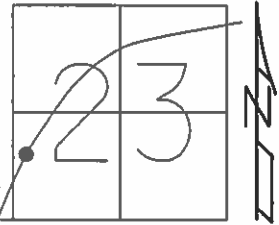

Grid: Northing: 626352.468 Easting: 1515596.129

RECORD: PI
 SET MAGS/WASHER
 11/01/04
 DCH
 SET MAG/WASHER
 @ BOTH
 07/29/15
 DCH, JLL
 REFA40

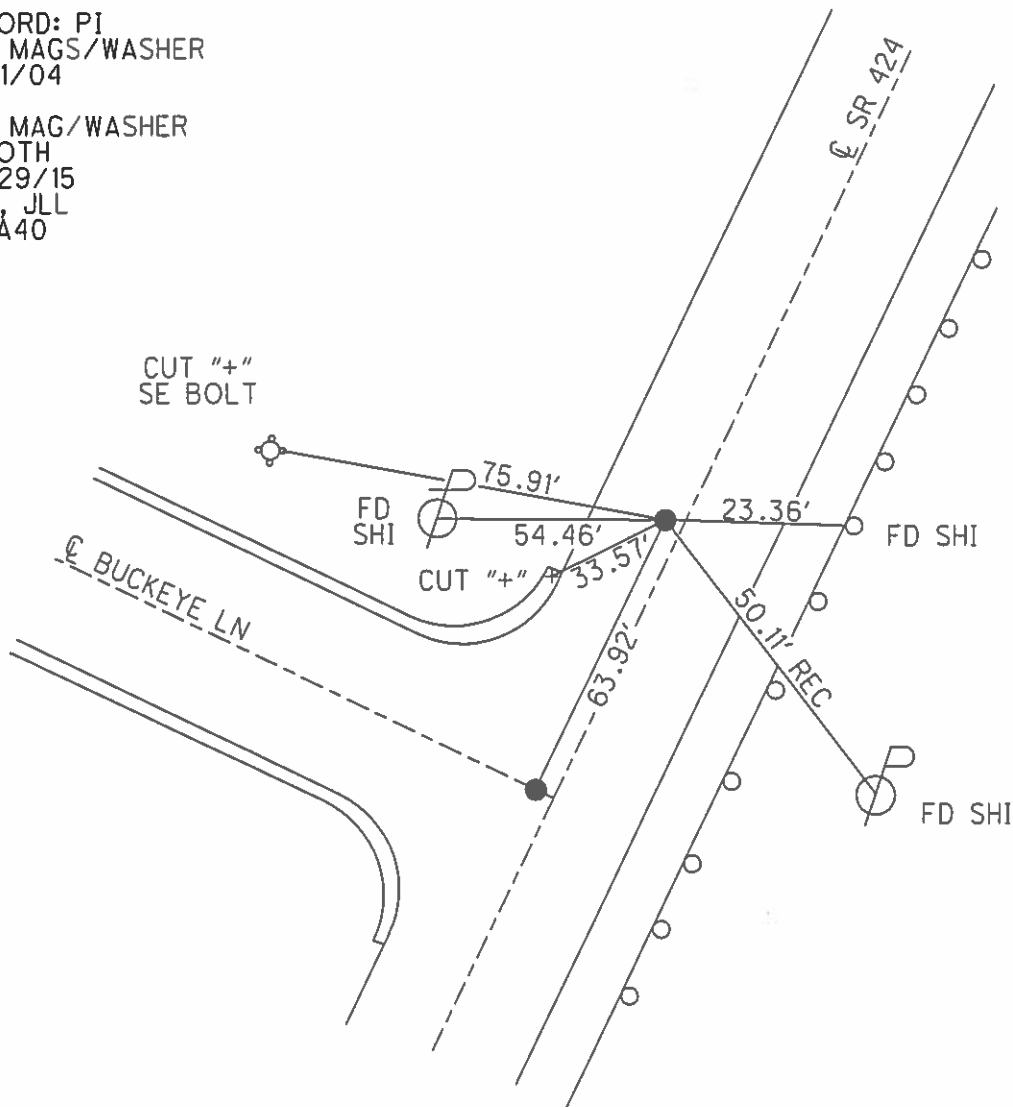

O.D.O.T. DISTRICT 2 SURVEY OFFICE

PERSONNEL

REFERENCE NO. 40

SHEET 2 OF 29

NOTES HOMAN

H.C. BARNHISEL

DATE 9-01-04

ROUTE S.R. 424

R.C. HOOGER

WEATHER SUN

COUNTY HENRY

TEMP. + 72°


TOWNSHIP NAPOLEON

SECTION 23

T 5 N R 6 E


MC-DRAWING

	PT "A"	PT "B"
TYPE MONUMENT	P.K. / WASHER	P.K. / WASHER
ON SURFACE - BELOW	SURFACE	SURFACE
LEFT- ϕ PAV'T. - RIGHT	3.3' LT ϕ	0.5' LT ϕ
15.3' TO RT EDGE PAVEMENT		11.0' TO LT. EOP
S.L.M.	418 + 91	419 + 56

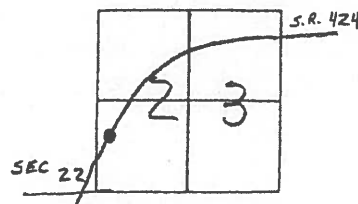

Reset Nags/Washers
11/01/04
DCH

RECORD = PI

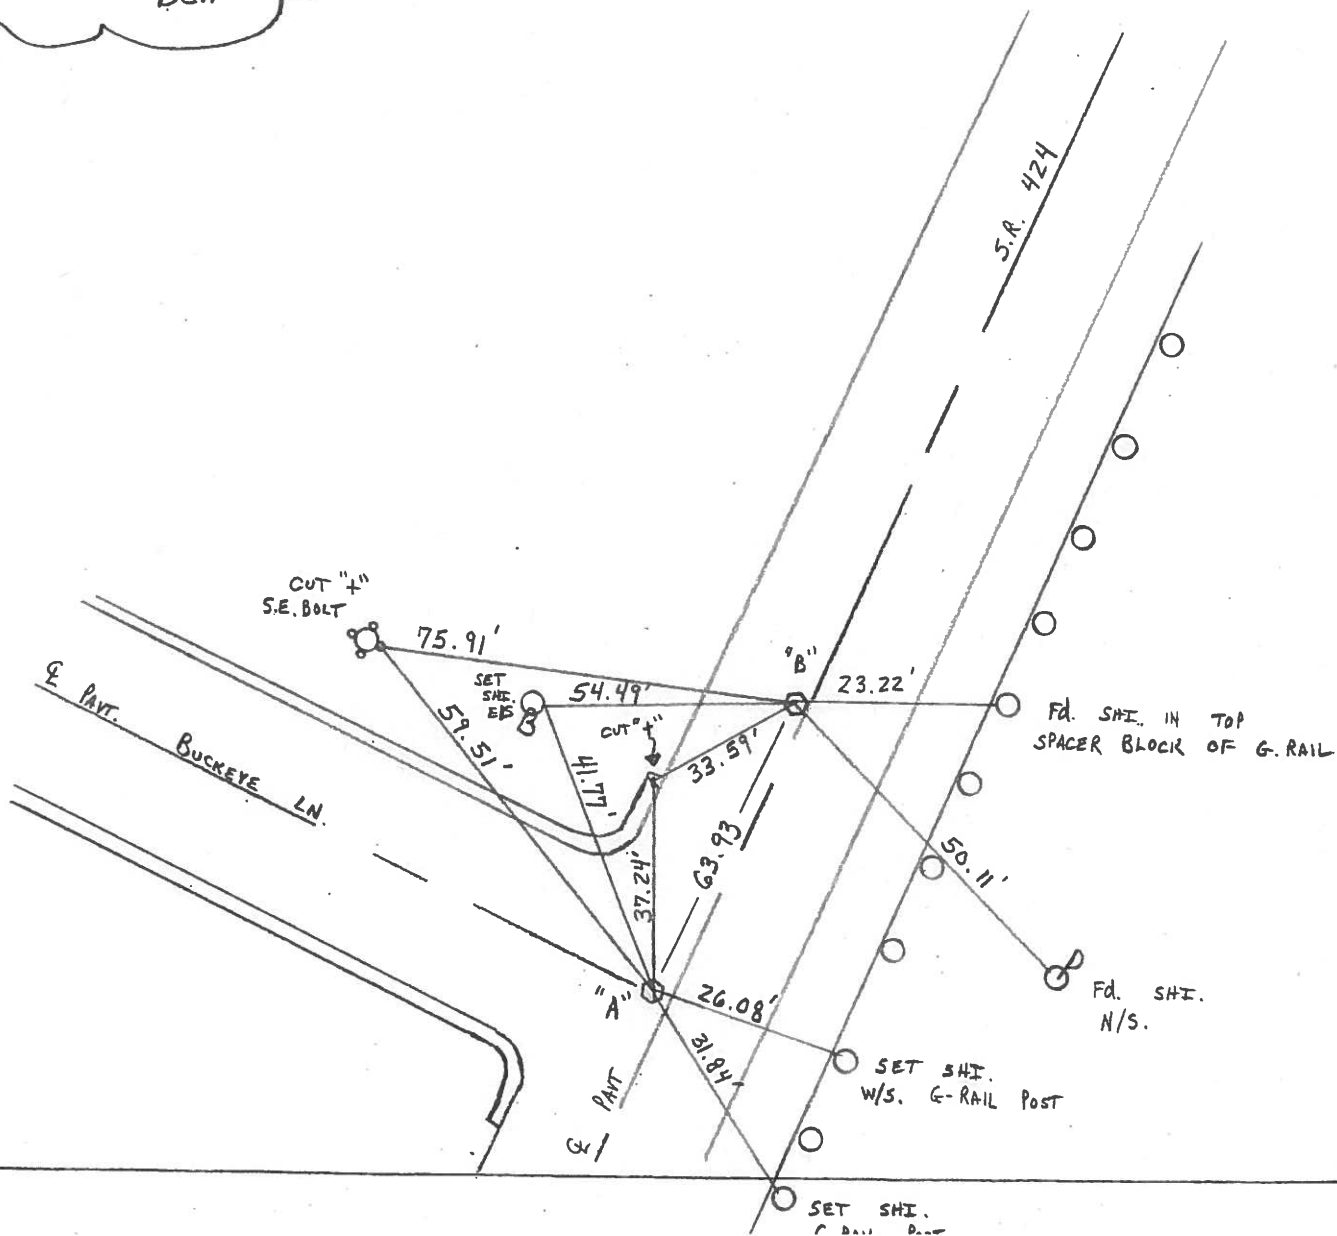

O.D.O.T. DISTRICT 2 SURVEY OFFICE

PERSONNEL _____

REFERENCE NO. _____

SHEET _____ OF _____

NOTES BARNHISEL

H.C. _____

DATE 9-21-90

ROUTE 424

R.C. HOFFMAN

WEATHER CLEAR

COUNTY HENRY

TEMP. +65°

TOWNSHIP Napoleon

SECTION 23

T S N R 6 E

TYPE MONUMENT Sm RR Spk

ON SURFACE - BELOW yes


LEFT- & PAV'T. - RIGHT 0.5

11.7 TO LT EDGE PAVEMENT

S.L.M. 419+56


40A

40B

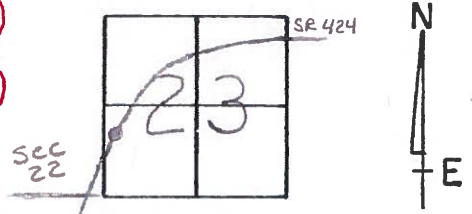

P.I.

Set P.K.'s & Washers
10-4-90
mB

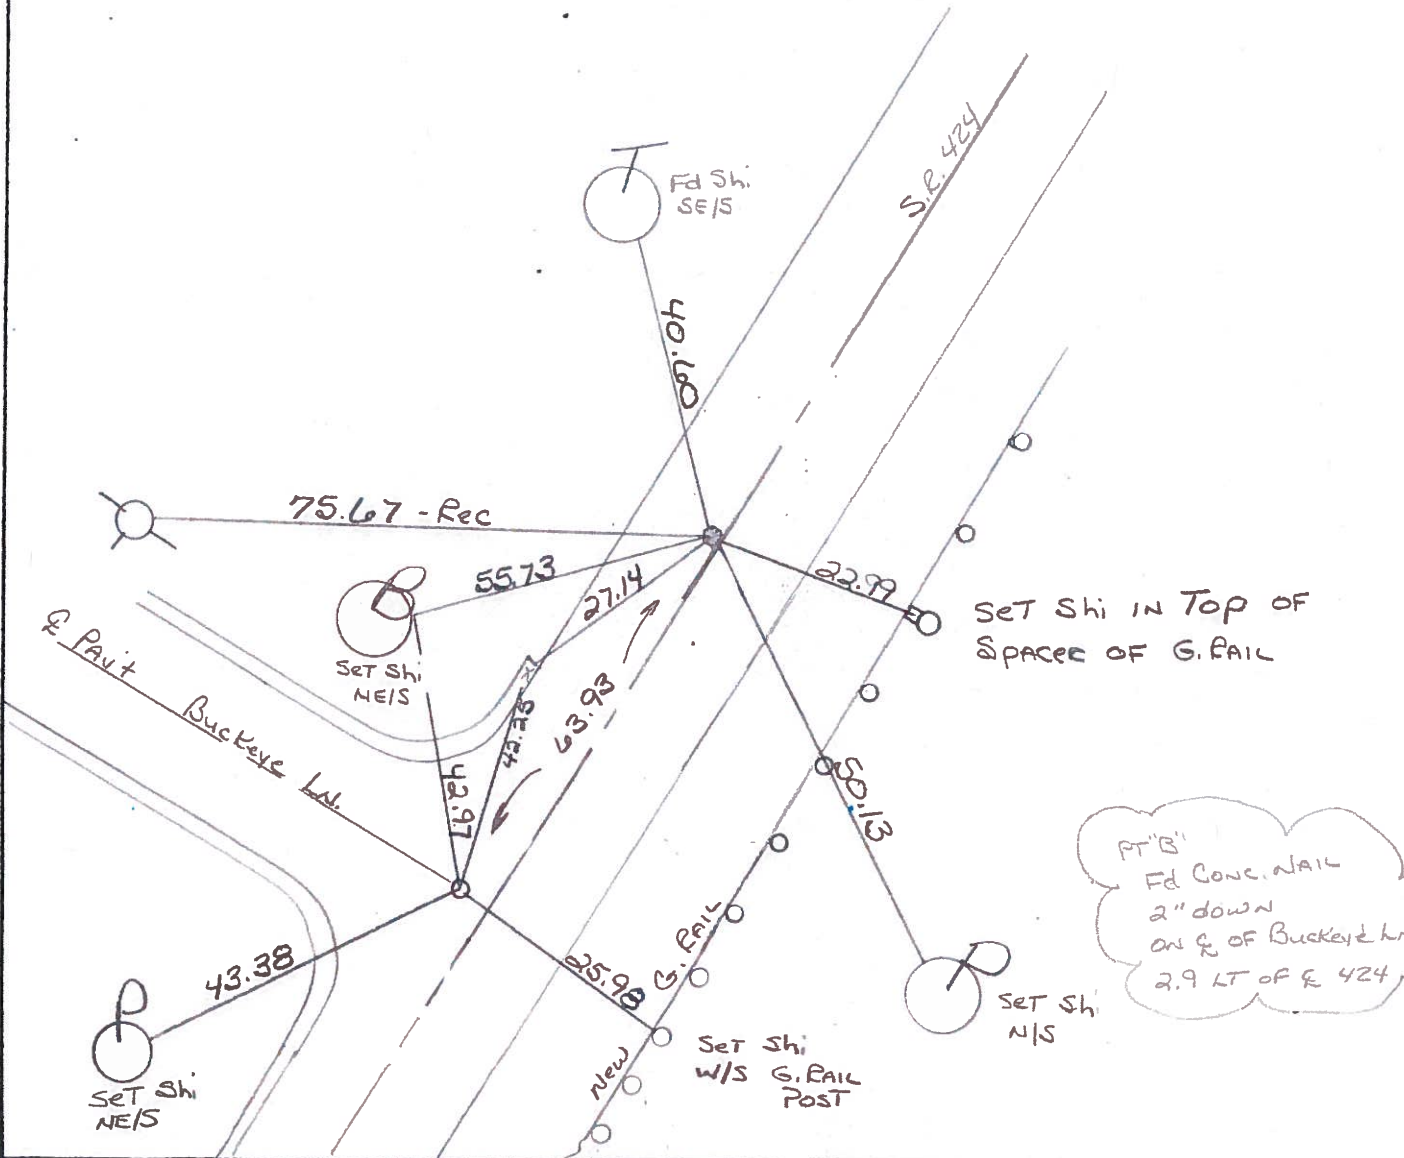

QD.O.T. DISTRICT 2 SURVEY OFFICE

Sht. 2 of 6

County HENRY S.R. 424

Date 7-26-79

Township NAPOLEON

Weather CLOUDY

Section 23

Temp. +73°

T5N, R6E


Personnel BURNSIDE

BOWERS

KNAPE

MEAD.

40B

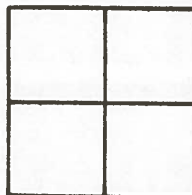

P.I.
S.L.M. STA. = 418+80
FD. R.R. SPK. 2" DEEP
§ .50' LT. OF CTR.
PAVE.

