


O.D.O.T. DISTRICT 2 SURVEY OFFICE (USE ONLY)


PERSONNEL _____ REFERENCE NO. 41 SHEET 6 OF 25
 NOTES HOMAN DATE 07/07/14 ROUTE SR 424
 H.C. LEU WEATHER CLOUDY COUNTY HENRY
 R.C. THOMAS TEMP. 75° TOWNSHIP NAPOLEAN
 _____ SECTION 23
 _____ T 5 N R 6 E

TYPE MONUMENT MAG/WASHER
 ON SURFACE - ~~BELOW~~ ON
~~LEFT~~ - Q PAV'T - ~~RIGHT~~ ON
11.9' TO RT EDGE PAVEMENT
 S.L.M. 427+42

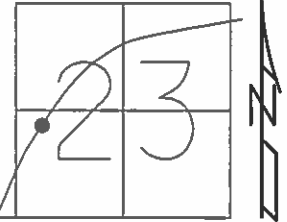

Grid: Northing: 627039.622 Easting: 1515976.509

RECORD: PI
 SET MAG/WASHER
 11/01/04
 DCH
 SET MAG/WASHER
 07/29/15
 DCH, JLL
 REF 41

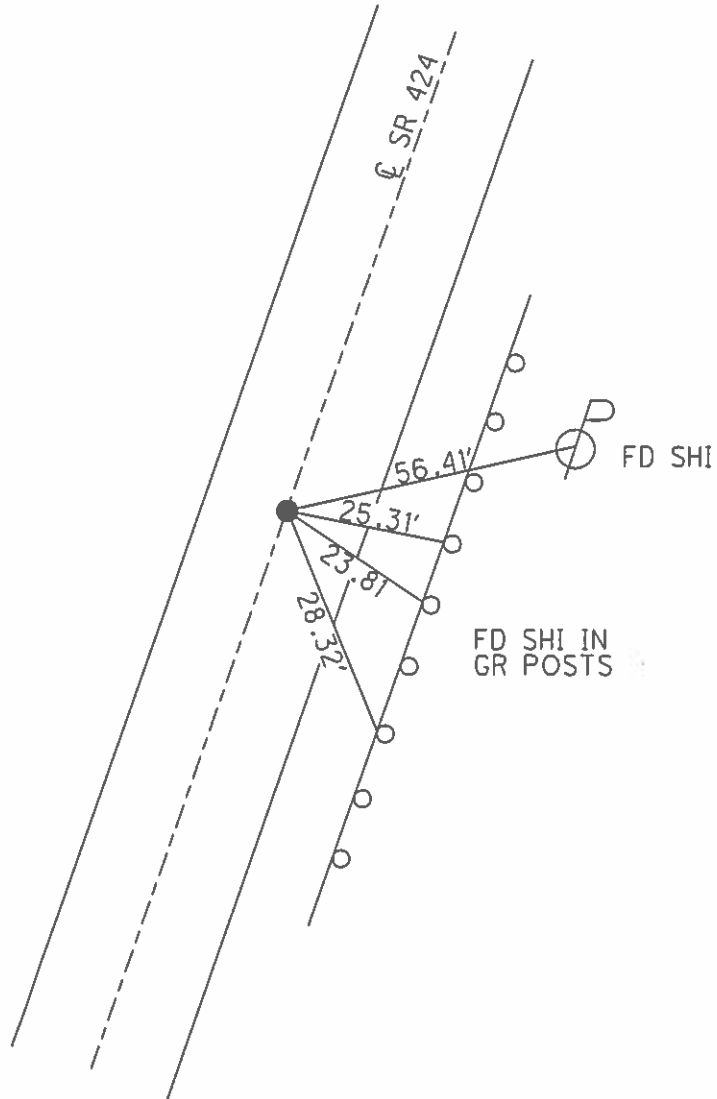

O.D.O.T. DISTRICT 2 SURVEY OFFICE

PERSONNEL

REFERENCE NO. 41

SHEET 3 OF 29

NOTES HOMAN

H.C. BARNHISEL

R.C. HOOGER

DATE 9-01-04

WEATHER SUN

TEMP. +72°

ROUTE S.R. 424

COUNTY HENRY

TOWNSHIP NAPOLEON

SECTION 23

T 5 N R 6 E

MC - Drawing


TYPE MONUMENT Sm. R.R. SPK. W/CNTR. PUNCH

ON SURFACE - BELOW SURFACE

LEFT - & PAV'T. - RIGHT ON 9


11.9' TO RT. EDGE PAVEMENT

S.L.M. 427 + 42

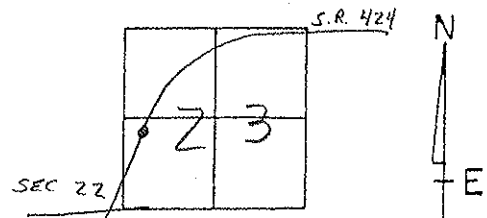

P.I.

RESET MAG/WASHER
 11-1-04
 D.C.H

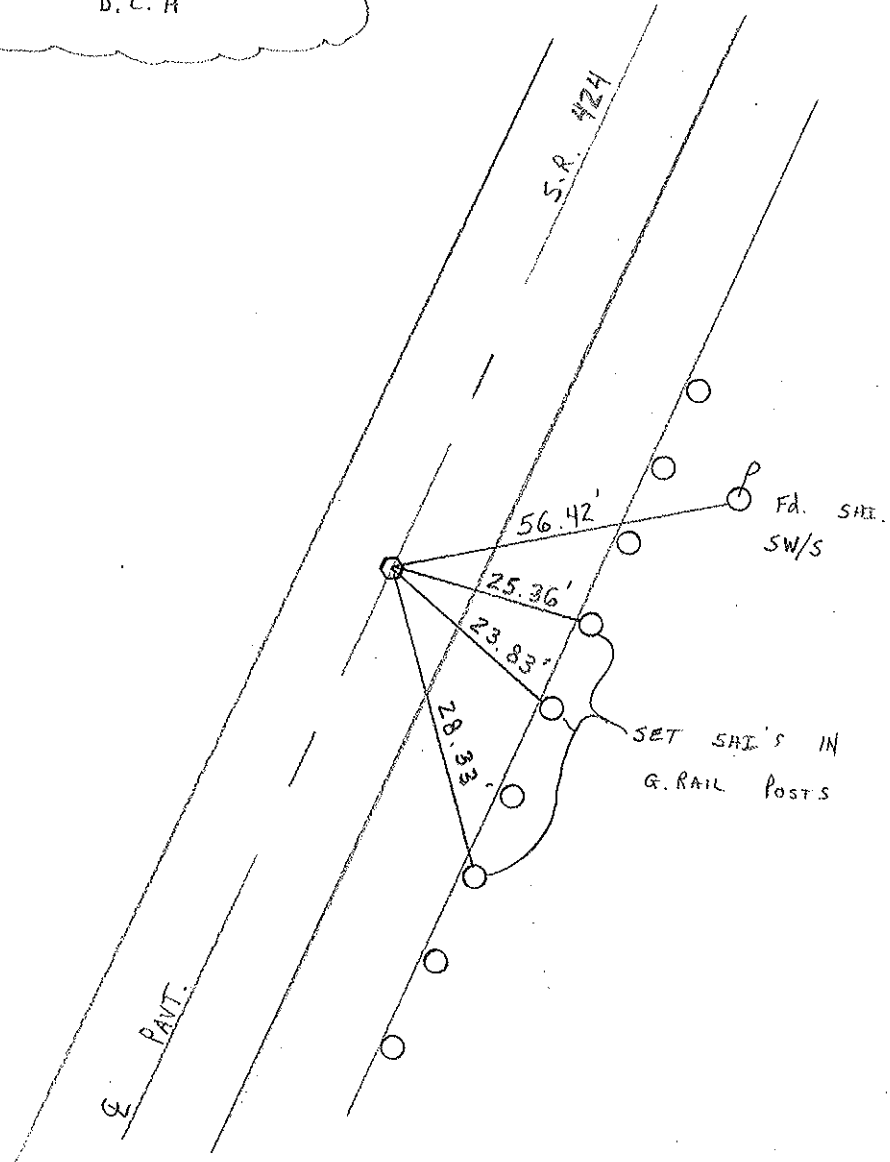

O.D.O.T. DISTRICT 2 SURVEY OFFICE

PERSONNEL _____

REFERENCE NO. _____

SHEET _____ OF _____

NOTES BARNHISEL

H.C. " "

R.C. HOFFMAN

DATE 9-21-90

WEATHER CLEAR

TEMP. +65°

ROUTE 424

COUNTY HENRY

TOWNSHIP Napoleon

SECTION 23

T5 NR 6 E

TYPE MONUMENT Sm RR Spk


ON SURFACE - BELOW 2"

LEFT- & PAV'T. - RIGHT YES

12.4 TO LT EDGE PAVEMENT


S.L.M. 427+42

41

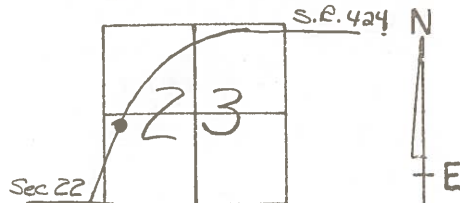

P.I.

Set Sm RR Spk
w/ CTS Punch
10-4-90
mB

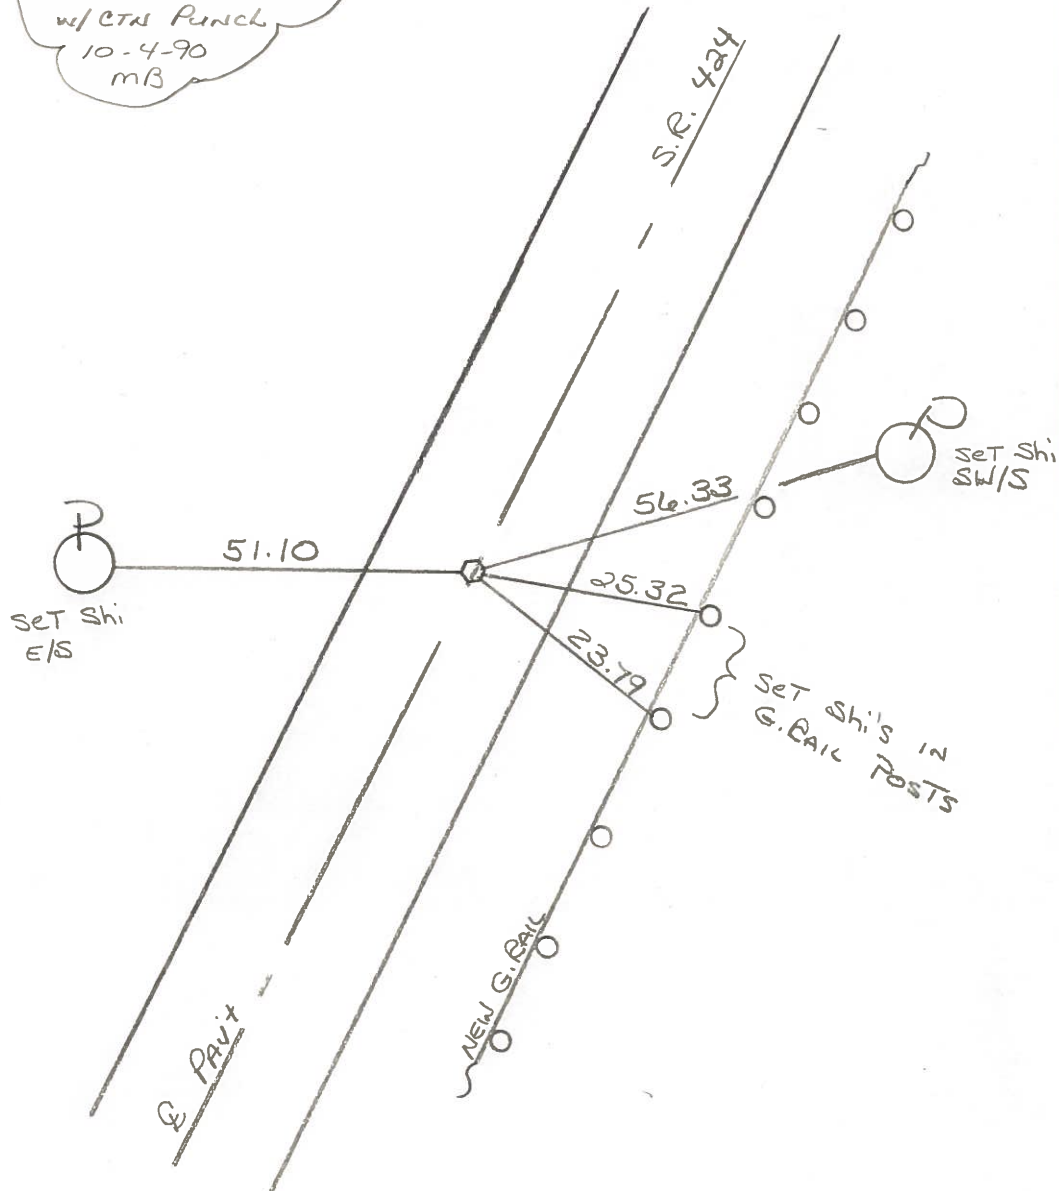

County HENRY S.R. 424

Date 7-26-79

Township NAPOLEON

Weather CLEARING

Section 23

Temp. +75°


T5N, R6E

Personnel BURNSIDE.

BOWERS

KNAPE

MEAD

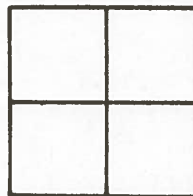

P.I.
S.L.M. STA. = 426+67
FD. P.K. NAIL @
SURFACE & IN CTR.
PAVE.

